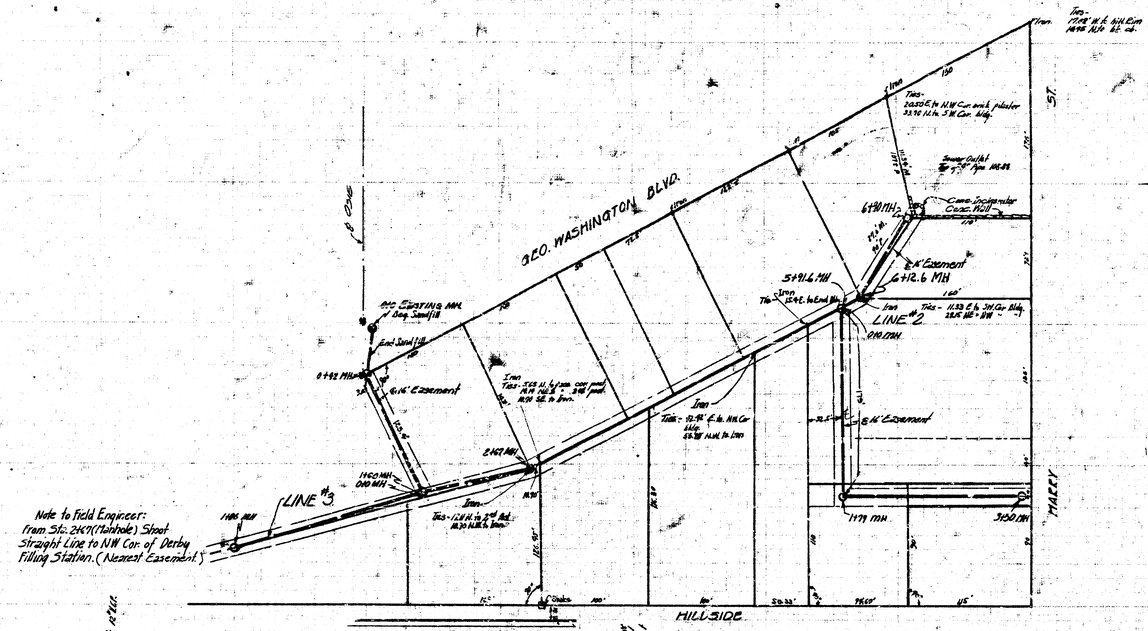

DETAIL OF TAMPED BACK FILL
Tamped back fill to be used in ditch all over 12' in depth.

LATERAL S, ~~DISTRICT~~ W, SANITARY SEWER #12
CITY OF WICHITA, KANSAS
L.K. White .... City Engineer
Date 6-30-50 Proj. No. C20-9