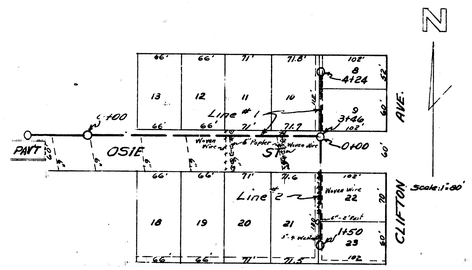
N
Scale: 1"=60'
OSIE ST.
PAVT.
CLIFTON AVE.
Line #1
Line #2
0+00
1+00
3+46
4+24
1+50
