


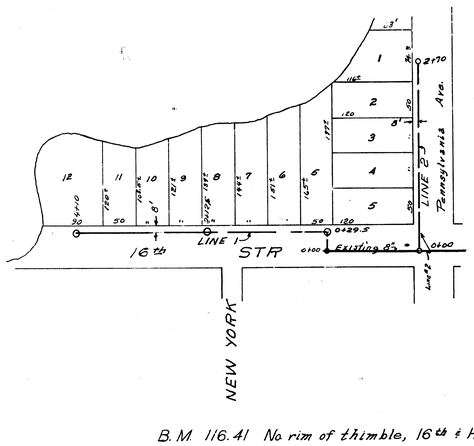


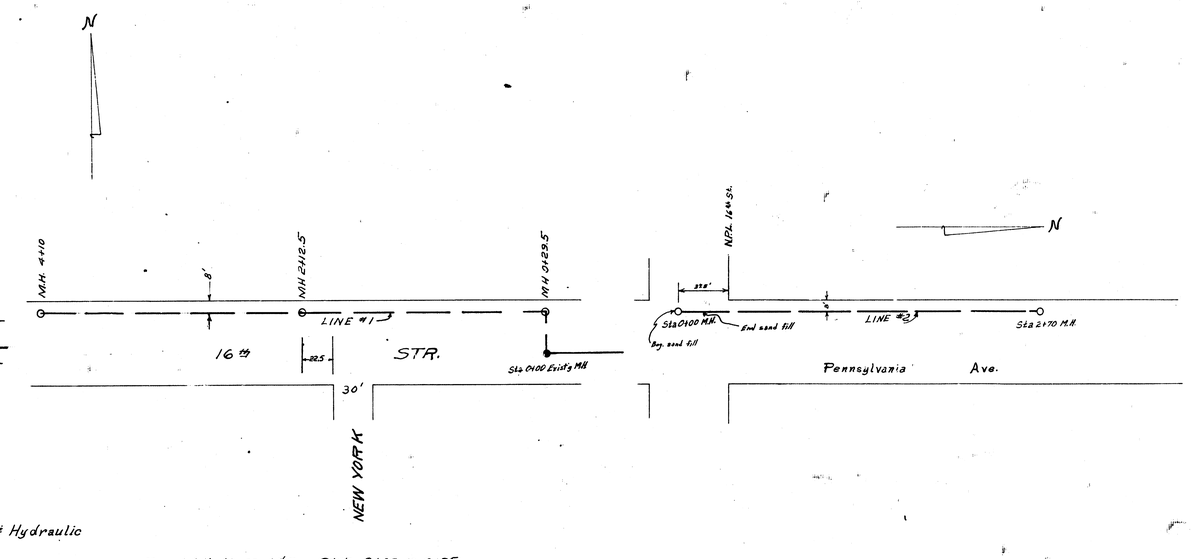

B.M. 116.41 No rim of thimble, 16th & Hydraulic

Sand fill Lines 1 & 2 Stas 0+00 to 0+25

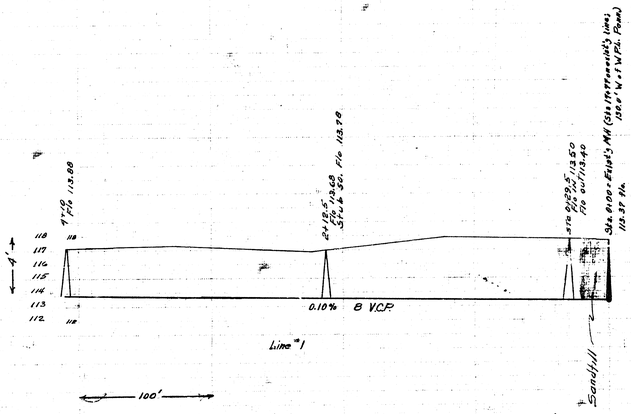

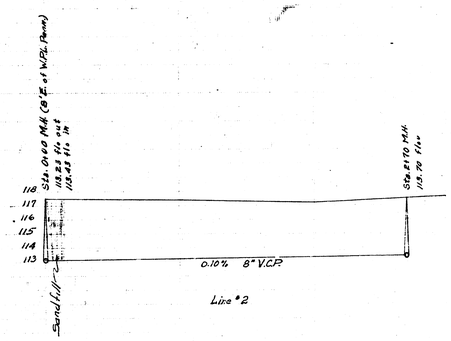

NOTE SCALE :-
1" = 4' VERT.
1" = 40' HORIZ.

Date 1-19-52
Drawn by L.H.W.
Checked by
Book # 1-55
Page

LAT. 4, SUB Y. SS# 12
City of Wichita, Kansas
L.K. White City Engineer
March 1951 Proj. No. C21-14

L. K. WHITE REGISTERED 55 KANSAS CITY ENGINEER