
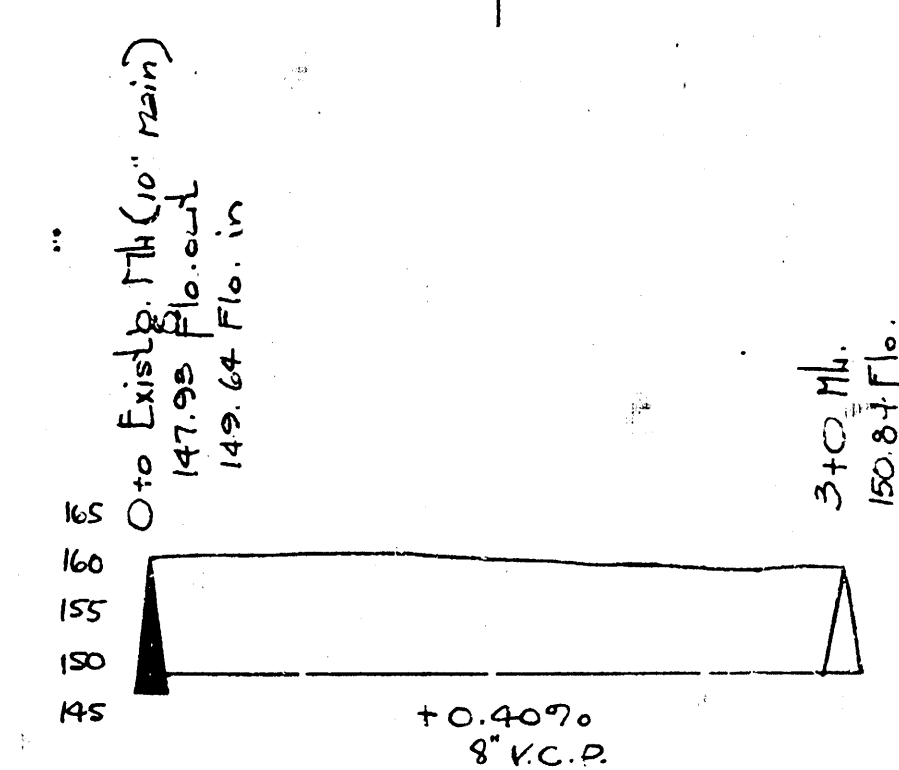
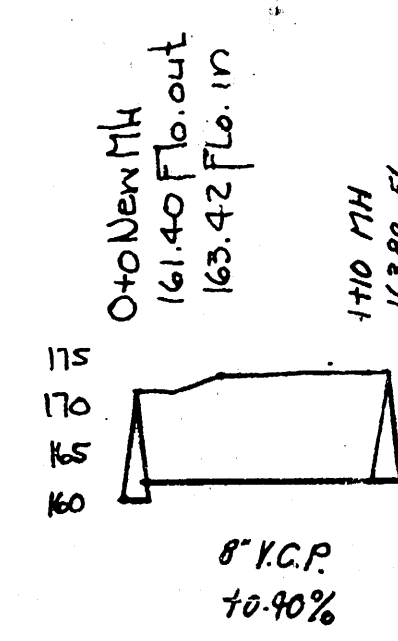
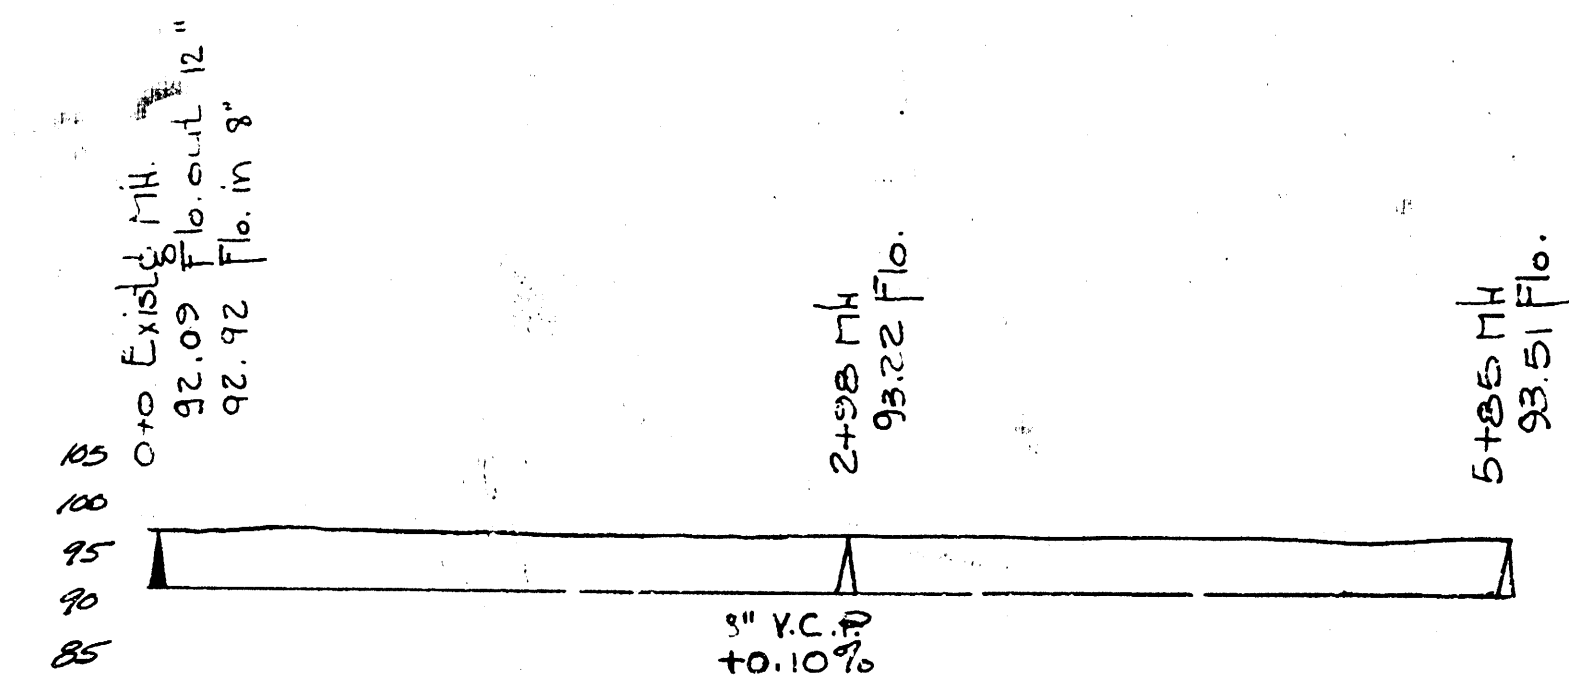
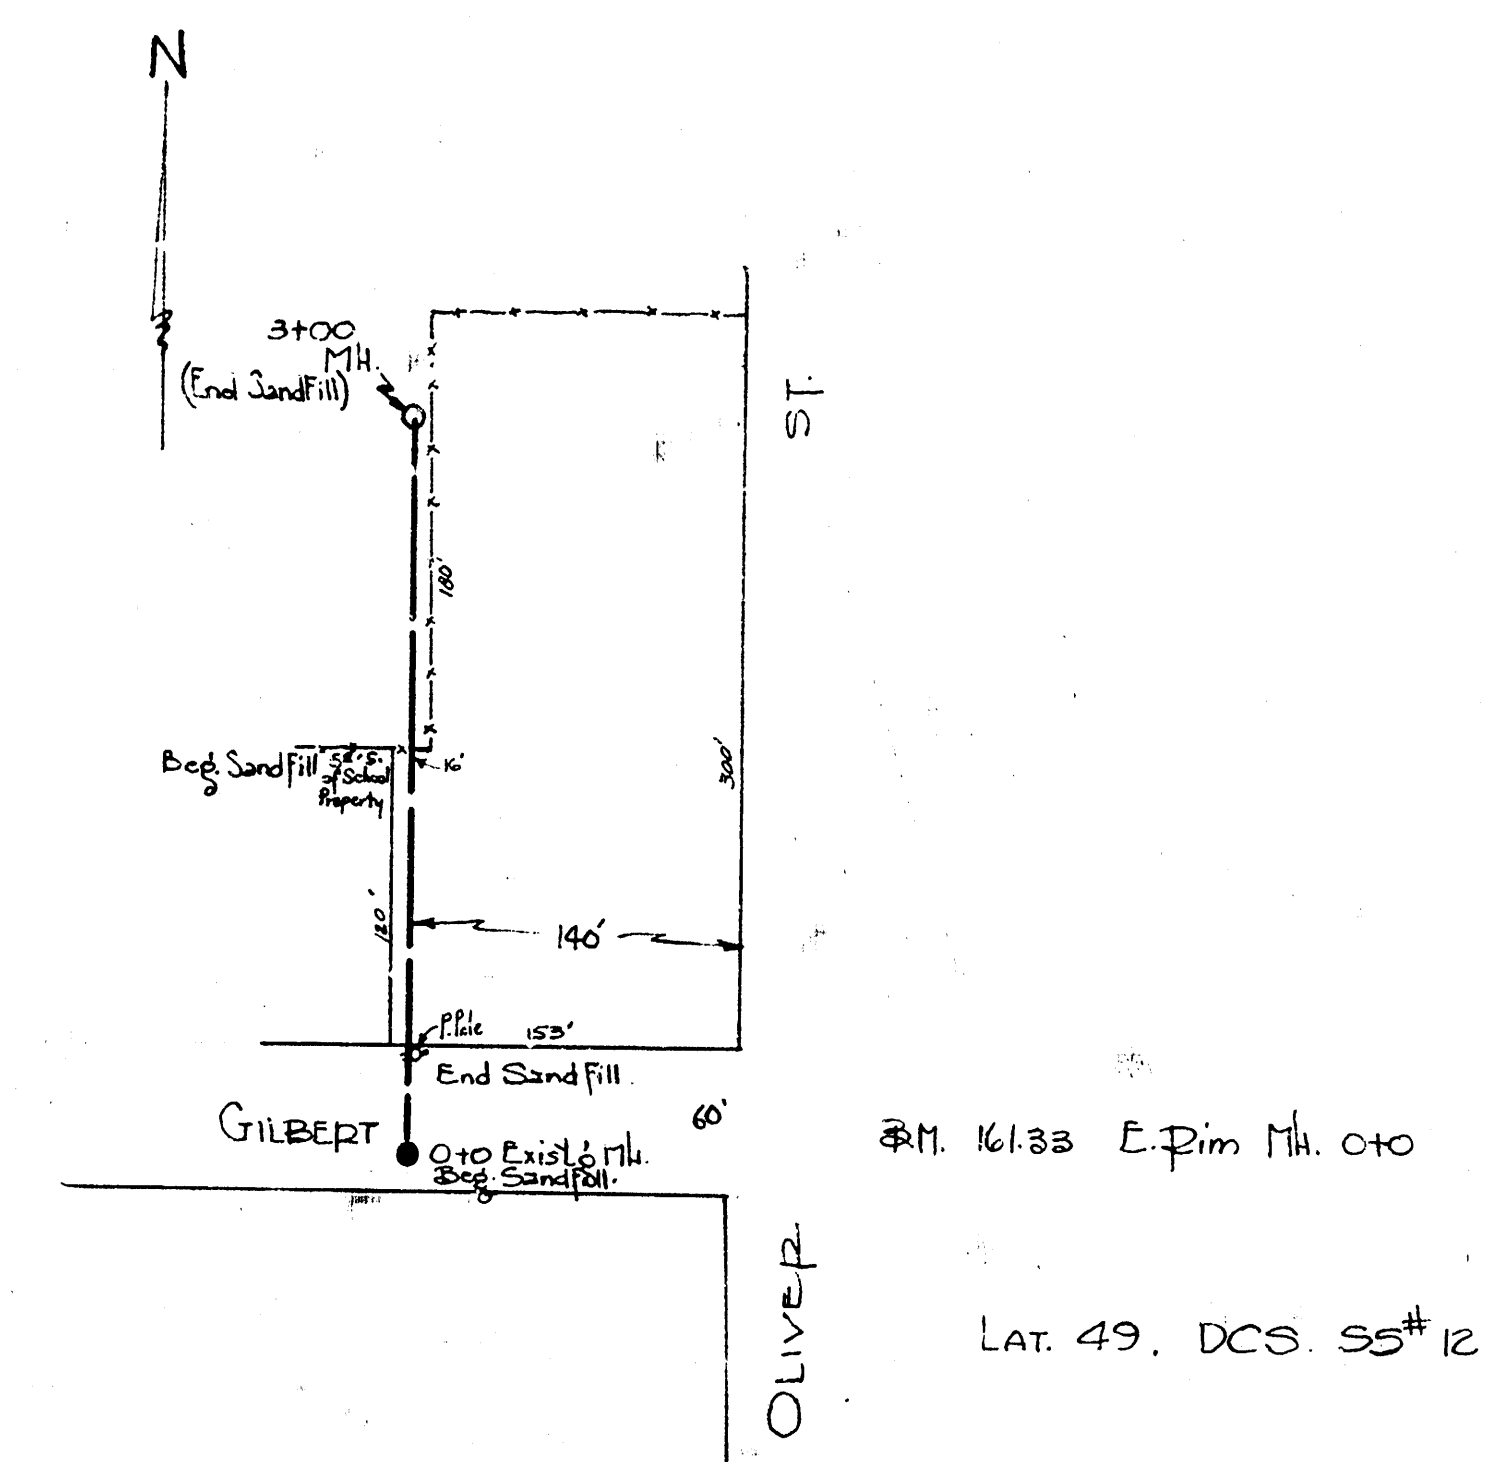
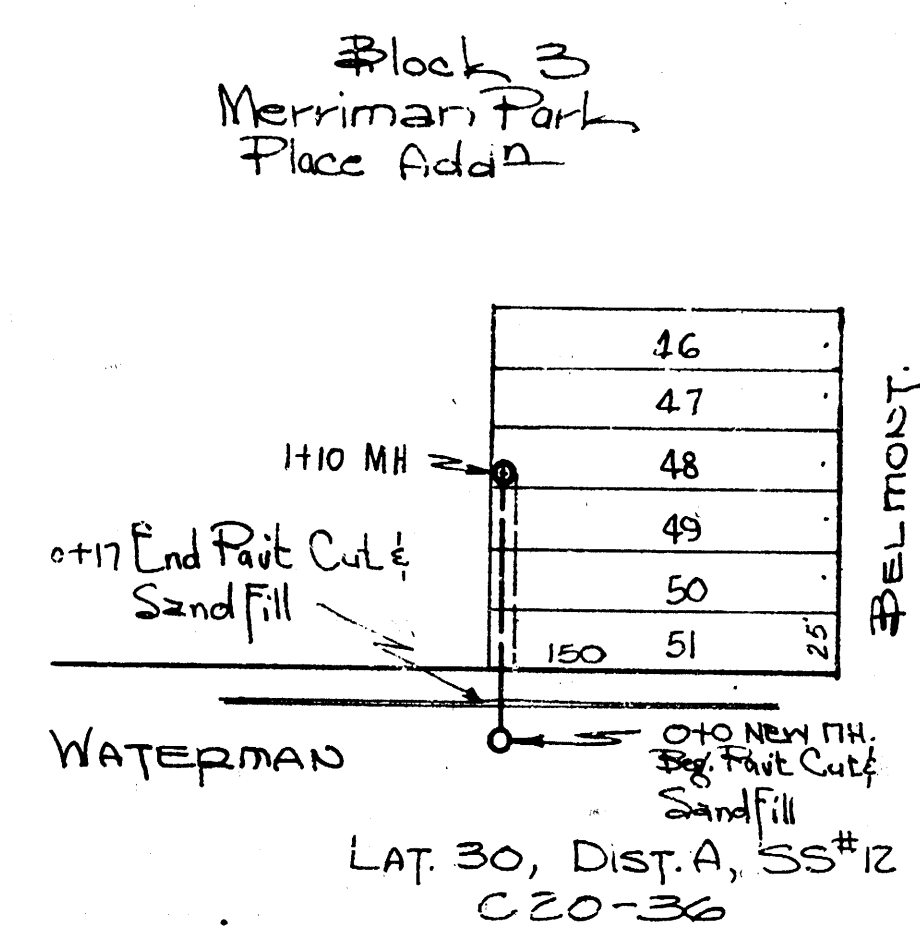


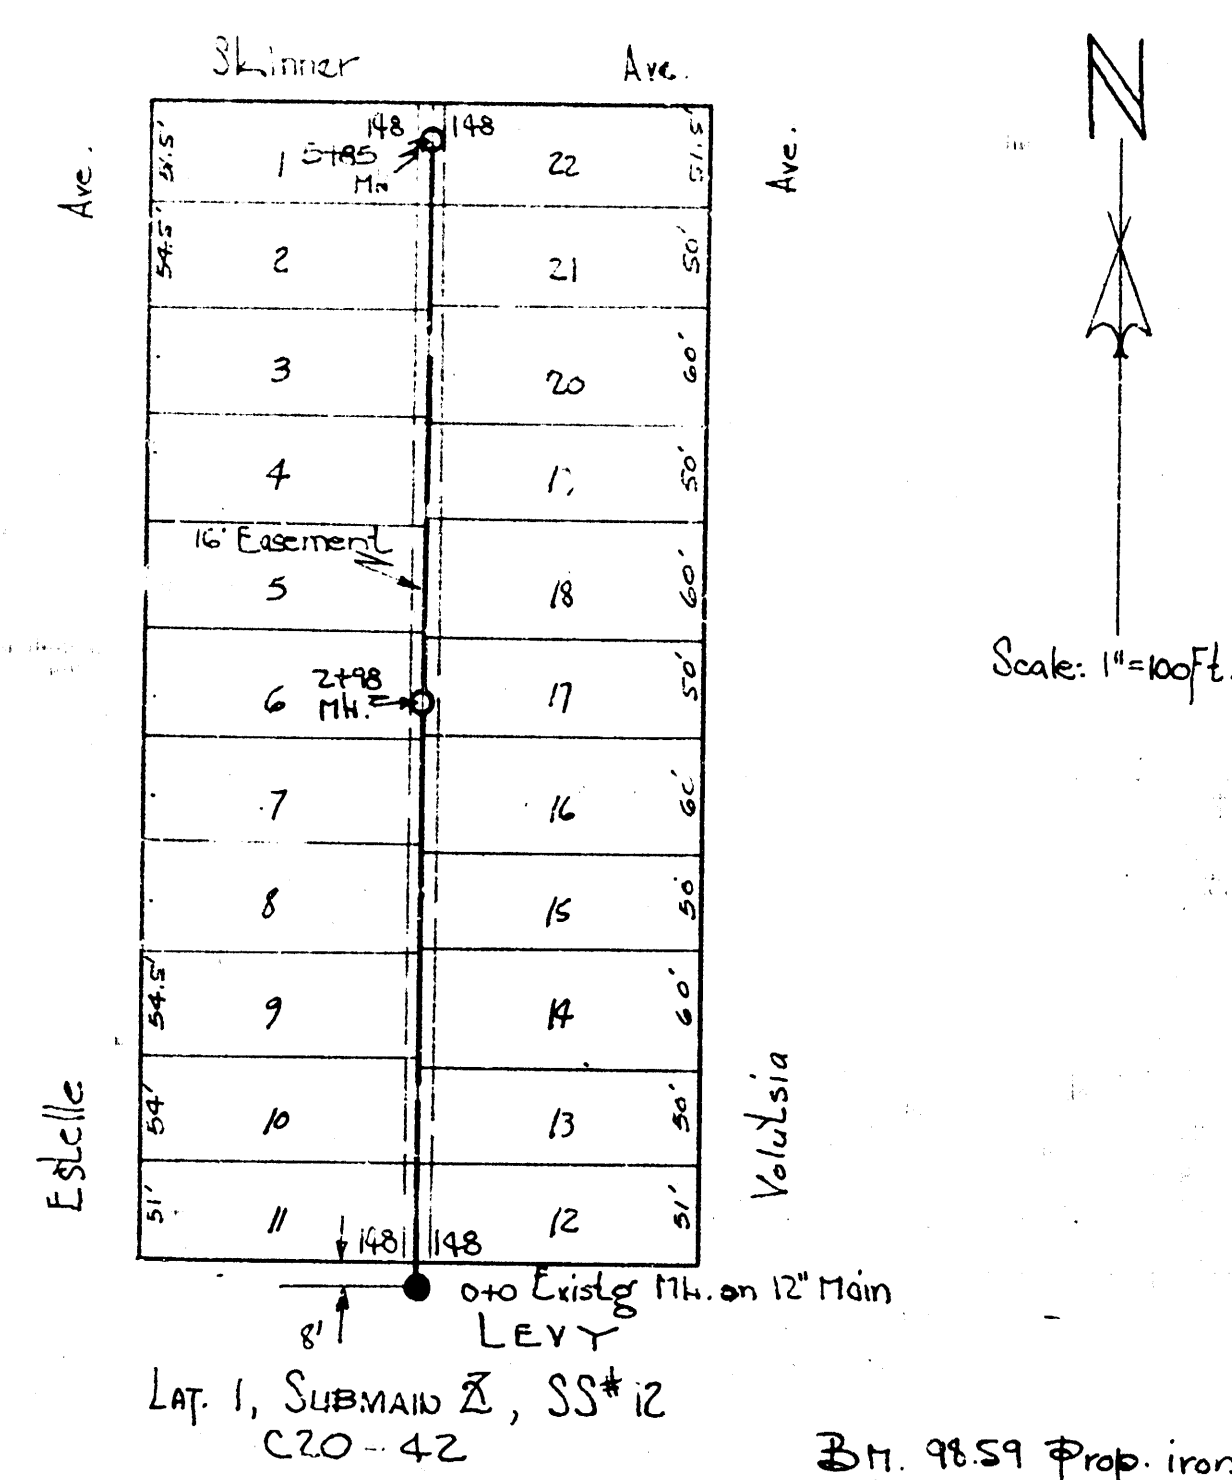

LAT. 49, D.C.S. SS#12
 LAT. 30, DISTRICT A, SANITARY SEWER #12
 LAT. 1, SUBMAIN Z, SANITARY SEWER #12
 CITY OF WICHITA, KANSAS
 L.K. White City Engineer
 DATE 5-24-50 Proj. No. C20