LAT. 2 of S.S. No. I

B.M. 103.81 K. in Kensler
c. of approach walk N.
S.W. cor. Boston + Santa Fe.

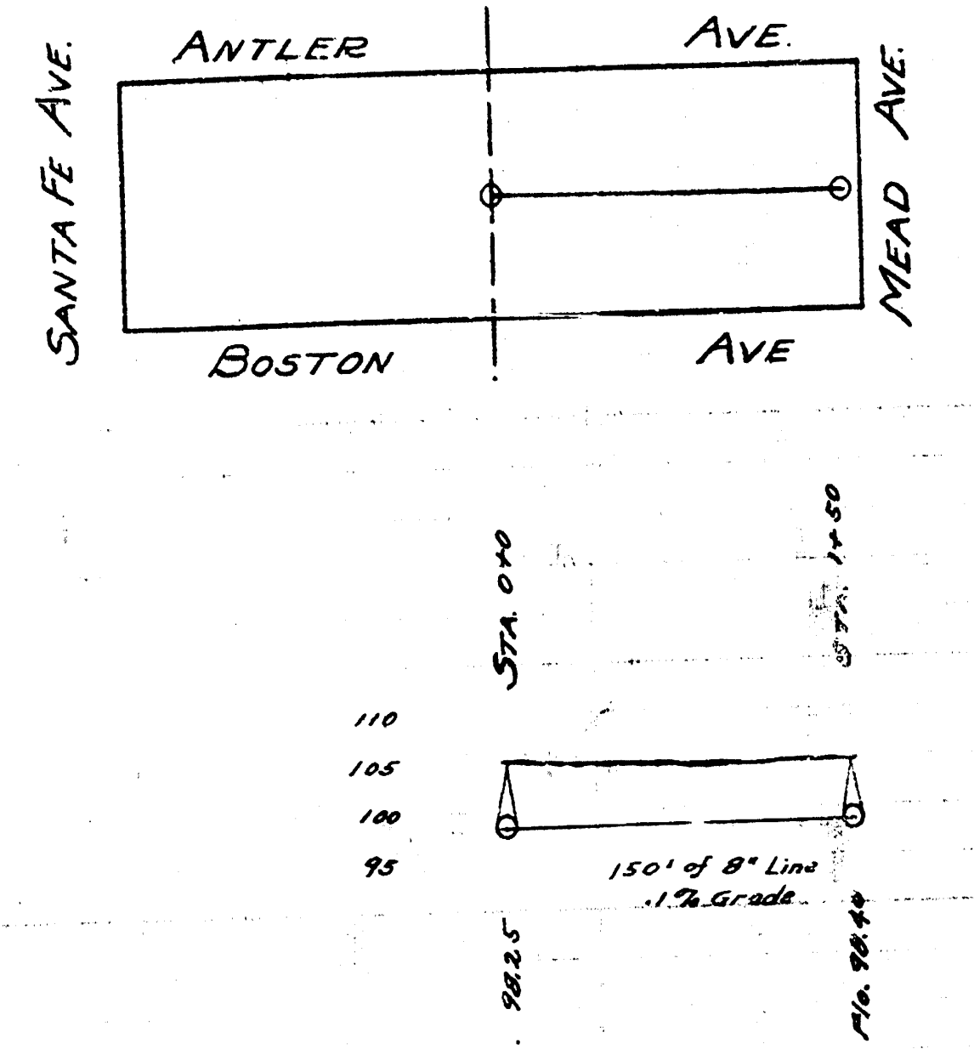
ANTLER
AVE.
SANTA FE AVE.
MEAD AVE.
BOSTON
AVE
STA. 0+0
STA. 1+50
110
105
100
95
150' of 8" Line
.1% Grade
Flo. 98.25
Flo. 98.40

LAT. 1 - DIST. G. S.S. No. 12.

B.M. - 131.09 x on curb
N.E. cor Estelle & 13th.

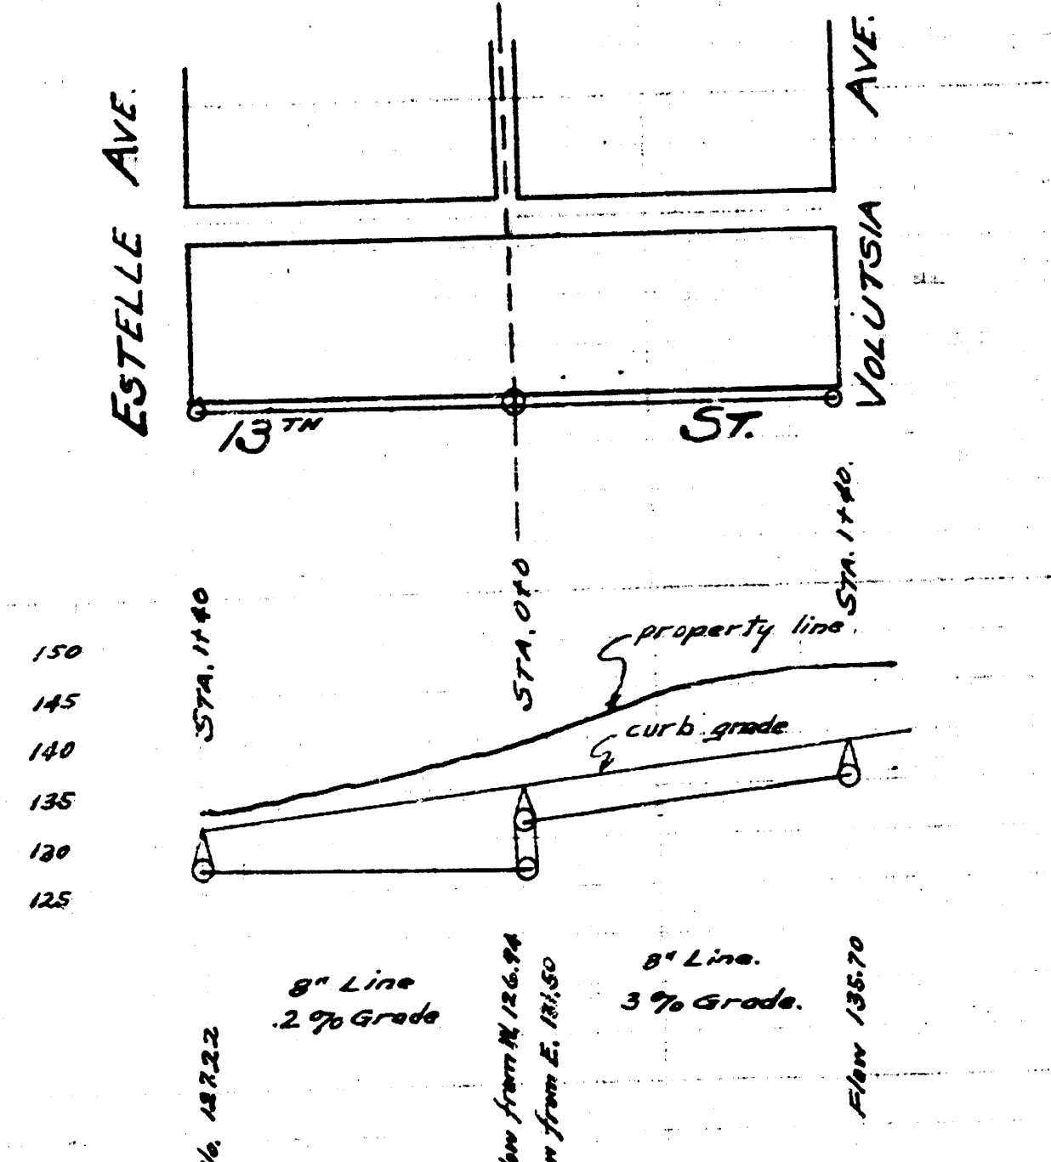
ESTELLE AVE.
VOLUTSIA AVE.
13TH
ST.
STA. 1+40
STA. 0+0
STA. 1+40
property line
curb grade
150
145
140
135
130
125
8" Line
.2% Grade
8" Line.
3% Grade.
Flo. 127.22
Flow from W. 126.94
Flow from E. 131.50
Flow 135.70

LAT. A., DIST. 1. S.S. No. 12.

B.M. 106.96 B in Buckeridge - West and cb. ret.
SW. cor. Hillside & Gilbert.

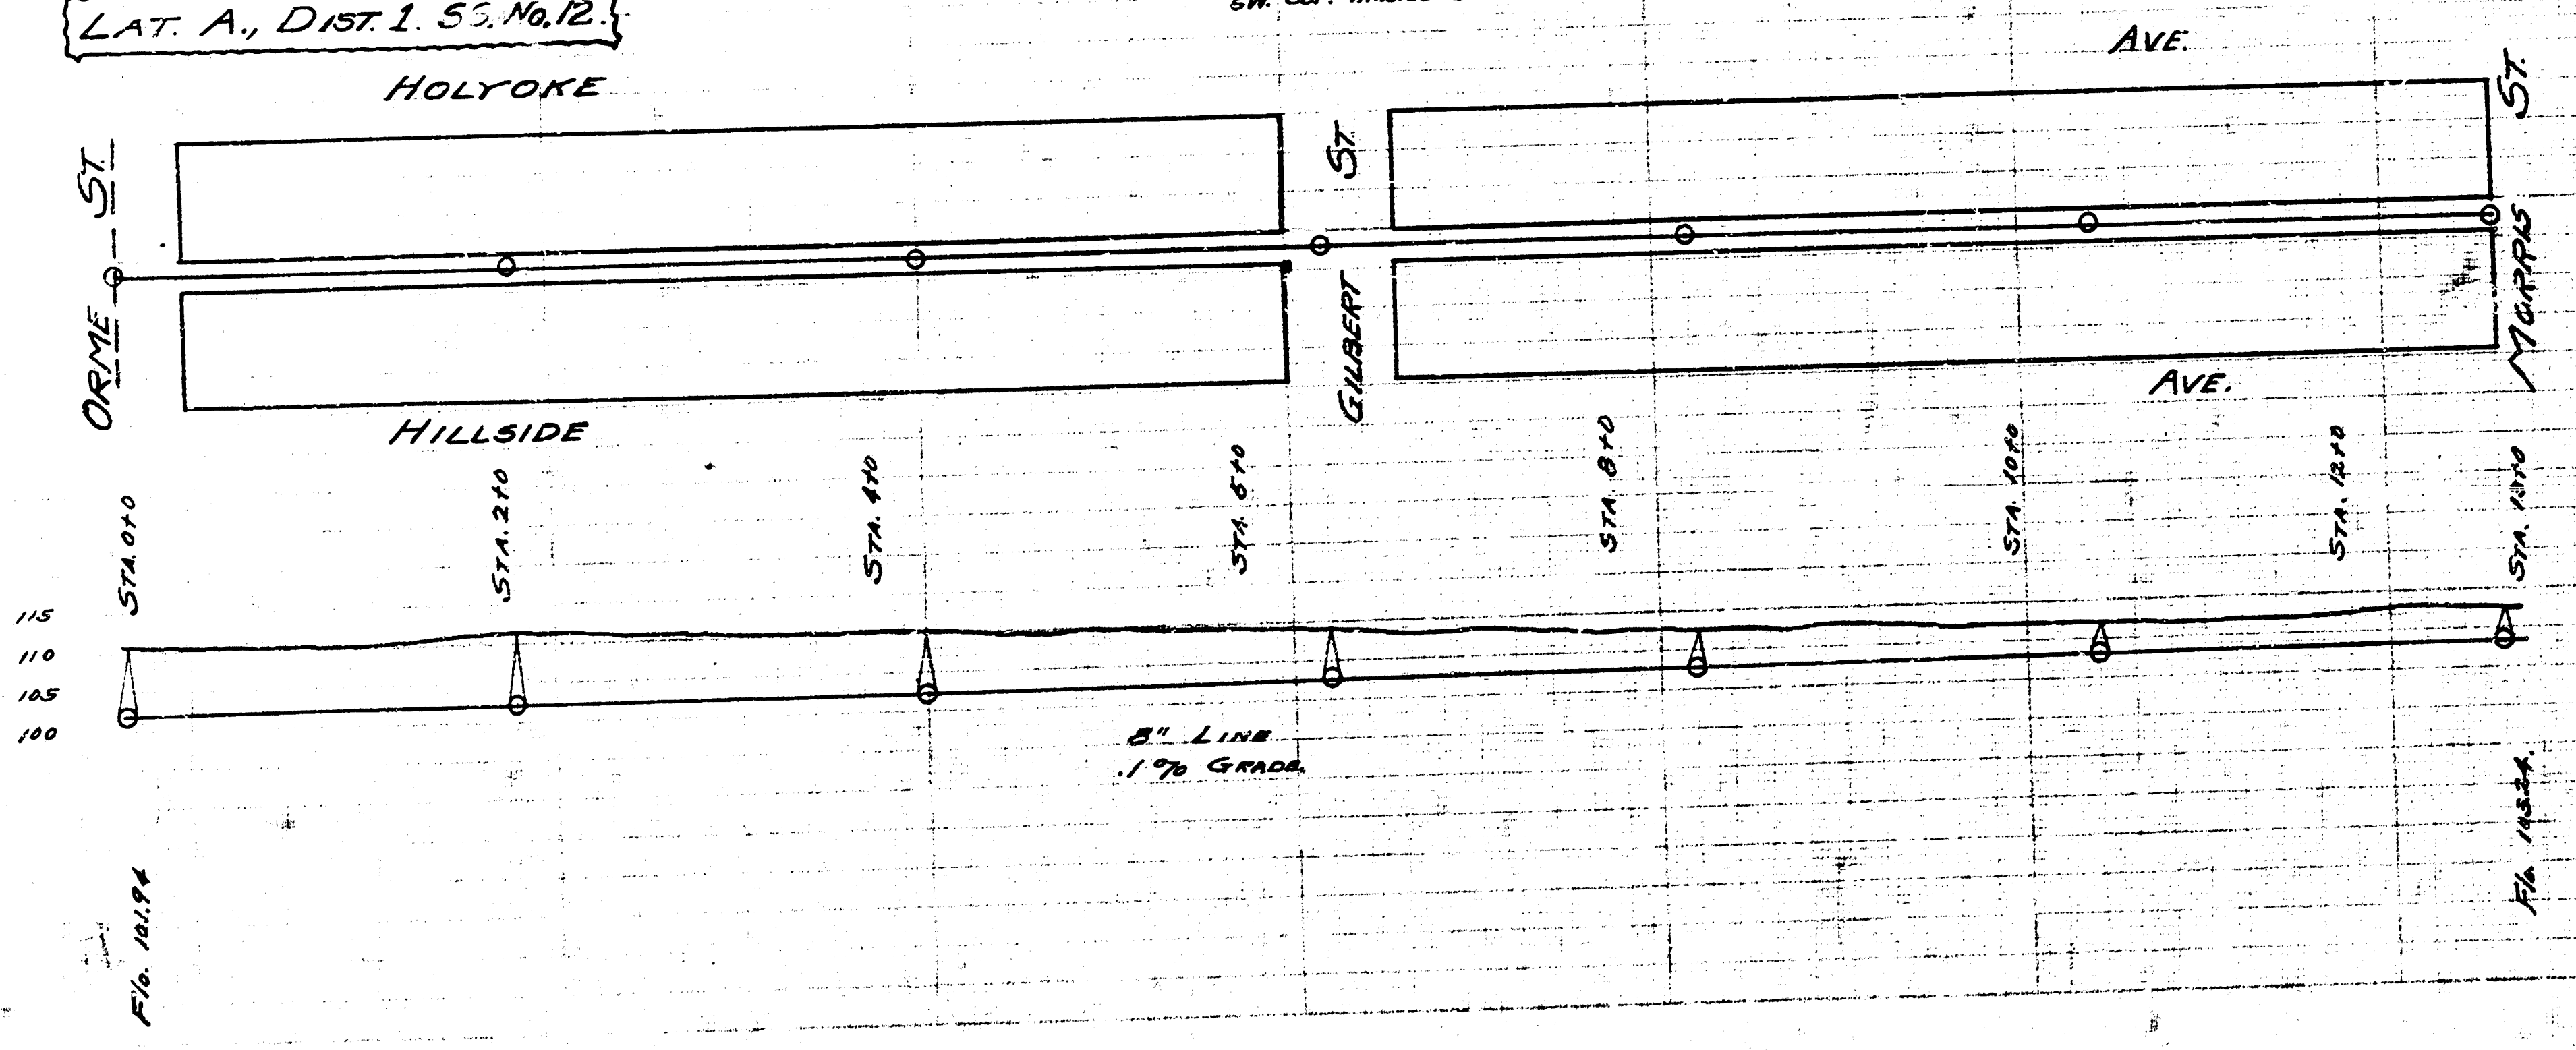
HOLYOKE
AVE.
ORME ST.
GILBERT ST.
MARRIS ST.
HILLSIDE
AVE.
STA. 0+0
STA. 2+0
STA. 4+0
STA. 6+0
STA. 8+0
STA. 10+0
STA. 12+0
STA. 13+0
115
110
105
100
8" LINE
.1% GRADE.
Flo. 101.94
Flo. 103.24.