




NOTE: Contractor to contact
Monsieur Hertel
Phone No. 682-1415
prior to construction.

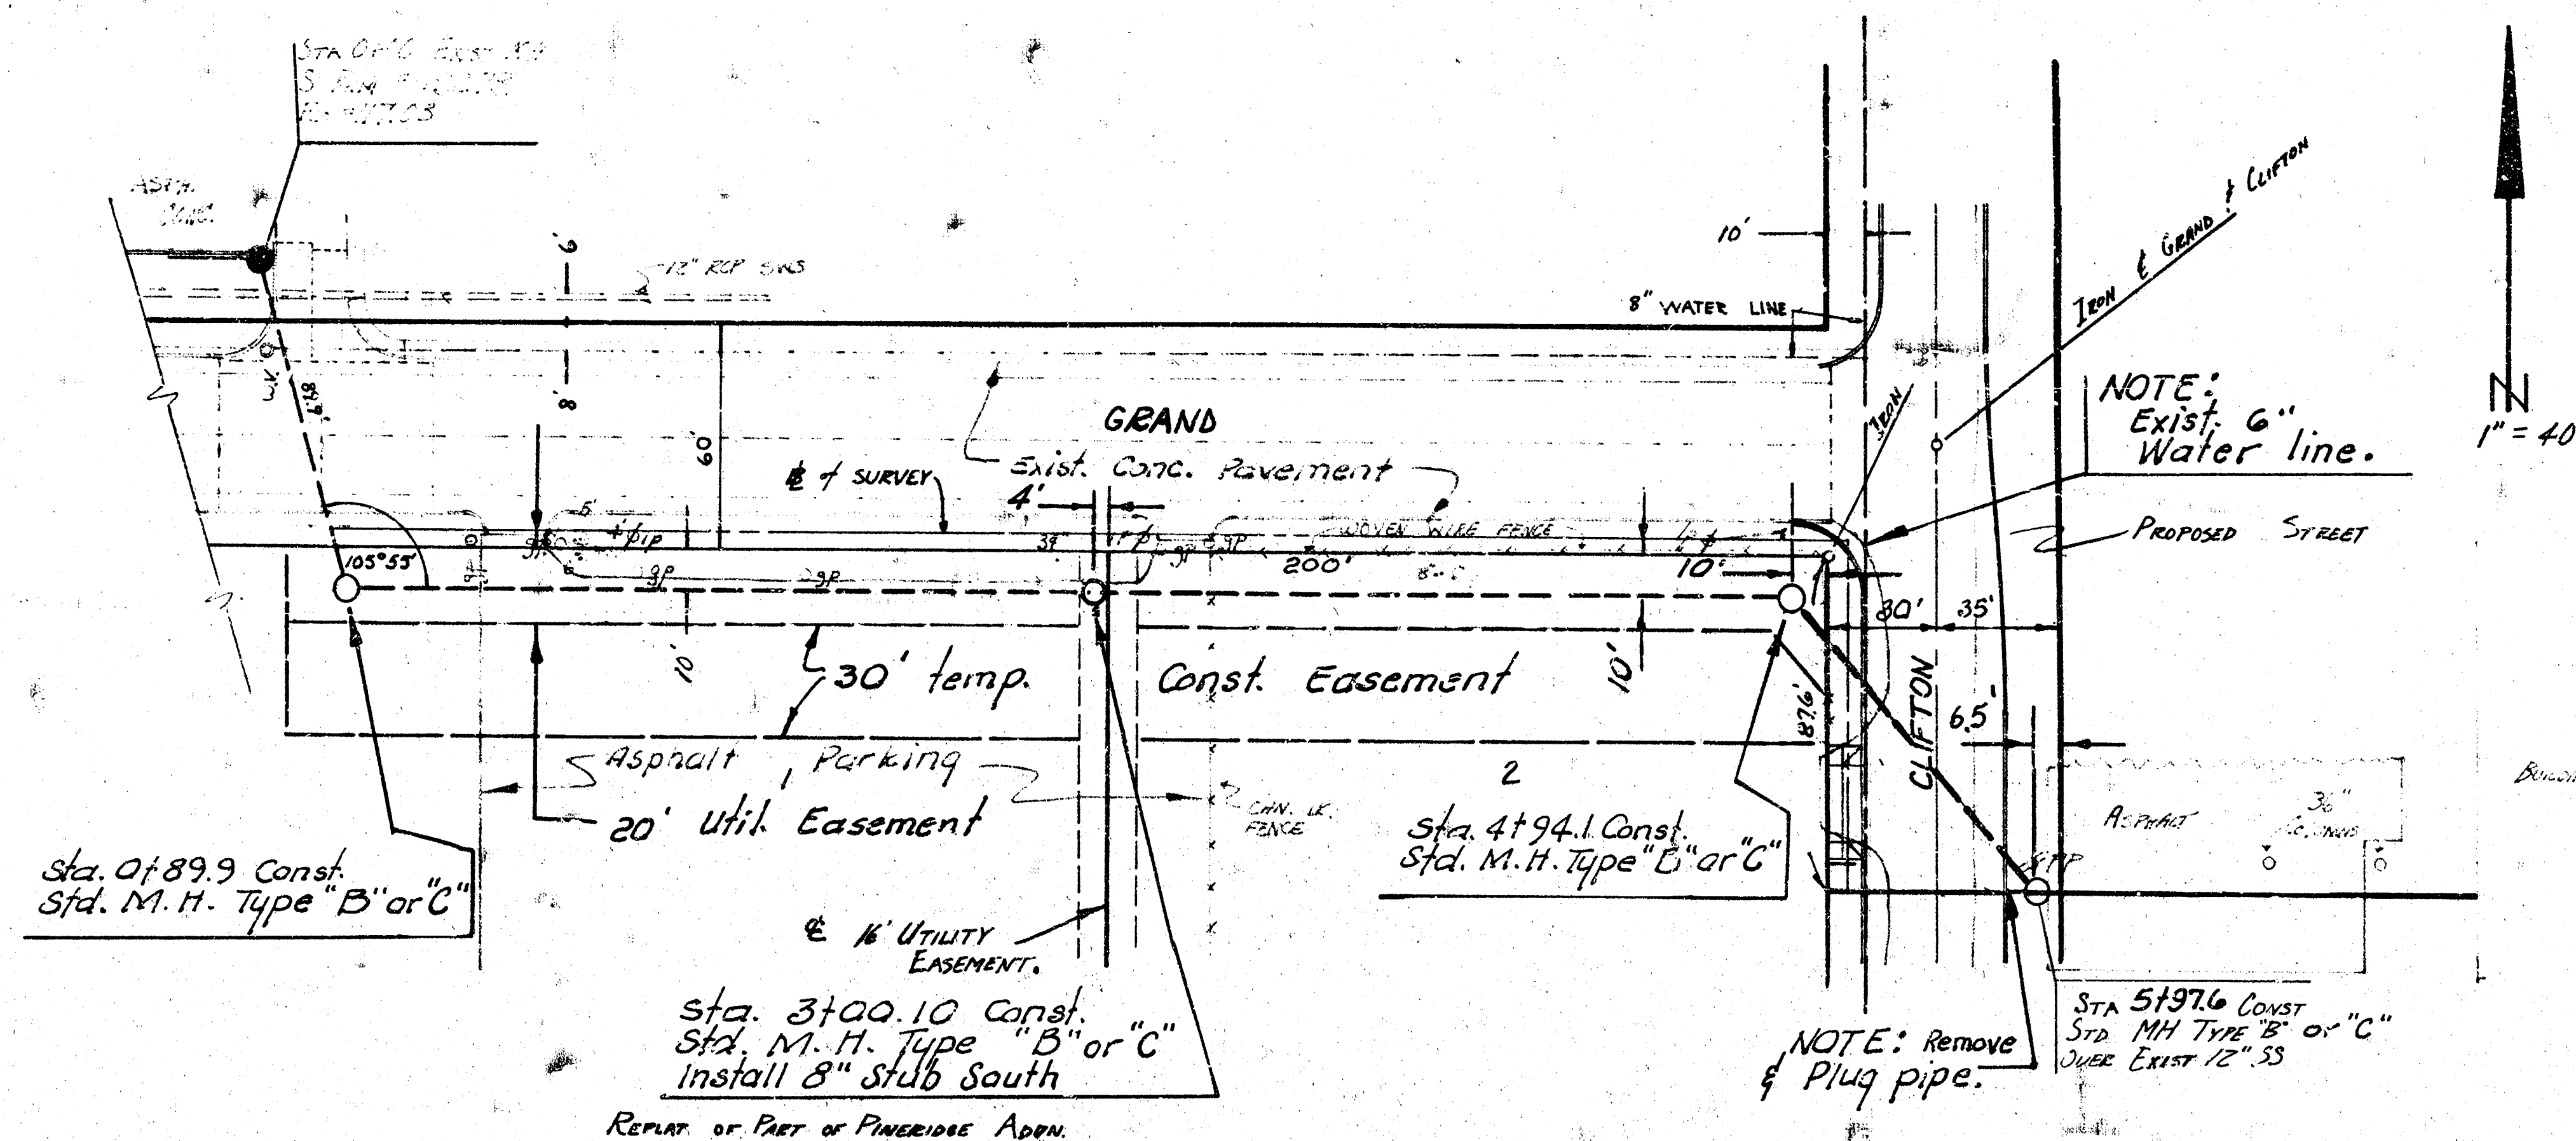

BM 14329 "O" ON W CURB CLIFTON
77' N of E GRAND.

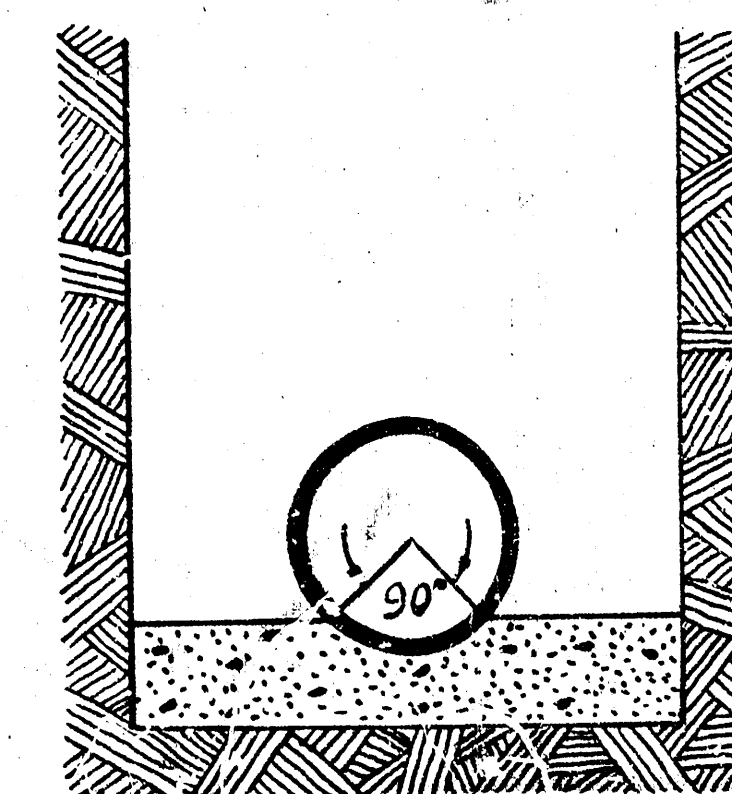

IMPROVED BEDDING
Minimum depth of granular embedment shall be one-fourth pipe diameter but in no case less than 4".

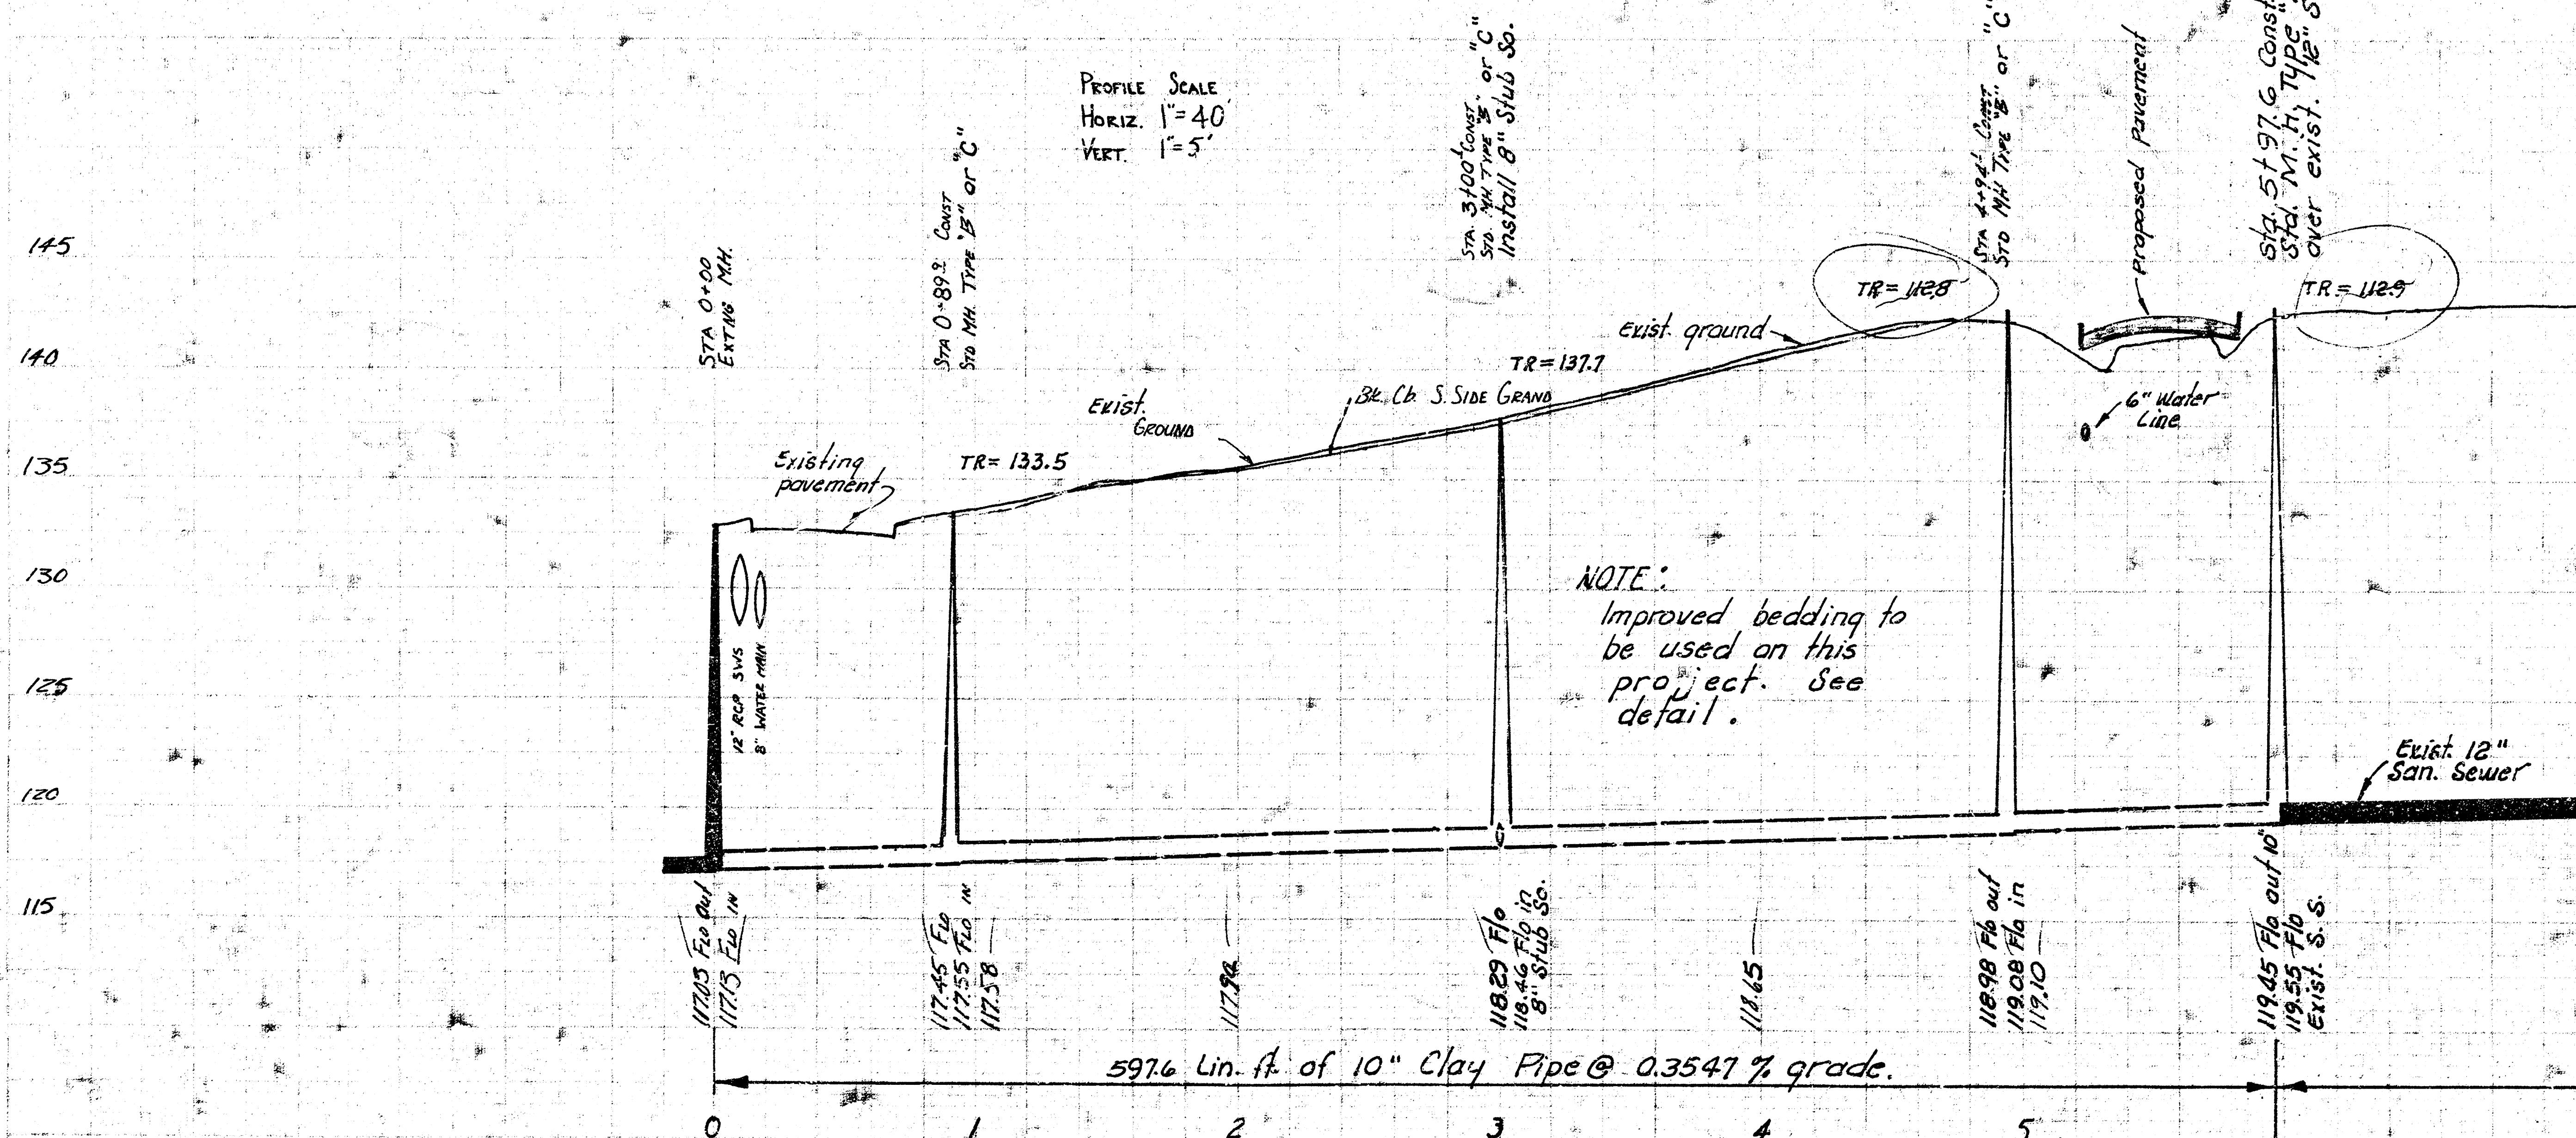

LAT. B, DISTRICT 4, S. S. NO. 12
CITY OF WICHITA, KANSAS
R. W. LINN — CITY ENGINEER
APRIL 1975 PROJECT NO. DBKL 574098