

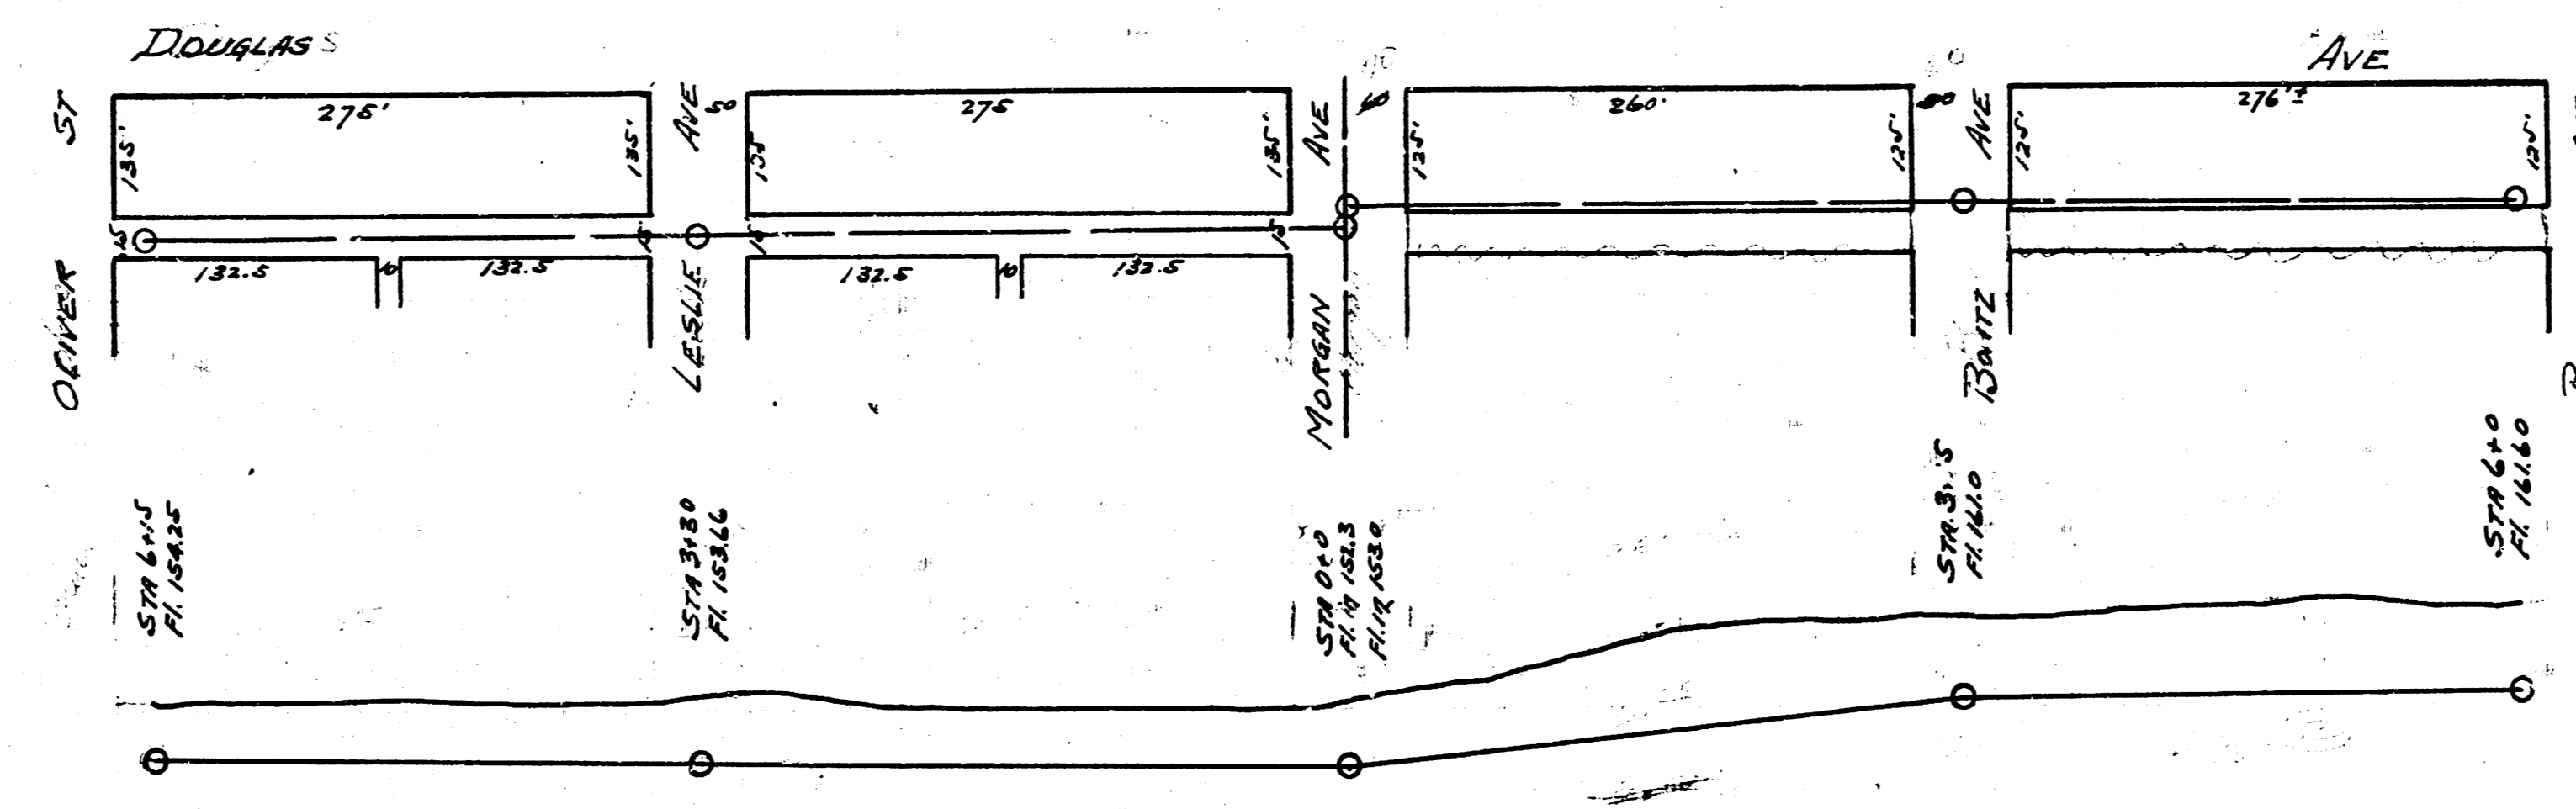


LAYOUT PLAN OF LAT. J. DIST. 6. S.S. NO 12.

North


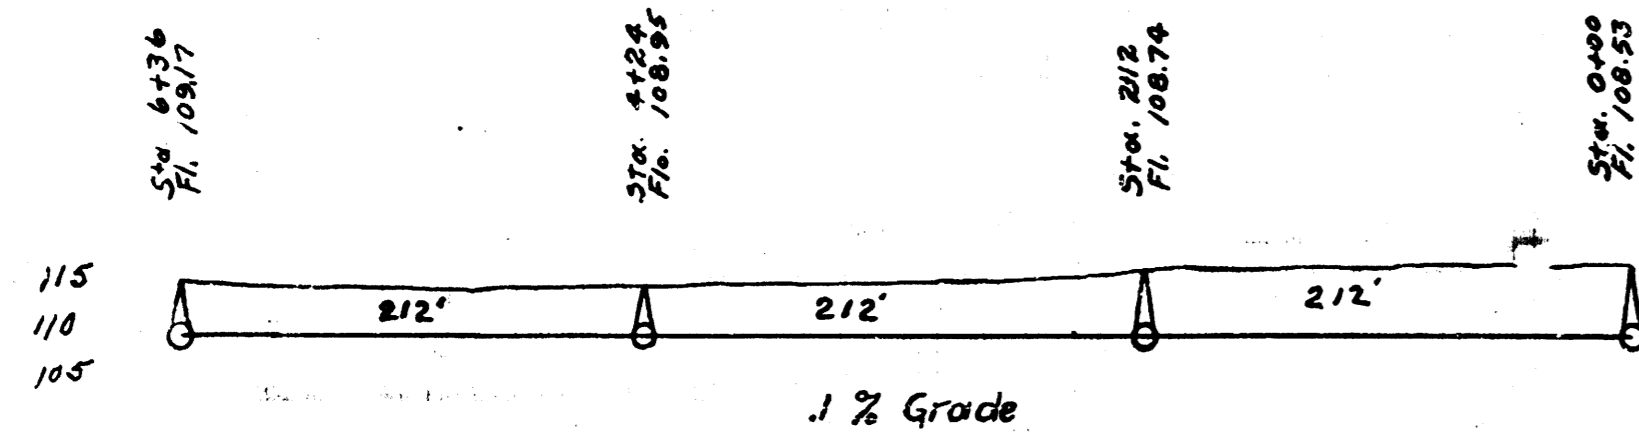


CHANGE IN SEWER LINES - IN THE ALLEY SOUTH  
 OF DOUGLAS BETWEEN OLIVER AND FORECAST.  
 Lot 1, Dist 6, S.S. 12.






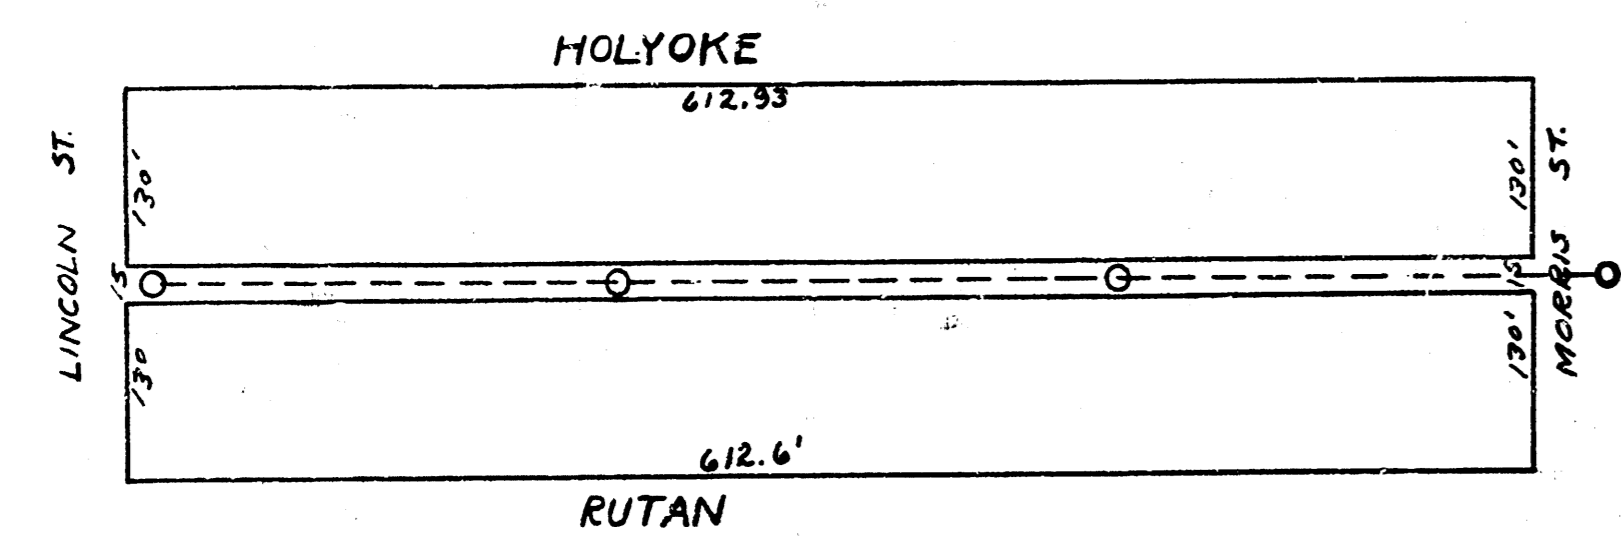


BM - 1147.3 on top of rim edge S.S. of M.H. in Morris at Alley bet. Holyoke and Rutan.

LAT. I DIST. 6 S.S. 12.







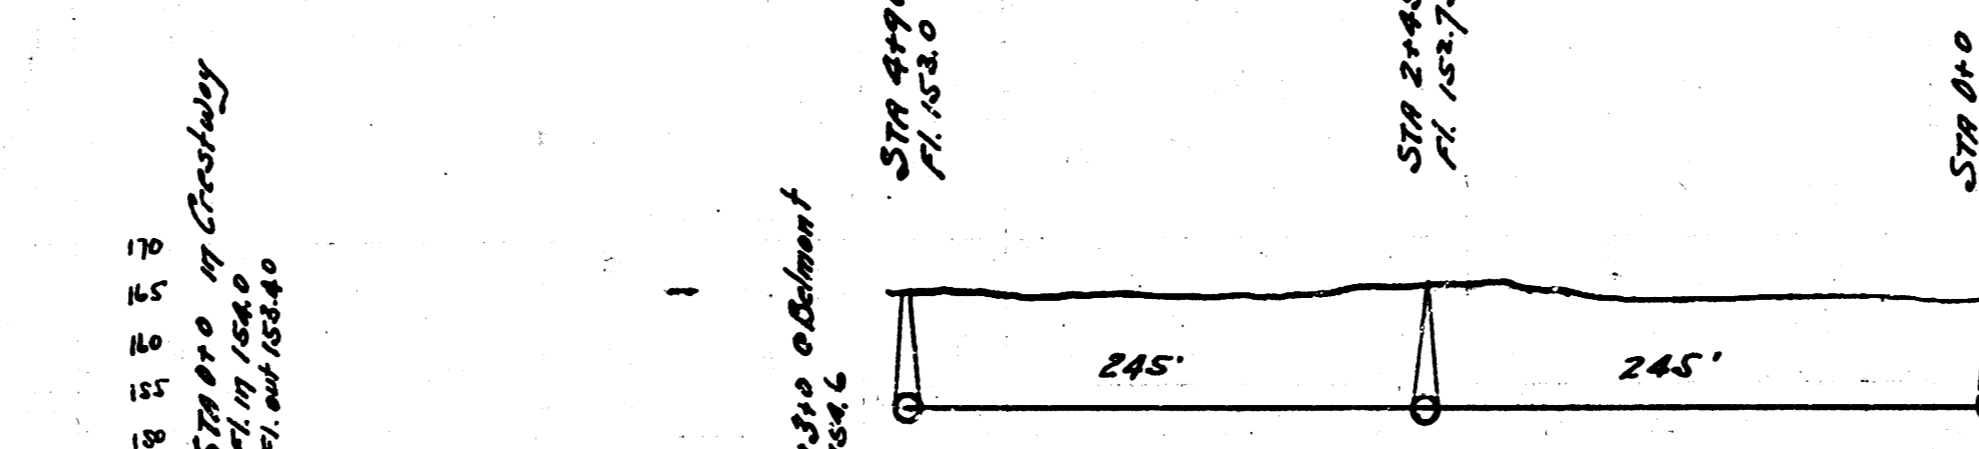
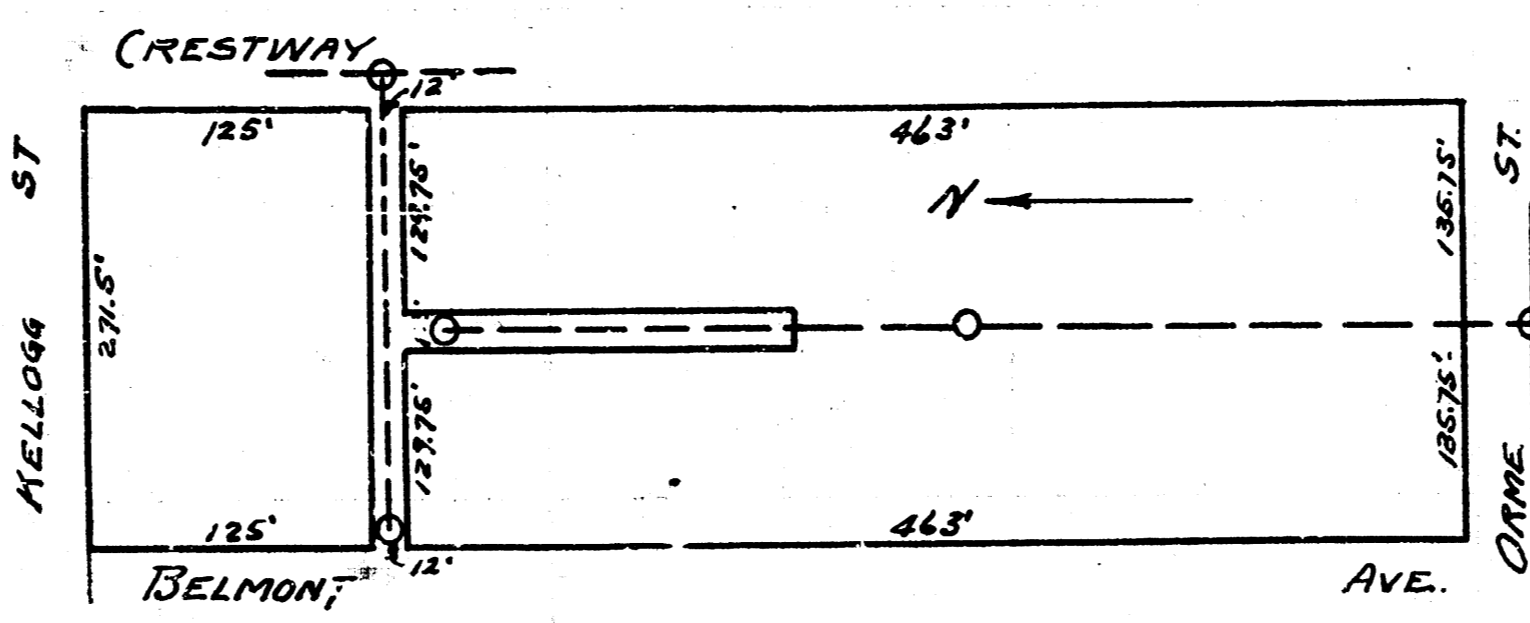


8" line 27% (line in alley S. of Kellogg)

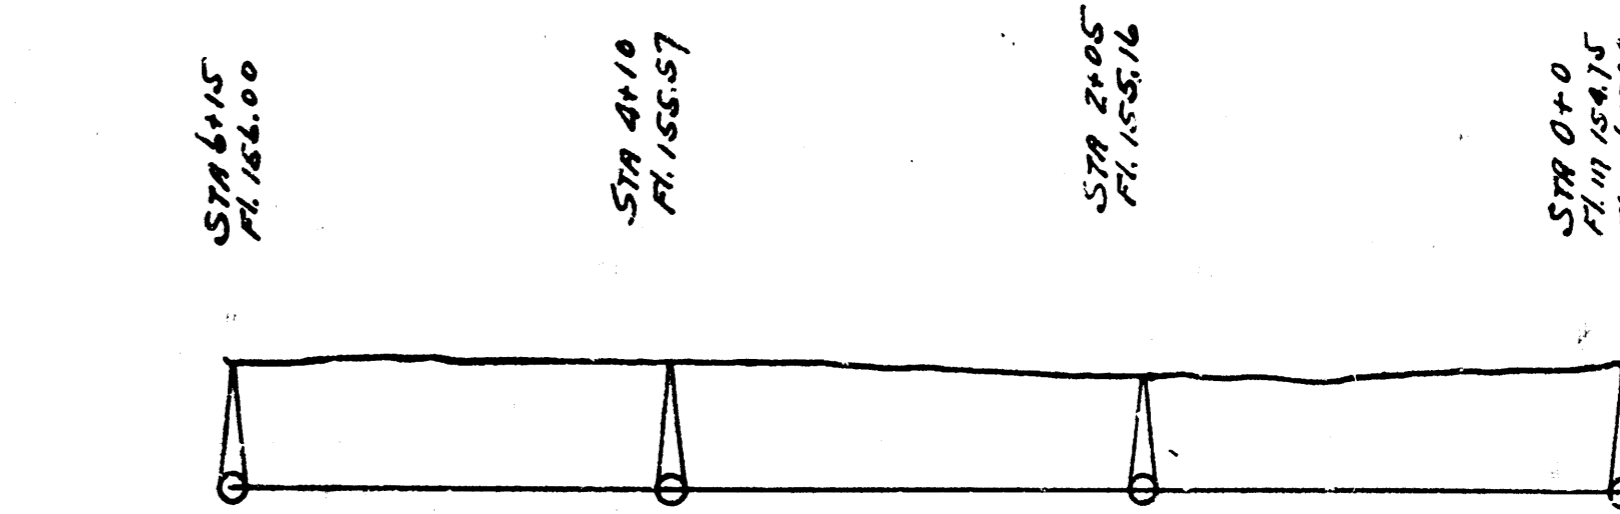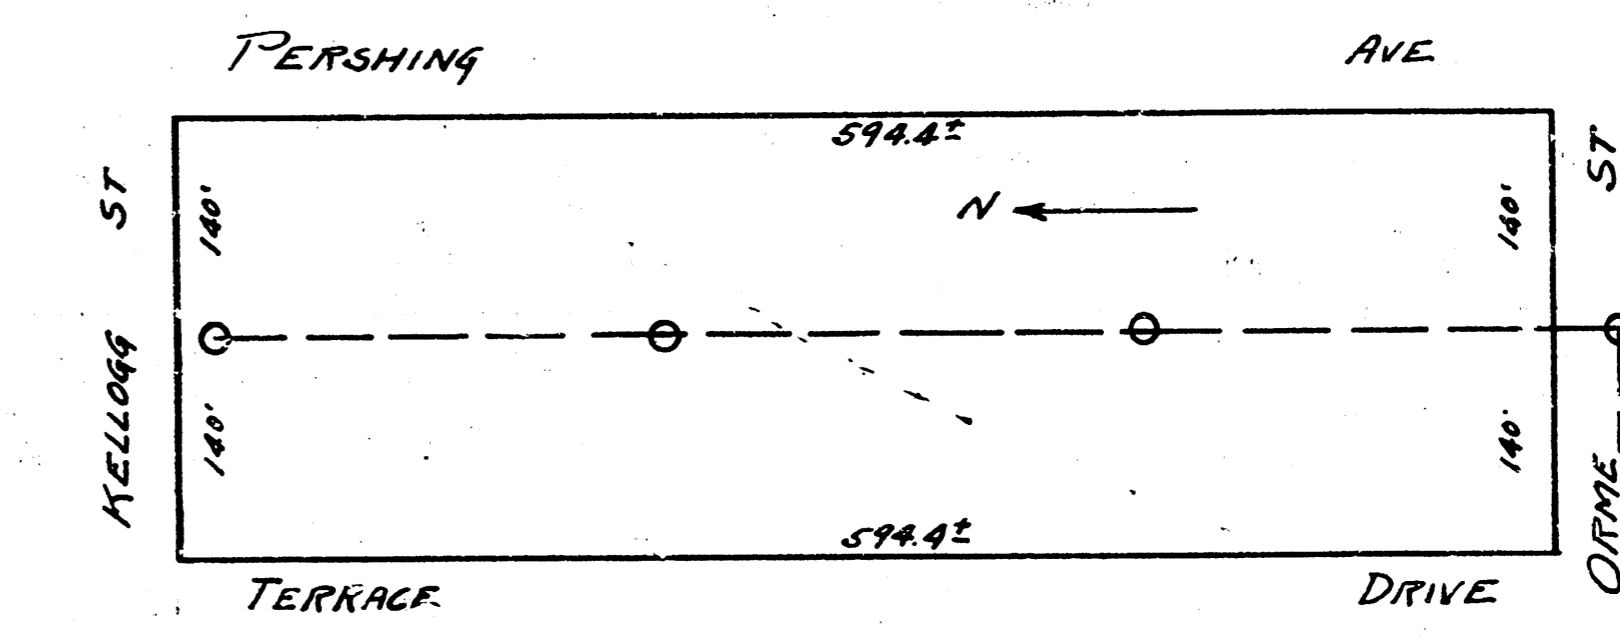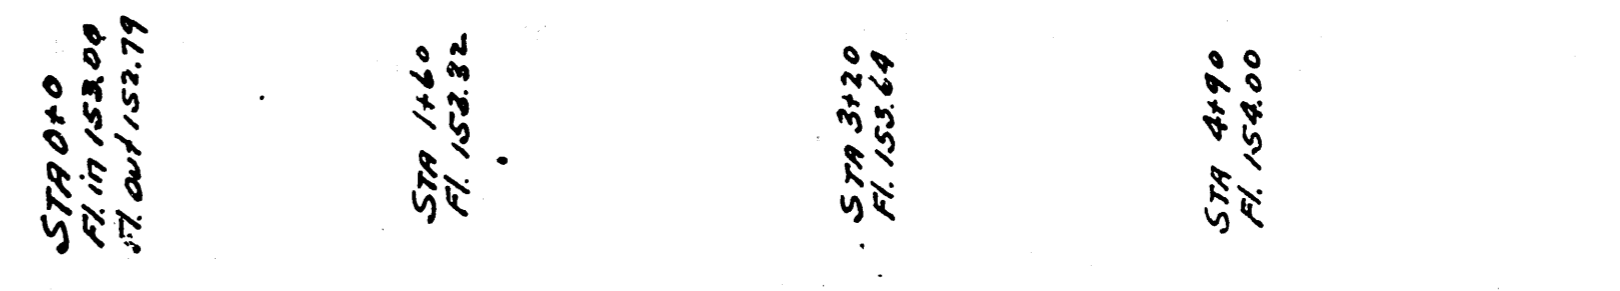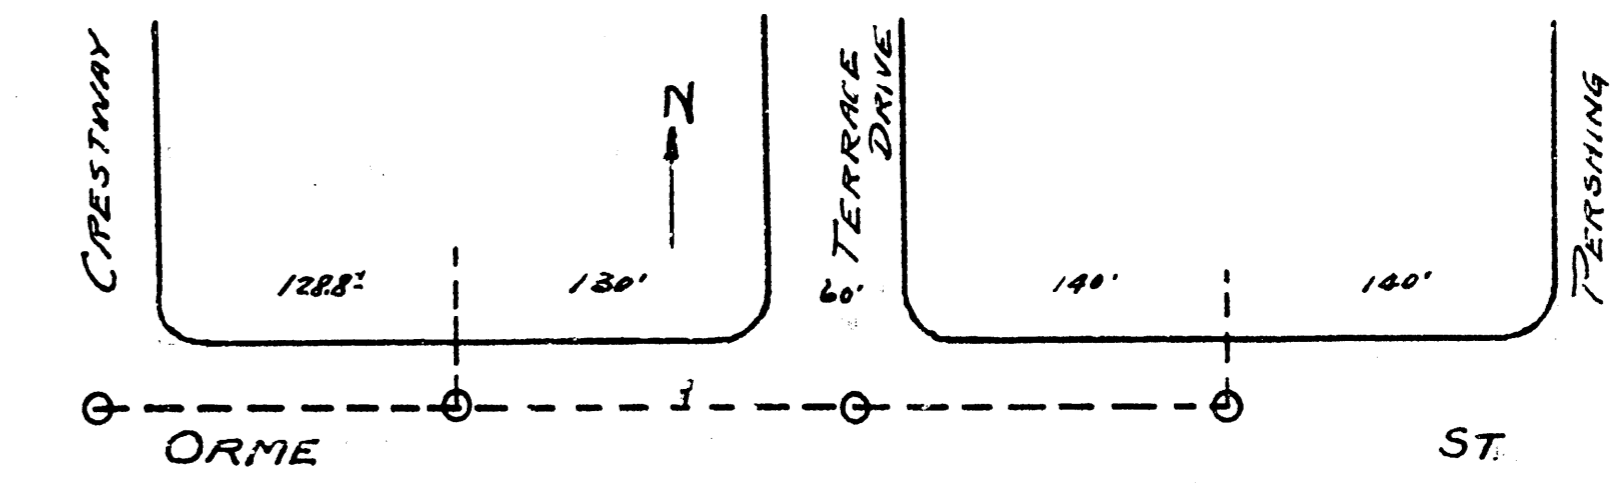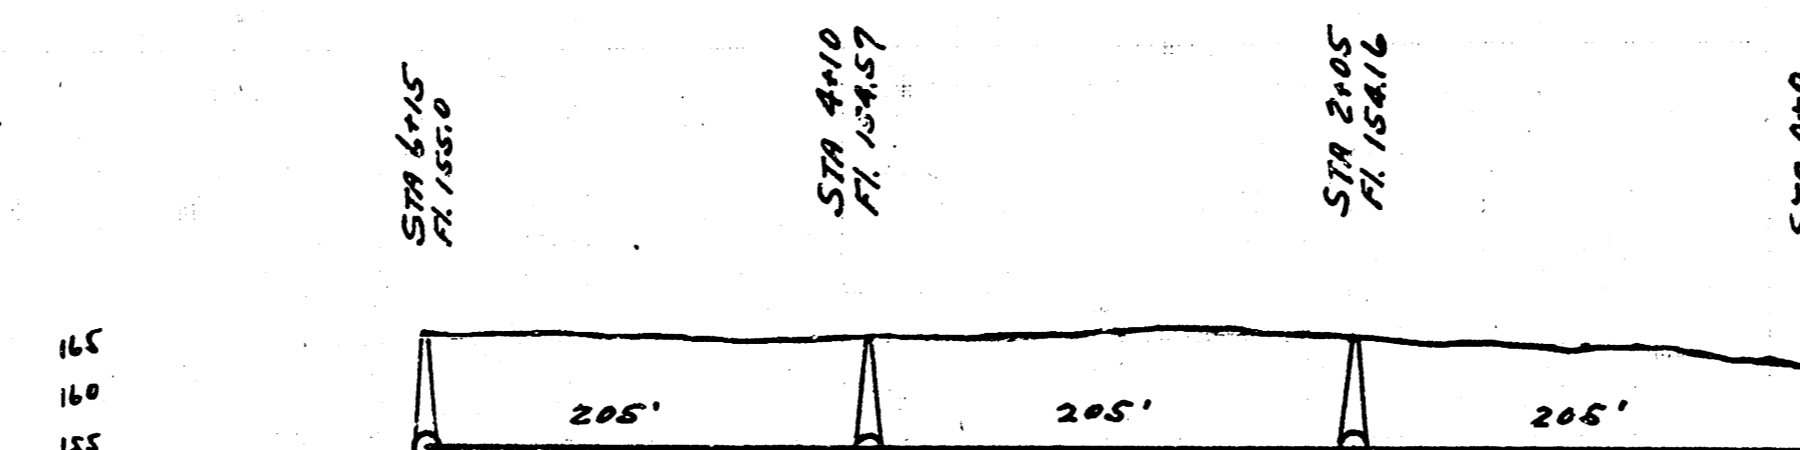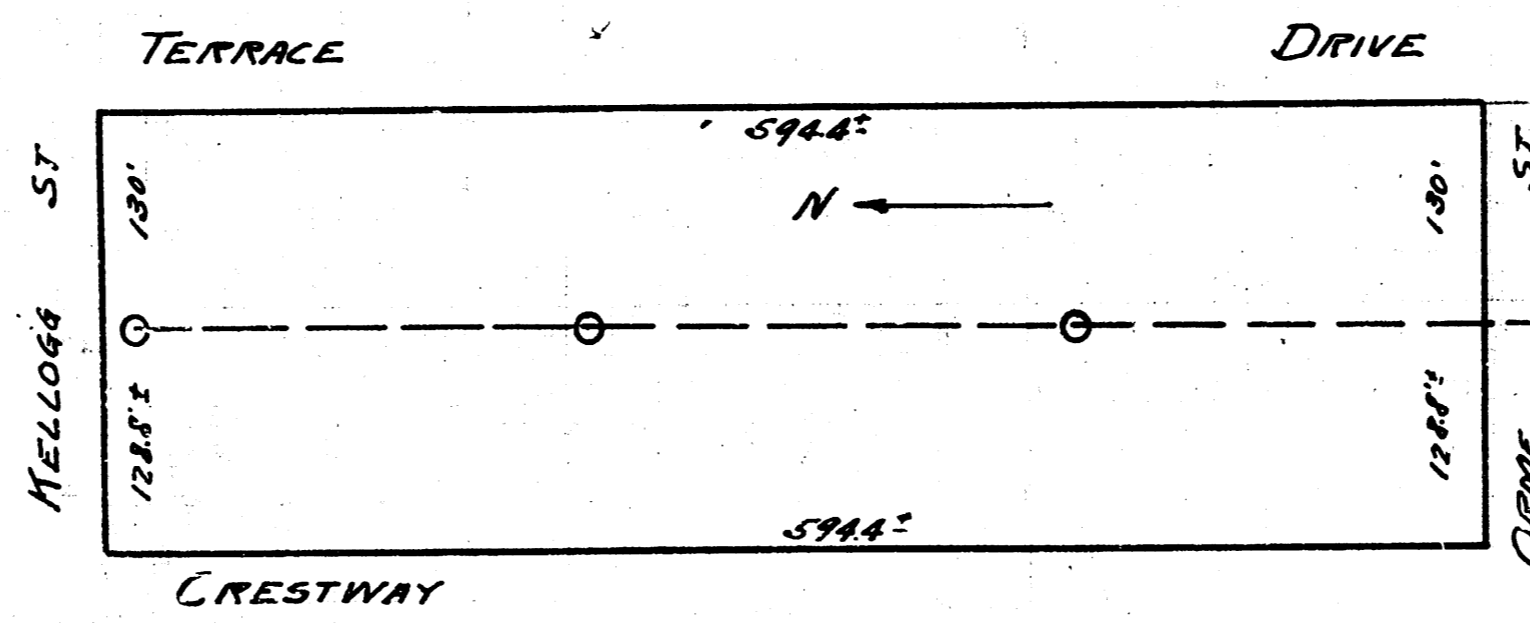

BM. 163.04 iron NW. cor. of Belmont and Orme.







LAT. K, DIST. 6, S.S. 12.

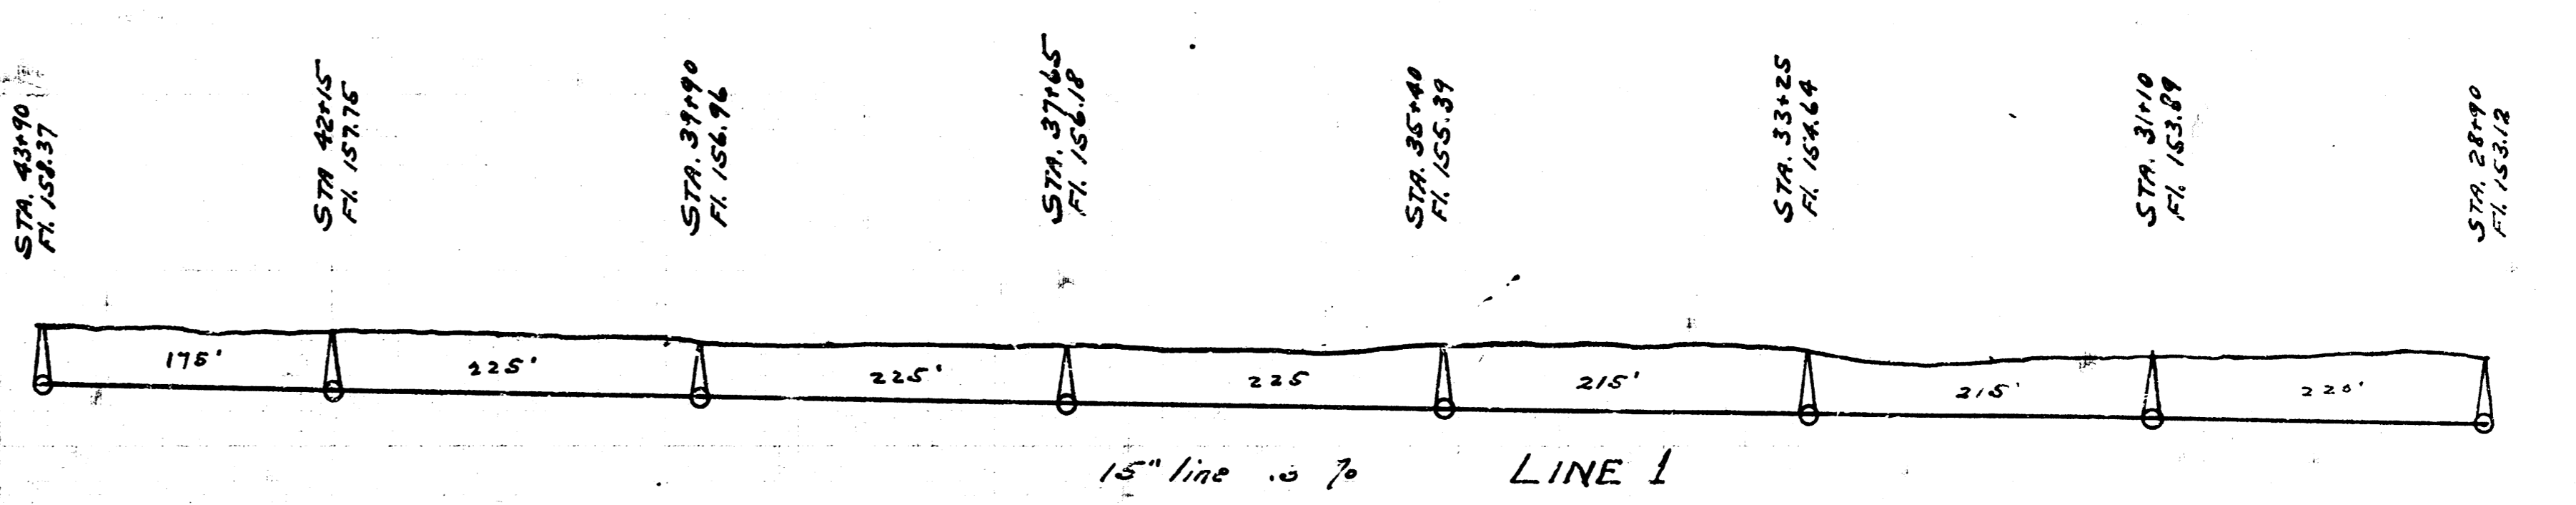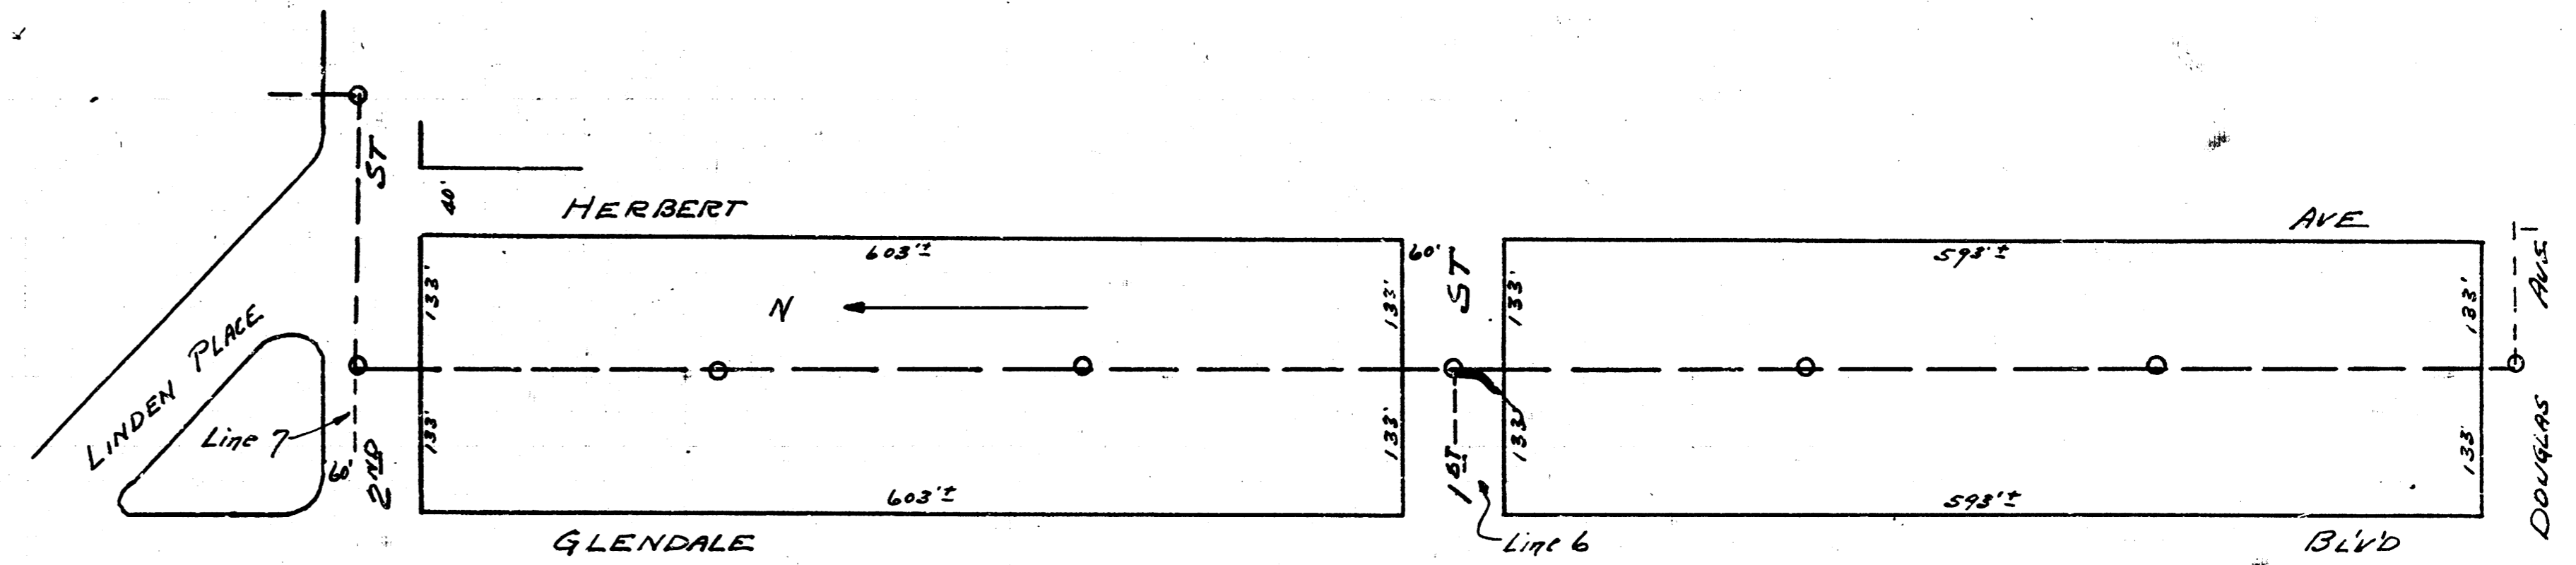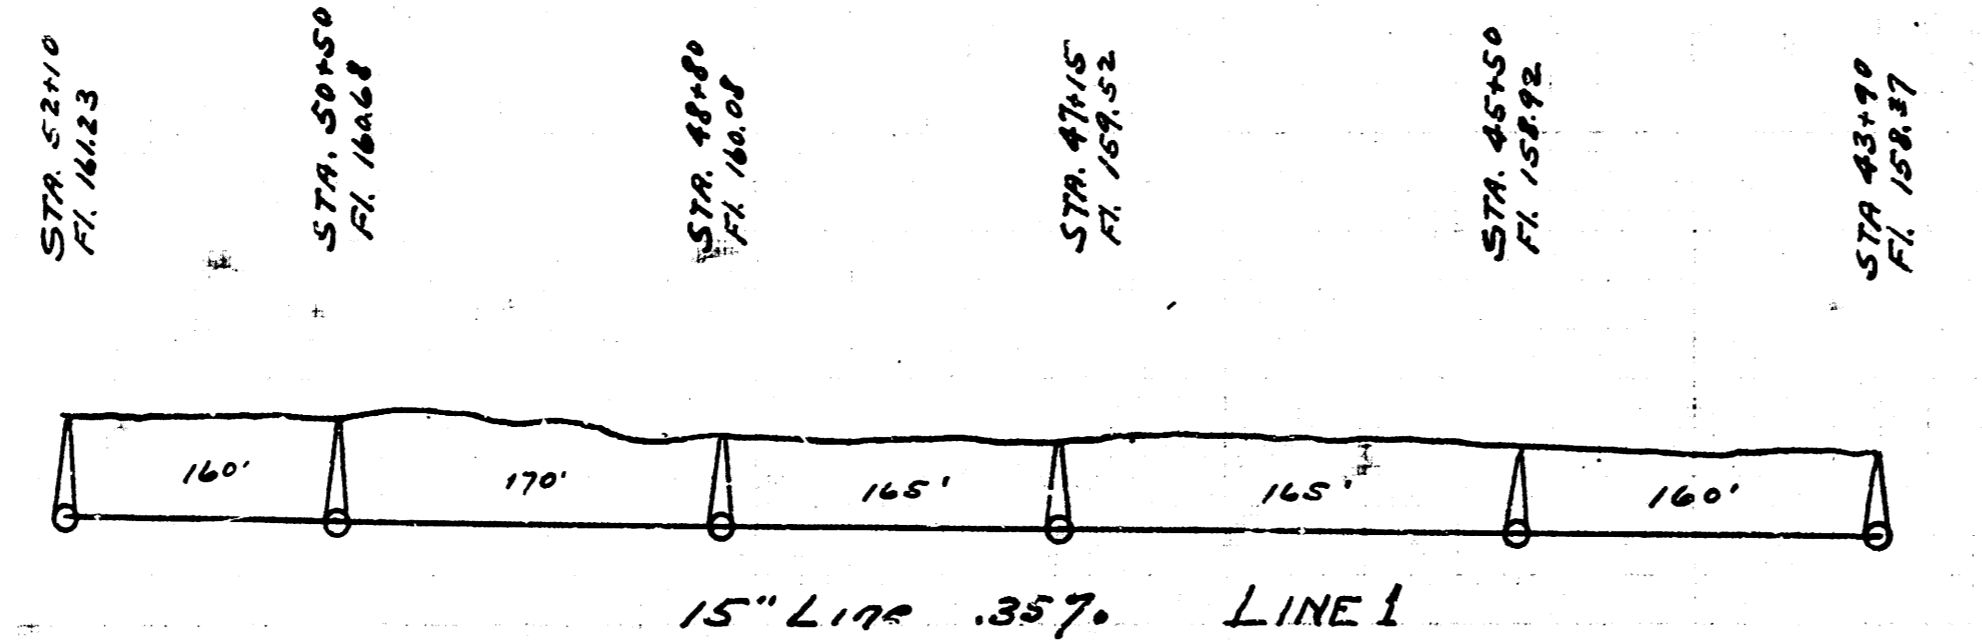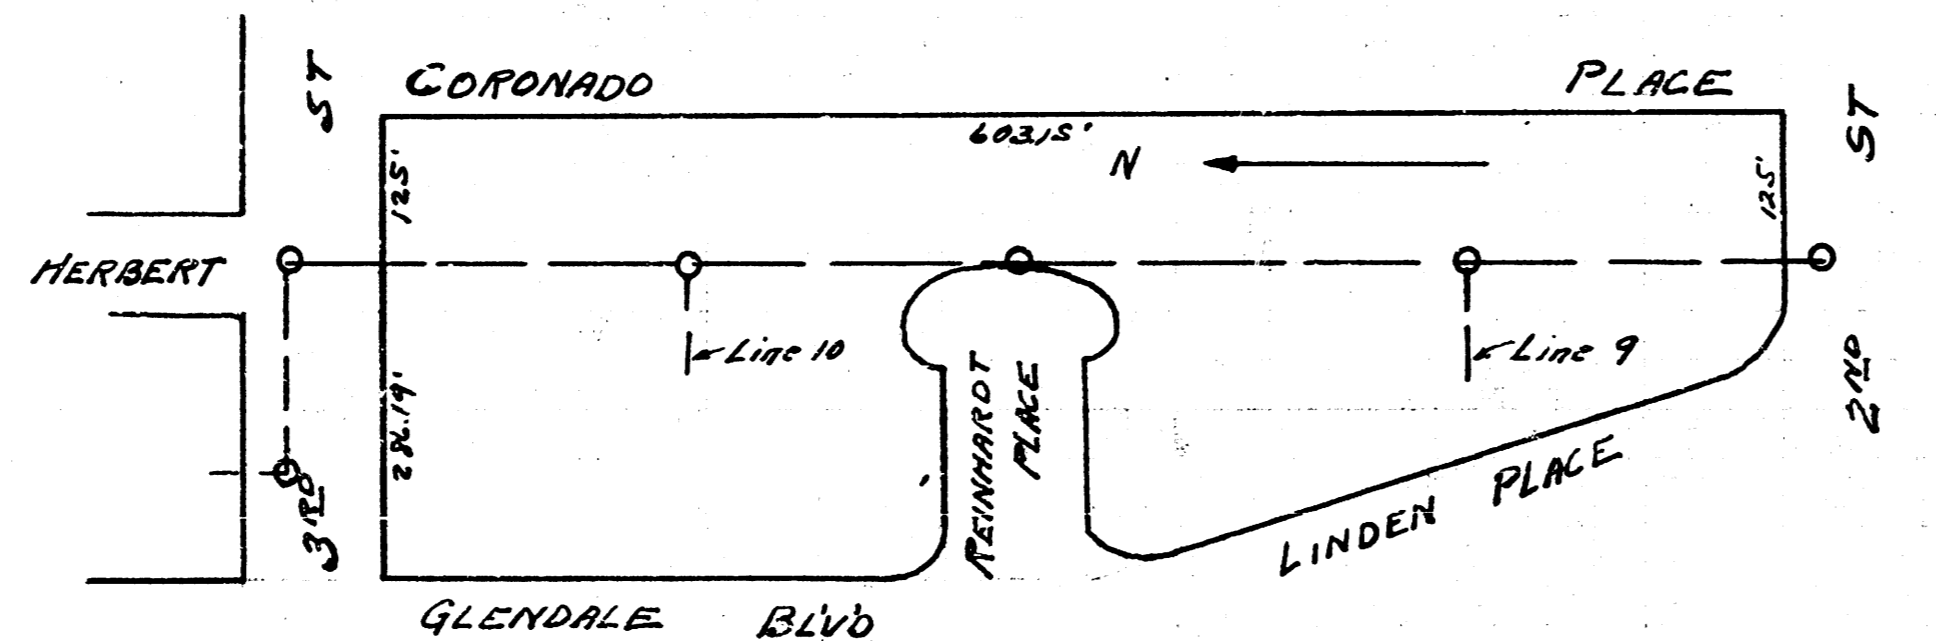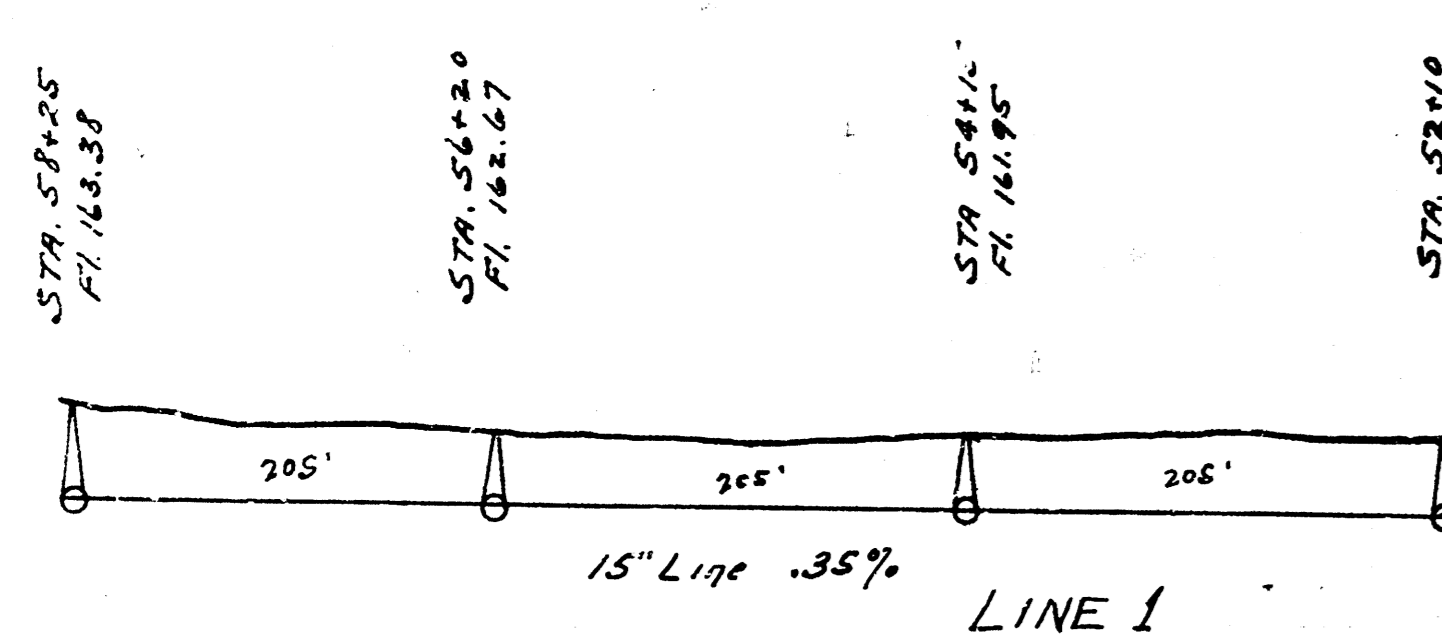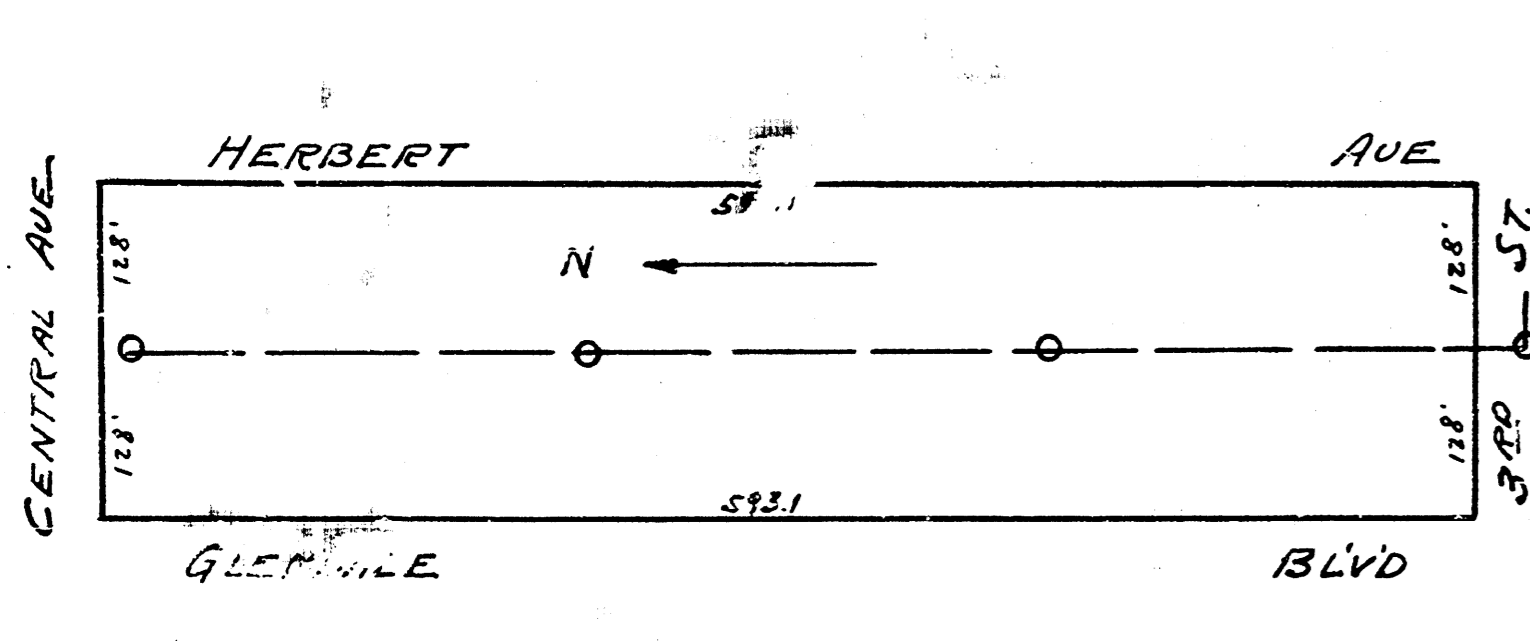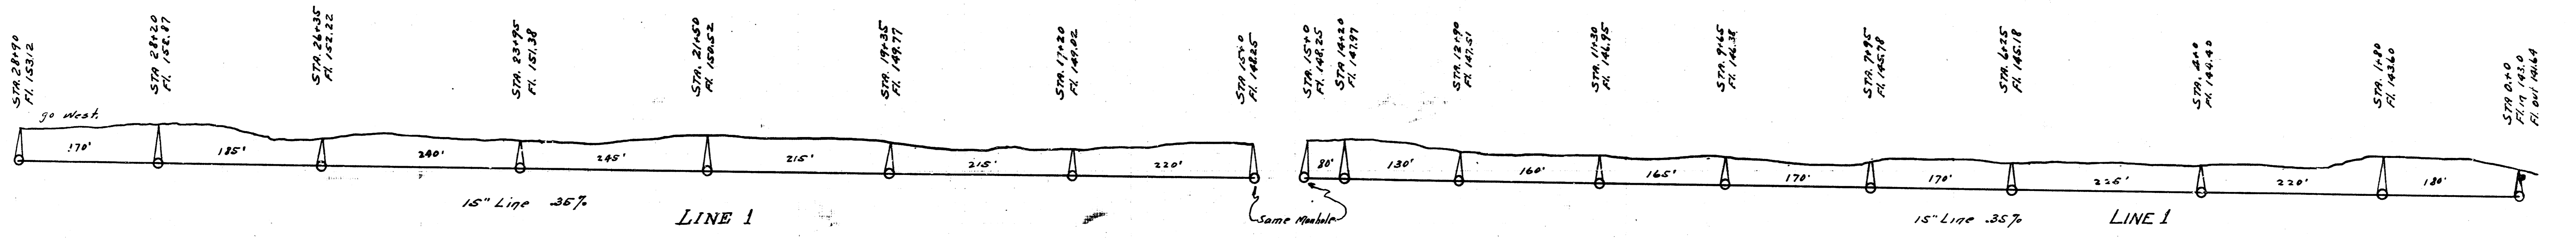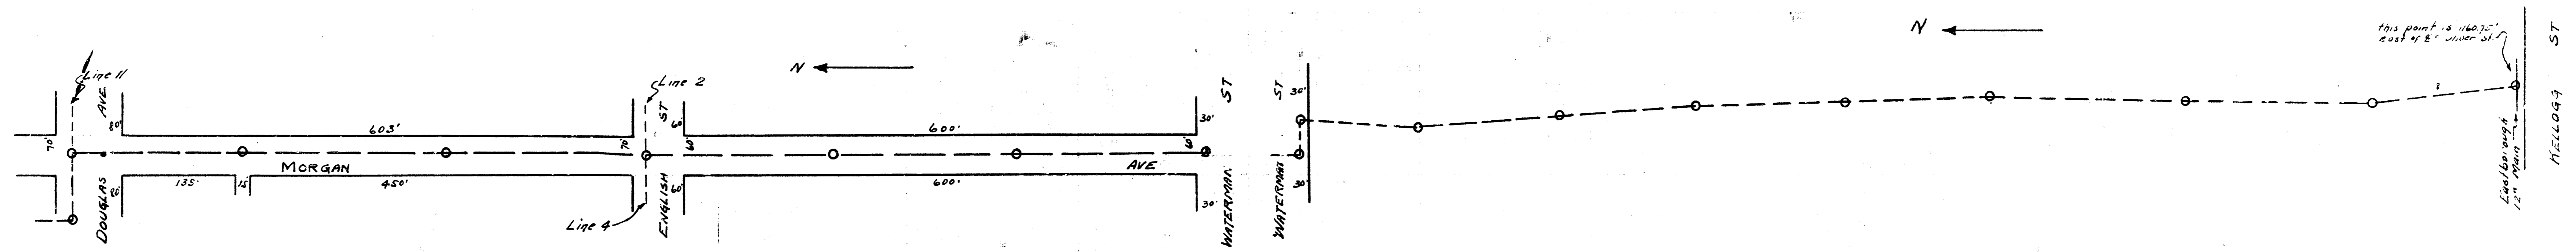







LAT. J, DIST. 6, S.S. 12.

SHEET I 4 SHEETS

B.M. 147.42 + on E.E. of ref. cb. S.E. cor. Oliver + Douglas.  
 147.75 iron s.s. 2'x2' block east of Oliver.  
 143.97 iron s.m. cor. Glendale and 1st.  
 + on west sidewalk south side No. 1st colored  
 east of house in 4126.

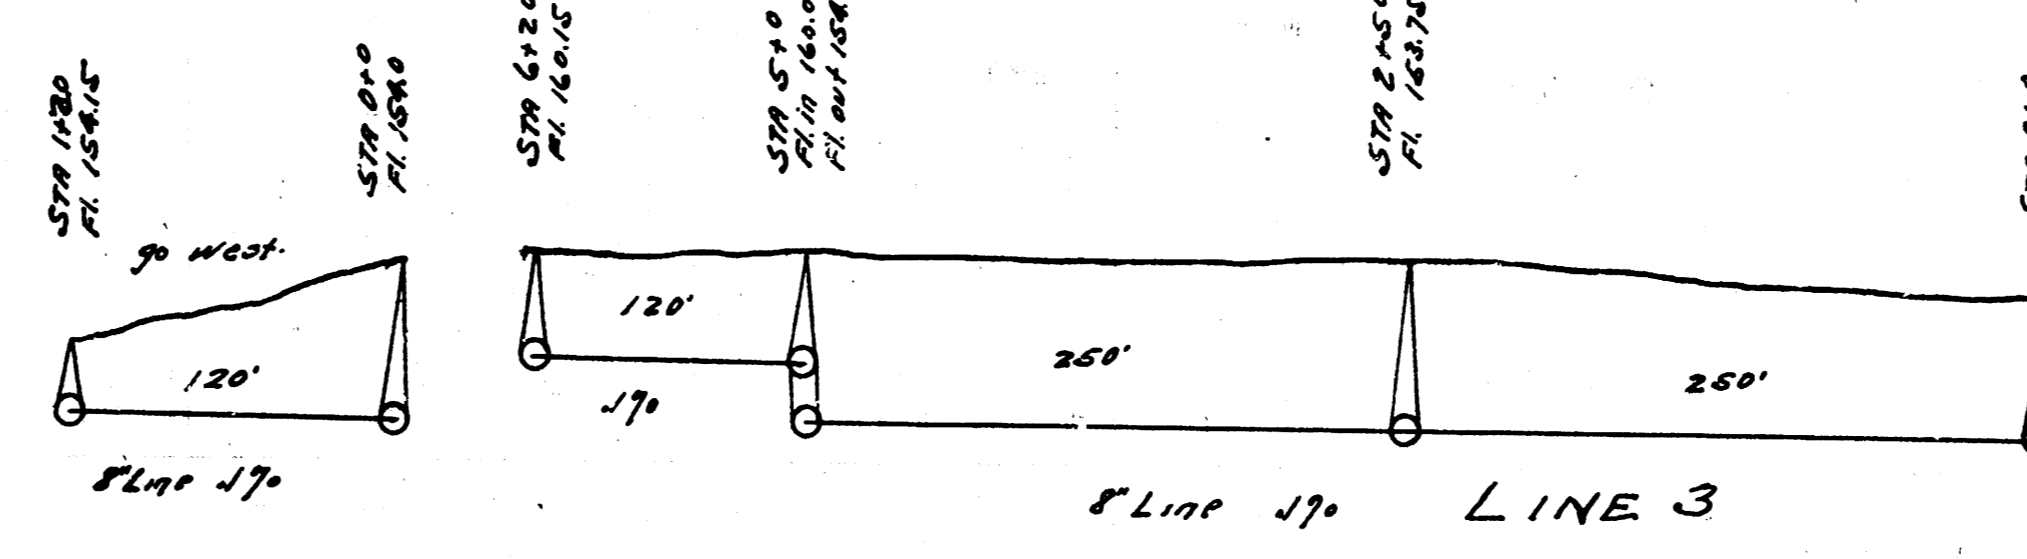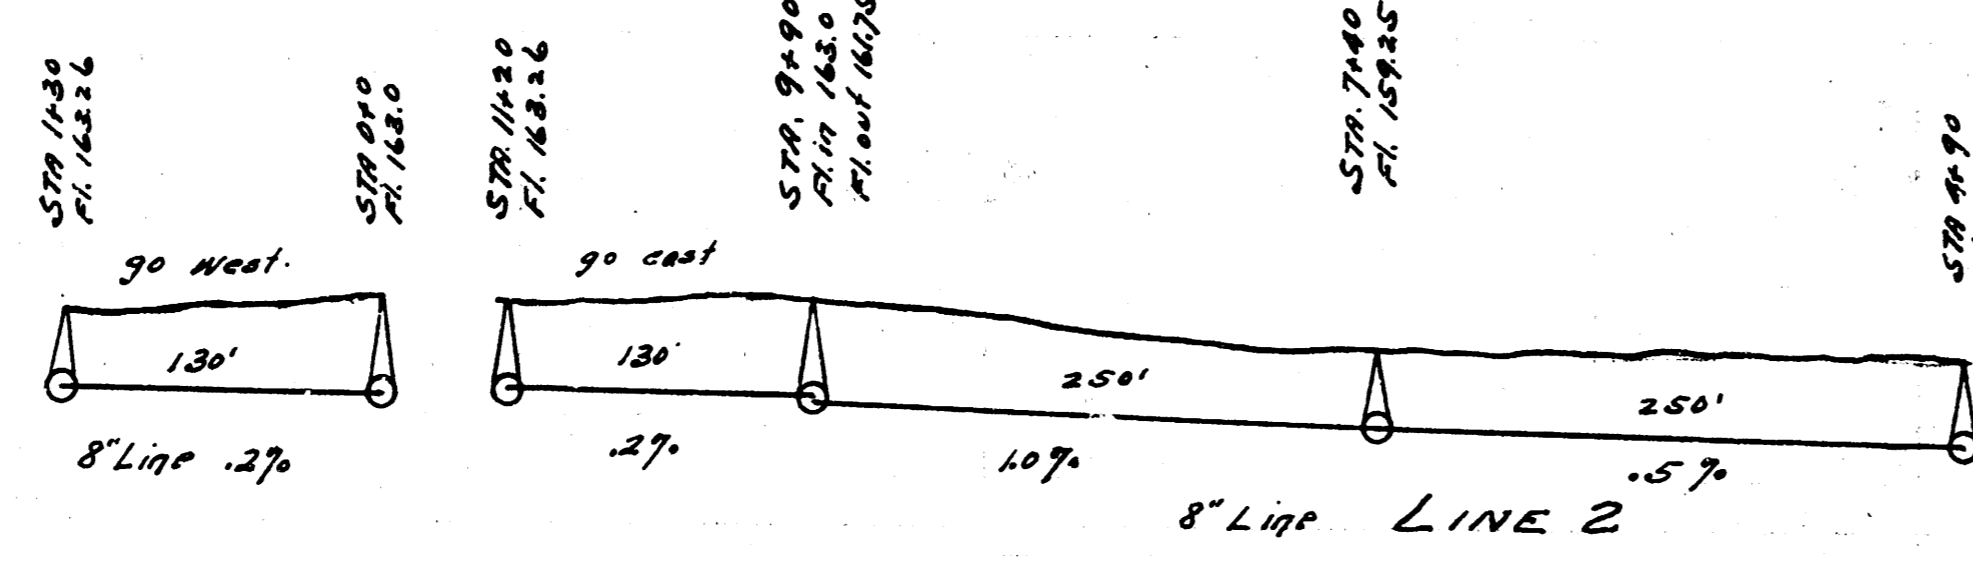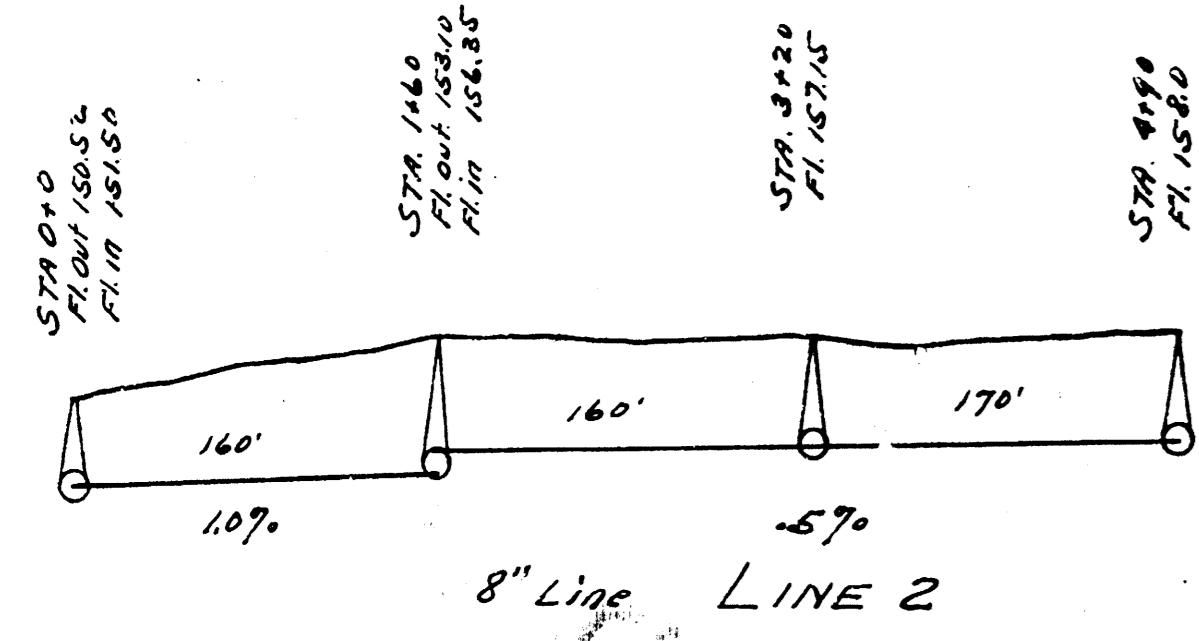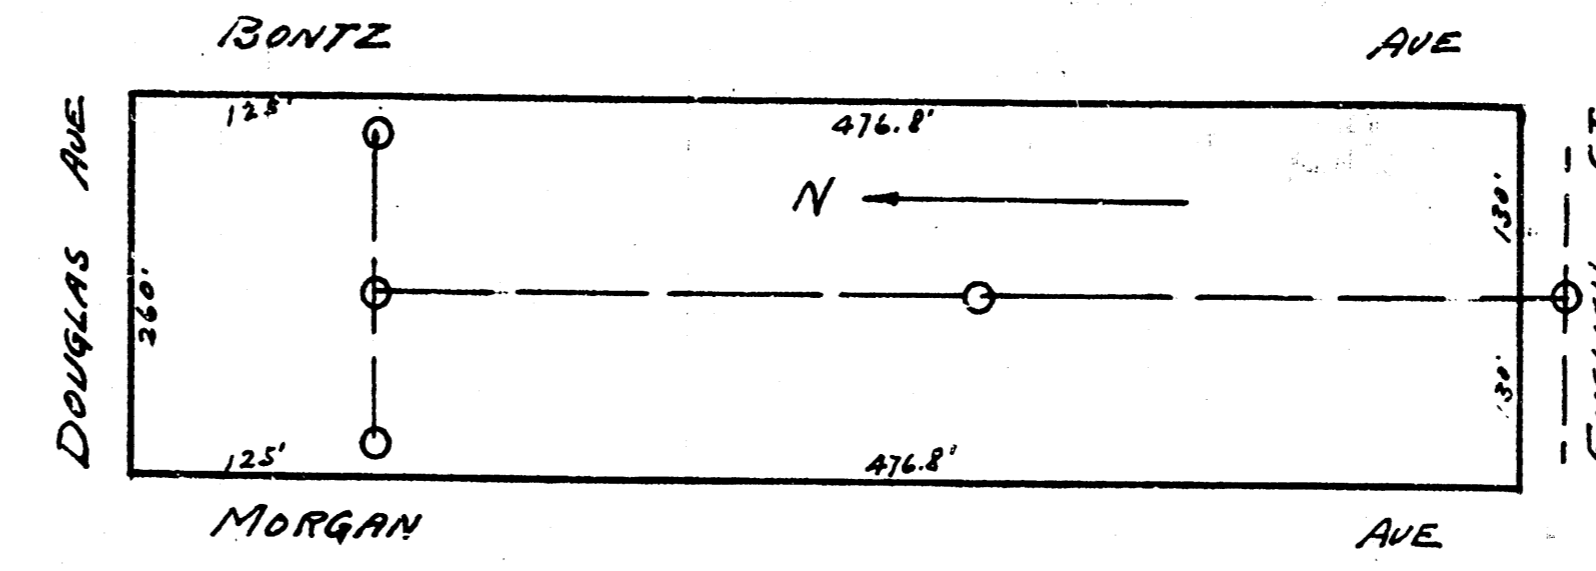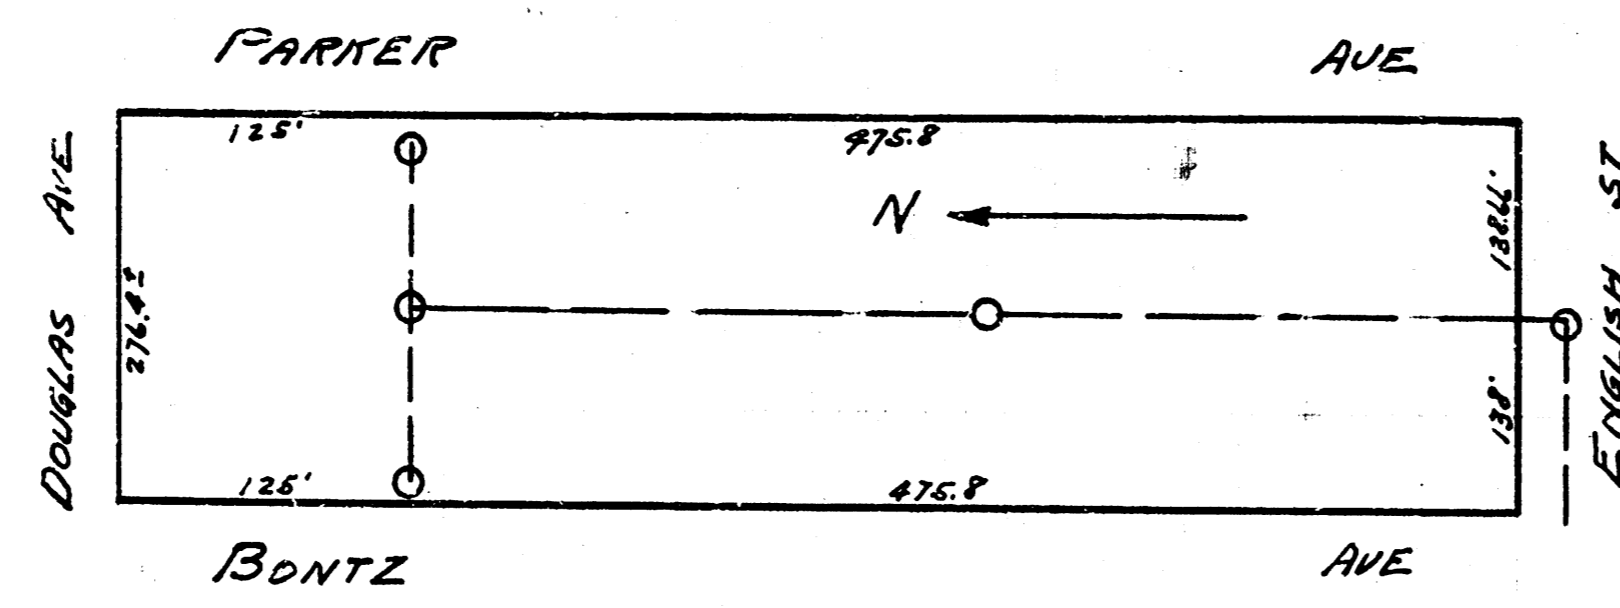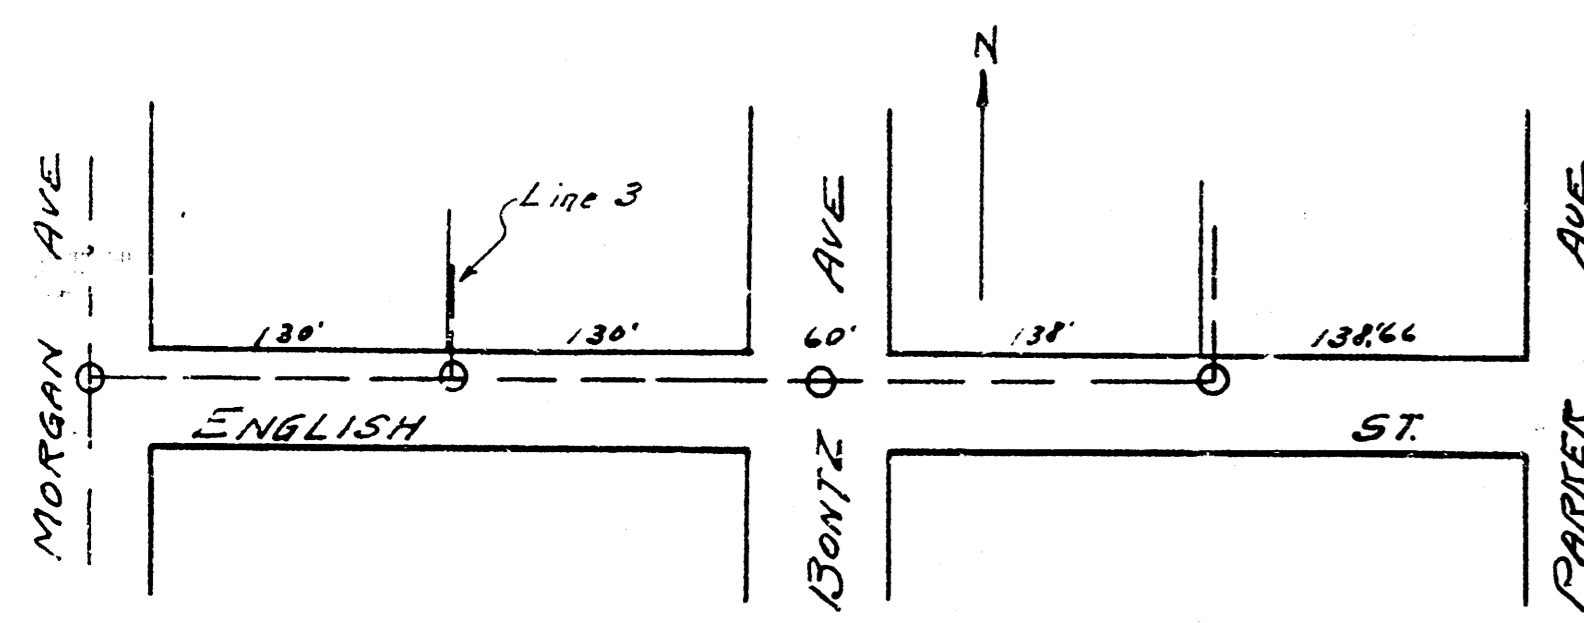

B.M. 16922 top of thumb NW cor. Oliver and Kelley.  
 168.57 top of thumb NW cor. Oliver and Kelley.  
 167.42 top of E end of 1" rd. ch. S.E. cor. Oliver & Douglas

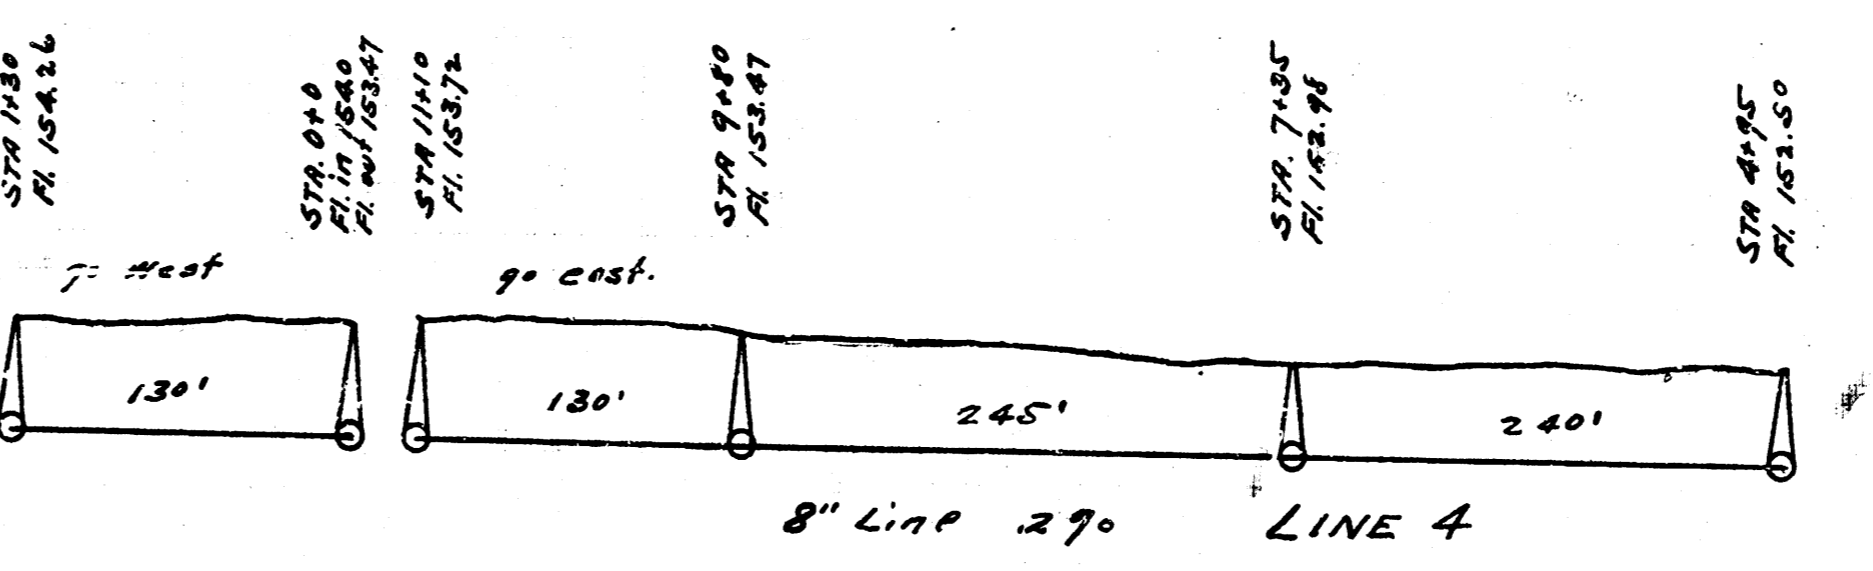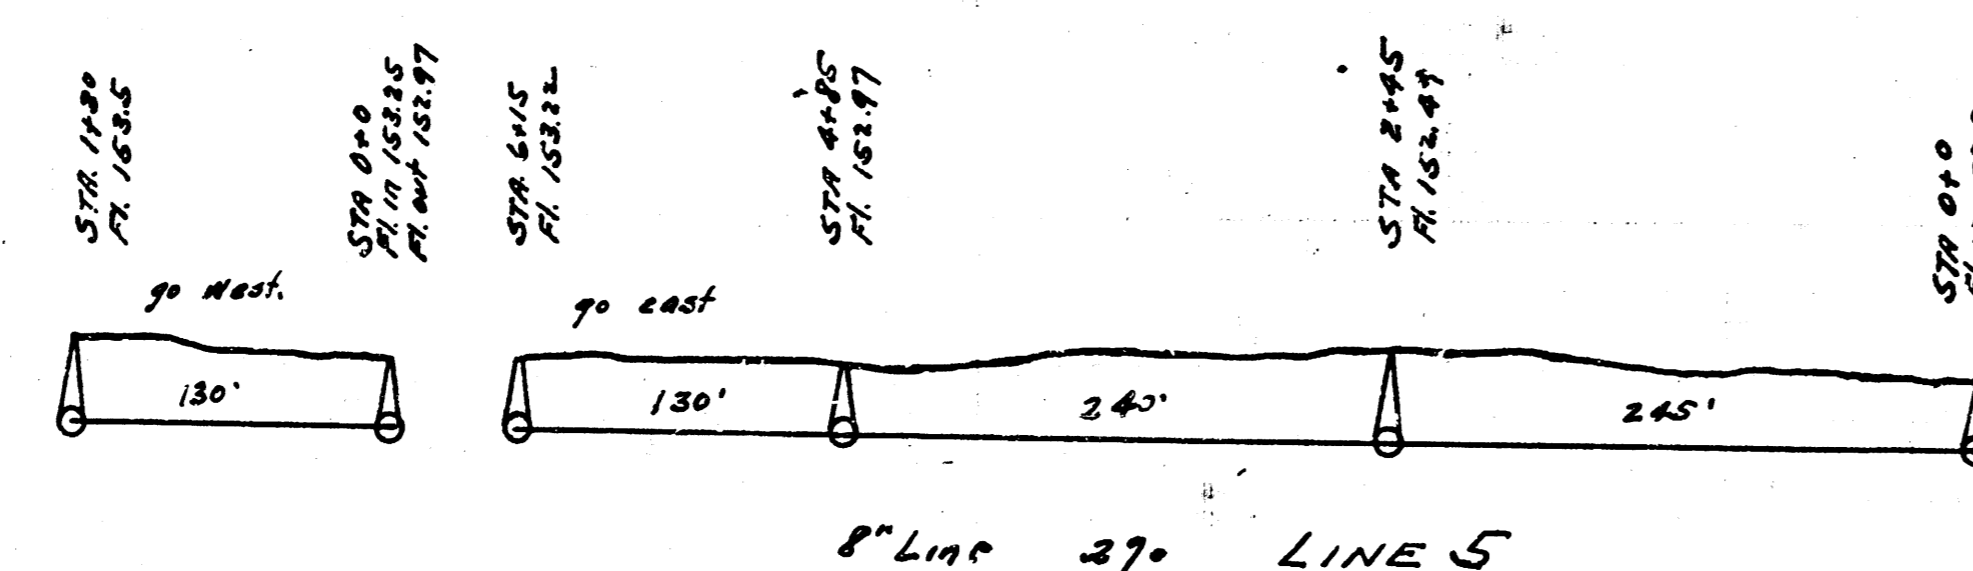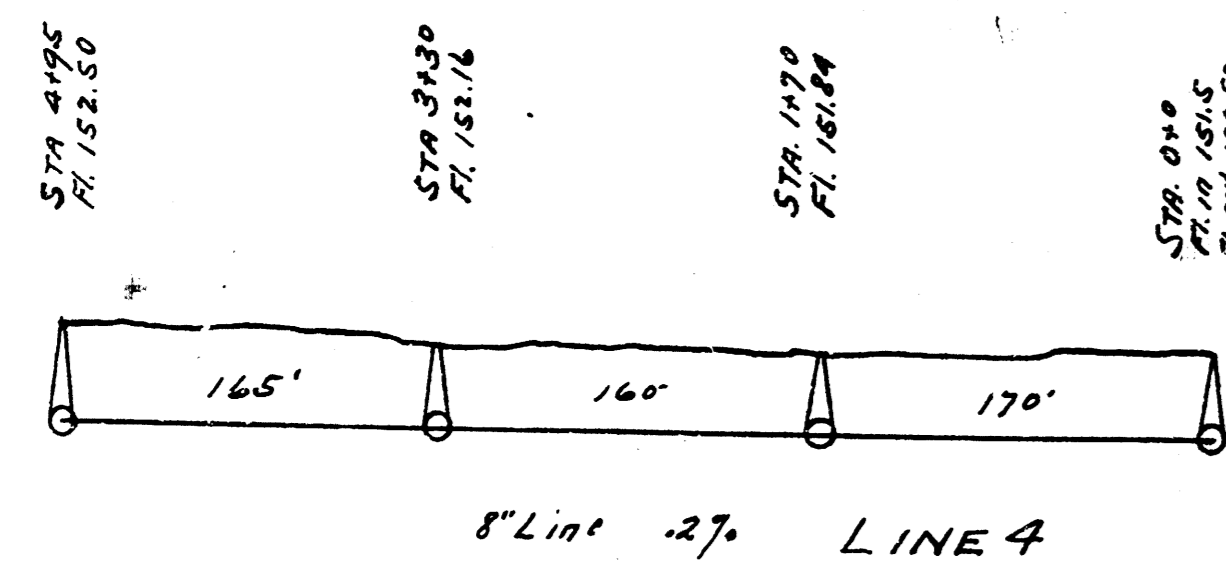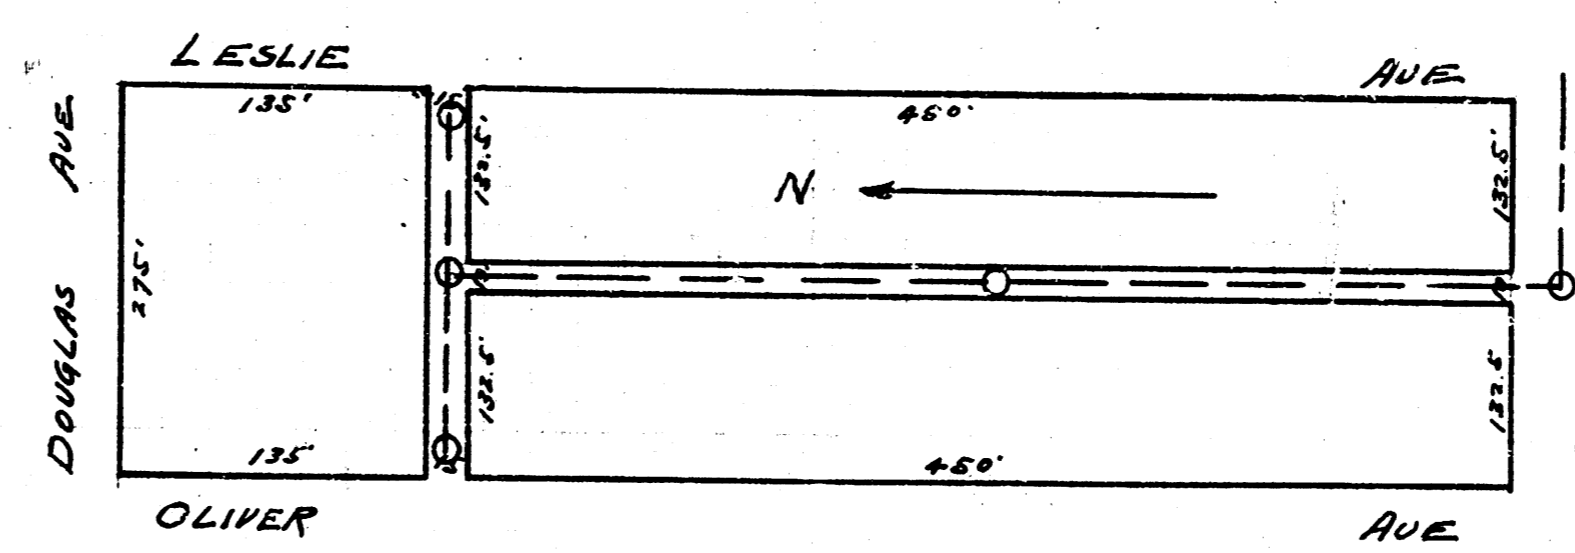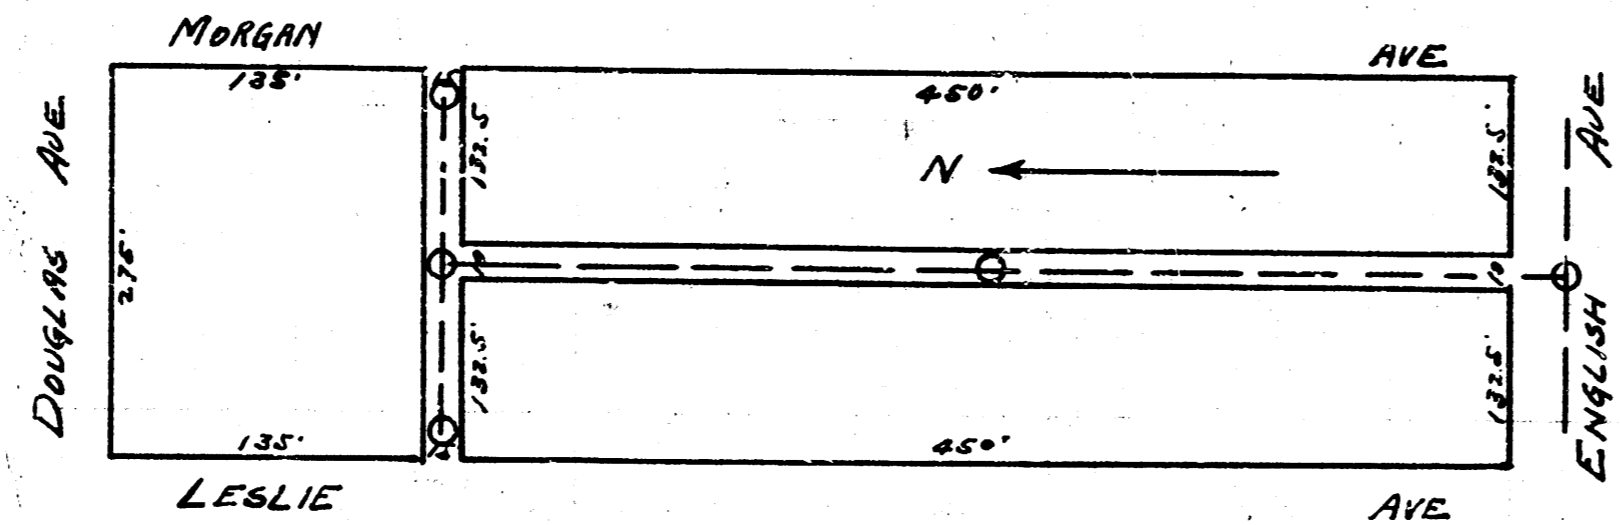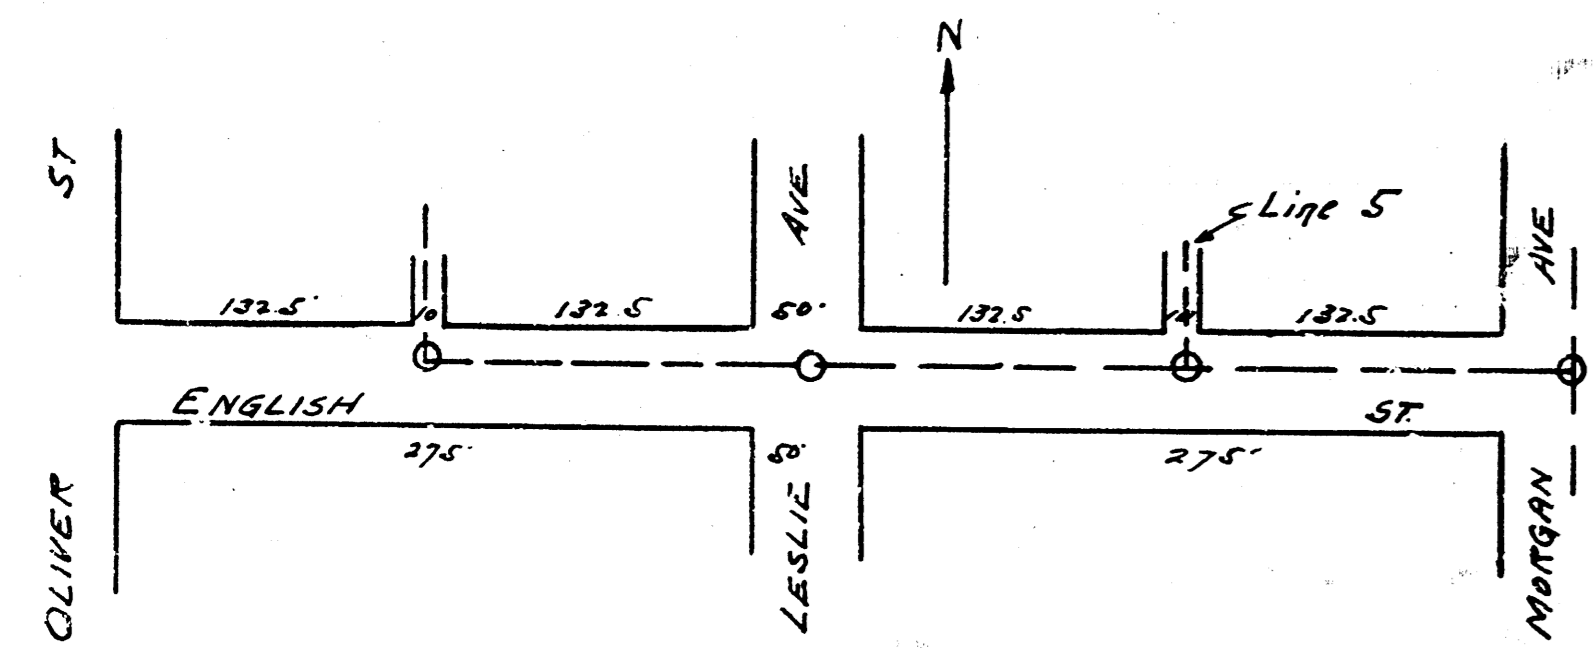

LAT. J, DIST. 6, SS. 12.











SHEET 2








4 SHEETS

LAT. J, DIST. 6, S.S. 12.

SHEET 3 4 SHEETS

1877 16772 1100 2nd St SW 1 block east of Oliver.  
 183.97 1100 SW Cor. Glendale + 1st.  
 174.41 1000 base of Culbert, SE cor. W. and 1st. Viny + Progress.  
 172.78 on floor of Miller house Spanish Plaza.  
 NE cor. 2nd + Coronado  
 170.79 + on E end SE cb 2nd + Oliver.

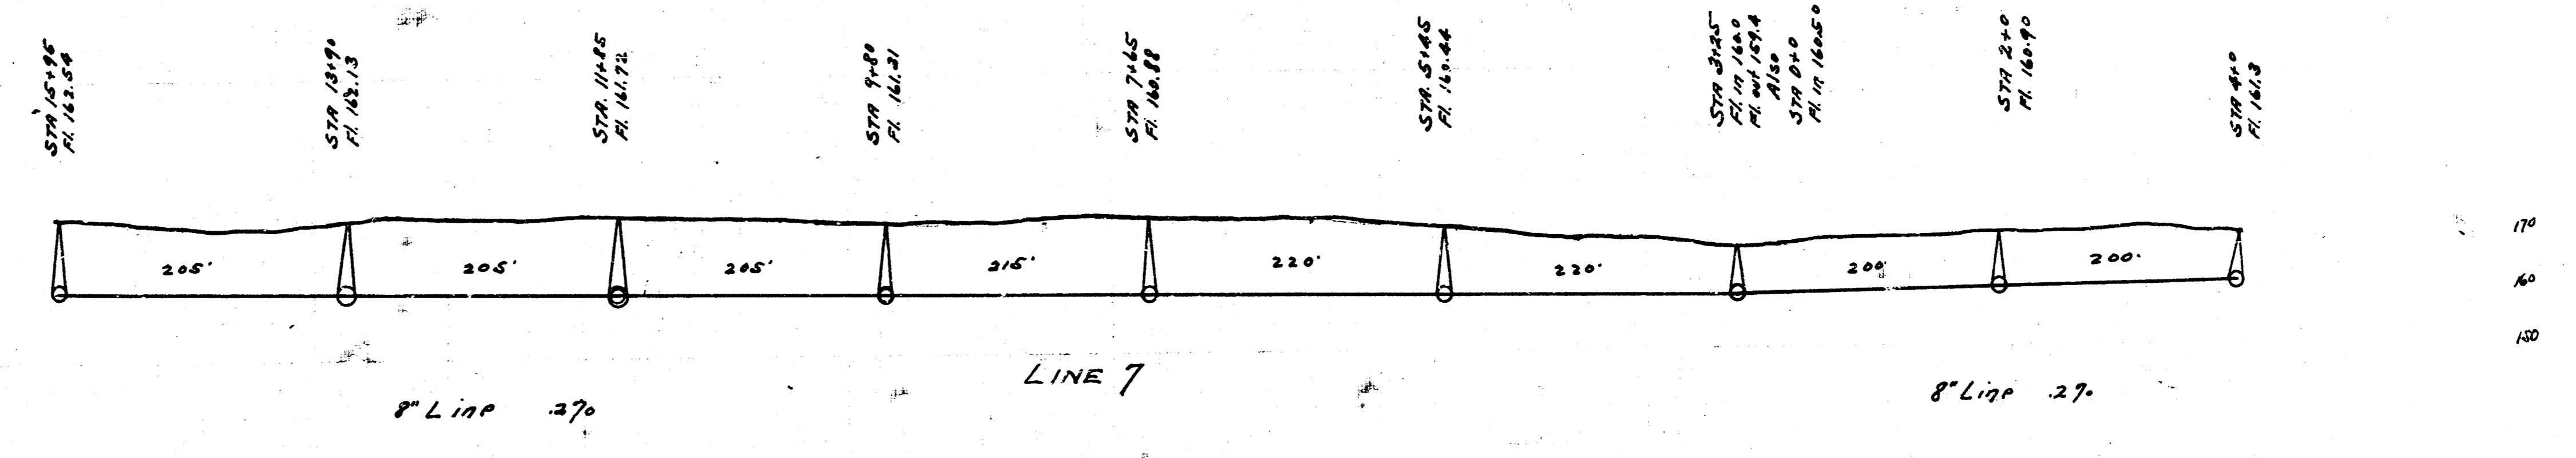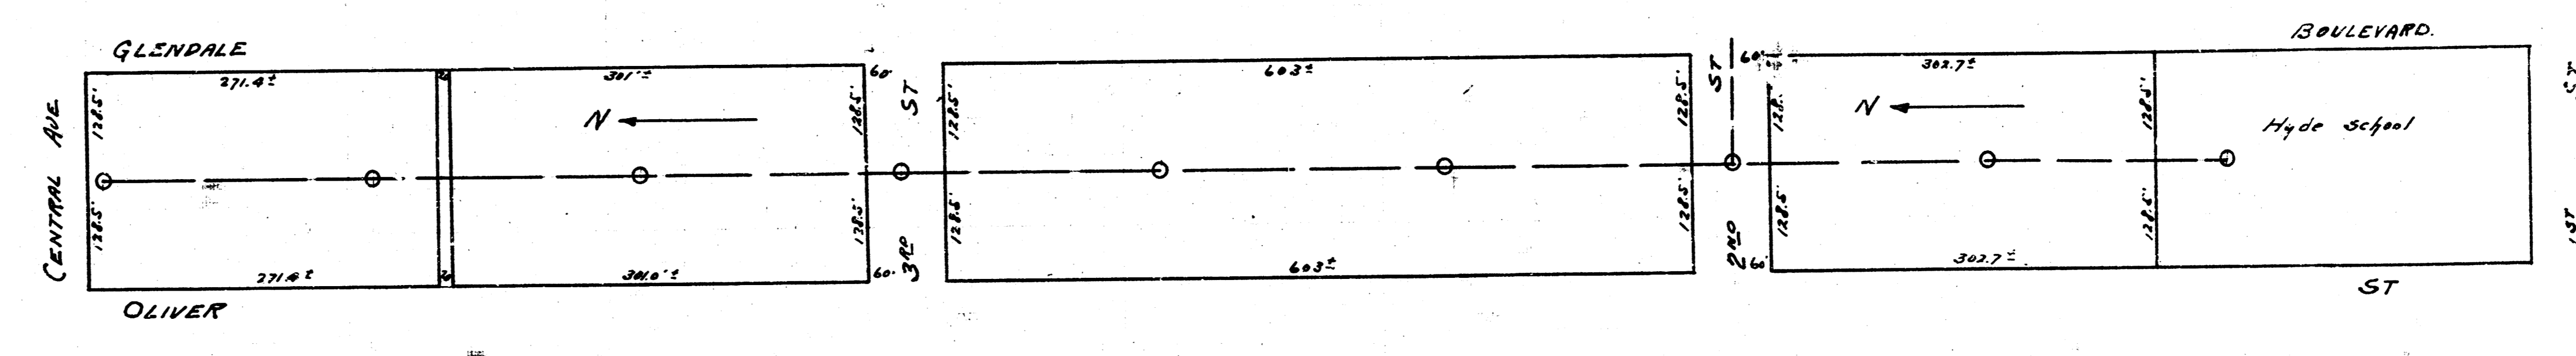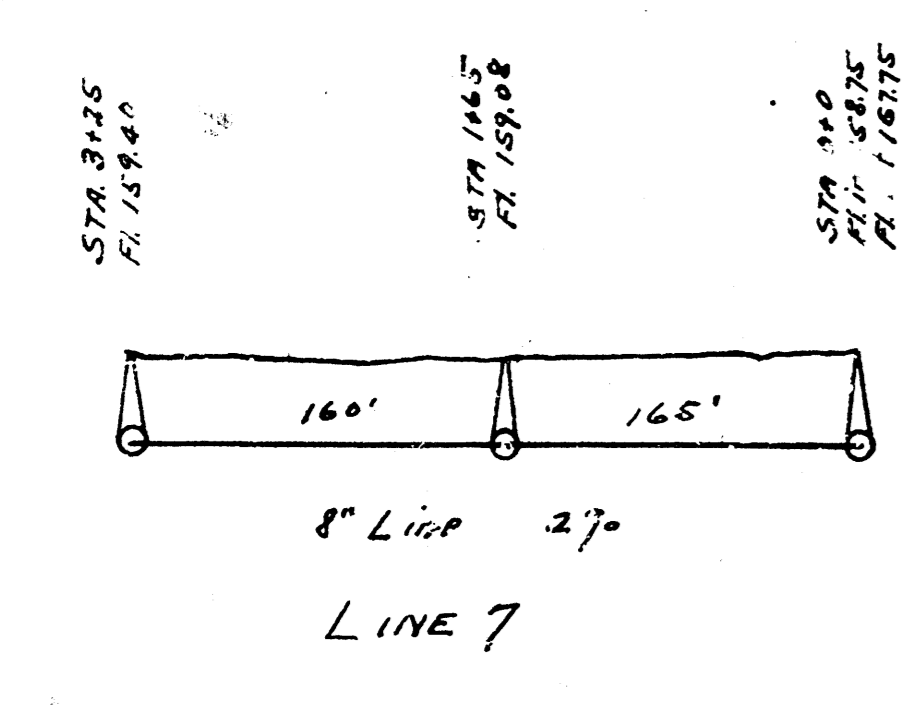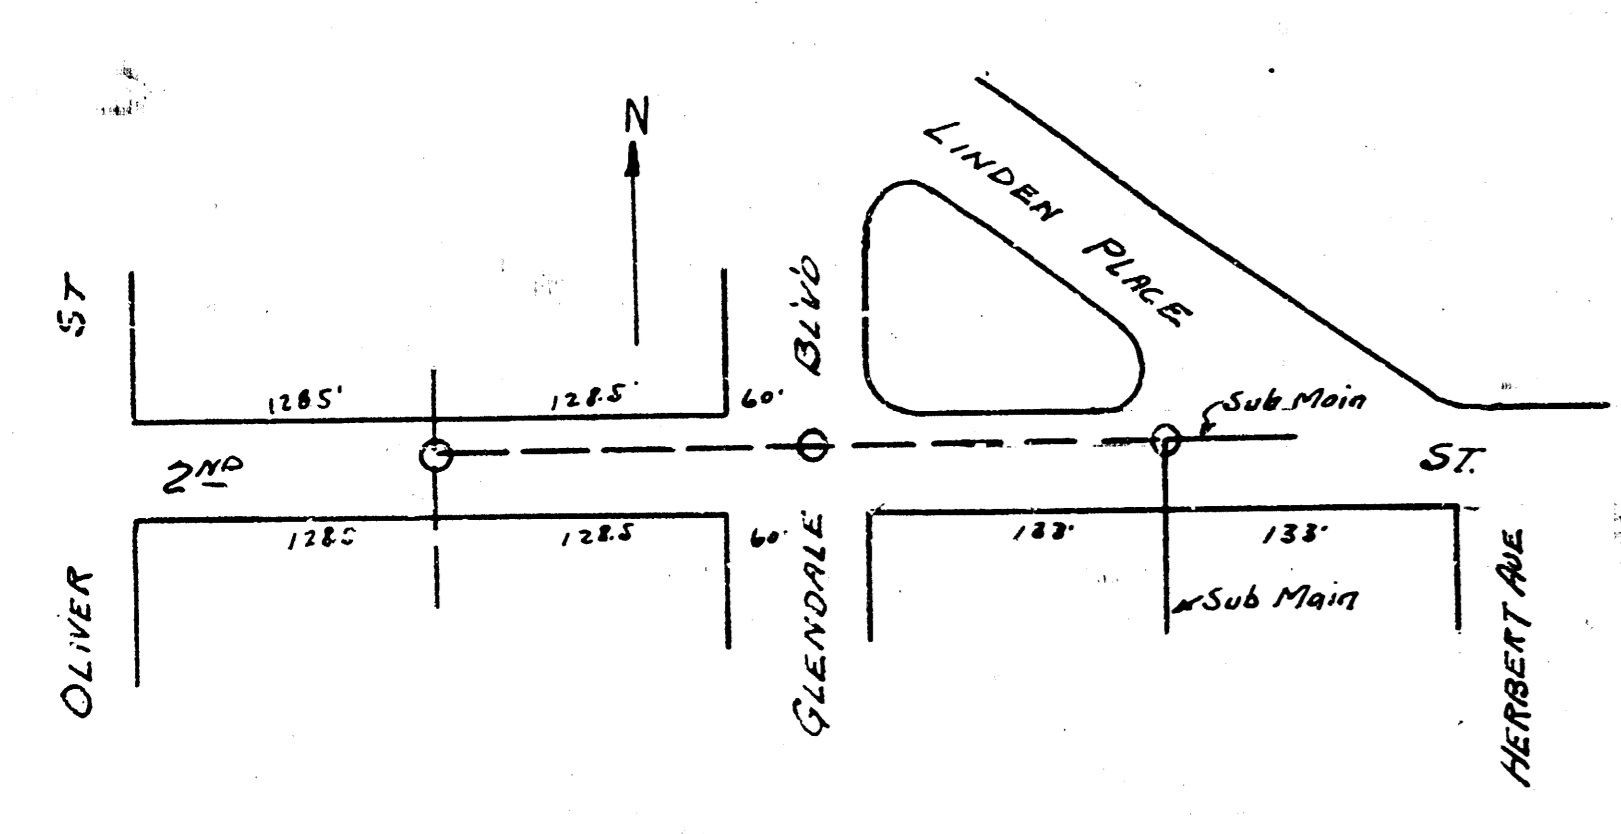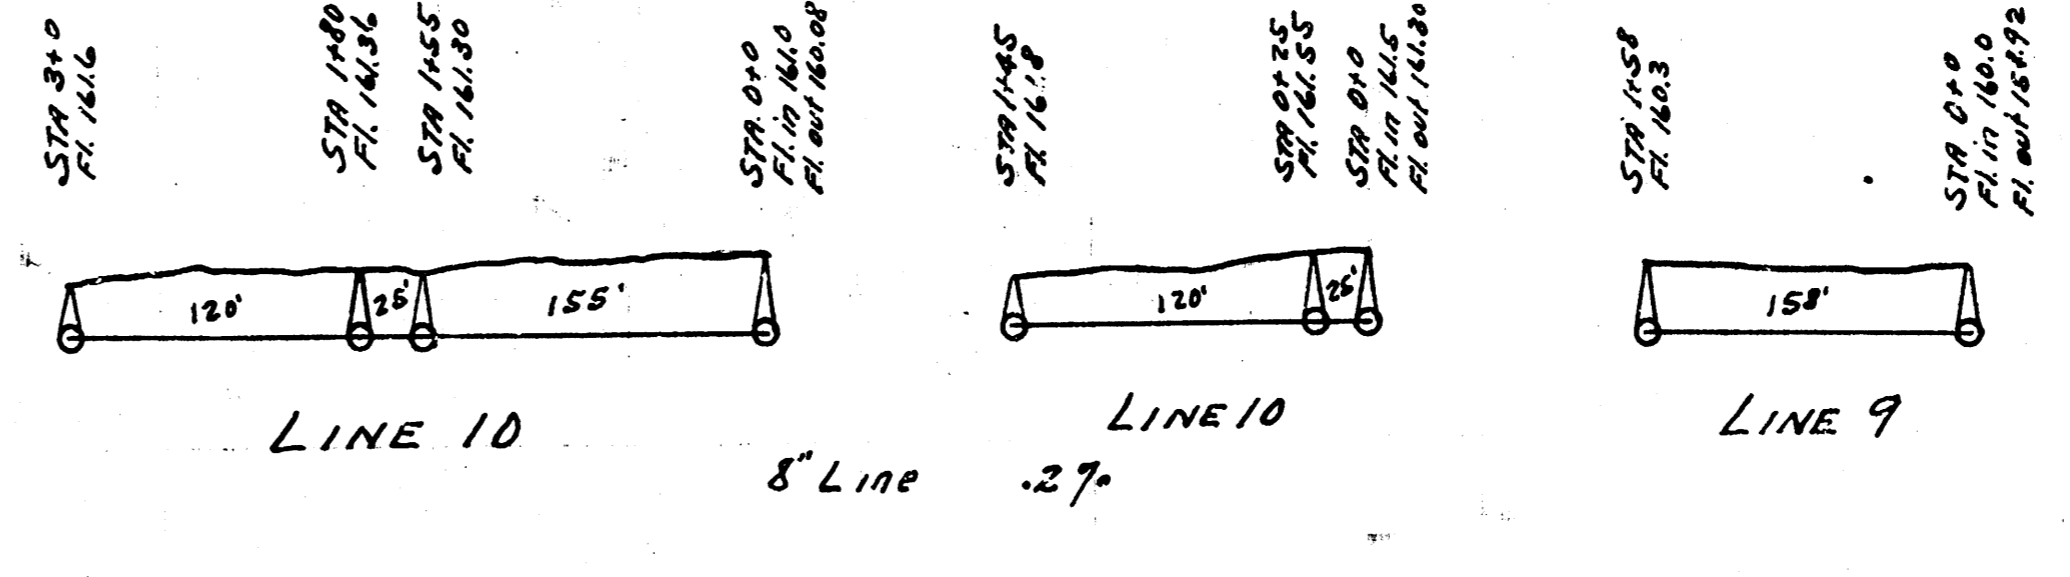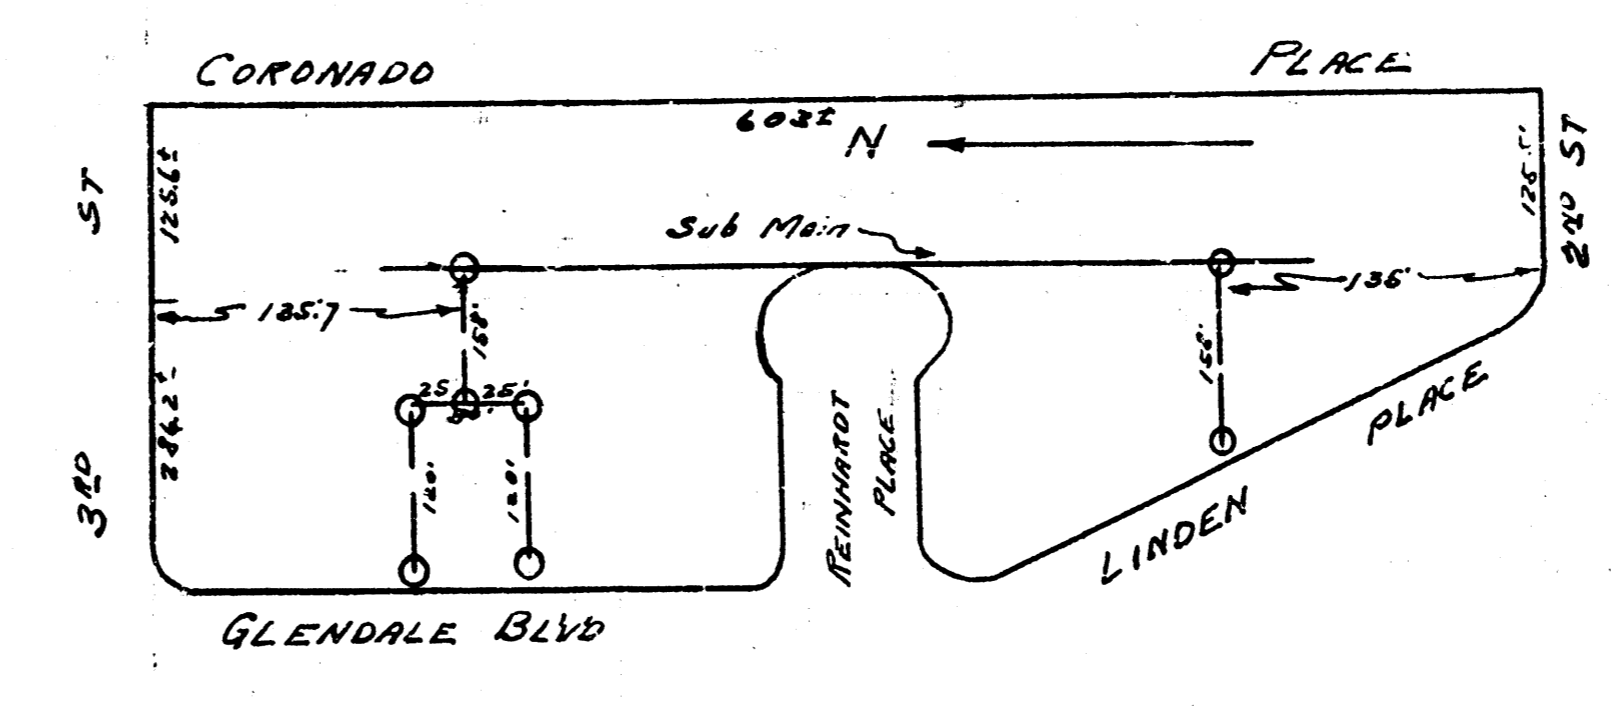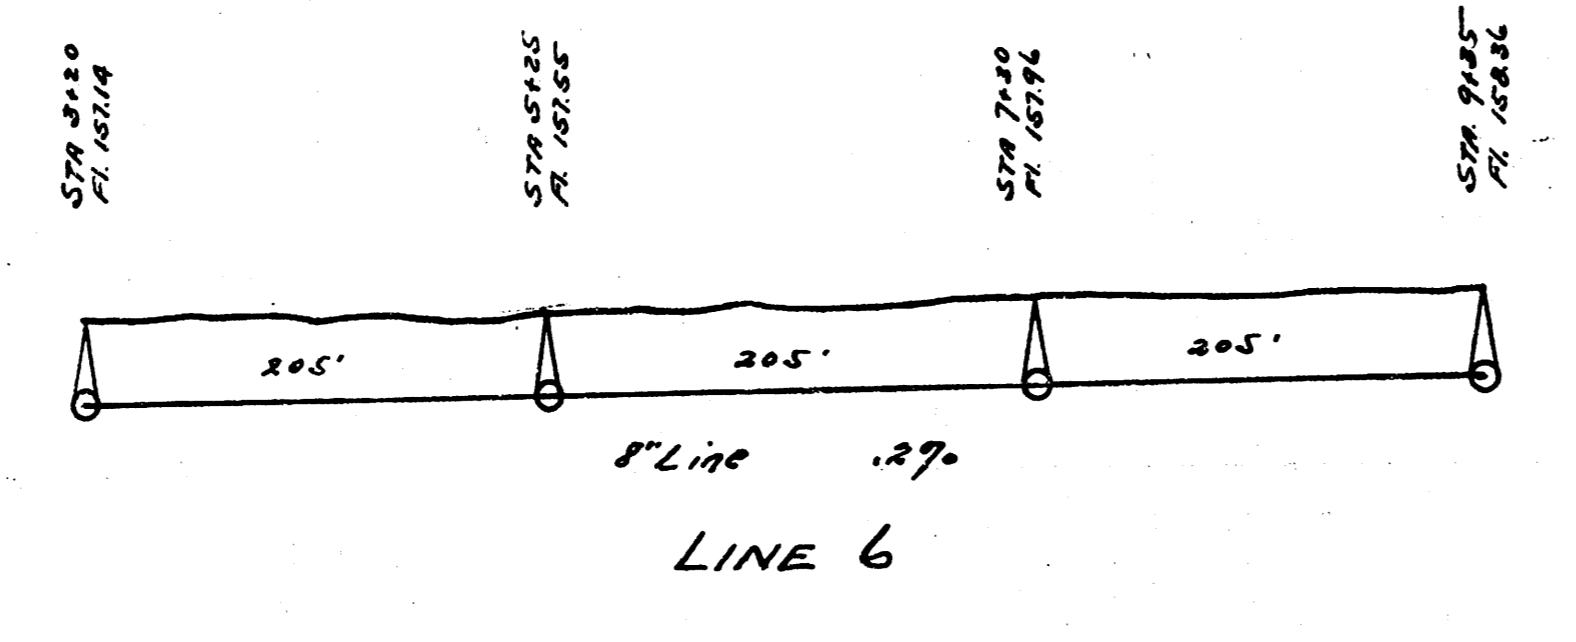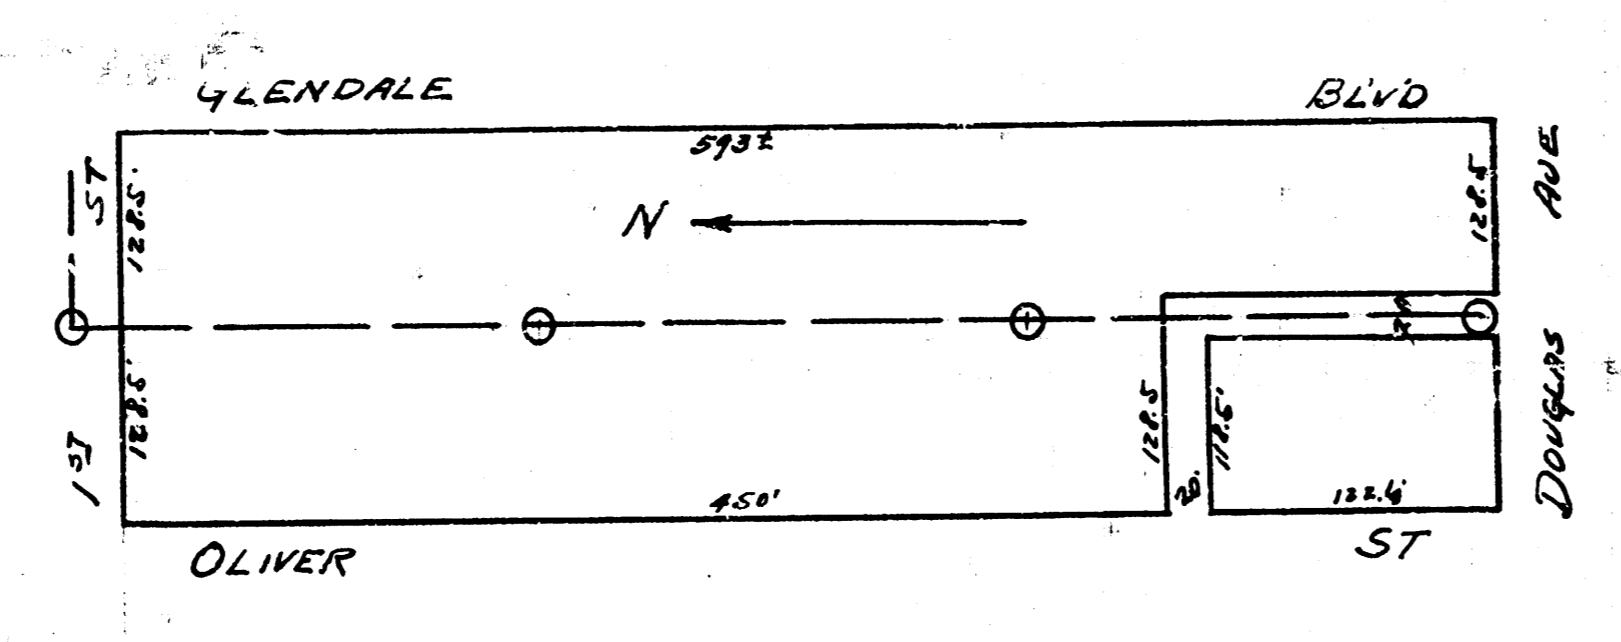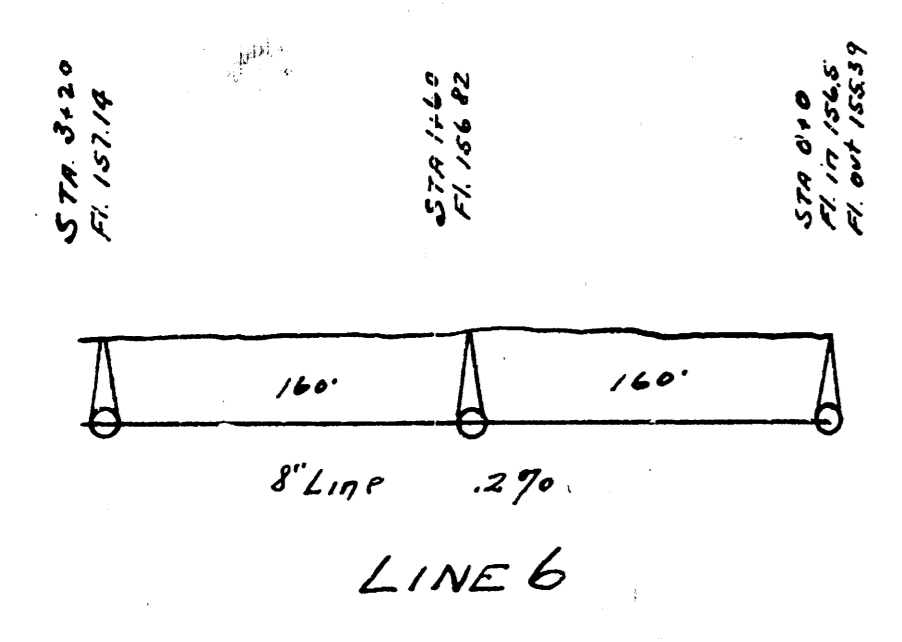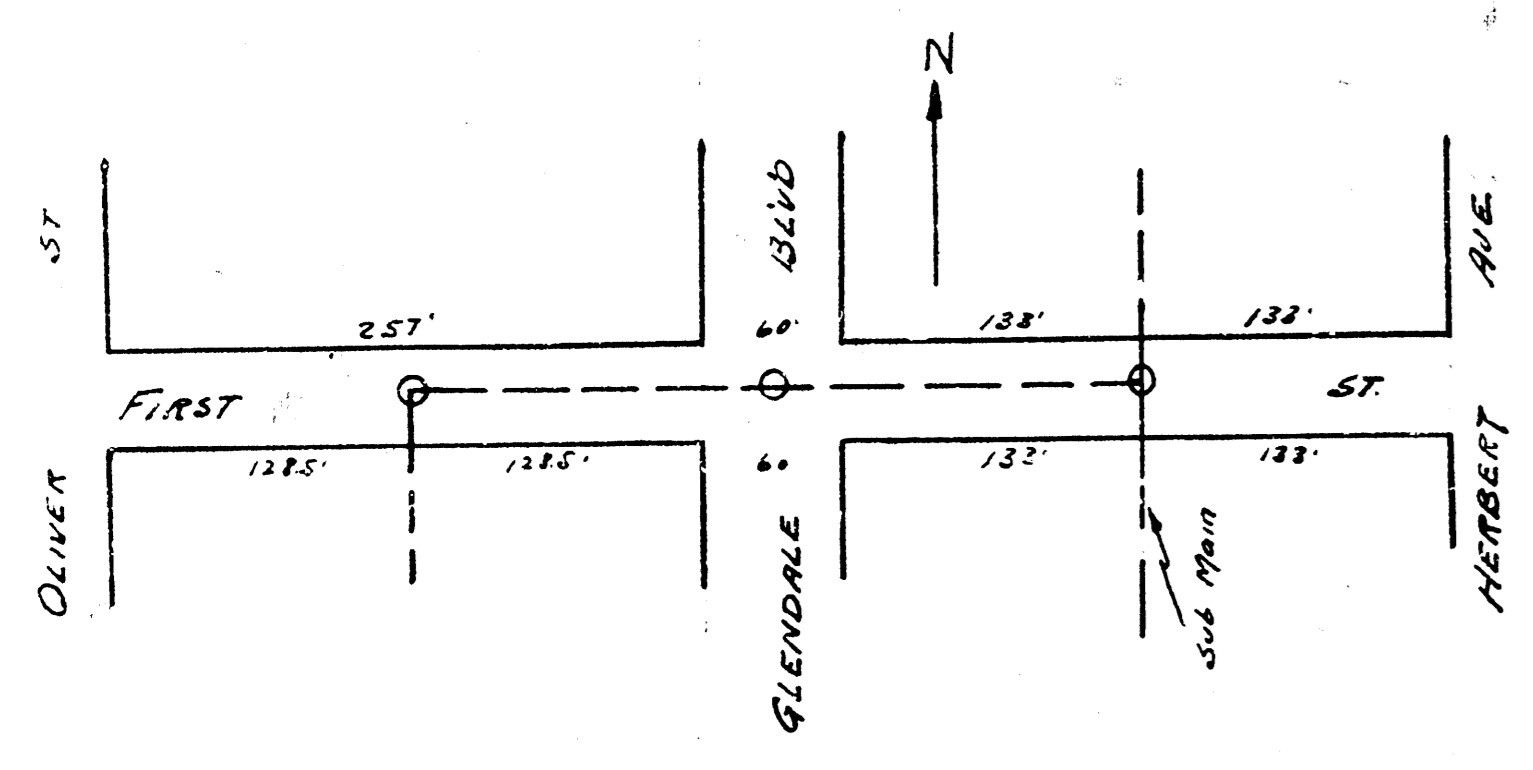

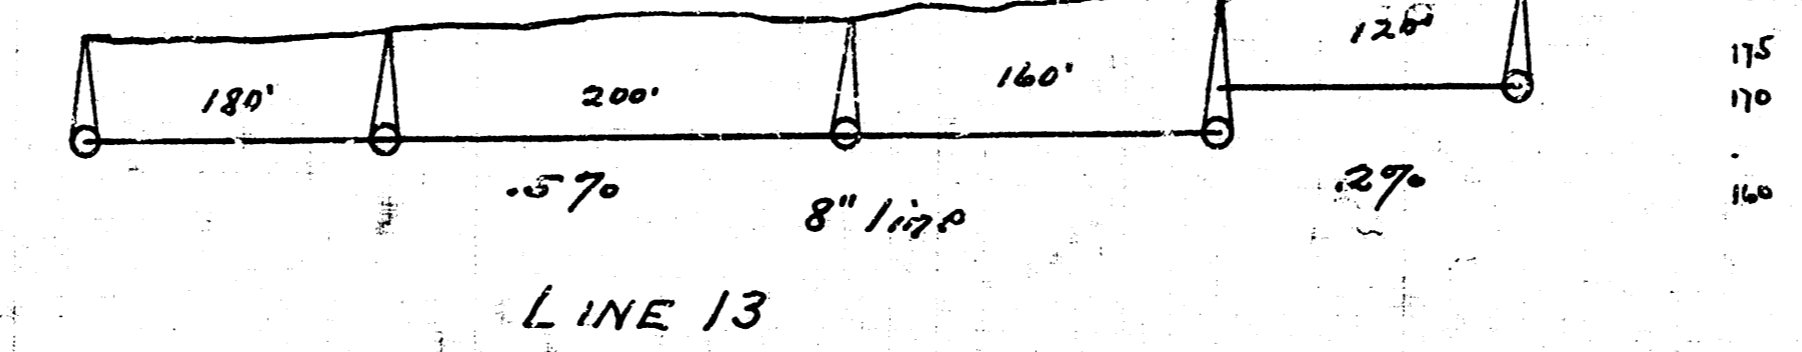 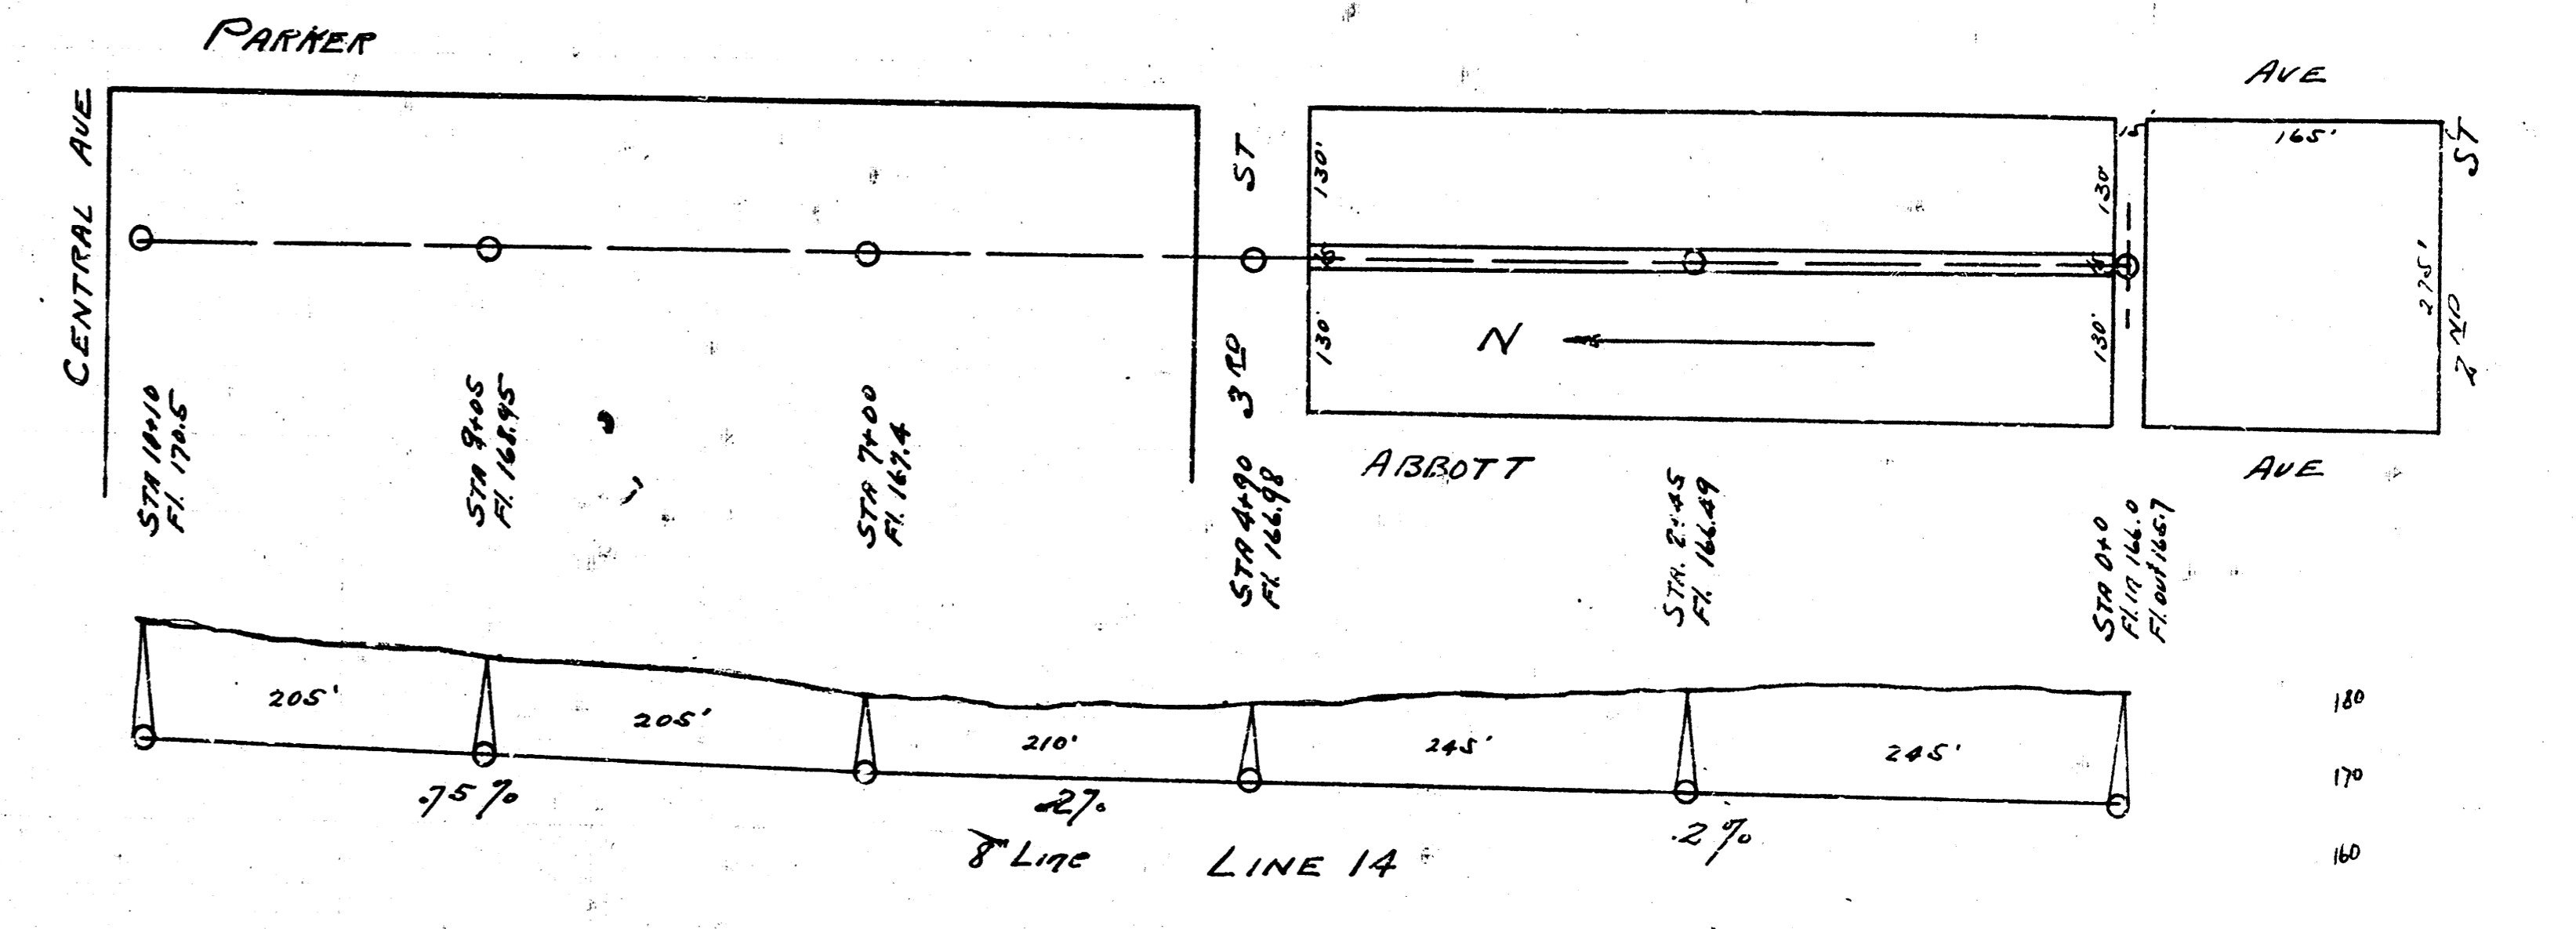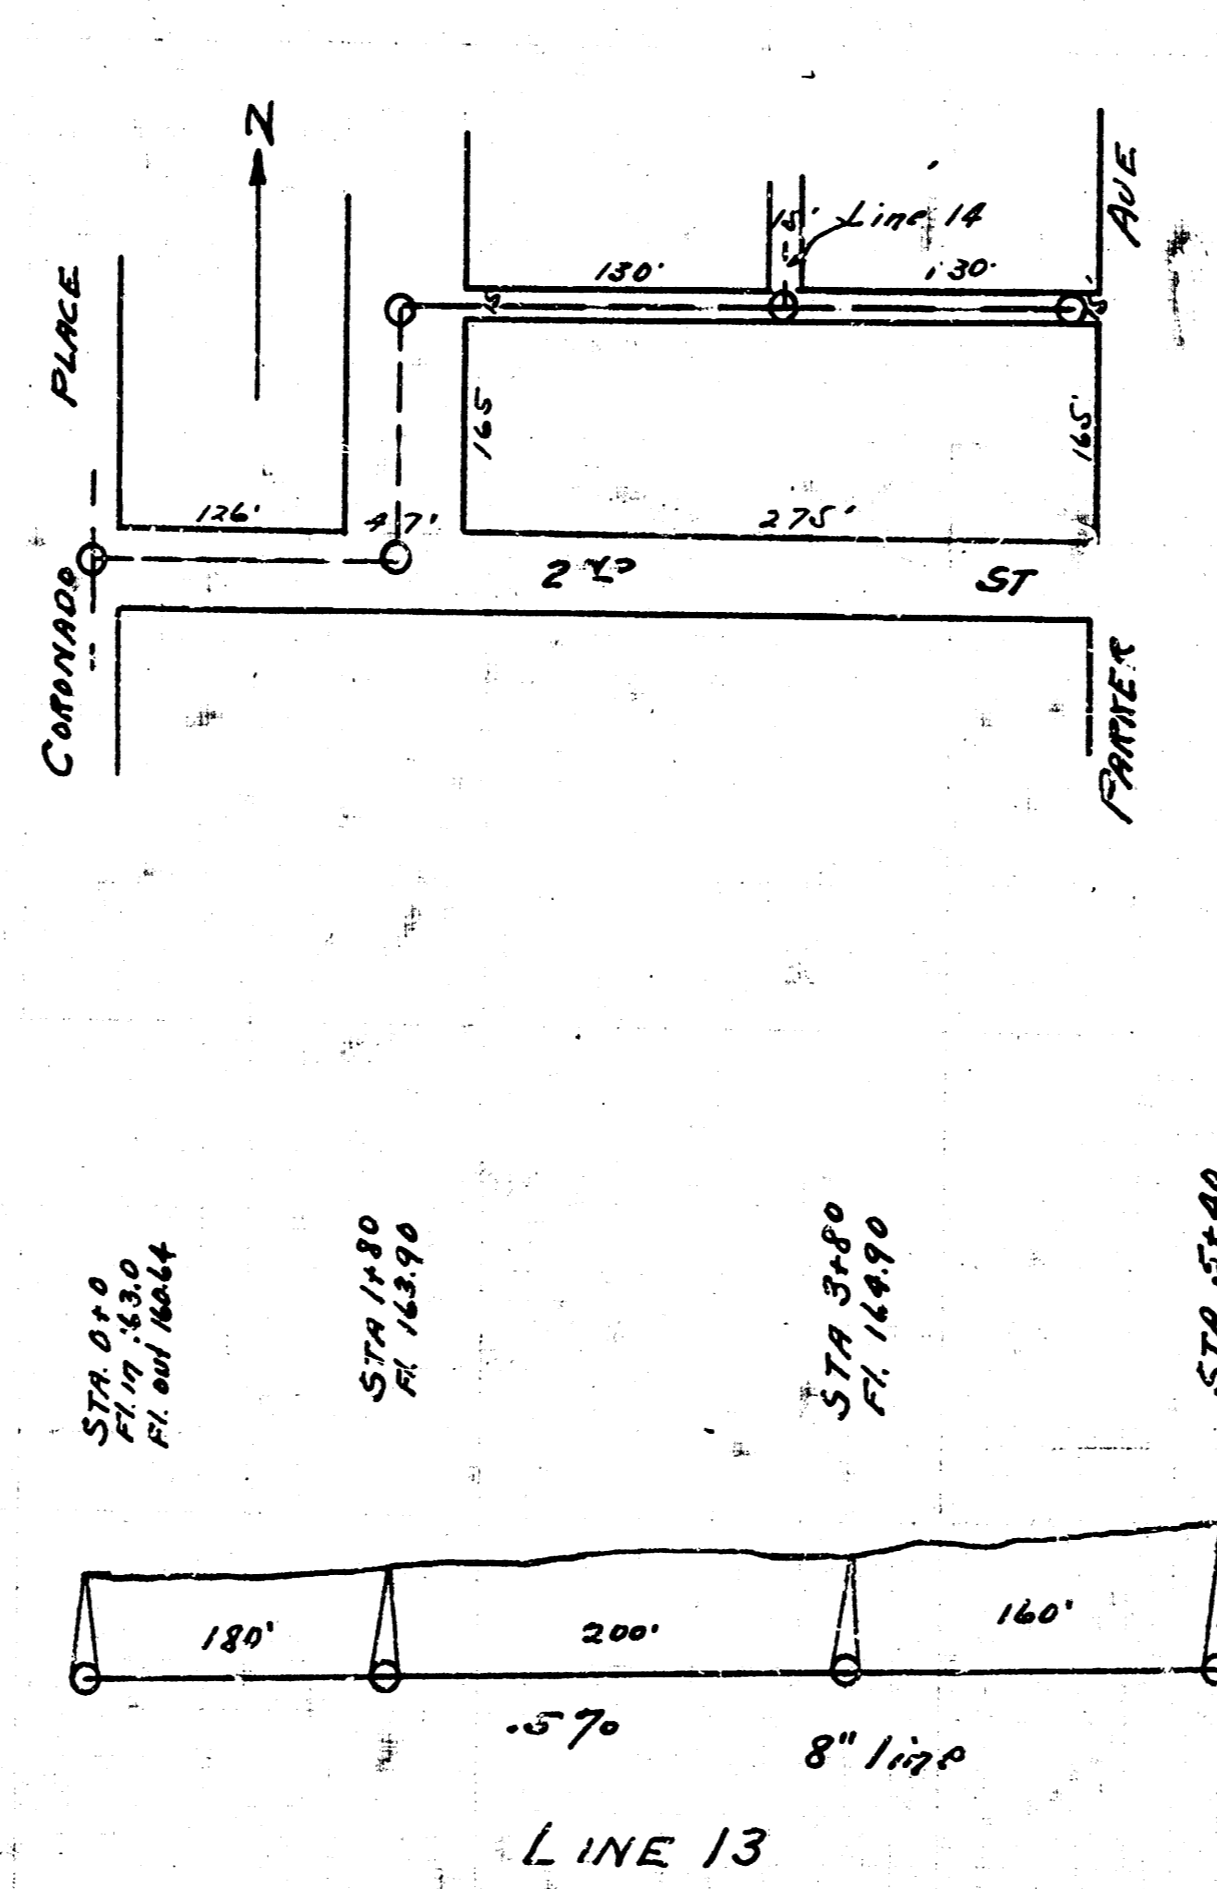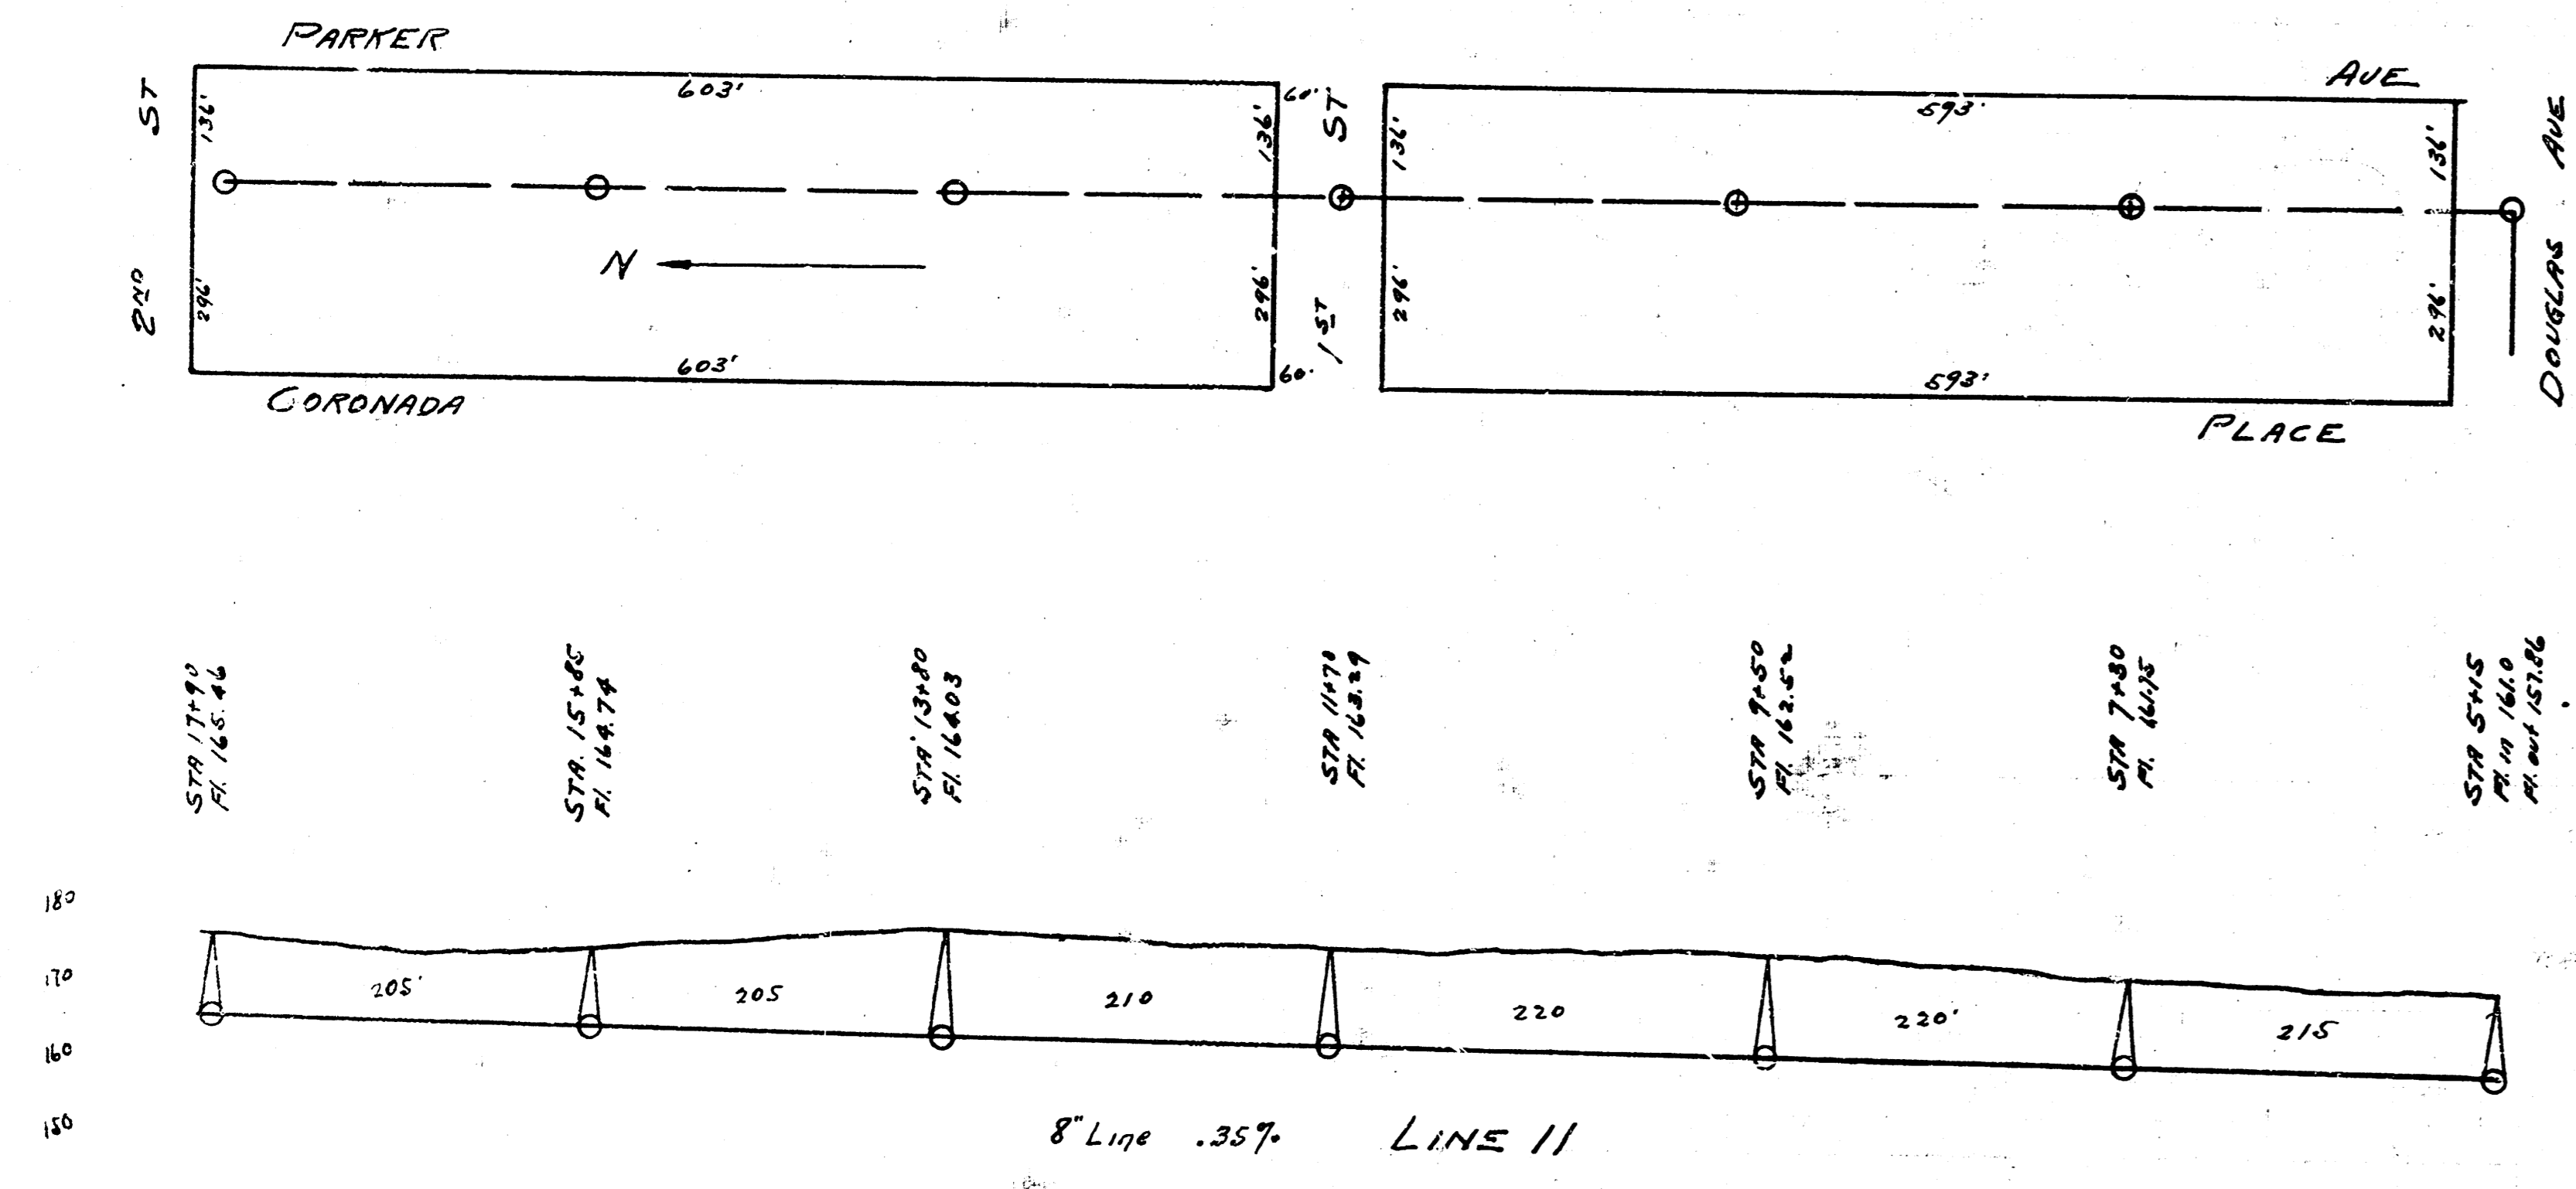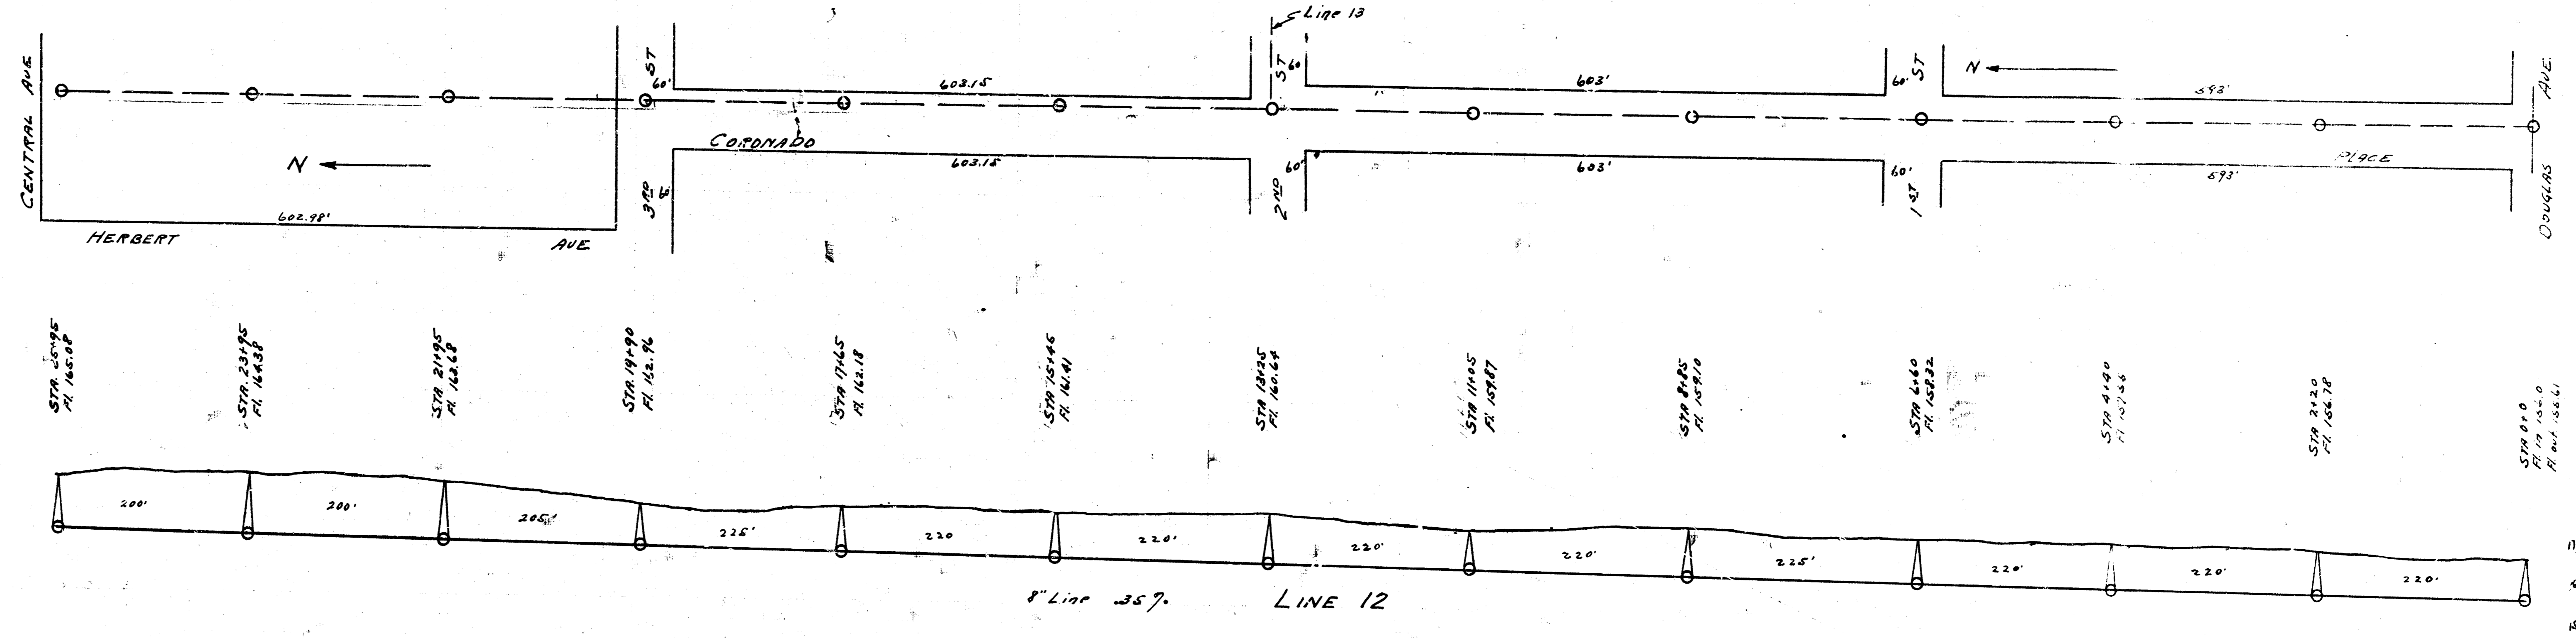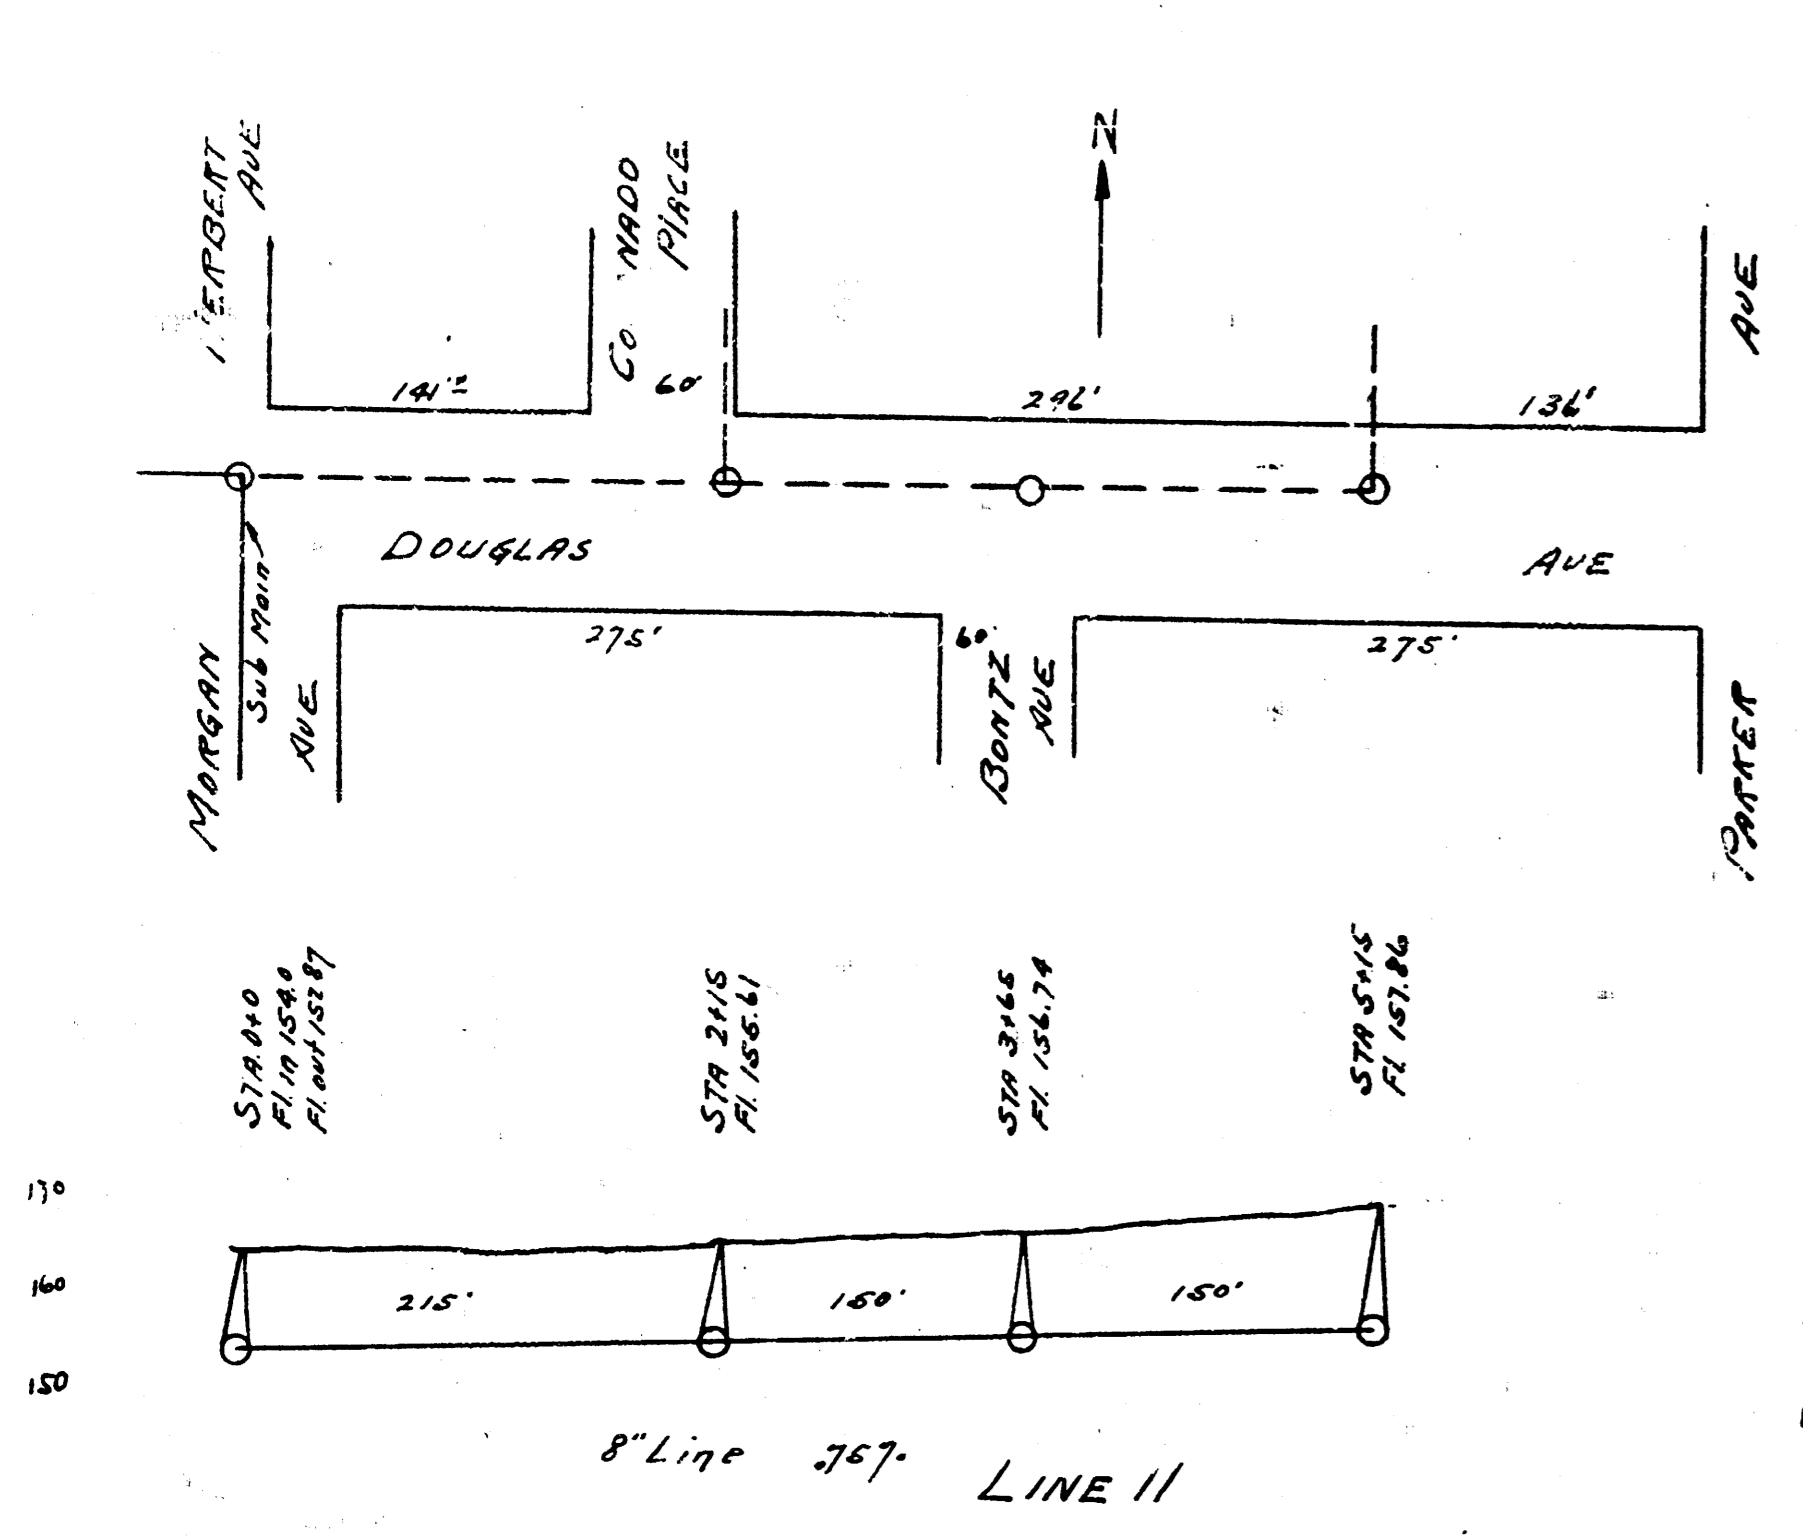

LAT. J, DIST. 6, S.S. 12.  
SHEET 4 4 SHEETS