
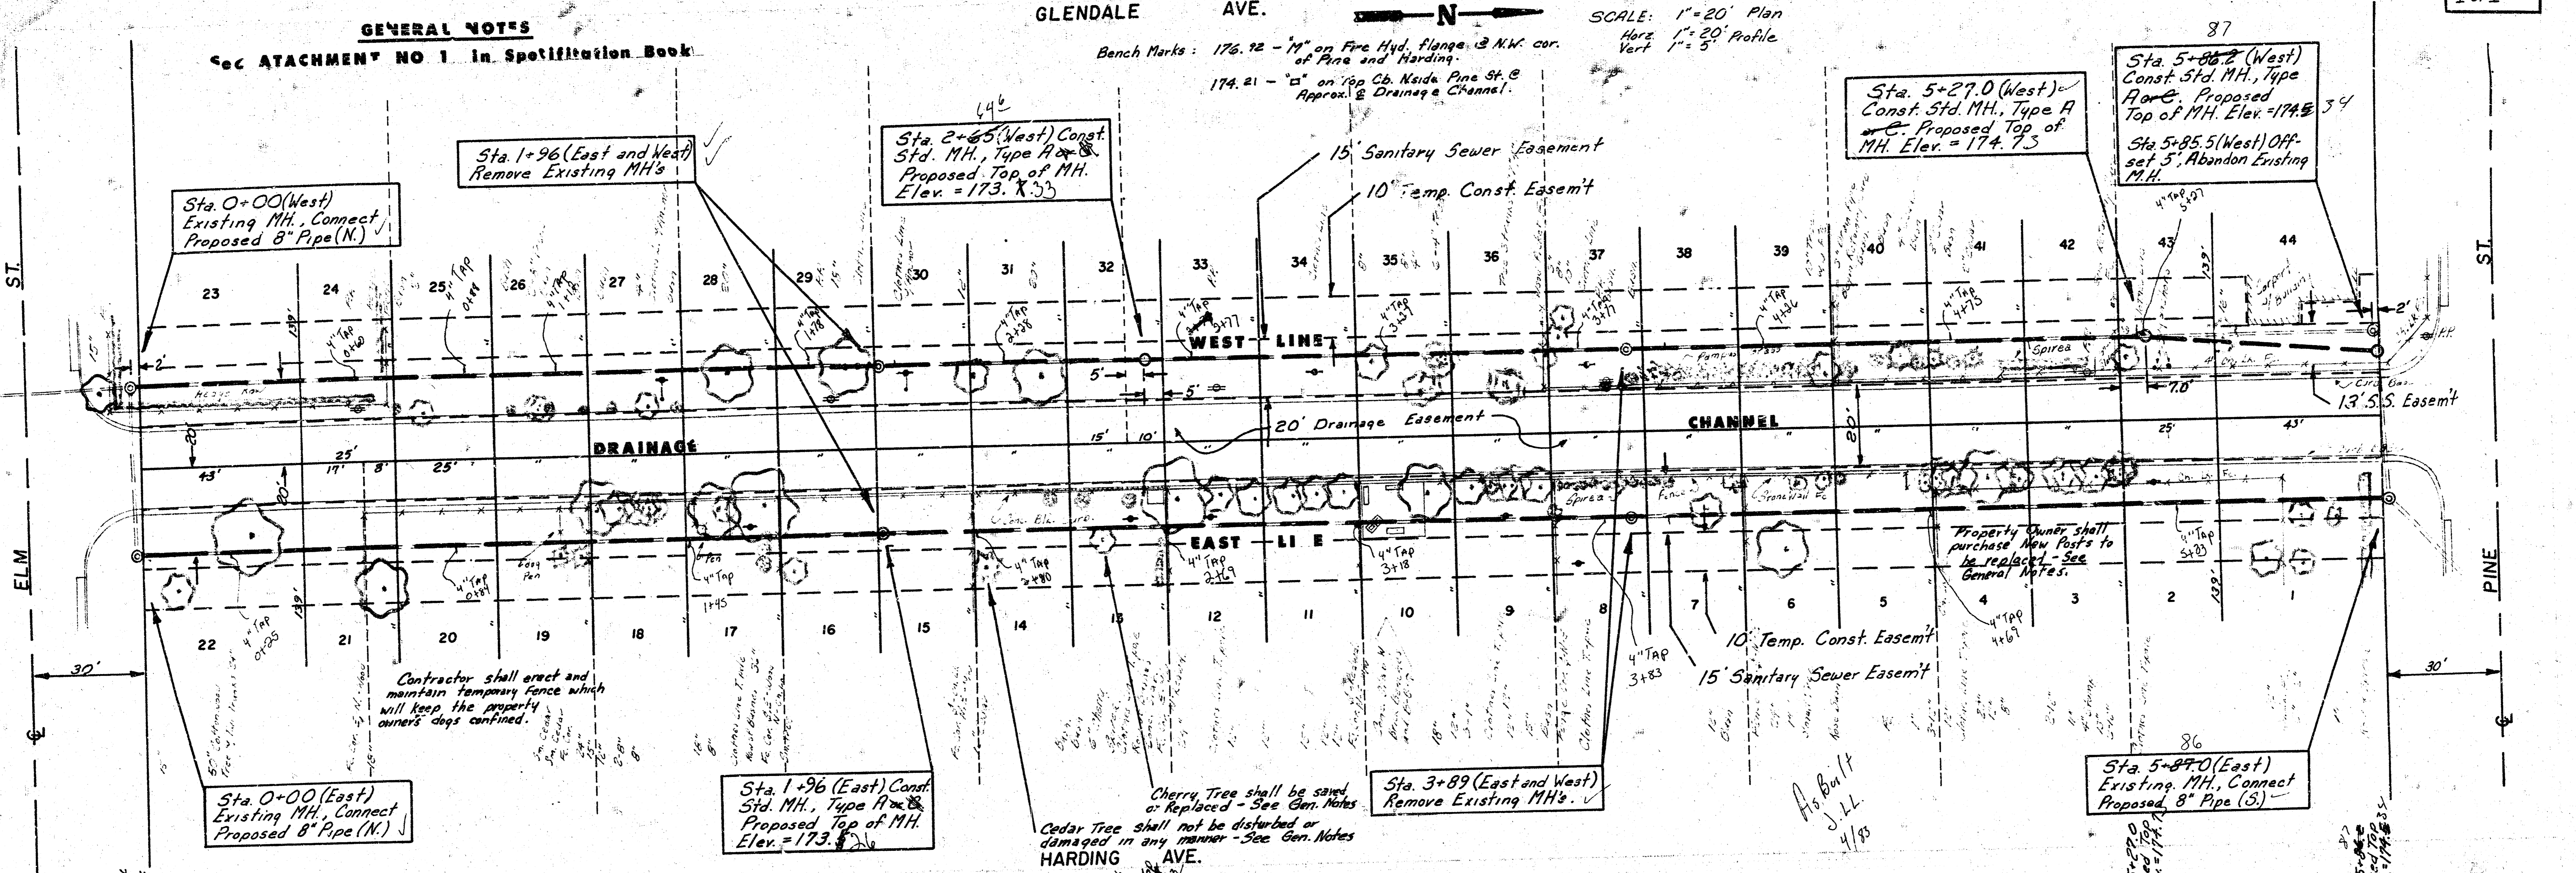
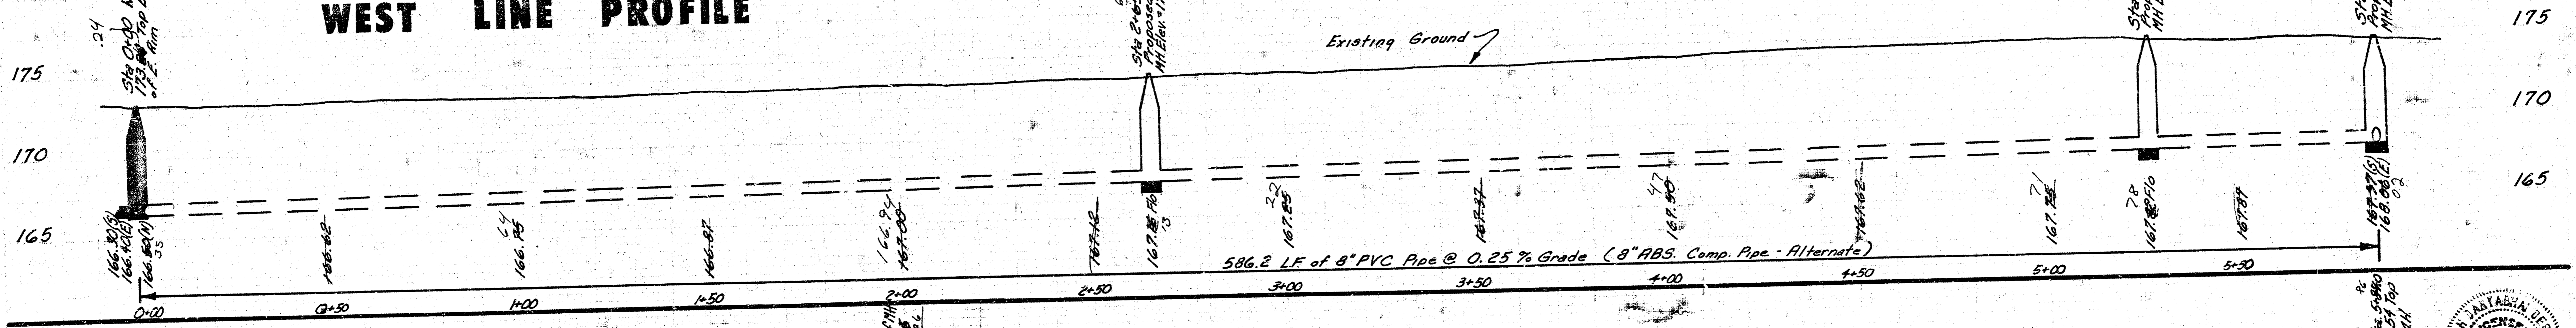


GENERAL NOTES
See ATTACHMENT NO 1 in Spot Elevation Book


GLENDALE AVE.  SCALE: 1" = 20' Plan
Bench Marks: 176.92 - "A" on Fire Hyd. Flange @ N.W. cor. of Pine and Harding.
174.21 - "B" on Top of. N.W. Pine St. @ Approx. @ Drainage Channel.



WEST LINE PROFILE



EAST LINE PROFILE

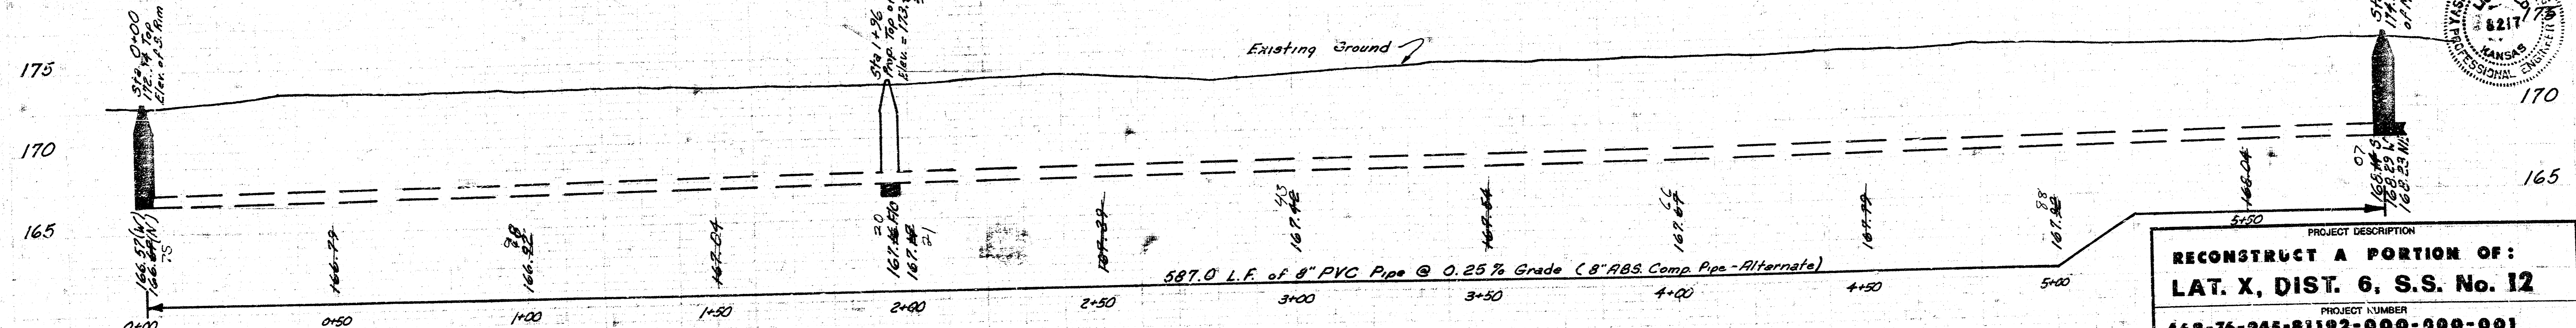


PROJECT DESCRIPTION
**RECONSTRUCT A PORTION OF:
LAT. X, DIST. 6, S.S. No. 12**

PROJECT NUMBER
468-76-245-81192-000-000-001

BOOK NO. DCD-169 APPROVED BY _____ DATE 6/82
DRAWN BY LINDZEY REVISION _____

CITY OF WICHITA
DEPARTMENT OF ENGINEERING
DIRECTOR OF ENG./CITY ENGINEER
R. W. BRUGGEMAN SCALE 1/1

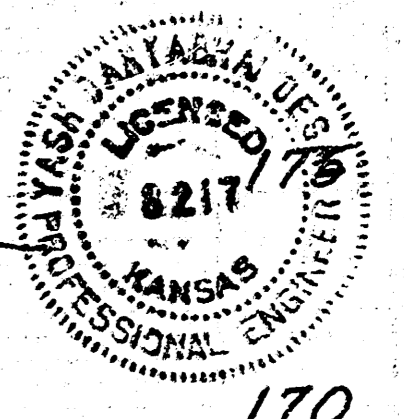

10 4 3 3