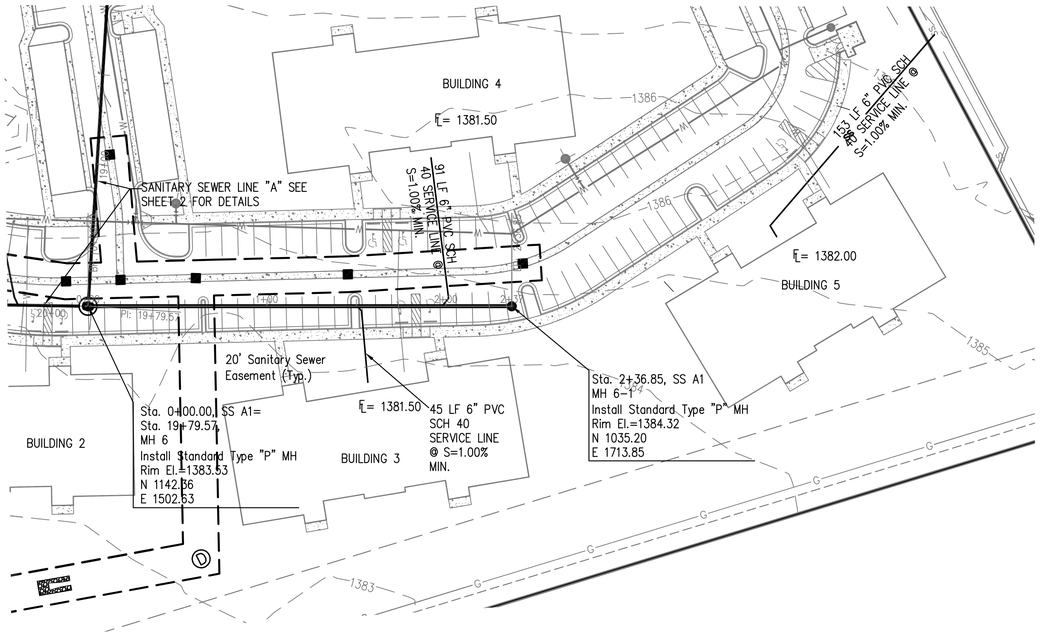

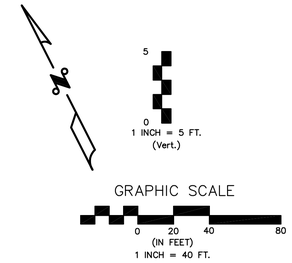

NOTE:
Service Lines from the buildings to the Sewer Mains shall be built by others after completion & acceptance of the 8" main.

SANITARY SEWER LINE "A-1"

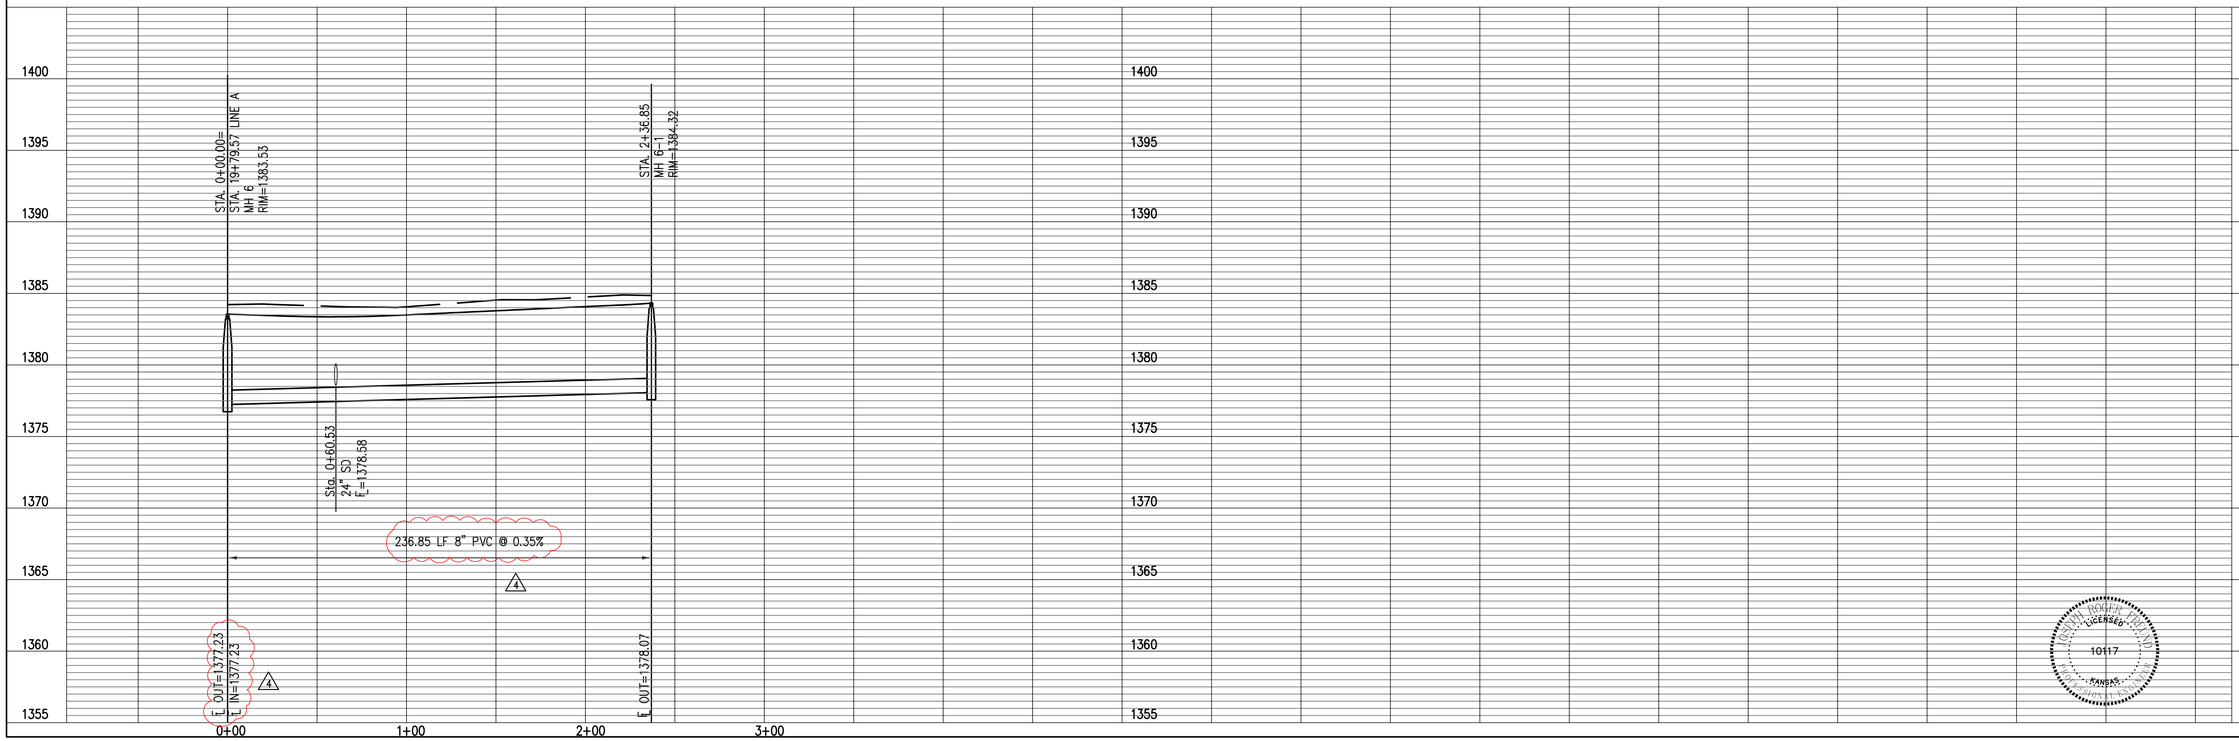

No.	Date	By	Approved	Revision
1				
2				
3				
4	01-24-08	KJW	JRF	CHANGED SAN. SEWER ELEVATIONS

PLAN & PROFILE
SAN. SEWER LINE A-1, A-2
Webber Group
Inwood Apartments

POE & ASSOCIATES, INC.
CONSULTING ENGINEERS
9940 E. Central, Suite 200 ■ Wichita, KS 67208-4242
Phone 316/685-4114 ■ FAX 316/685-4444

JOHN ROGER FRIESEN
LICENSED
10117
KANSAS
PROFESSIONAL ENGINEER

Engineer: JRF
Designer: kjw
Poe Job No.: 1909
Date: 8-31-07

Sheet 3
C-27 of 20

P:\1909A Revised Inwood\Working Dwgs\PP&SHEETZ\P & P SAN A1 - Sheet 2.dwg, Sheet 2, 4/9/2008 9:09:59 AM