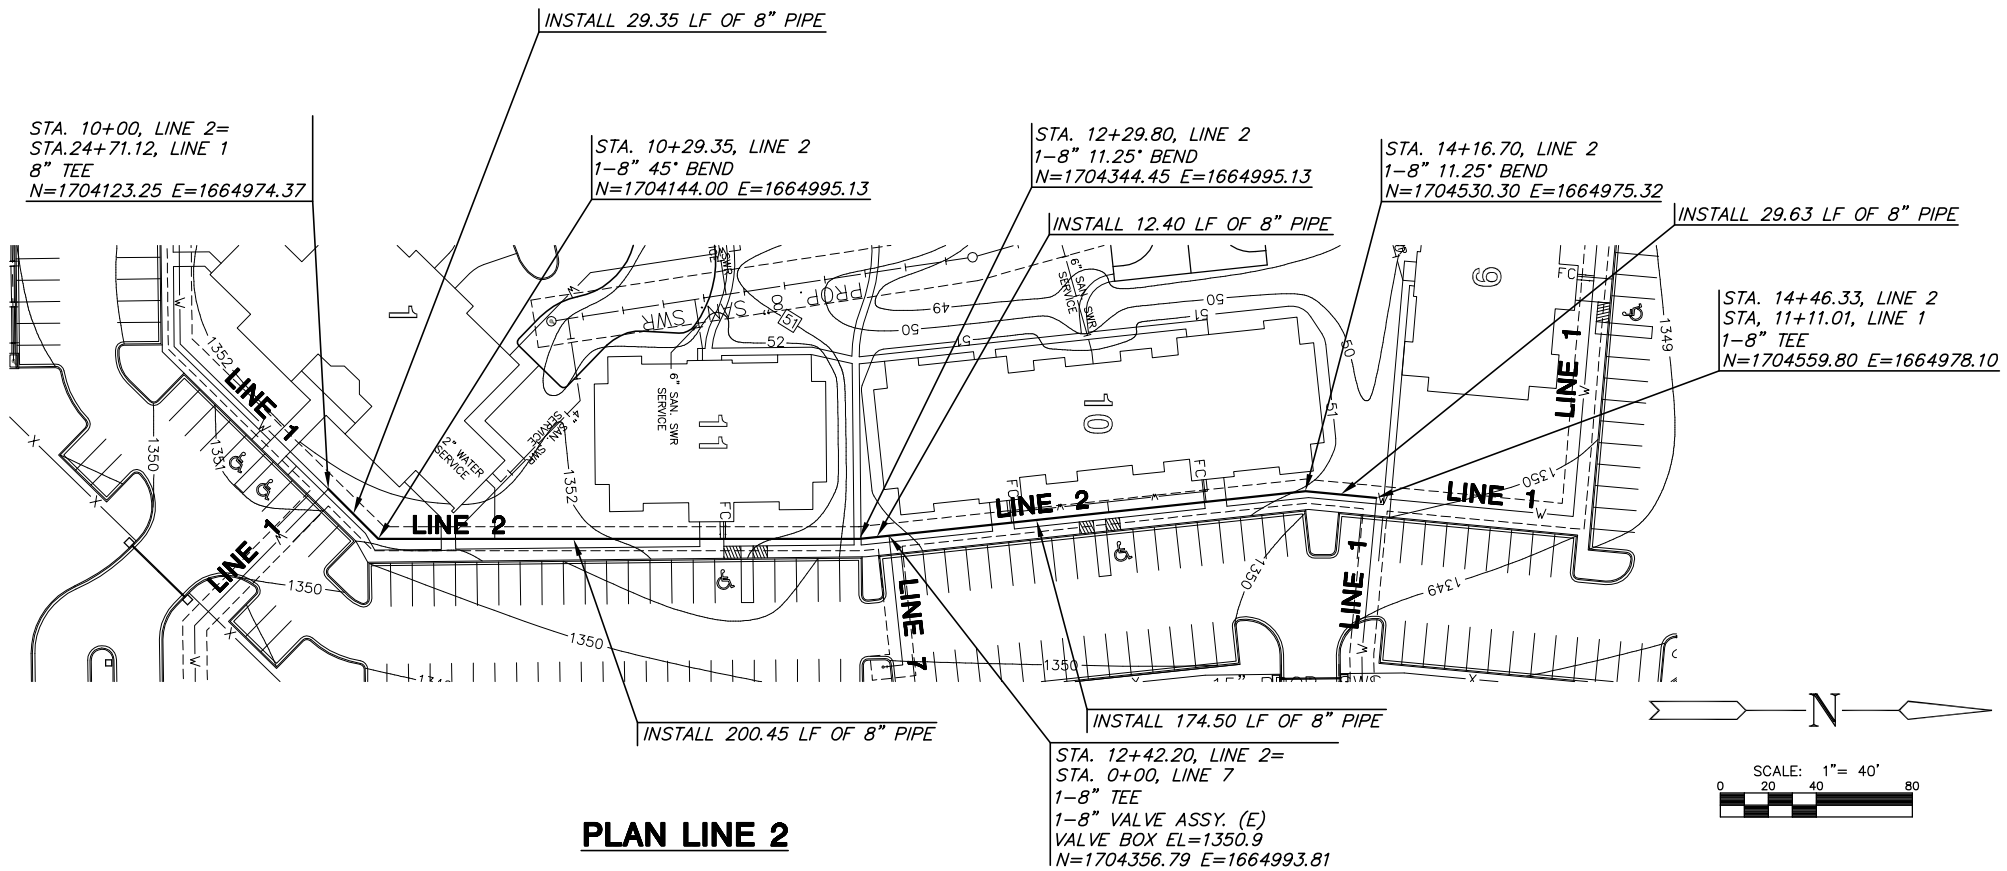

PLAN LINE 2

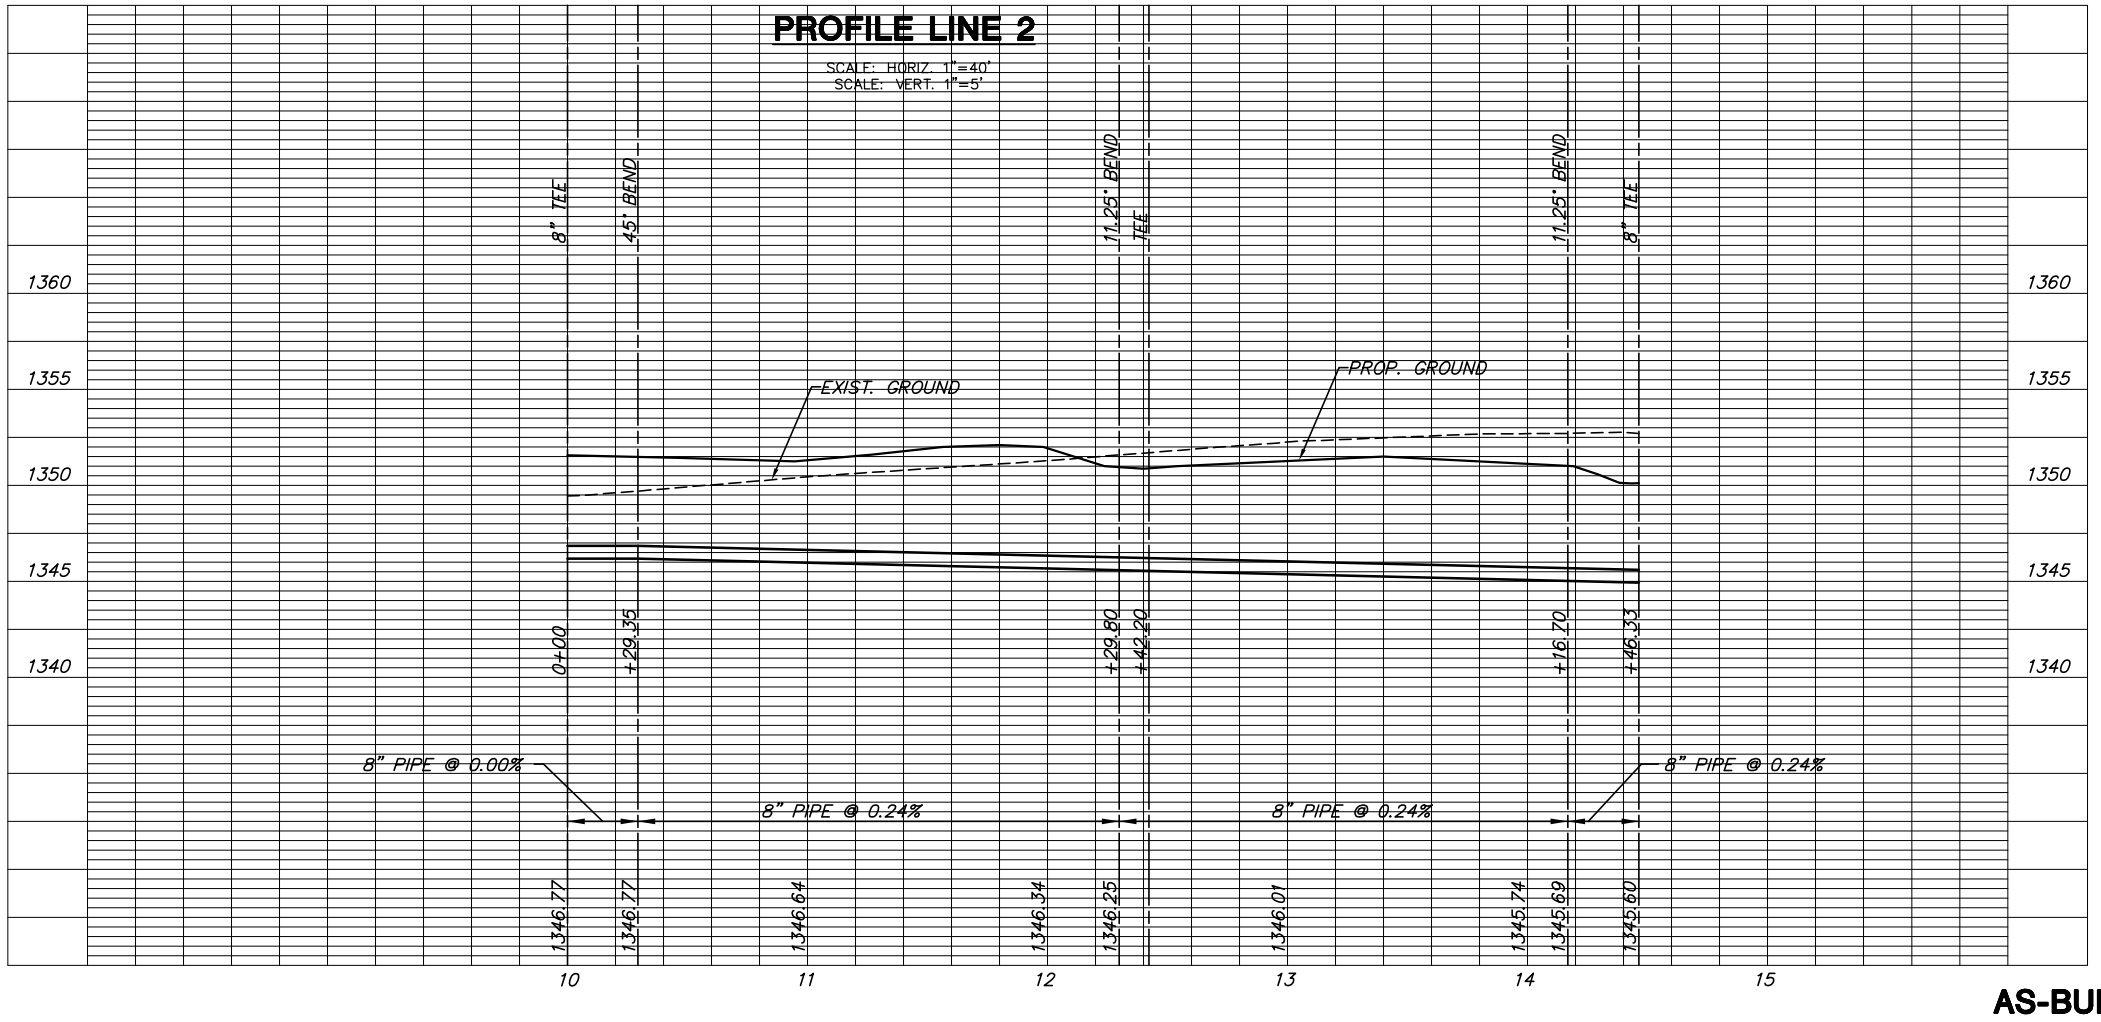

AS-BUILT FEBRUARY 2008

MKEC ENGINEERING CONSULTANTS, INC.
411 N. WEBB ROAD
WICHITA, KS. 67206
316 - 684 - 9600

WATER DISTRIBUTION PLANS

THE GROVE AT WICHITA

LOT 1, BLOCK 1 CAMPUS CREST

LINE 2
SHEET TITLE

07008 (CC)
07254 (MKEC)
PROJECT NUMBER

JTC
DESIGN BY

JWC
DRAWN BY

GJA
CHECKED BY

ISSUED
October 2007

REVISED

SHEET NO.
6 of 8

J:\CIVIL\07254\DWG\WTR\AS-BUILT\0725404.DWG

PLOTTED: Wednesday, April 23, 2008 @ 03:02PM