



SANITARY SEWER PLANS
KRUG SOUTH ADDITION
PHASE 1

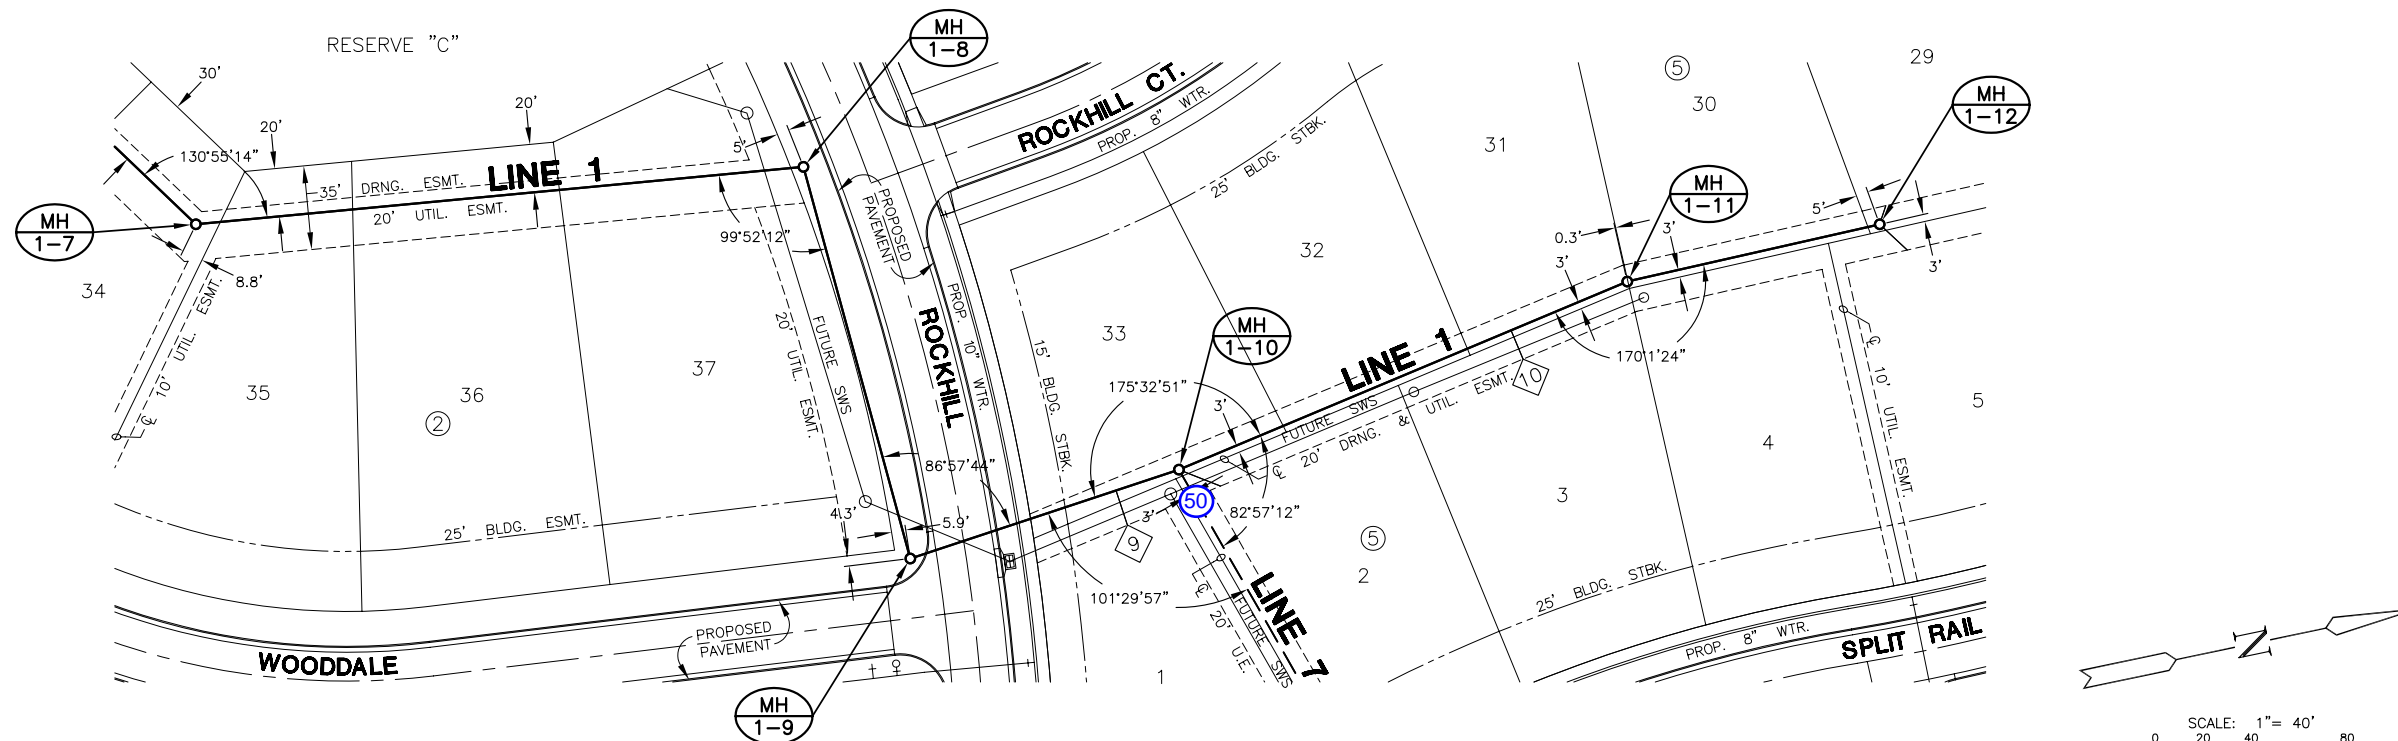

PLAN LINE 1

NOTE:
TRENCHES TO BE BACKFILLED WITH SAND AND FLUSHED WHEN SEWER LINE RUNS ALONG FRONT OF LOTS.

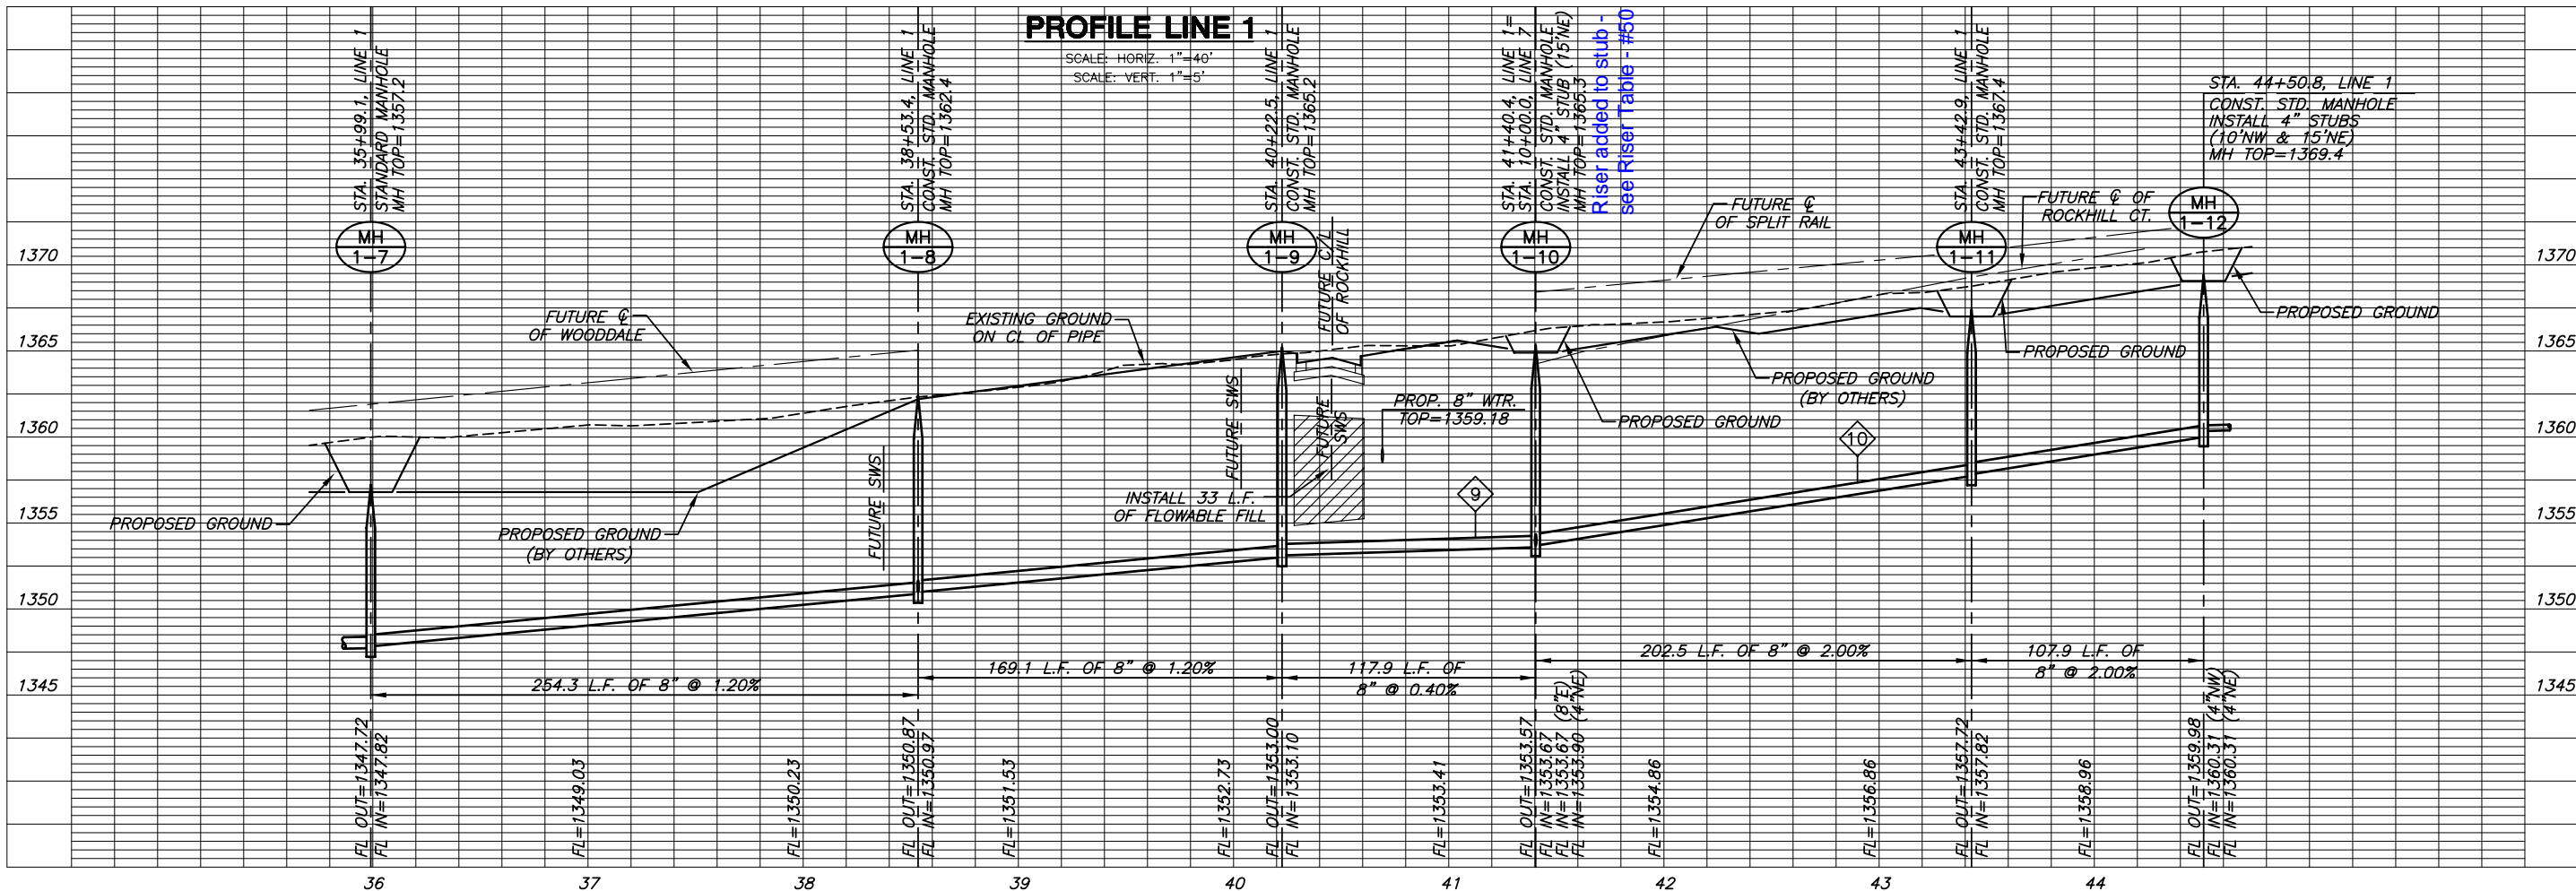

PROFILE LINE 1

LINE 1

SHEET TITLE
468-84321
PROJECT NUMBER

DESIGN BY **DFL**
DRAWN BY **DMU**
CHECKED BY **GJA**

ISSUED
February 2007
REVISED

SHEET NO.
10 of 31