NOTE:
CONTRACTOR TO VERIFY LIMITS OF TREE REMOVAL WITH DEVELOPER/ENGINEER PRIOR TO ANY REMOVAL.

= TREE REMOVAL

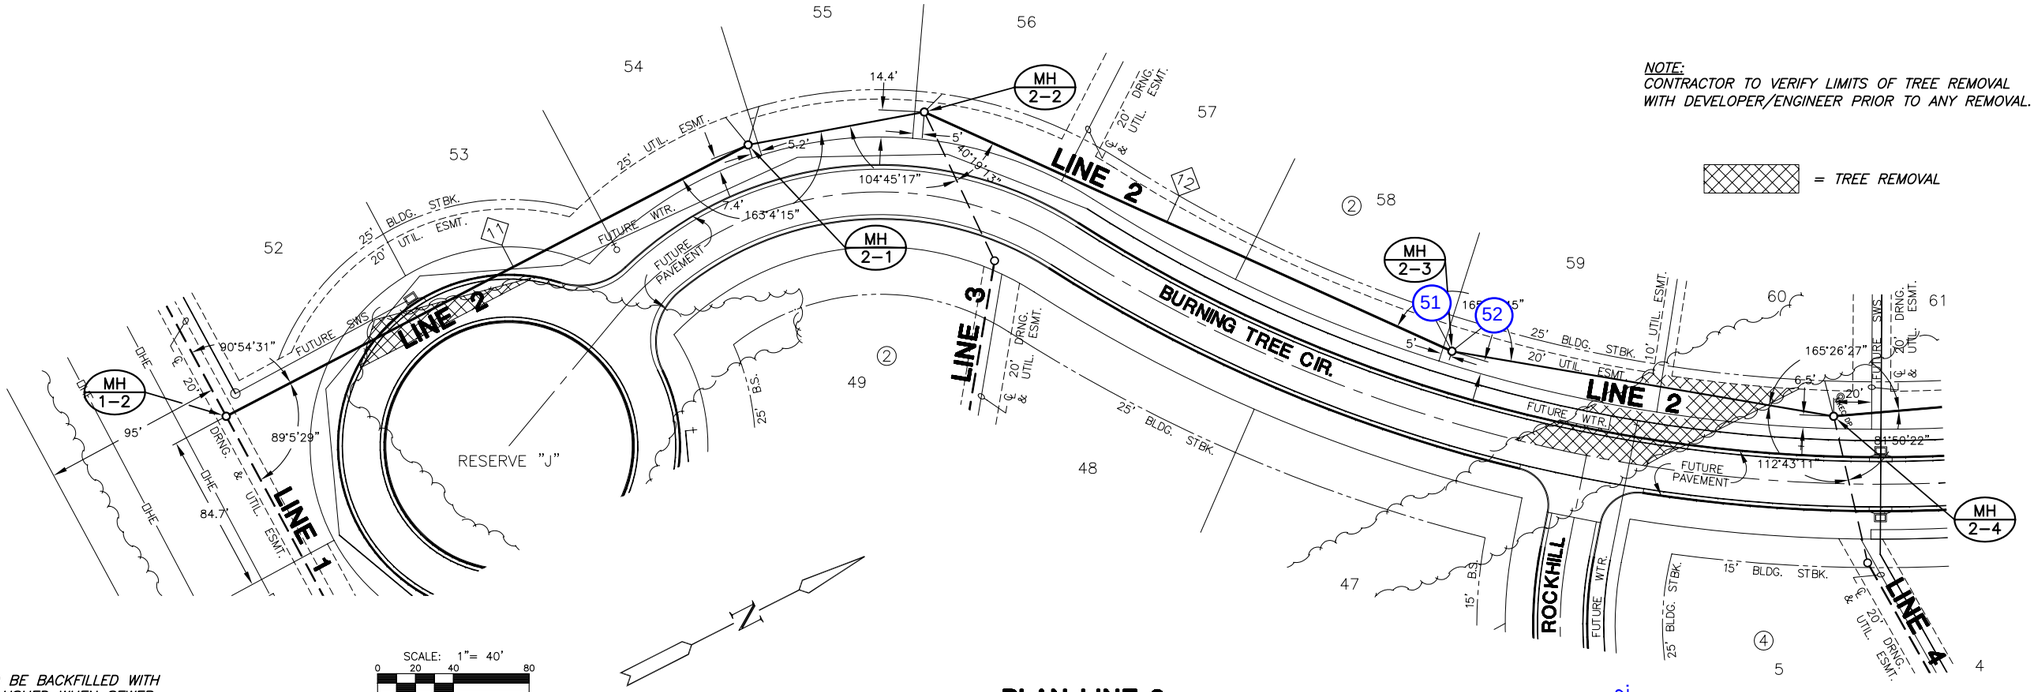

NOTE:
TRENCHES TO BE BACKFILLED WITH SAND AND FLUSHED WHEN SEWER LINE RUNS ALONG FRONT OF LOTS.

SCALE: 1"= 40'
0 20 40 80

PLAN LINE 2

PROFILE LINE 2

SCALE: HORIZ. 1"=40'
SCALE: VERT. 1"=5'

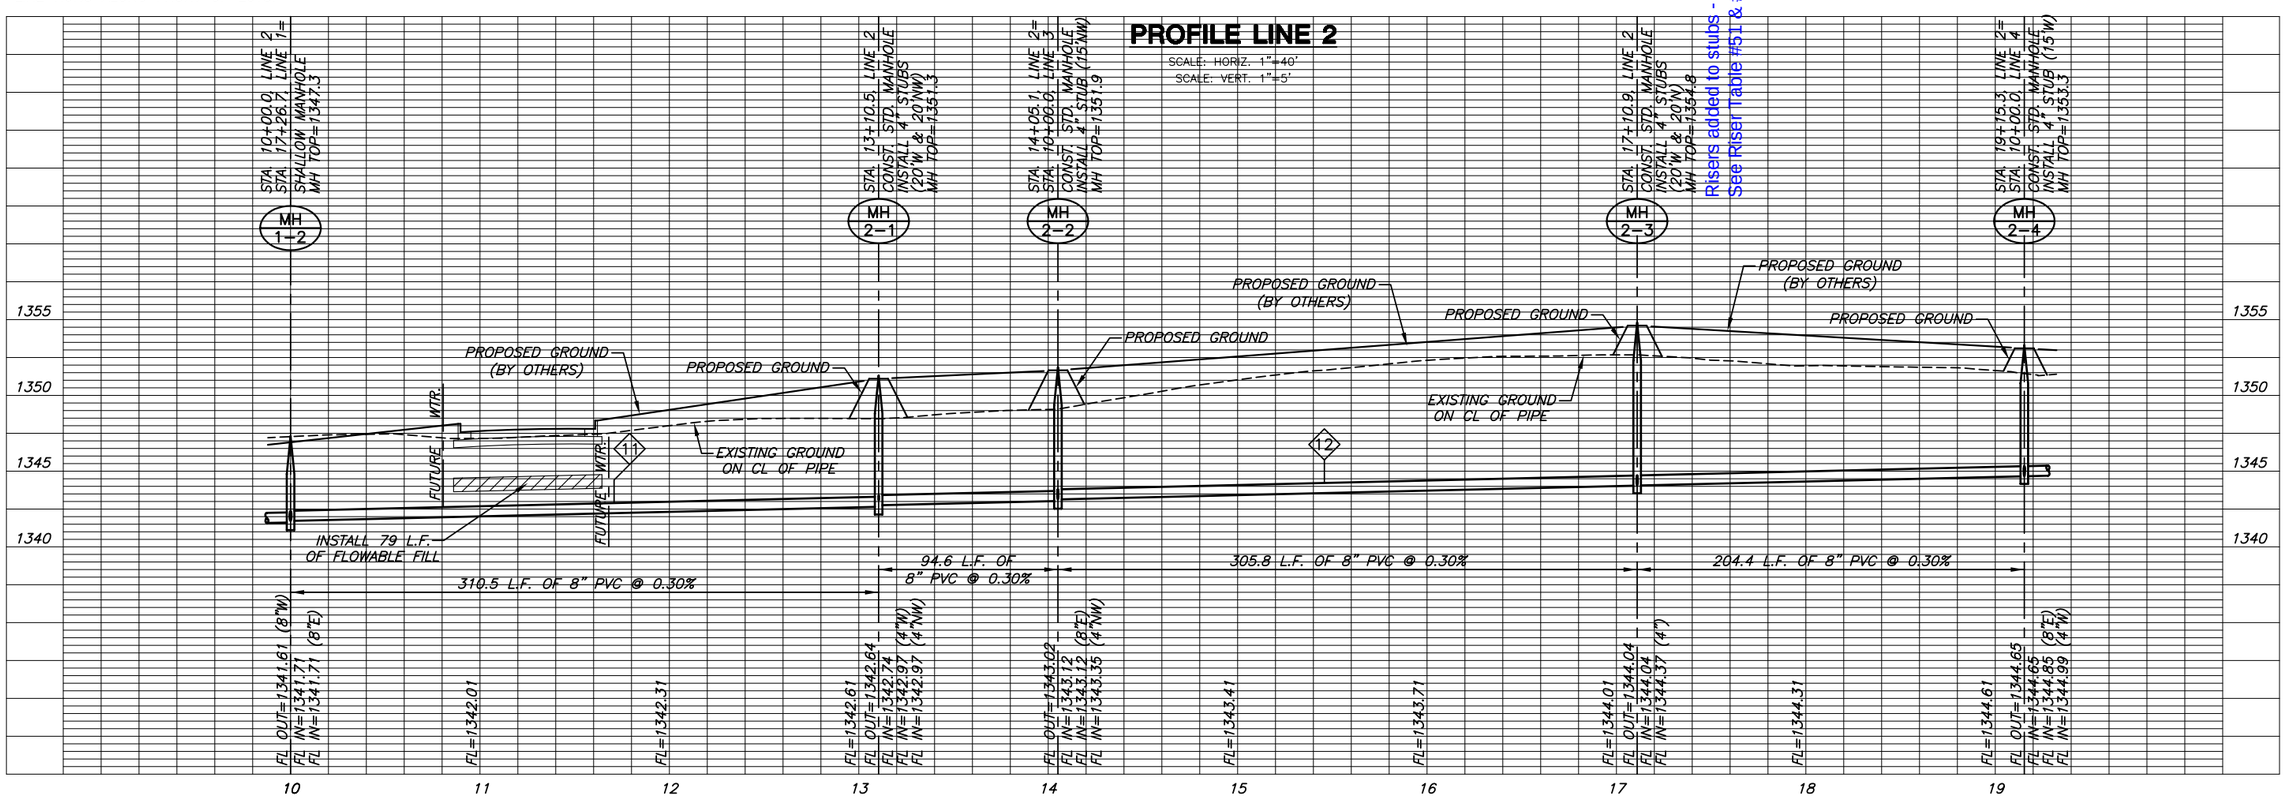

MKEC ENGINEERING CONSULTANTS, INC.
411 N. WEBB ROAD
WICHITA, KS. 67206
316 - 684 - 9600

SANITARY SEWER PLANS
KRUG SOUTH ADDITION
PHASE 1

LINE 2
SHEET TITLE
468-84321
PROJECT NUMBER

DFL
DESIGN BY
DMU
DRAWN BY
GJA
CHECKED BY

ISSUED
February 2007
REVISED

SHEET NO.
11 of 31

PLOTTED: Wednesday, February 28, 2007 @ 07:30AM

J:\CIVIL\05291\DWG\SAN\PH1\05291_B5.DWG