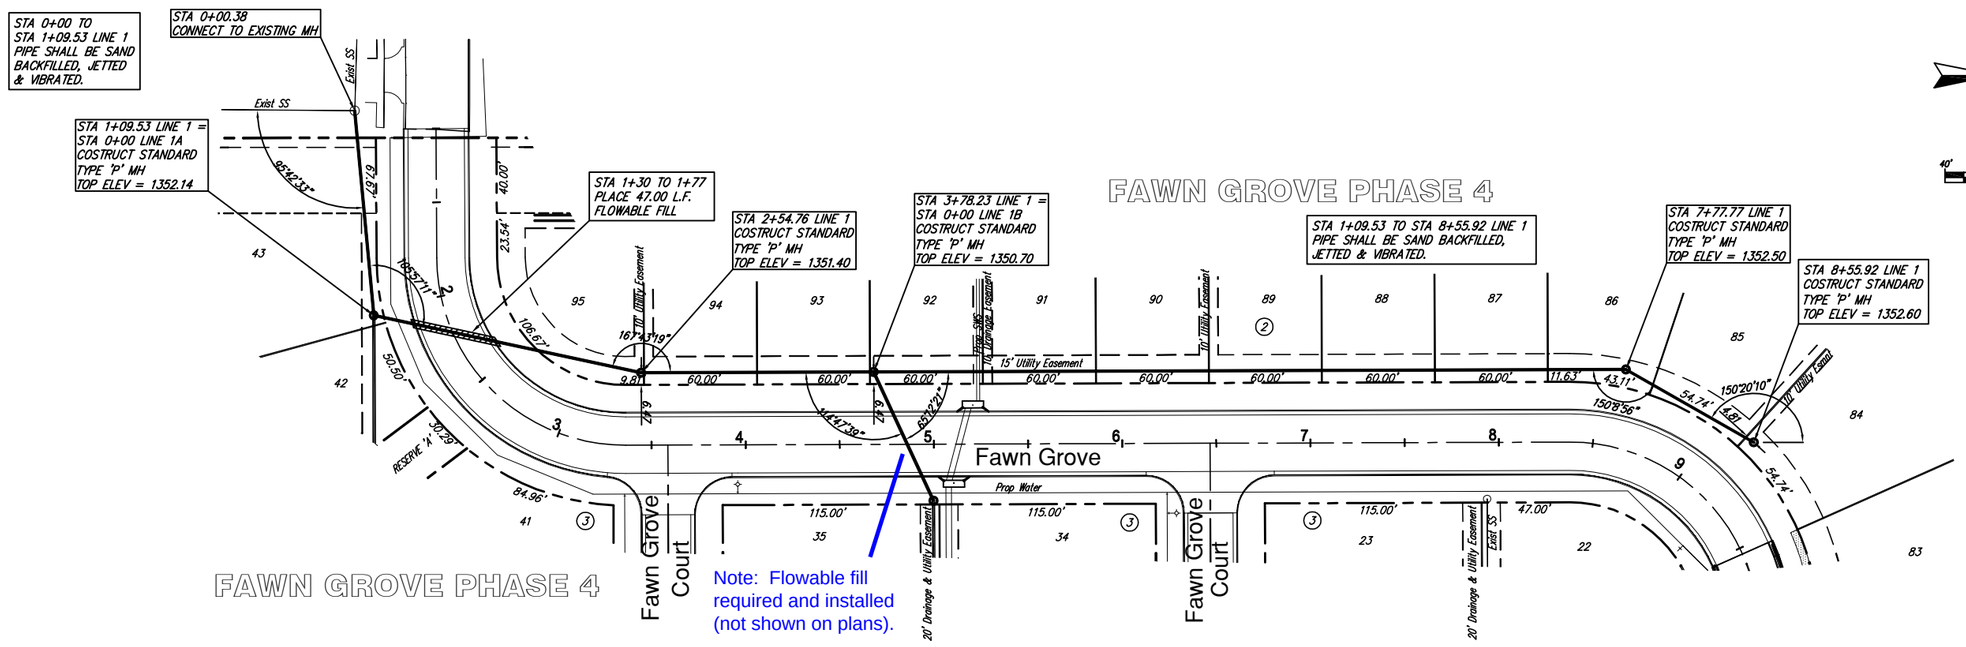

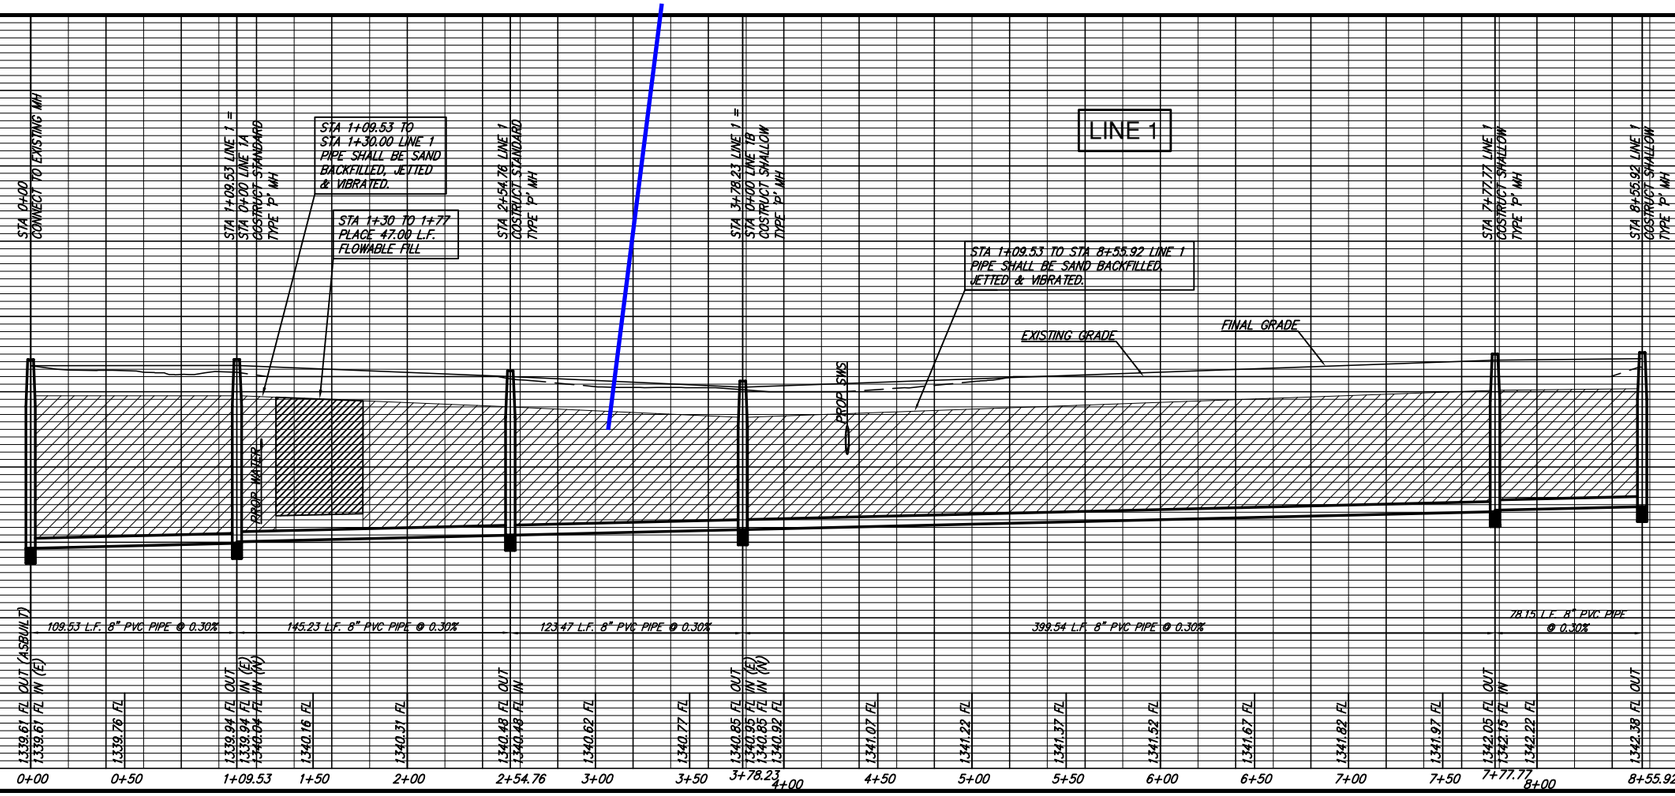

Ruggles & Bohm, P.A.
Engineering, Surveying, Land Planning
934 North Main
Wichita, Kansas 67203
(316) 264-6203
(316) 264-6211 fax
E-mail: ruggles@rbpa.com
www.rbpa.com

DESIGN	E.JG
DRAWN	RLS
DATE	May 24, 2007
UTILITY	
REVISED	
REVIEW	
PROJECT NUMBER	.
DRAWING FILE	SS 1

Fawn Grove Phase 4
SS Line 1
WICHITA, KANSAS

RB JOB 3075E

SHEET 2 of 16