

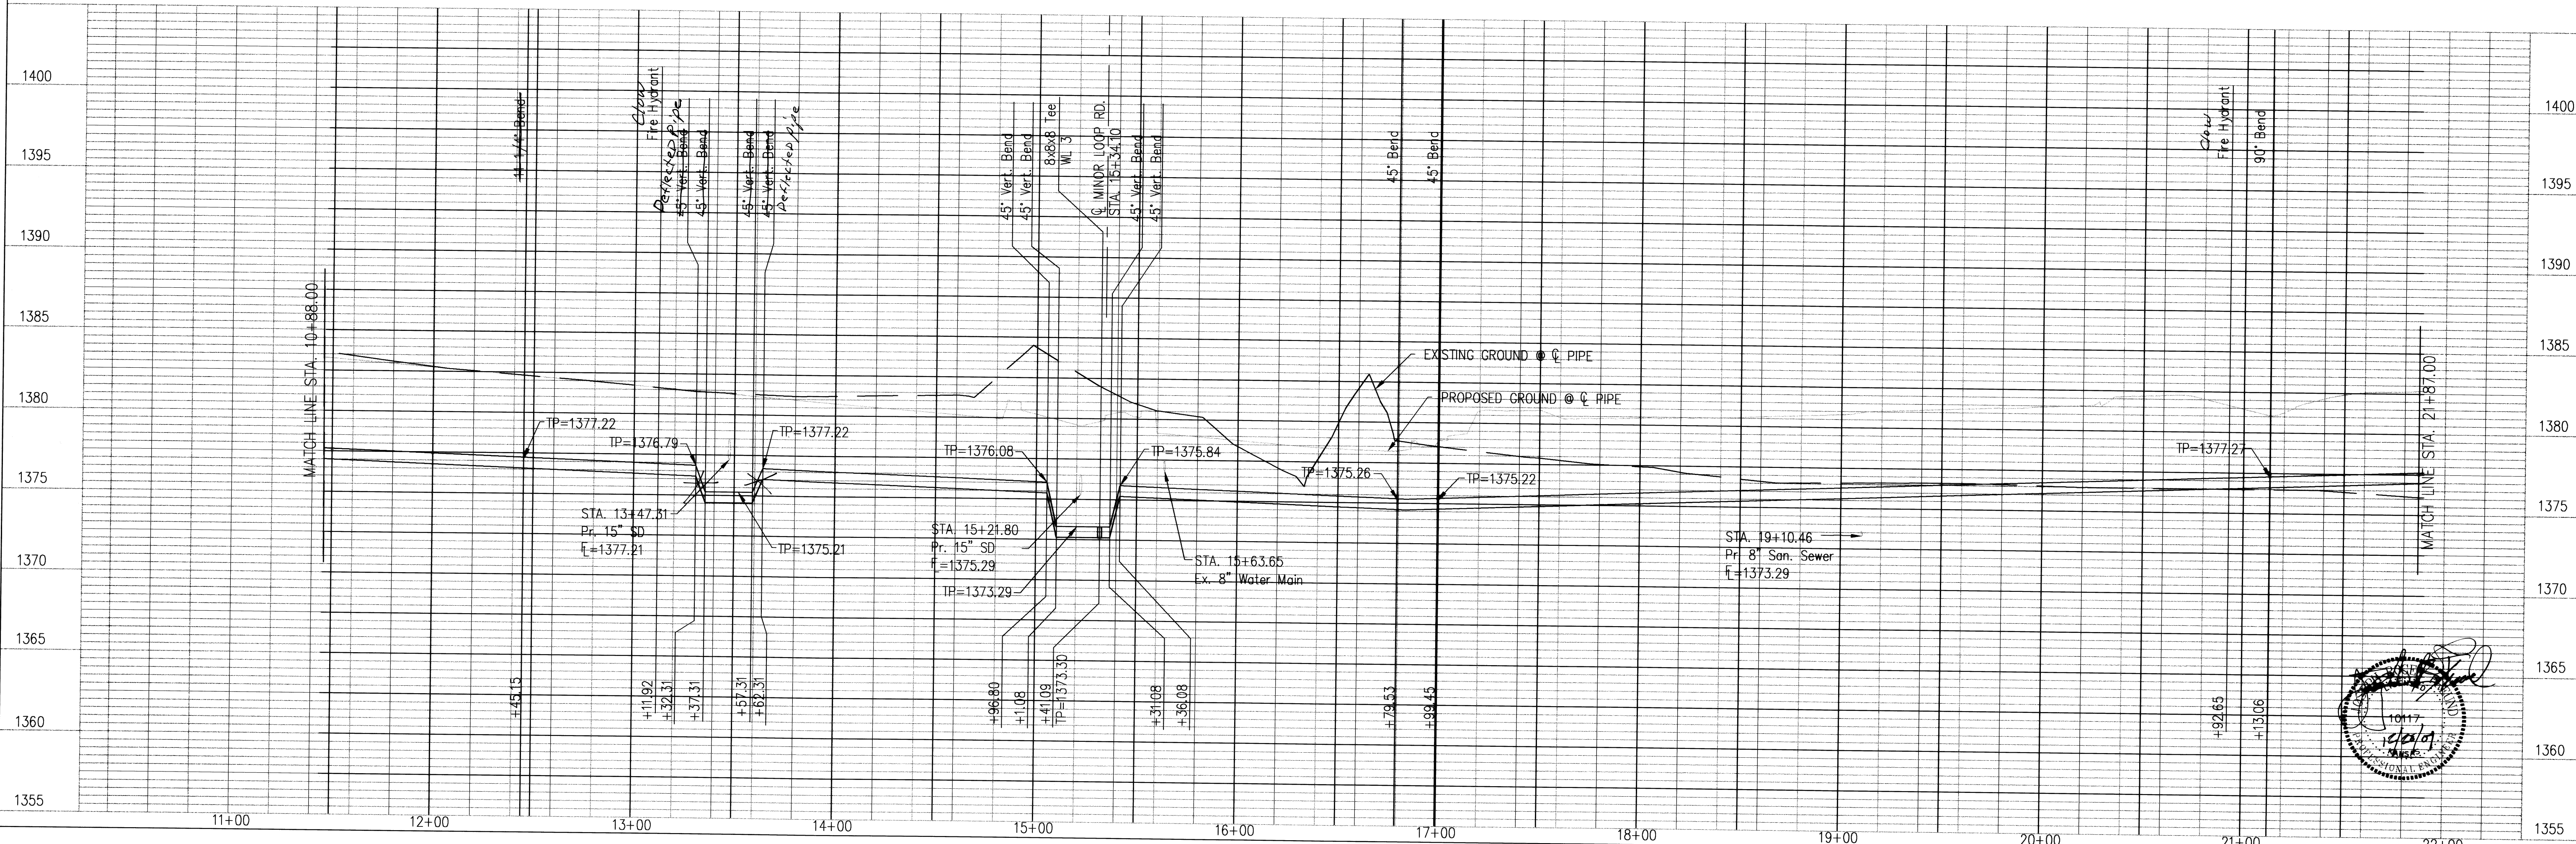


WATER LINE "1"

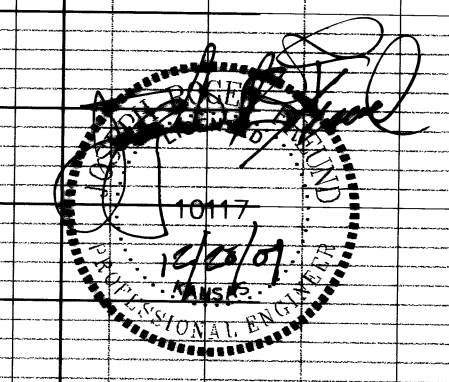

Engineer:	JRF	Approved:		Revision:	
Designer:	K/W	Date:		By:	
Poe Job No.:	1909	No.:	3	Date:	11-09-07
Date:	8-31-07	By:	JRF	Date:	11-09-07
Sheet 3	C-46	of 13			DELETED 3 GARAGES

POE & ASSOCIATES, INC.
CONSULTING ENGINEERS
5940 E. Central, Suite 200 ■ Wichita, KS 67208-4242
Phone 316/685-4114 ■ FAX 316/685-4444

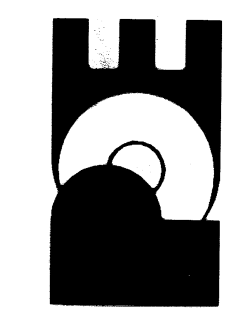

Plot Date: 11/09/07 10:42:04 AM