
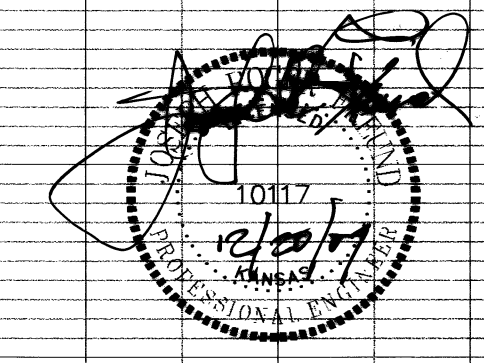


**Encasement Criteria:**

1. If the water line is below the sewer line than the sewer line will always be encased.
2. If the water line is above the sewer line and less than 24" separation than the sewer line is to be encased.
3. If the water line is above the sewer line and more than 24" separation than no encasement is needed.

# WATER LINE "1"

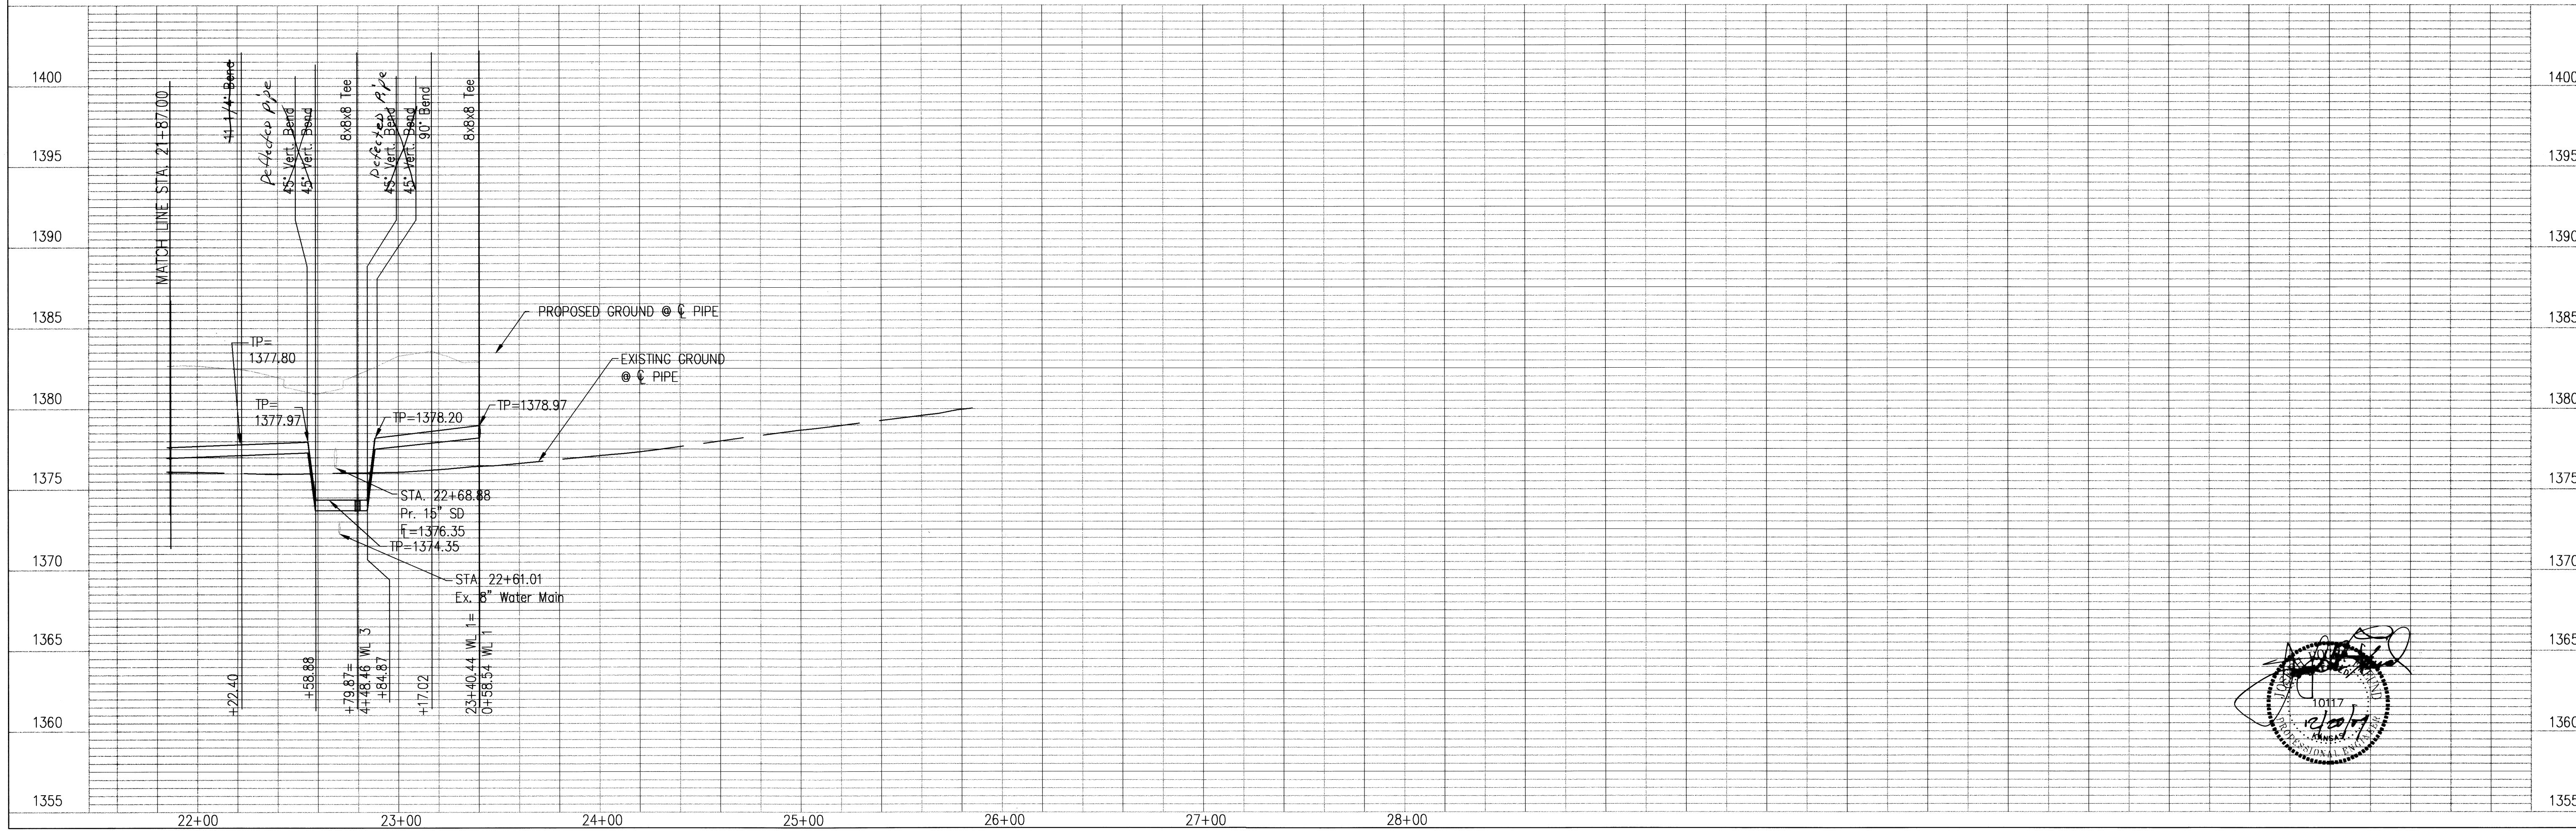

<b>PLAN &amp; PROFILE</b> <b>WATER LINE "1"</b> Webber Group Inwood Apartments	
No.	<input type="checkbox"/> <input type="checkbox"/> <input type="checkbox"/> <input type="checkbox"/>
Date	
By	
Approved	
Revision	
<b>POE &amp; ASSOCIATES, INC.</b> <b>CONSULTING ENGINEERS</b> 3940 L. Central, Suite 200 ■ Wichita, KS 67208-0242 Phone 316/685-4114 ■ FAX 316/685-4444	
Engineer:	JRF
Designer:	KJW
Poe Job No.:	1909
Date:	8-31-07
Sheet 4 C-47 of 13	