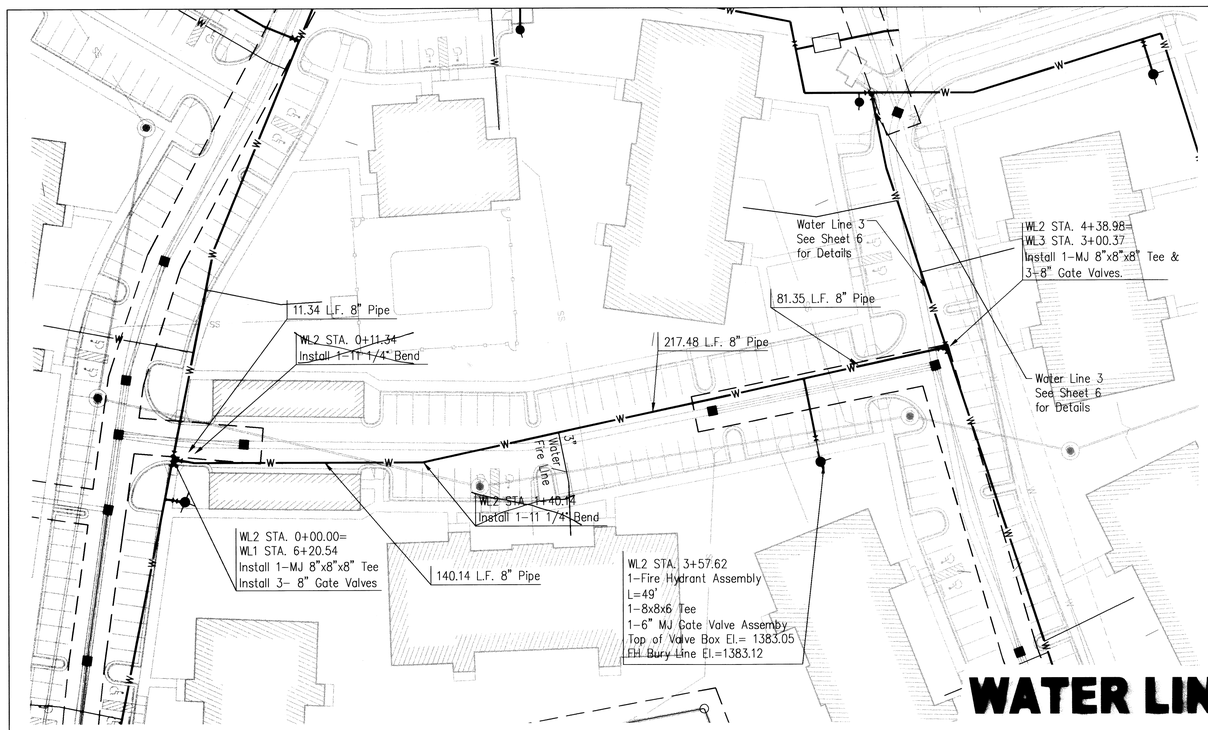

WATER LINE "2"

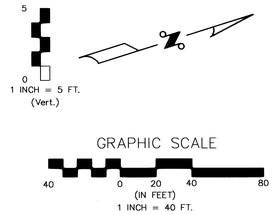

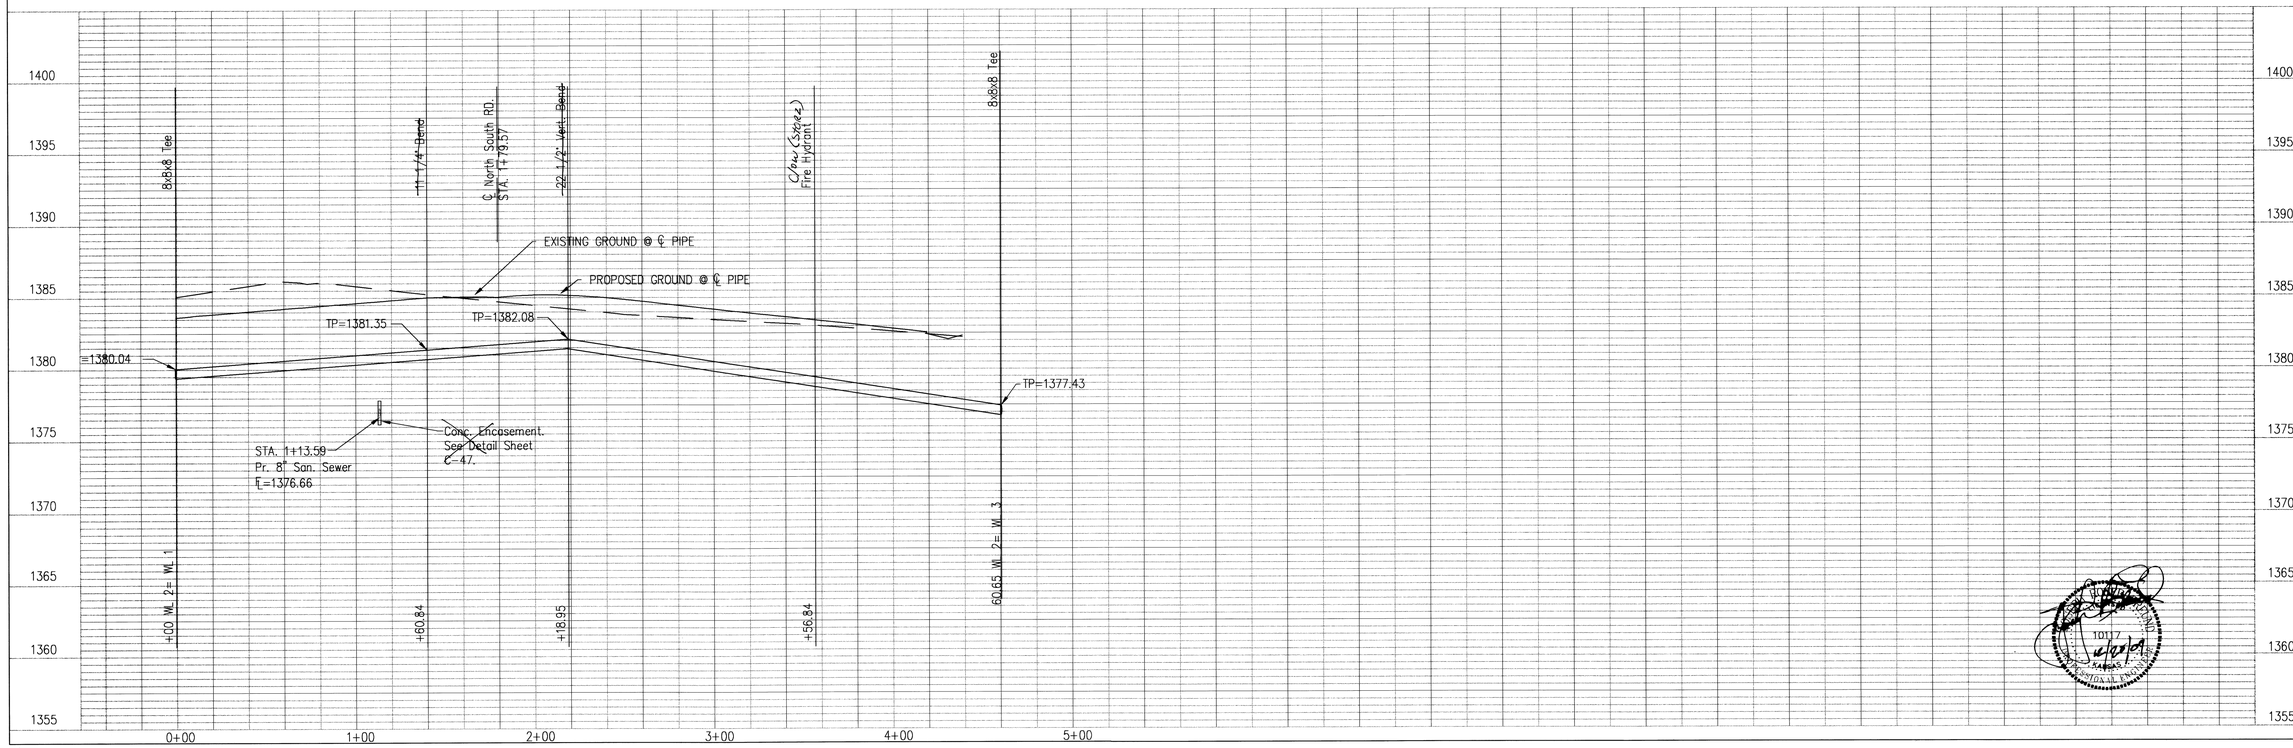

No.	Date	By	Approved	Revision

PLAN & PROFILE
WATER LINE "2"
Webber Group
Inwood Apartments

POE & ASSOCIATES, INC.
CONSULTING ENGINEERS
5940 E. Central, Suite 200 ■ Wichita, KS 67208-4242
Phone 316/685-4114 ■ FAX 316/685-4444

Engineer: JRF
Designer: KJW
Poe Job No.: 1909
Date: 8-31-07

Sheet 5
C-48 of 13

P:\1909A Revised Inwood\Working Dwgs\PW\SHEETS\Webber 2 p & p - Sheet 1.dwg, Sheet 1, 12/20/2007 10:42:27 AM