


SANITARY SEWER LINE "A"

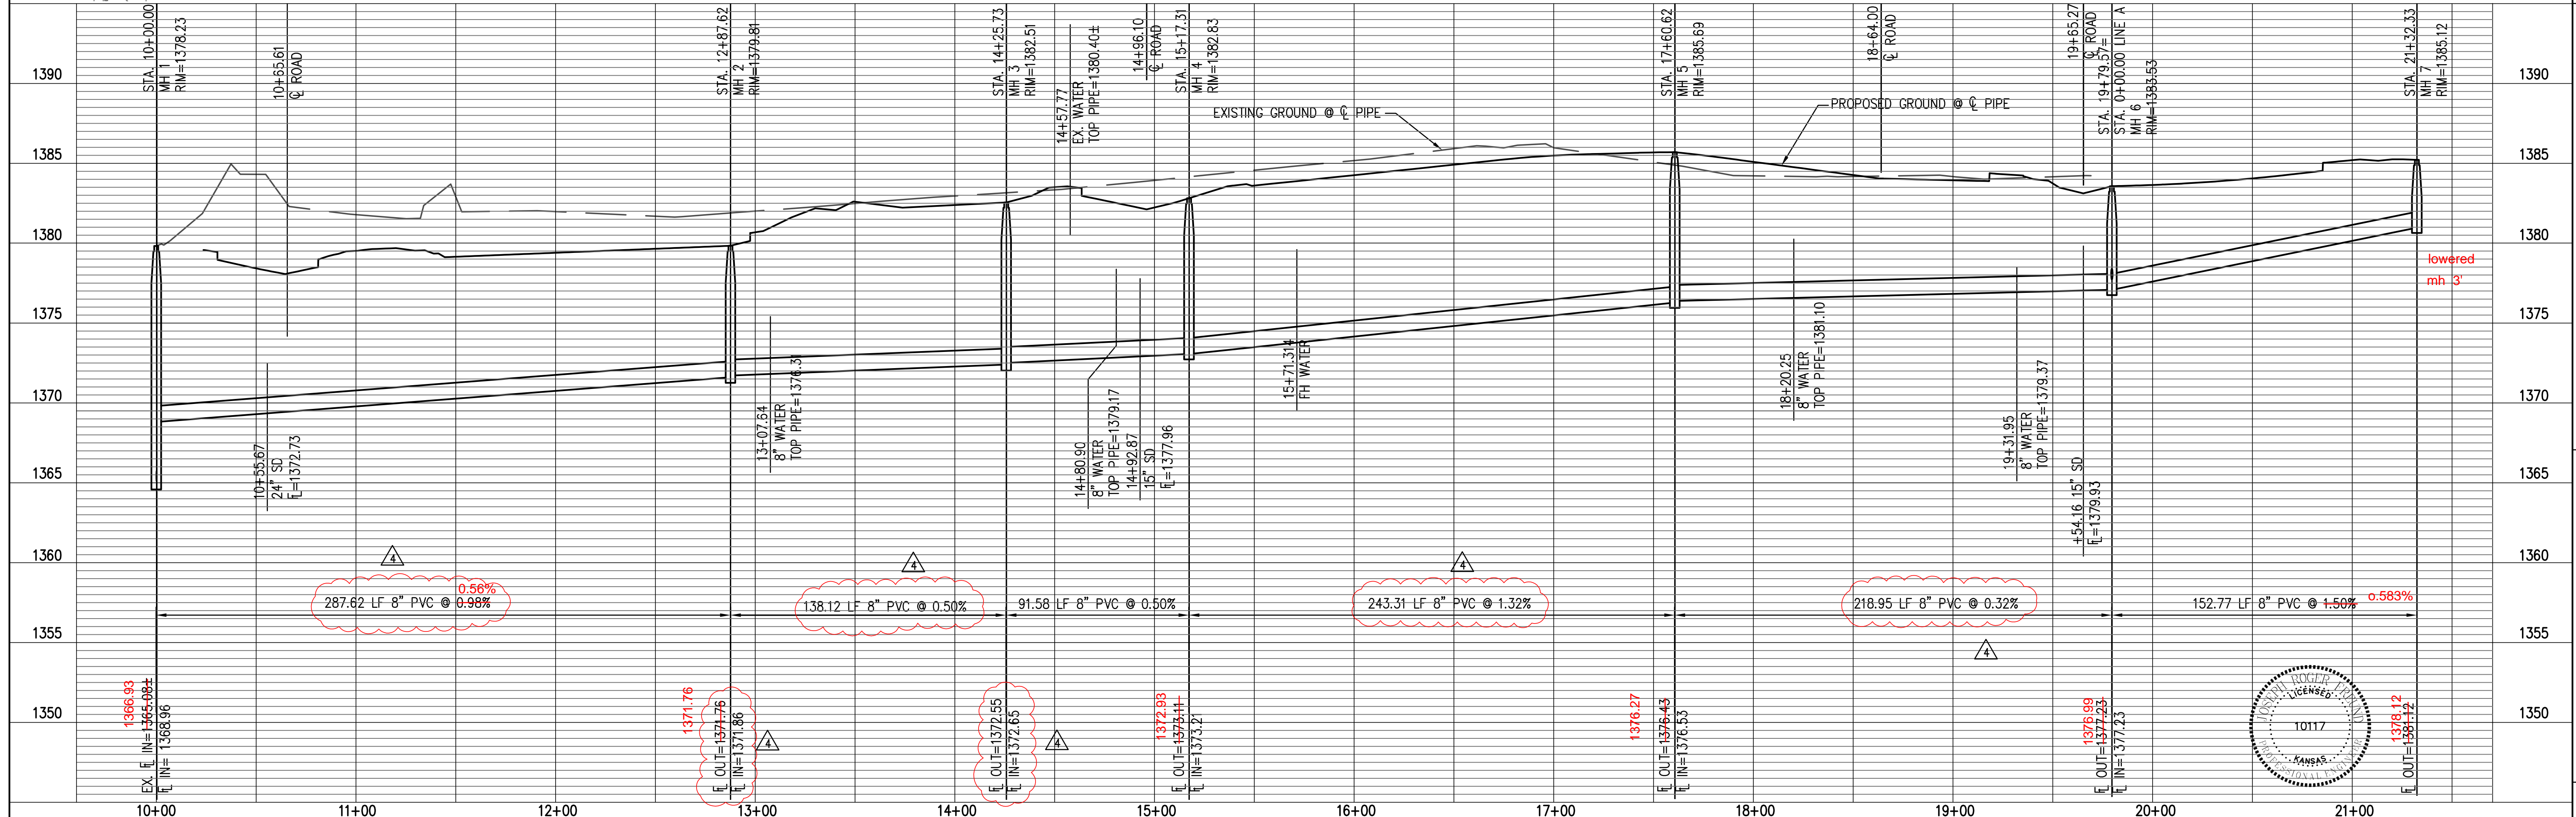

PLAN & PROFILE "A"
SANITARY SEWER LINE "A"
 Webber Group
 Inwood Apartments

No.	Date	By	Approved	Revision
1	01-24-08	K/W	JRF	CHANGED SAN. SEWER ELEVATIONS
2	11-09-07	K/W	JRF	DELETED 3 GARAGES

Engineer: JRF
 Designer: K/W
 P.O. Job No.: 1909
 Date: 8-31-07

Sheet 2 of 26
 C-26

POE & ASSOCIATES, INC.
 CONSULTING ENGINEERS
 5940 E. Central, Suite 200 • Wichita, KS 67208-4942
 Phone 316/685-4114 • FAX 316/685-4444

P:\1000A Revamped Inwood\Working Drawings\SSHEETS\26.P & P SAN A - Sheet 1.dwg, Sheet 1, 4/23/2008 8:58:03 AM