
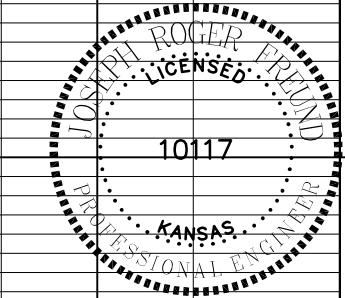



# STORM DRAIN LINE "2"

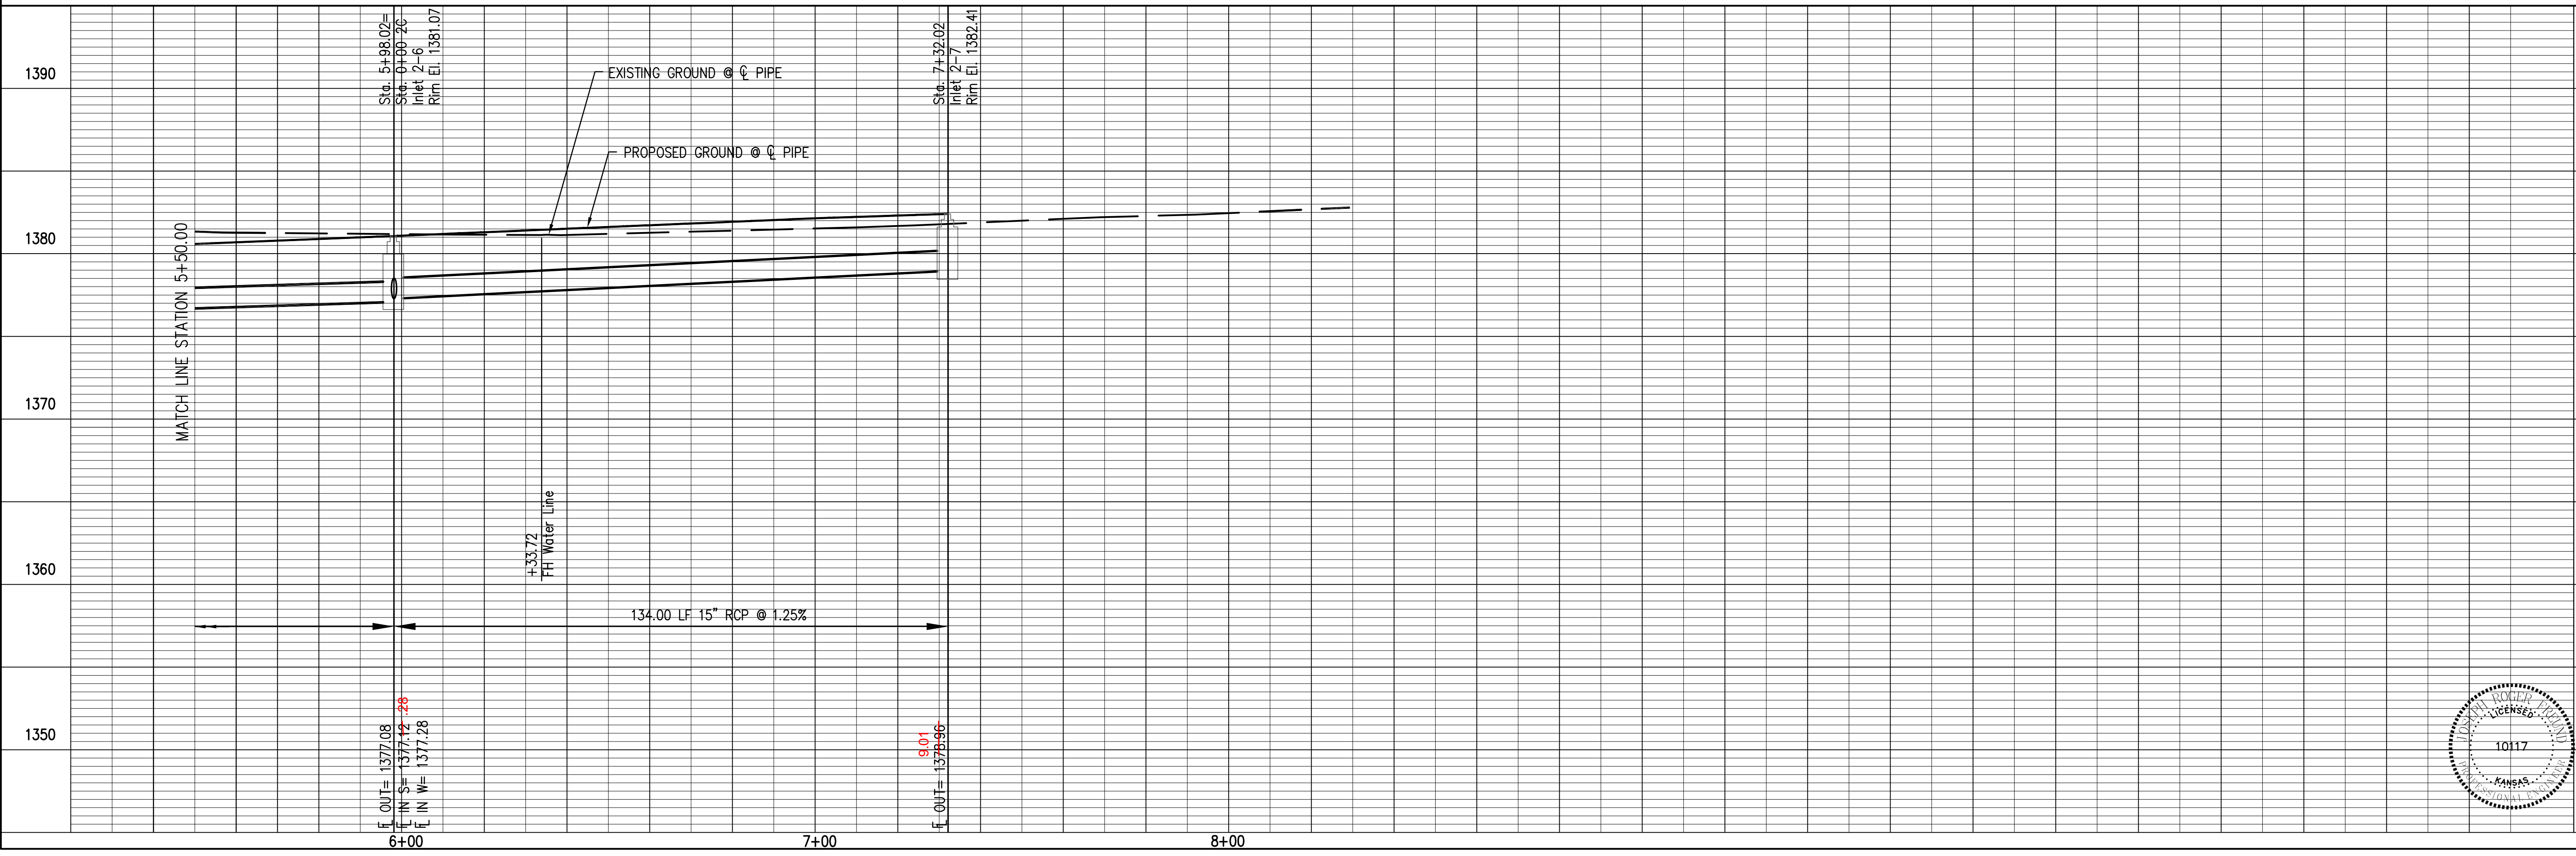

No.	Date	By	Approved	Revision
1				
2				
3				
4				

PLAN AND PROFILE  
 STORM DRAIN LINE "2"  
 Webber Group  
 Inwood Apartments

**POE & ASSOCIATES, INC.**  
 CONSULTING ENGINEERS  
 5940 E. Central, Suite 200 ■ Wichita, KS 67208-4242  
 Phone 316/685-4114 ■ FAX 316/685-4444

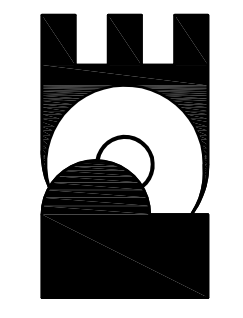

Engineer: JRF  
 Designer: KJW  
 P.O. Job No.: 1909  
 Date: 8-31-07

Plot 000A Revit 2008 Inwood Apartments DWG: PPS-SHEET3.rvt, P. 6 of 2 - SHEET 3.rvt, Date: 8/31/07 9:05:30 AM