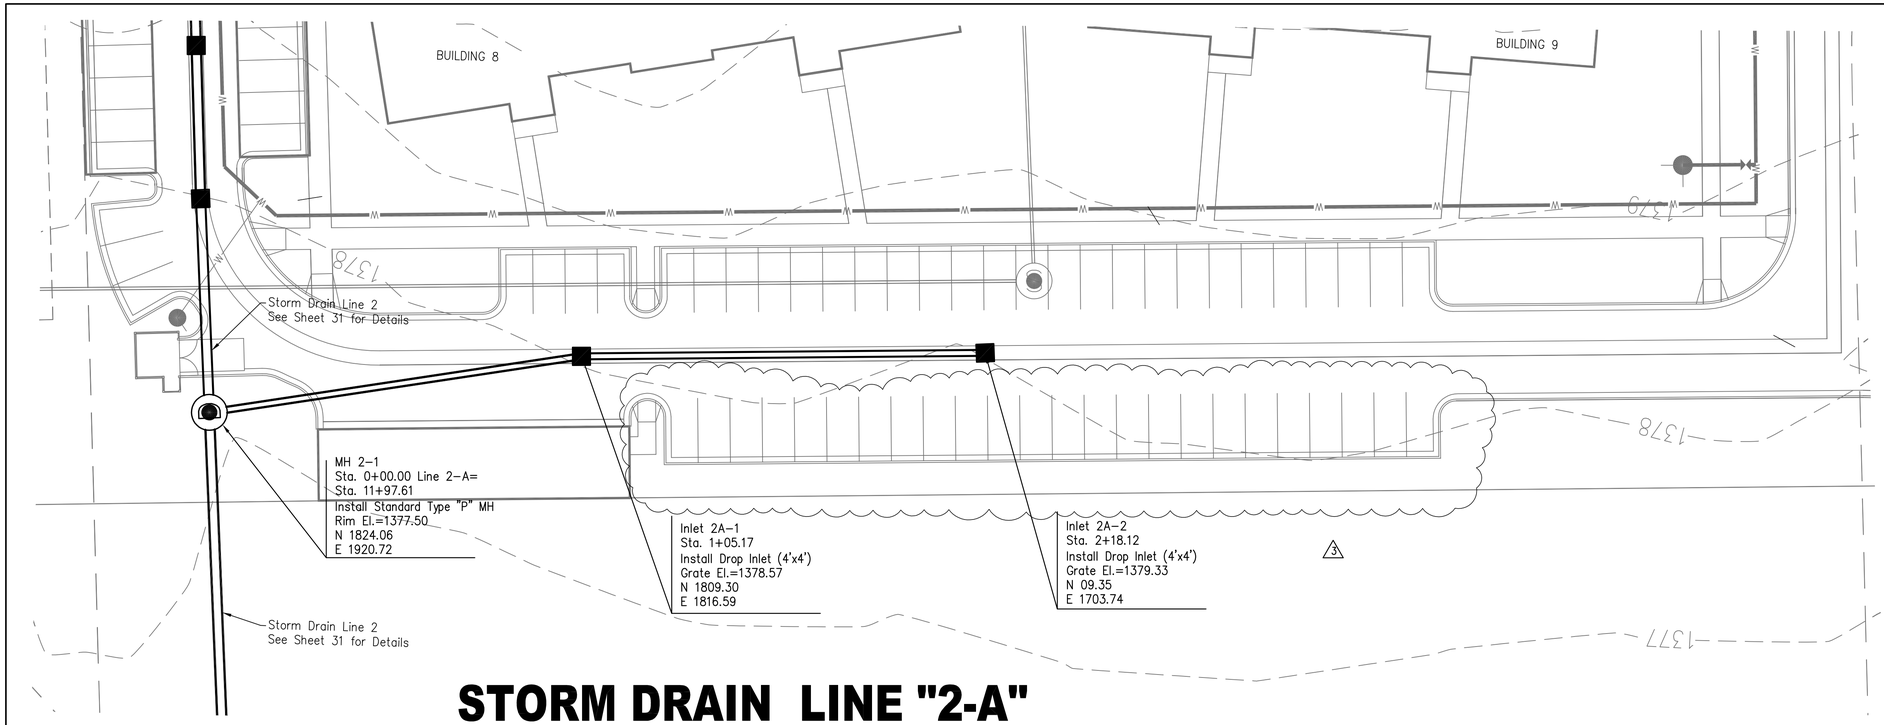

STORM DRAIN LINE "2-A"

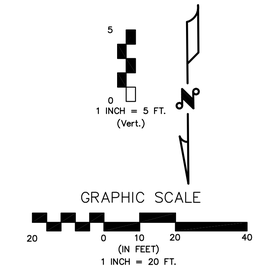

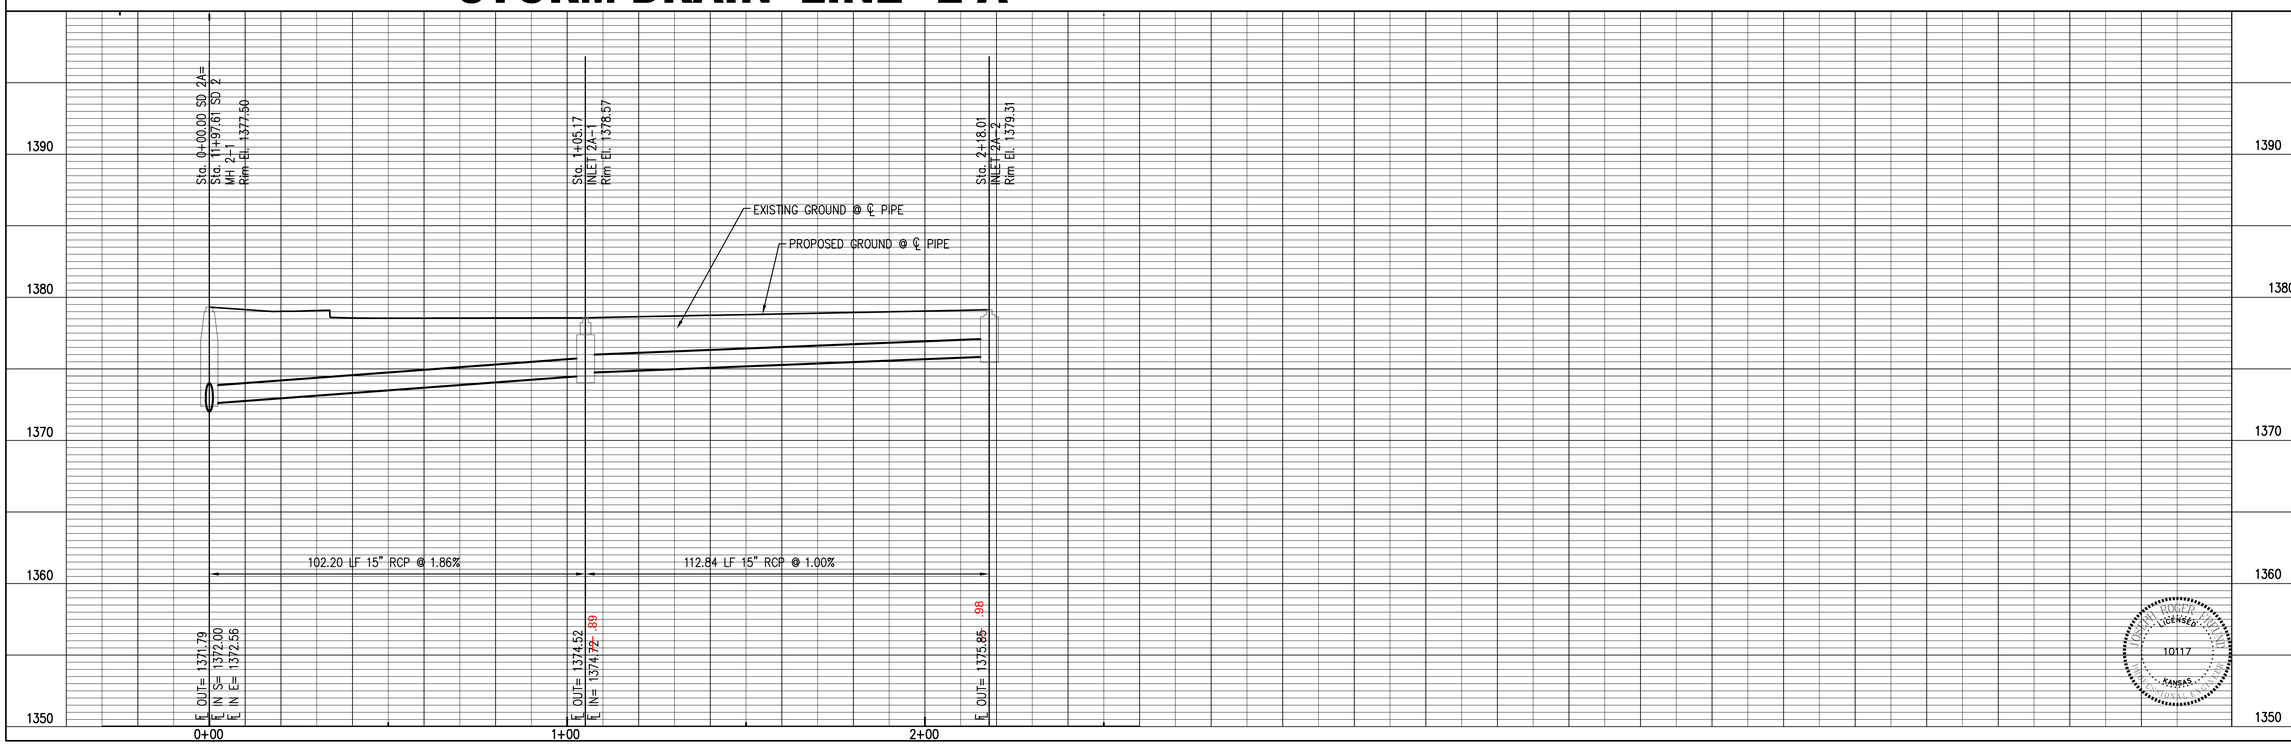

No.	Date	By	Approved	Revision
3	11-09-07	KJW	JRF	DELETED 3 GARAGES

PLAN AND PROFILE
STORM DRAIN LINE "2-A"
Webber Group
Inwood Apartments

POE & ASSOCIATES, INC.
CONSULTING ENGINEERS
5940 E. Central, Suite 200 ■ Wichita, KS 67208-4242
Phone 316/685-4114 ■ FAX 316/685-4444

JOSEPH ROGER FLEMMING
LICENSED
10117
KANSAS
PROFESSIONAL ENGINEER

Engineer: JRF
Designer: kjw
Poe Job No.: 1909
Date: 8-31-07

C-33

P:\1909A Revised Inwood\Working Dwgs\PP&SHEETS\C-2&P & P sd 2 - SHT 31.dwg, SHT 33, 4/3/2008 9:05:08 AM