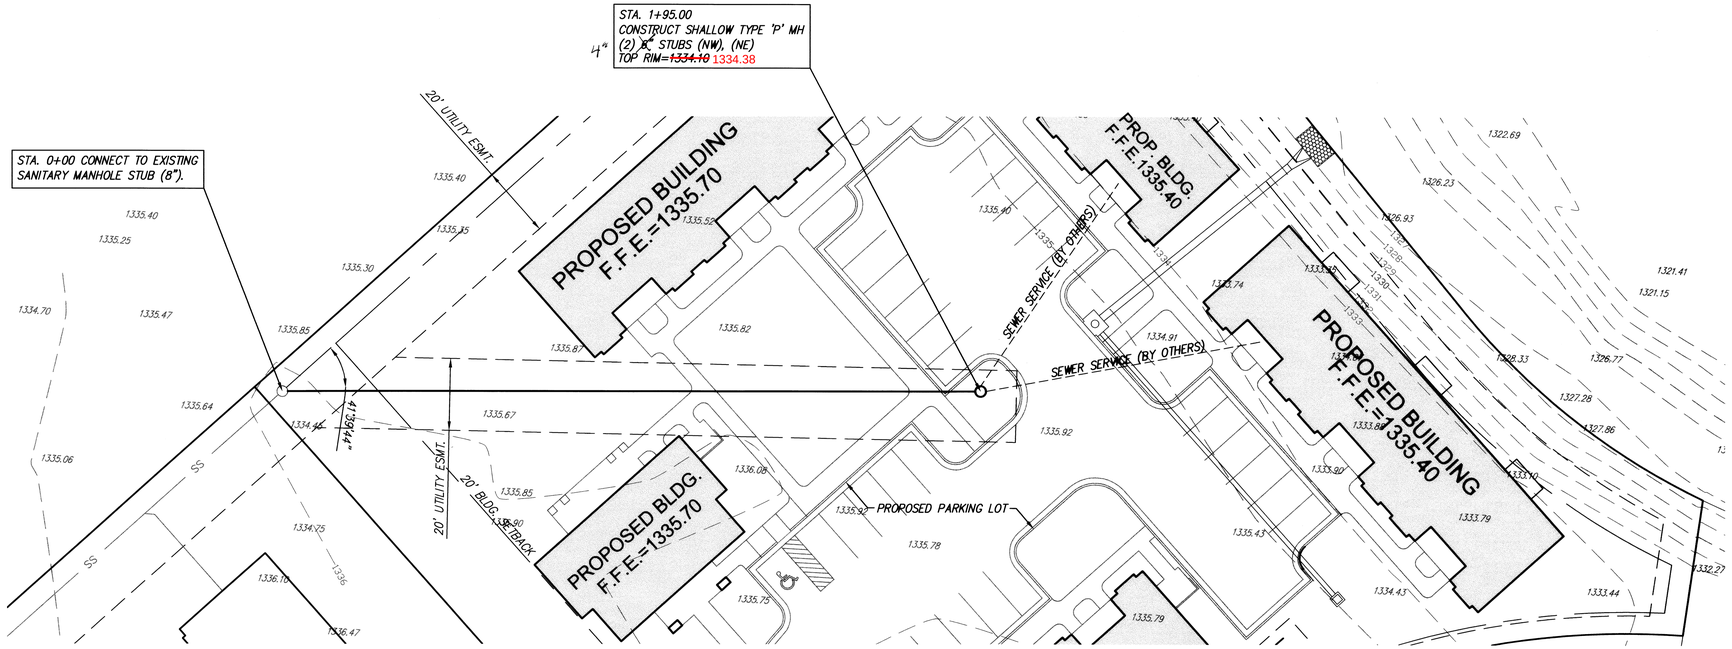

SCALE: 1"=20' (H)
1"=5' (V)

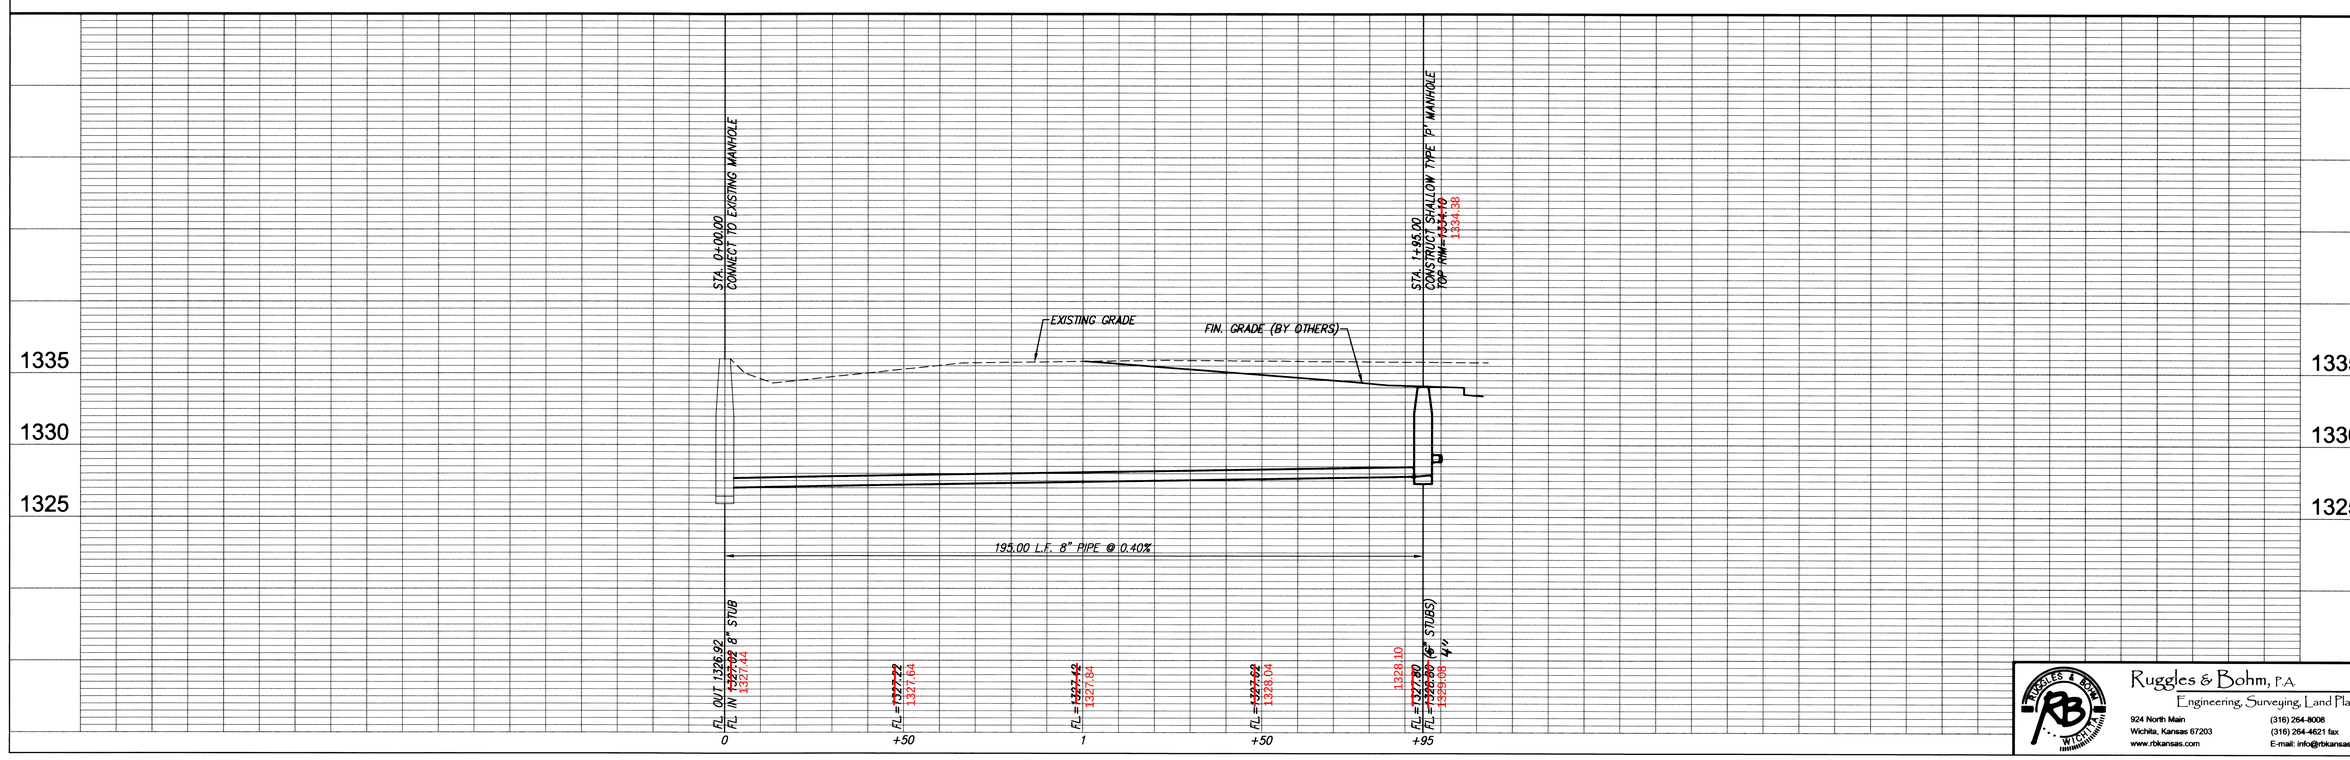

DESIGN TCR
DRAWN E.B
REVISED
UTILITY
DATE Sept. 26, 2006
REVIEW

PROJECT NUMBER 1704 PPS (607861)
DRAWING FILE Engineering Base (SS)

LOT 2, BLK 1 SHADY RIDEGE 2ND
SANITARY SEWER
WICHITA, KANSAS

Ruggles & Bohm, P.A.
Engineering, Surveying, Land Planning
924 North Main
Wichita, Kansas 67203
www.rbkansas.com
(316) 264-8008
(316) 264-4621 fax
E-mail: info@rbkansas.com

RB JOB 2941E
SHEET 2 of 3