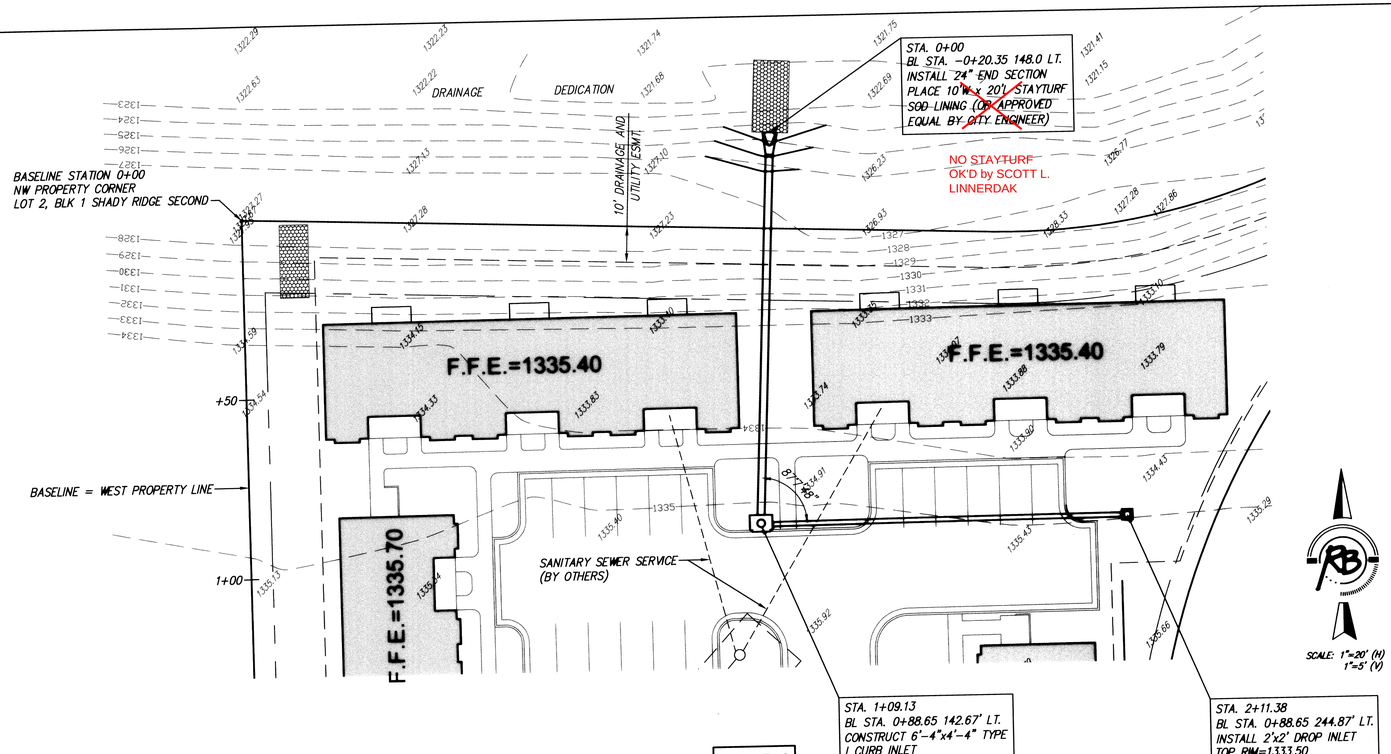

LINE 1

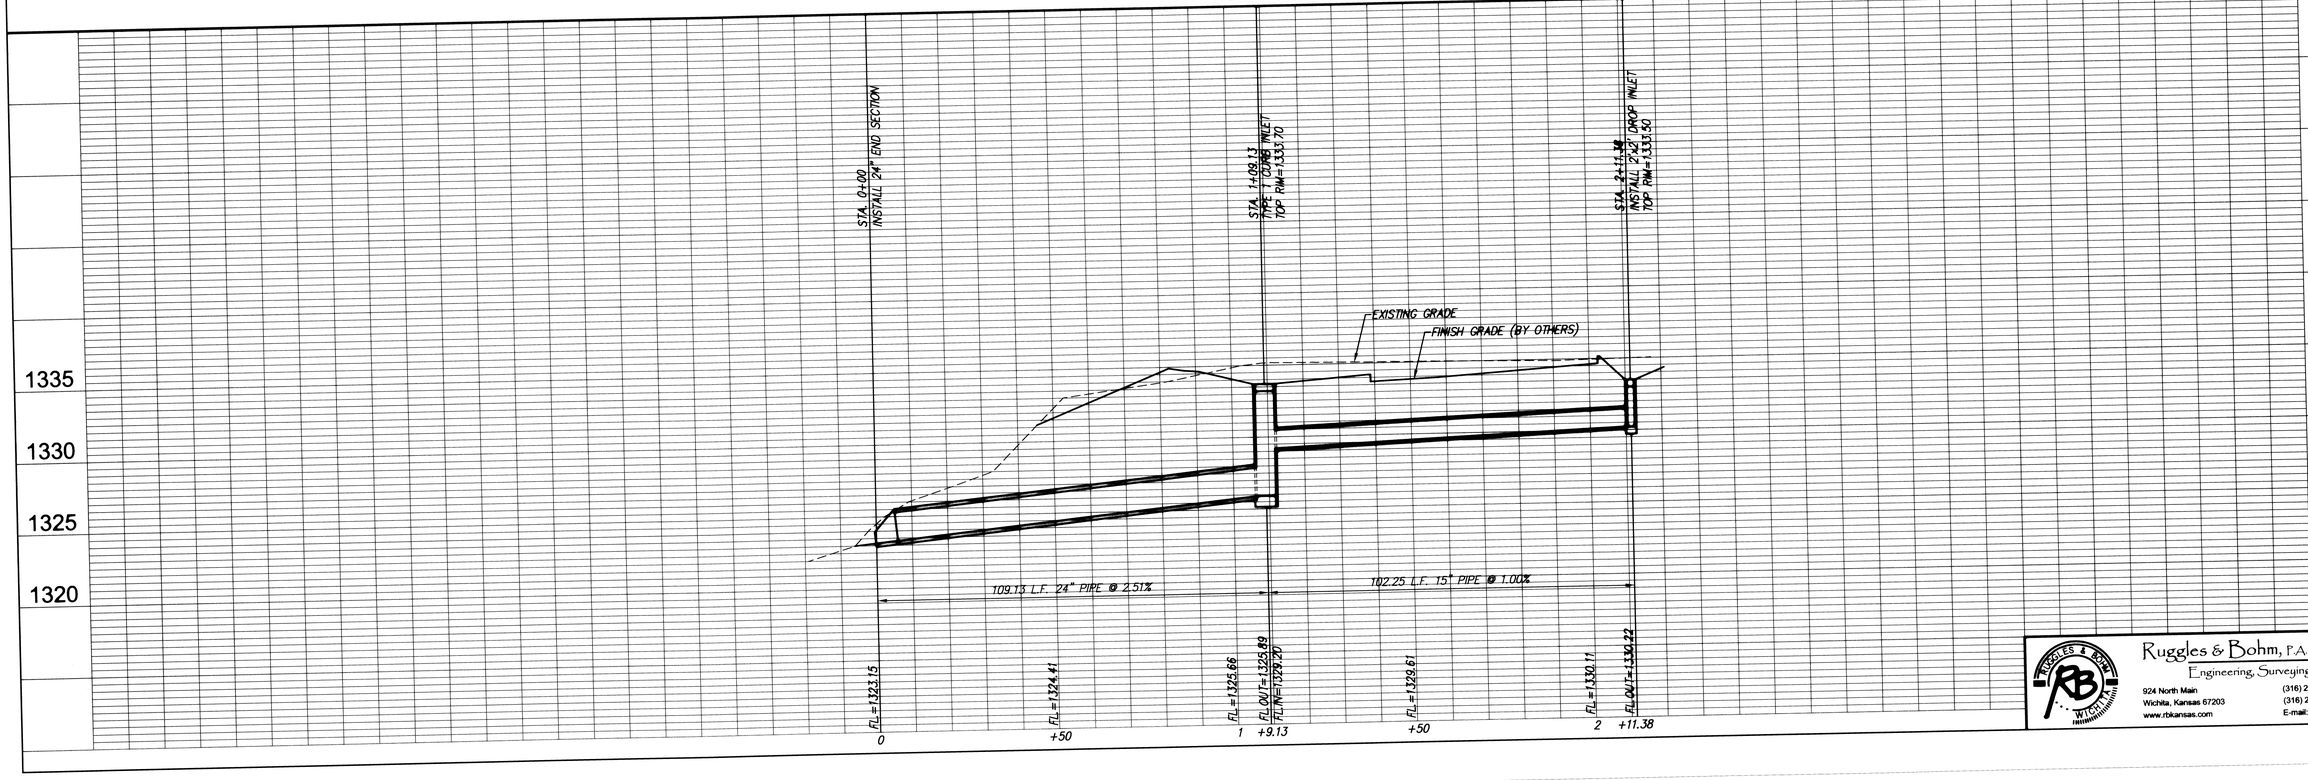

REVISED
REVIEW
DRAWN EJB
DATE Sept. 28, 2006
DESIGN TCR
UTILITY
PROJECT NUMBER 1707
DRAWING FILE Engineering Base (SS)

LOT 2, BLK 1 SHADY RIDGE 2ND
STORM SEWER
WICHITA, KANSAS

RB JOB 2941
SHEET 3 OF 5

Ruggles & Bohm, P.A.
Engineering, Surveying, Land Planning
924 North Main
Wichita, Kansas 67203
www.rbkansas.com
(316) 264-8006
(316) 264-4621 fax
E-mail: info@rbkansas.com