



LOT #1 6" VLP SERVICE


LOT #5 6" VLP SERVICE

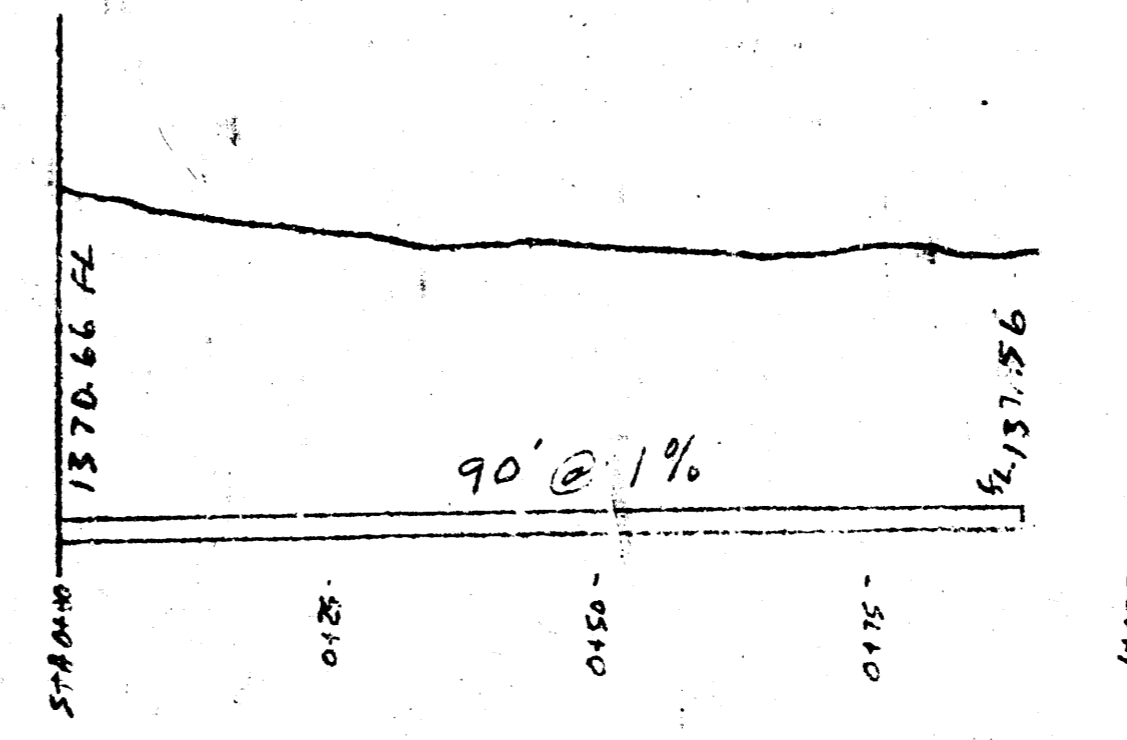

LOT #2 6" VLP SERVICE

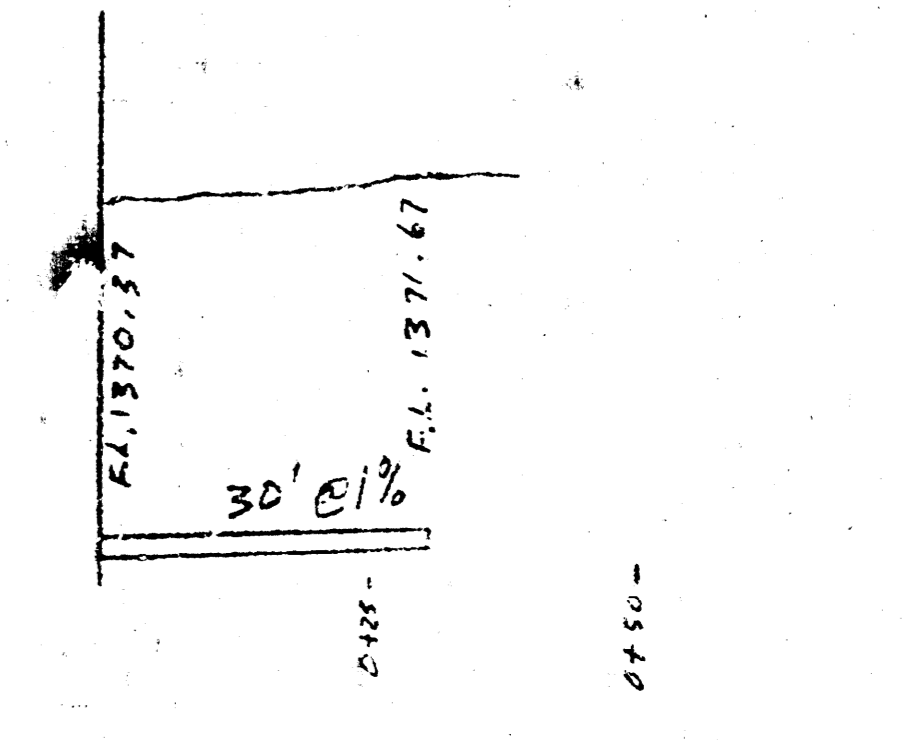

LOT #3 6" VLP SERVICE

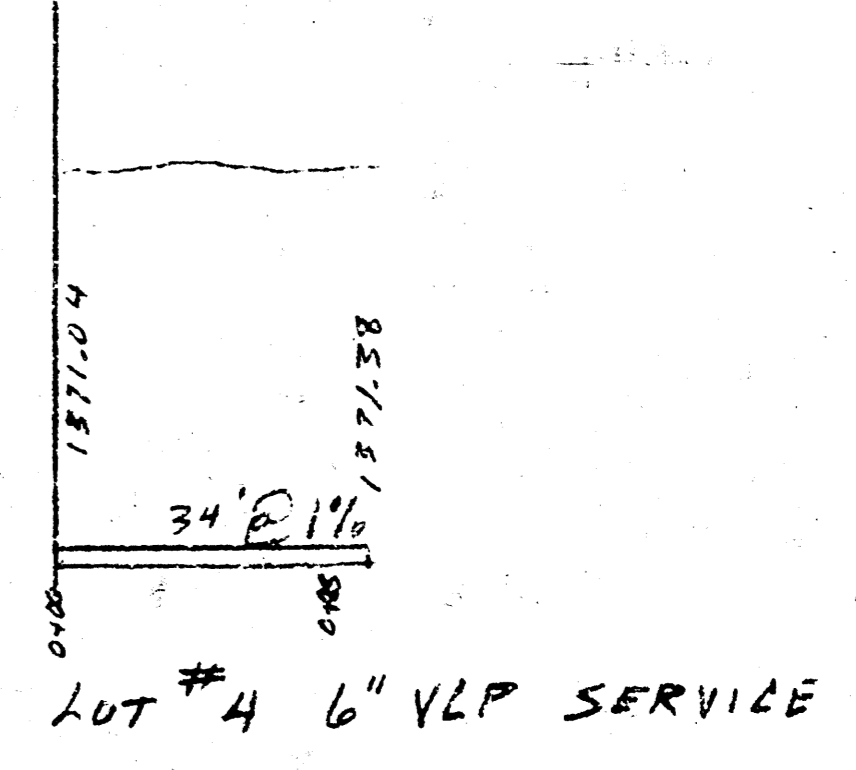

LOT #4 6" VLP SERVICE

EMERGENCY FIRE ACCESS & PUBLIC UTILITY EASEMENT

NOT TO SCALE

