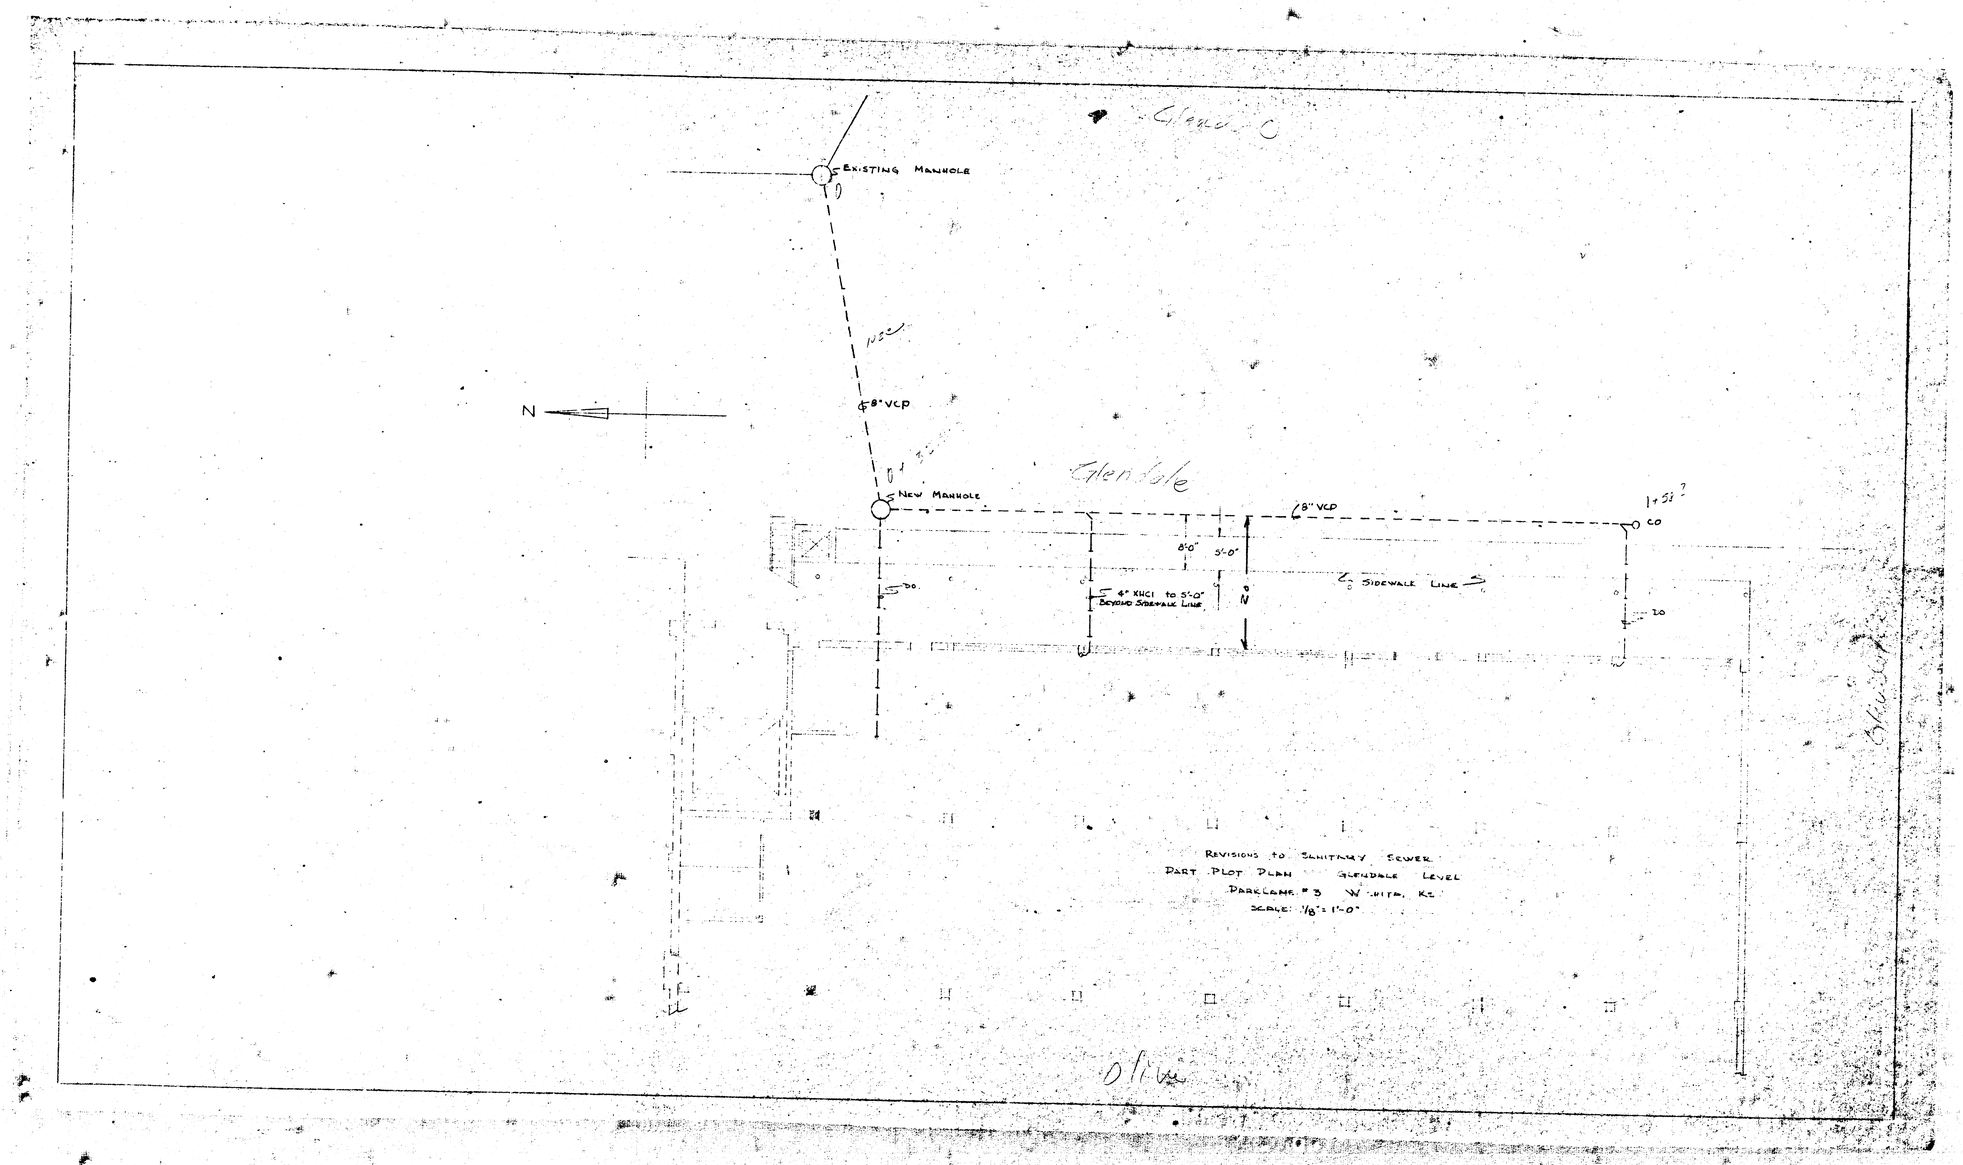


REVISIONS TO SANITARY SEWER
PART PLOT PLAN GLENDALE LEVEL
PARKLANE #3 WICHITA, KS
SCALE: 1/8" = 1'-0"