
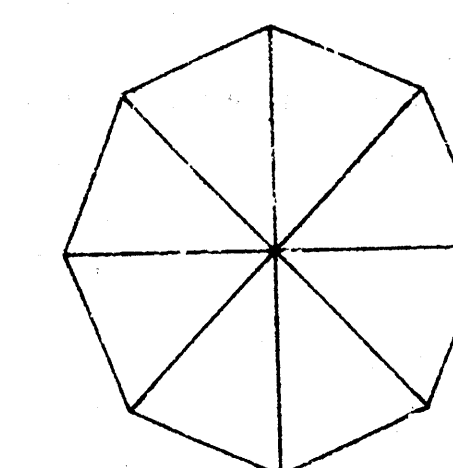
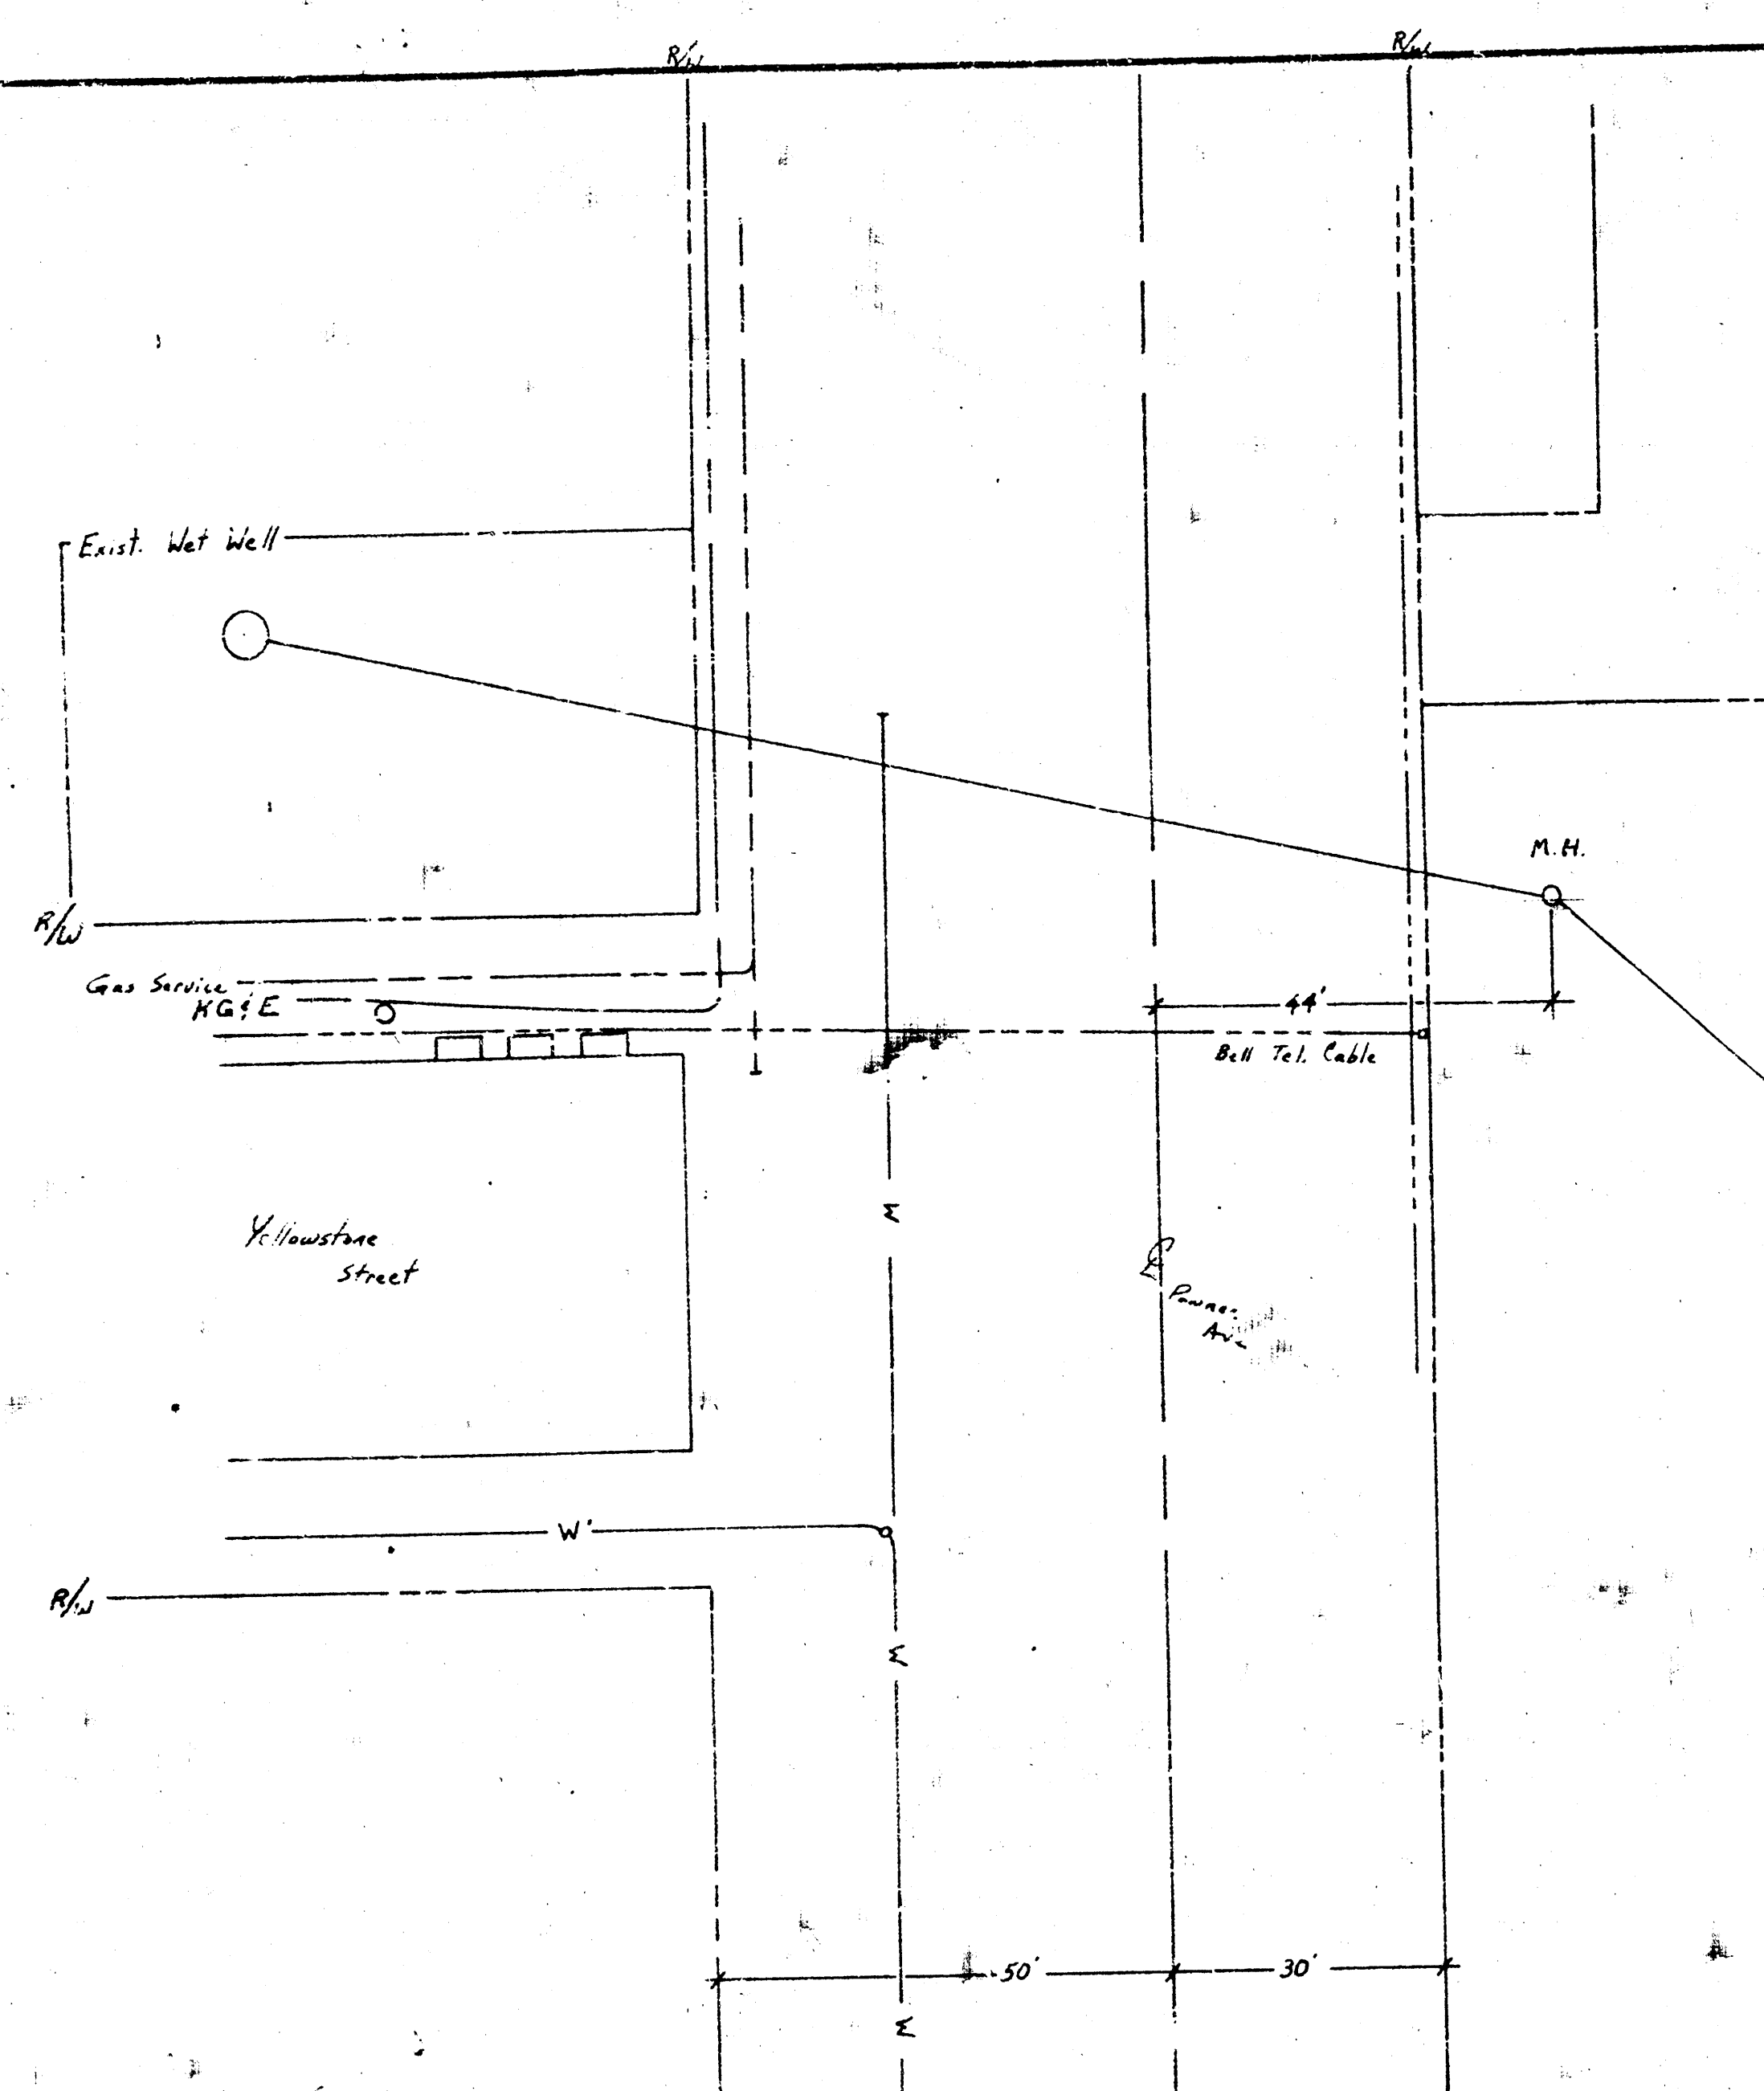


PROFILE	SURVEYED	BY	DATE
NOTED			
GRAD'S CHECKED			
NOTE BOOK			
2. M. NOTED			

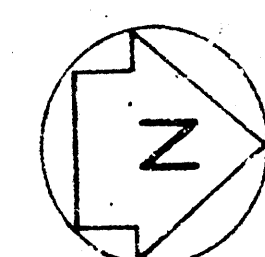


SHELTER


NOTE TO CONTRACTOR

This project will be constructed under the supervision of the CITY ENGINEER and in accordance with the SPECIFICATIONS of the CITY OF WICHITA. The CONTRACTOR will provide the City of Wichita for all costs of inspection.

APPROVED AS NOTED
By CITY ENGINEER OF WICHITA
Sanitary Sewers _____
Storm Sewers _____
Driveway Approaches _____

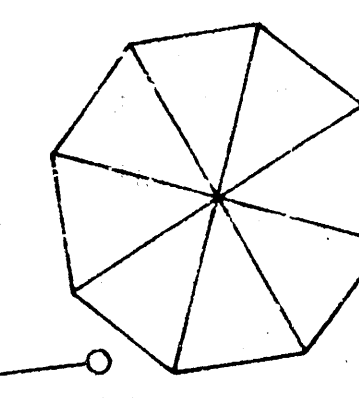

RESTROOMS

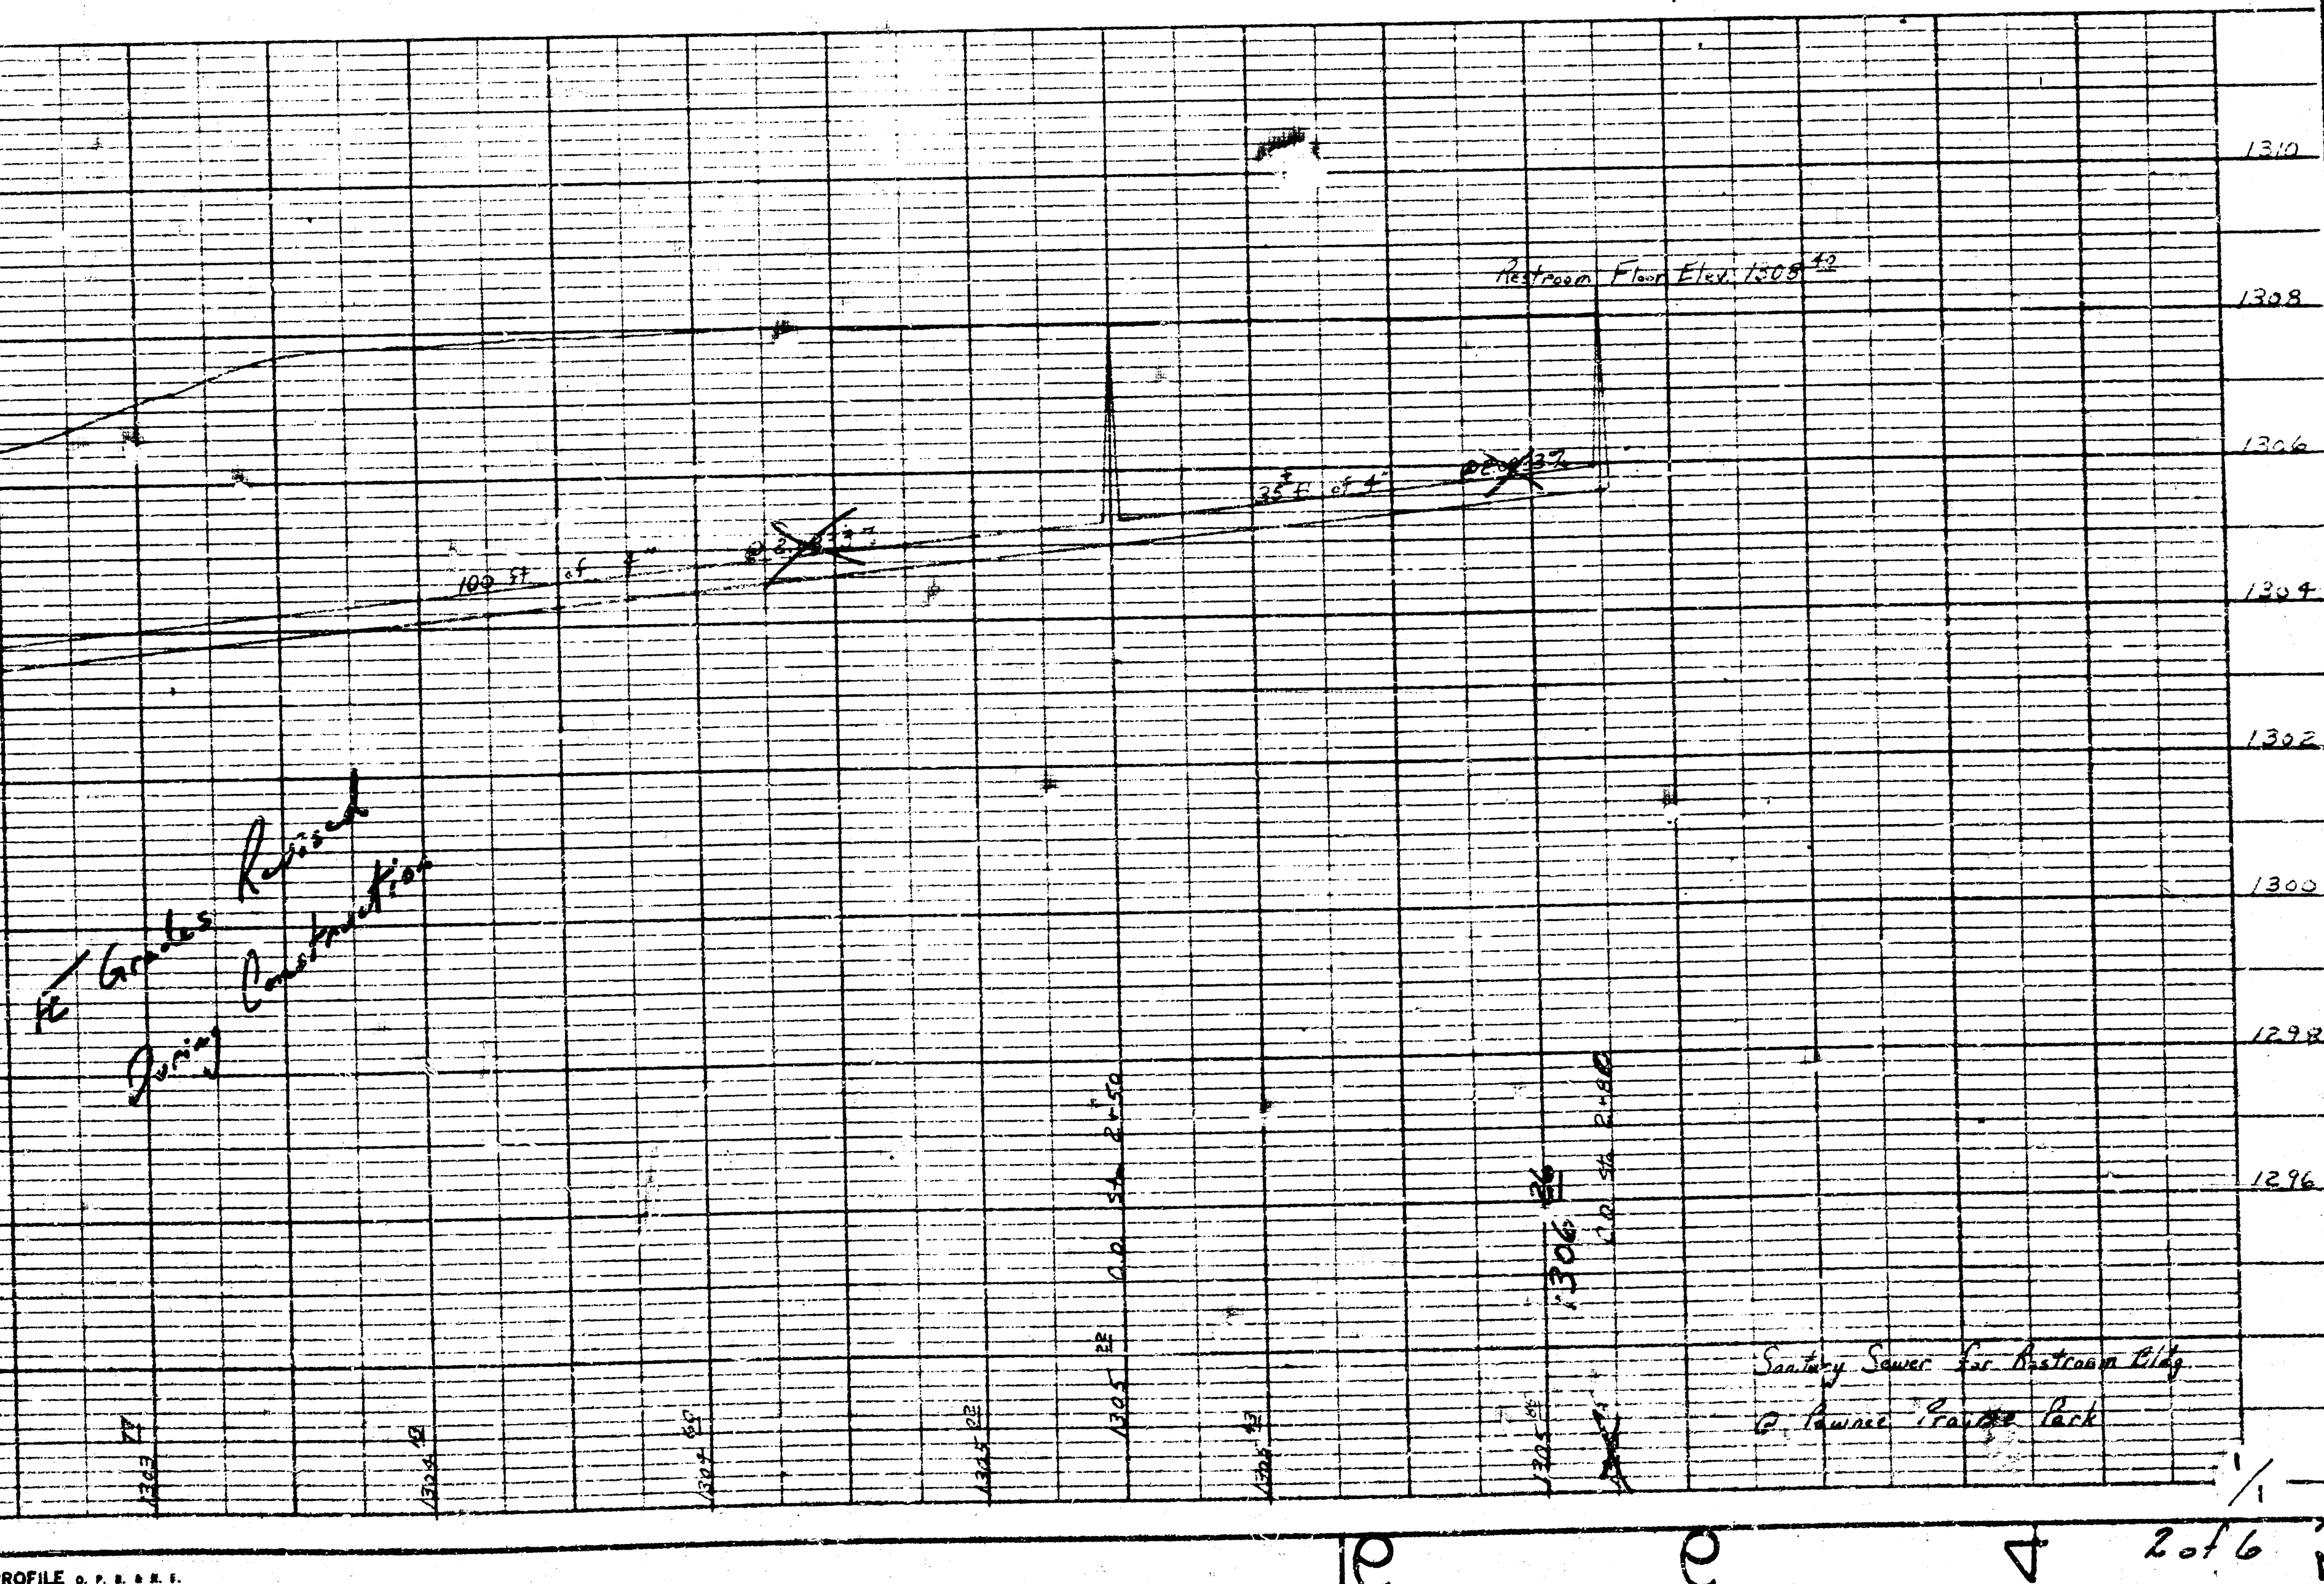

12 Grades Revised
During Construction

Sanitary Sewer for Astorham Bldg
A Lawrence, Frank Park