
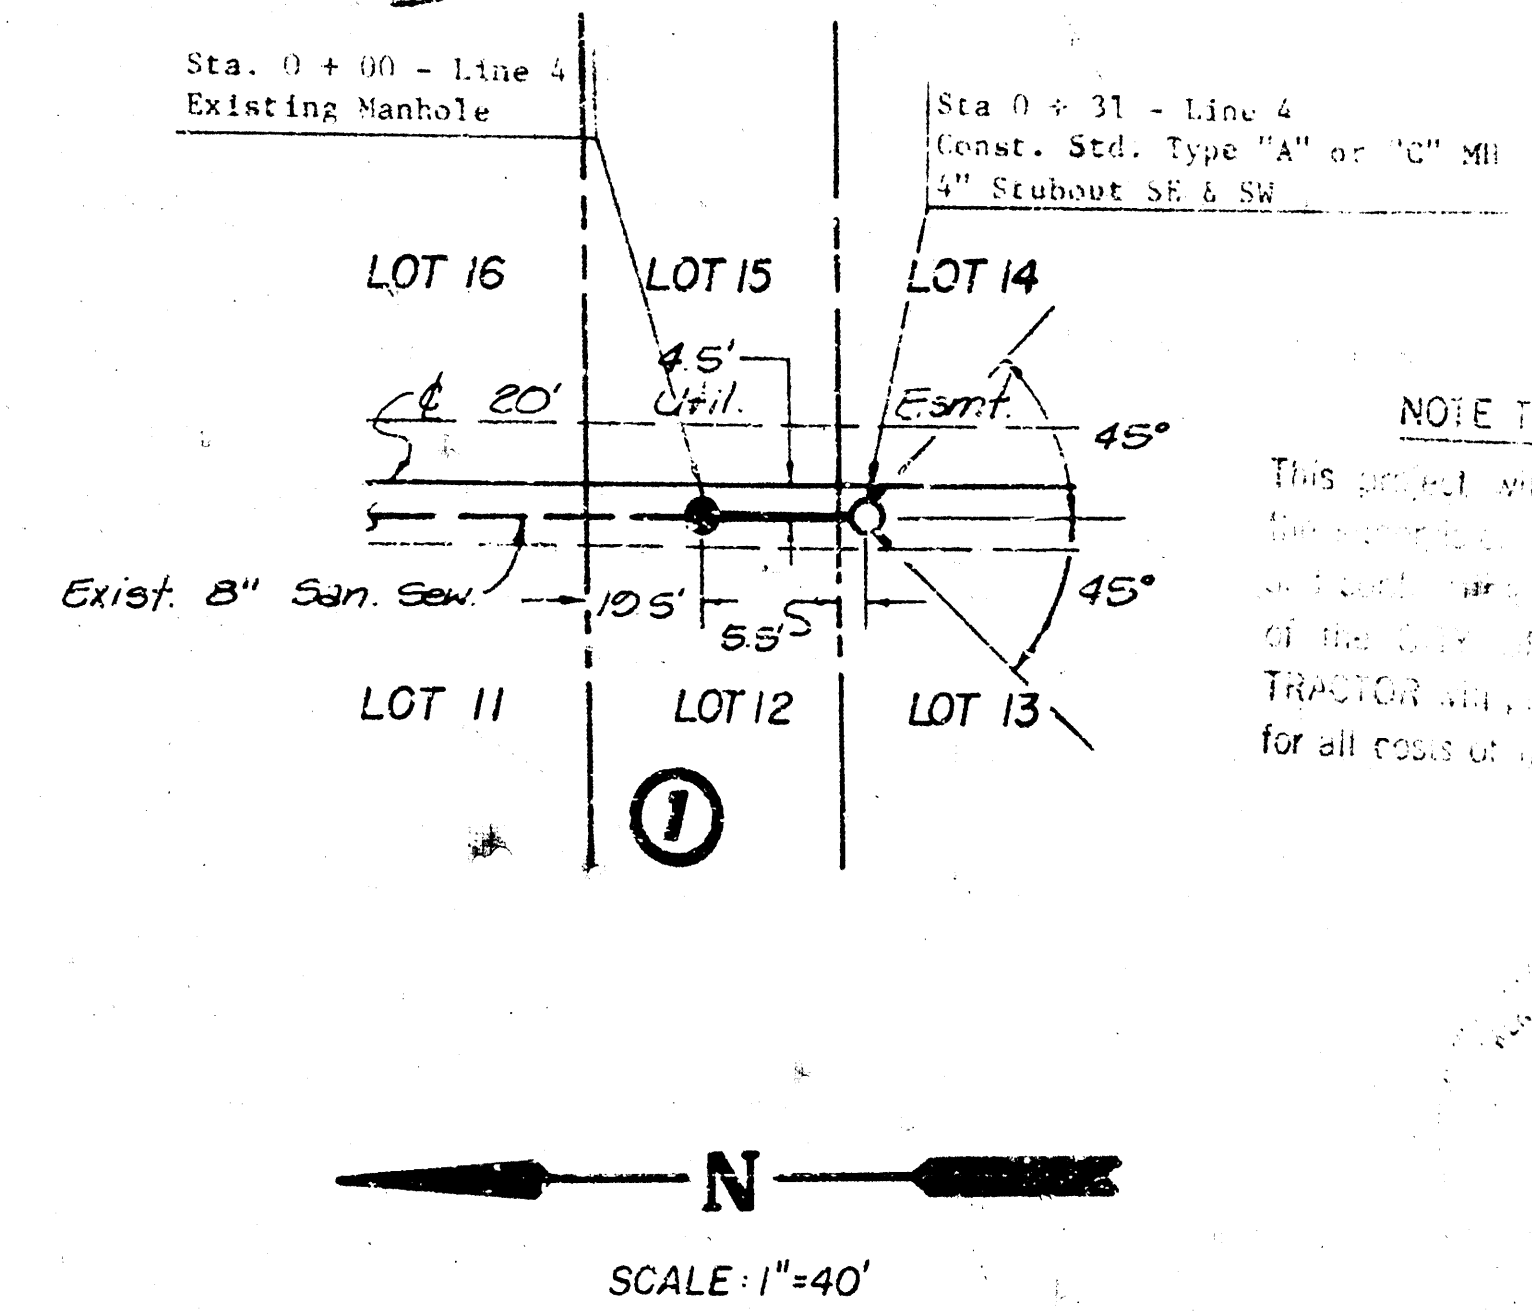
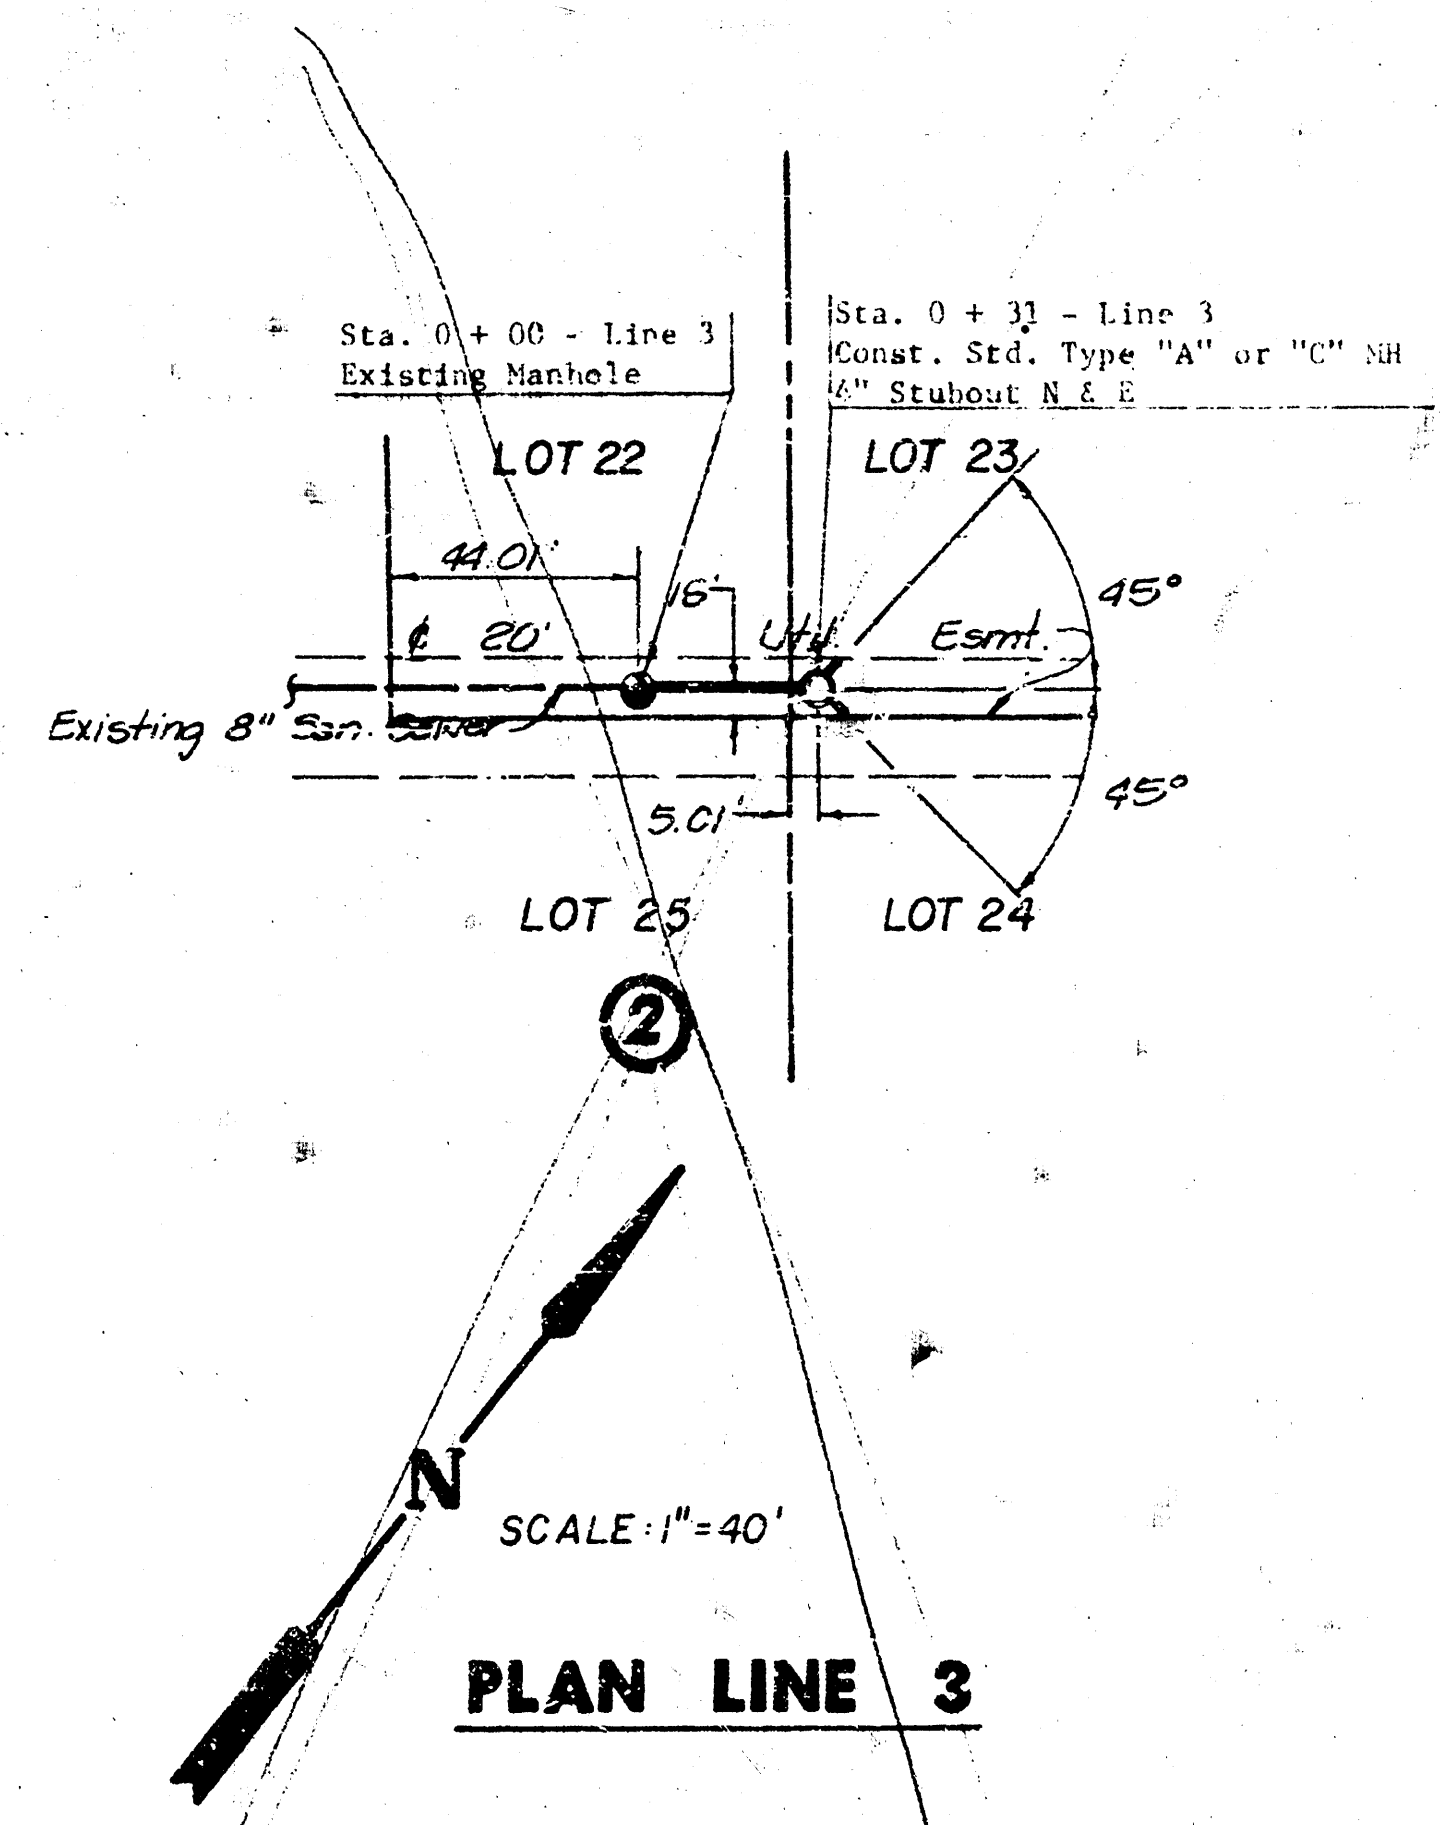
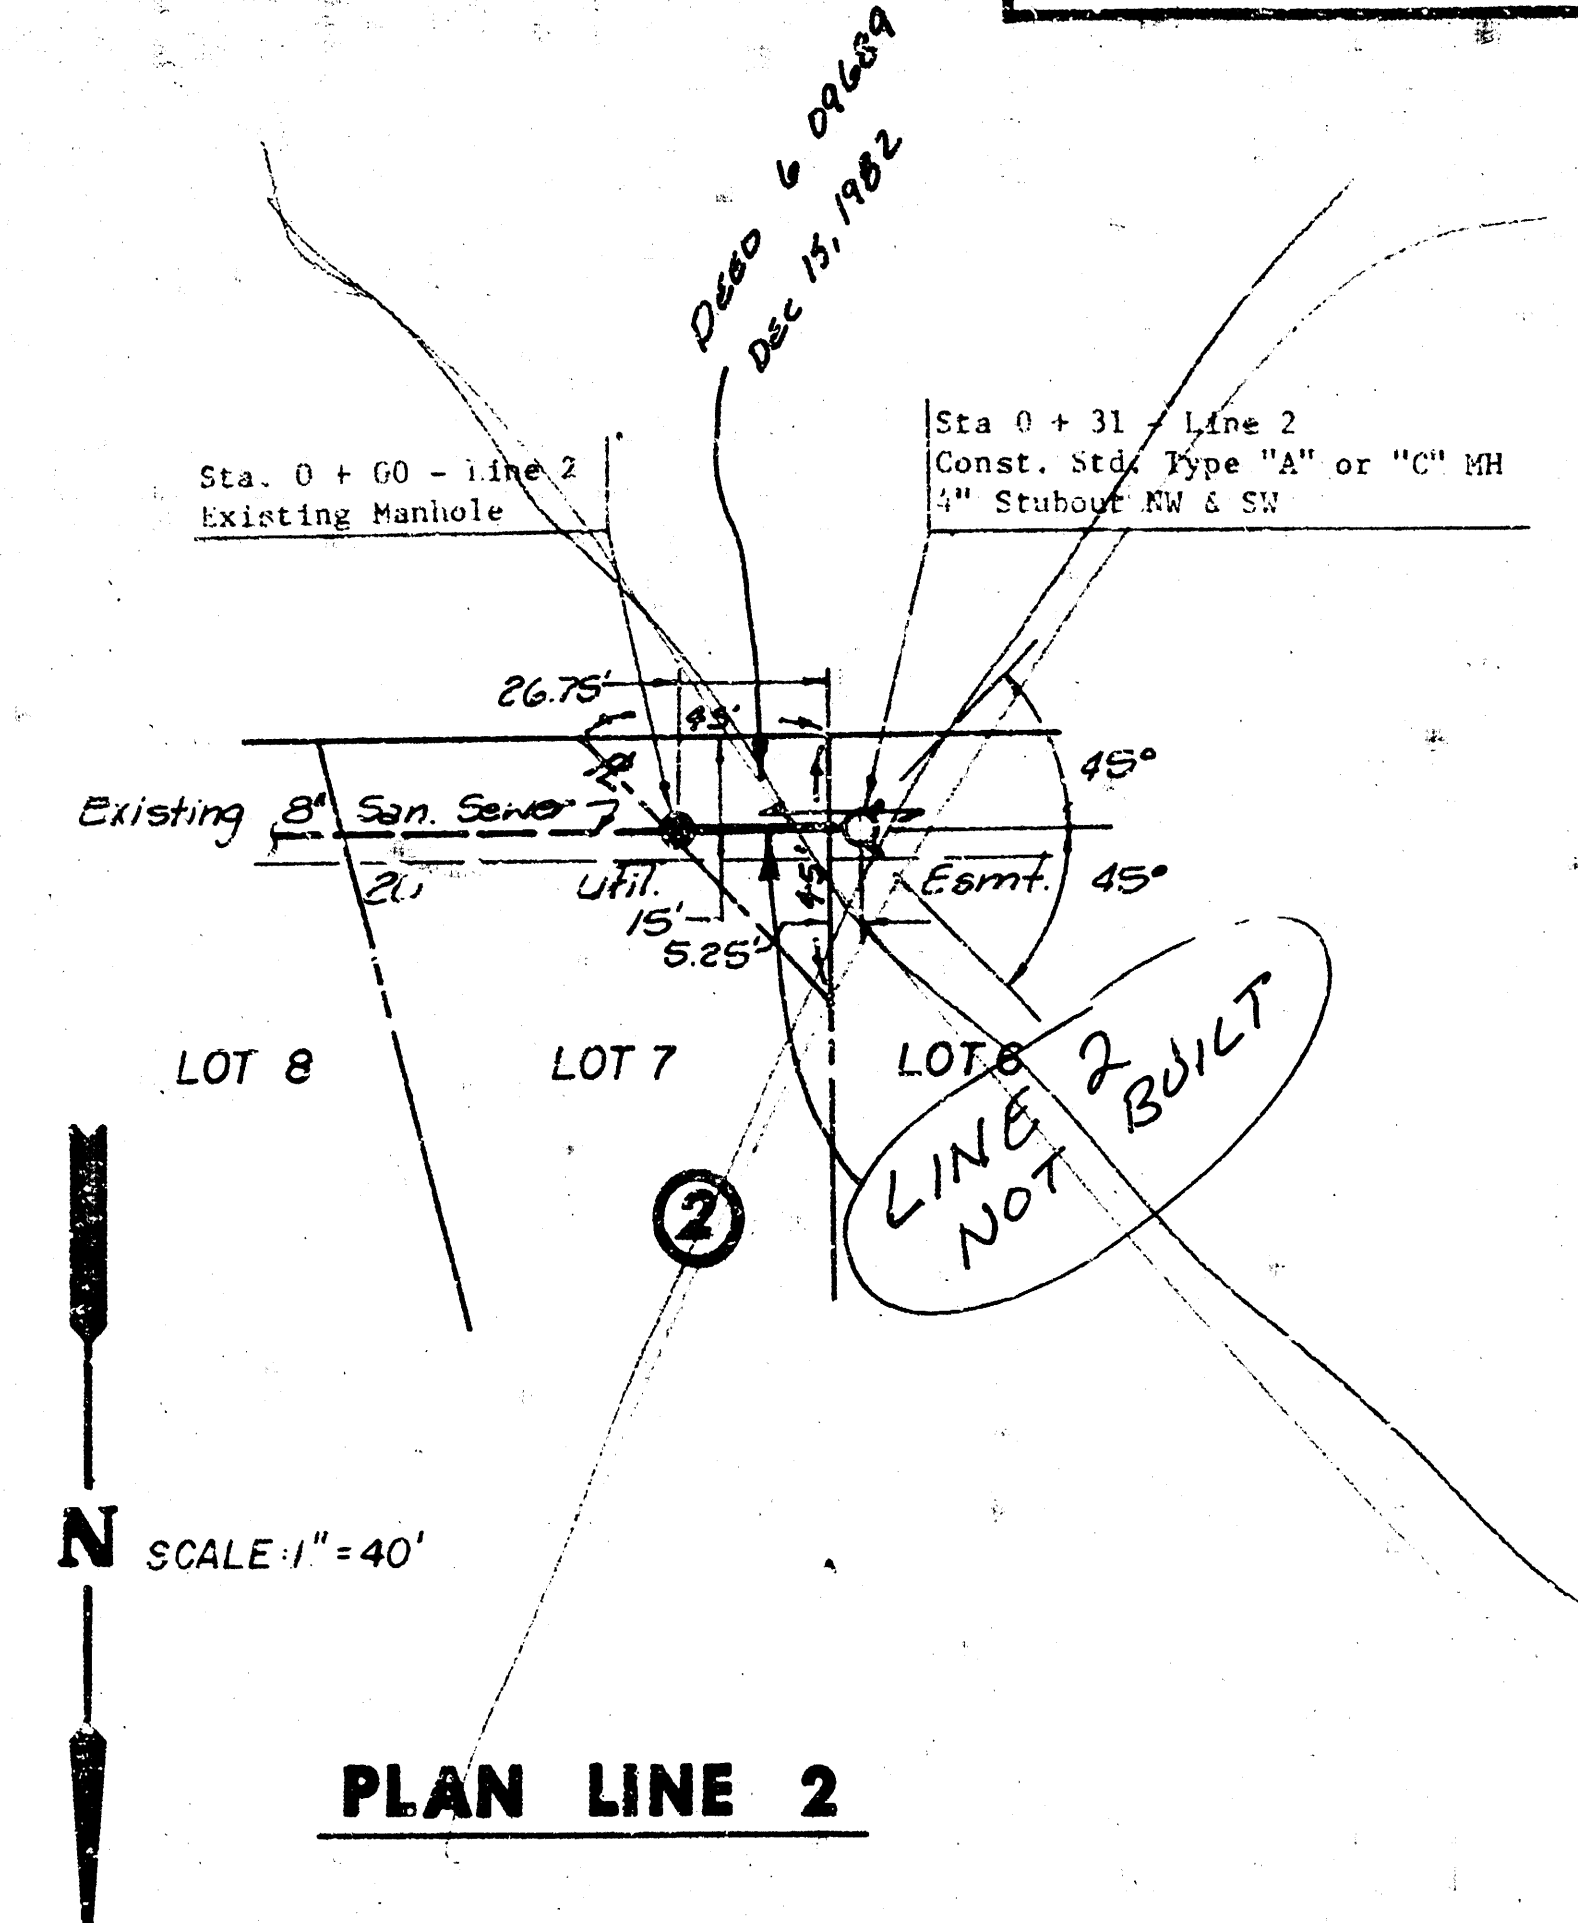



PEPPERWOOD ADDITION
 LATERAL 20, MAIN 7 EXTENSION
 468-76-245-80000-000-000-008

GENERAL NOTES:
 1. Pipe: Either VCP, ABS or PVC may be used.
 2. Manhole top elevations shall be set by the Field Engineer to match proposed finished grade as determined by the developer.

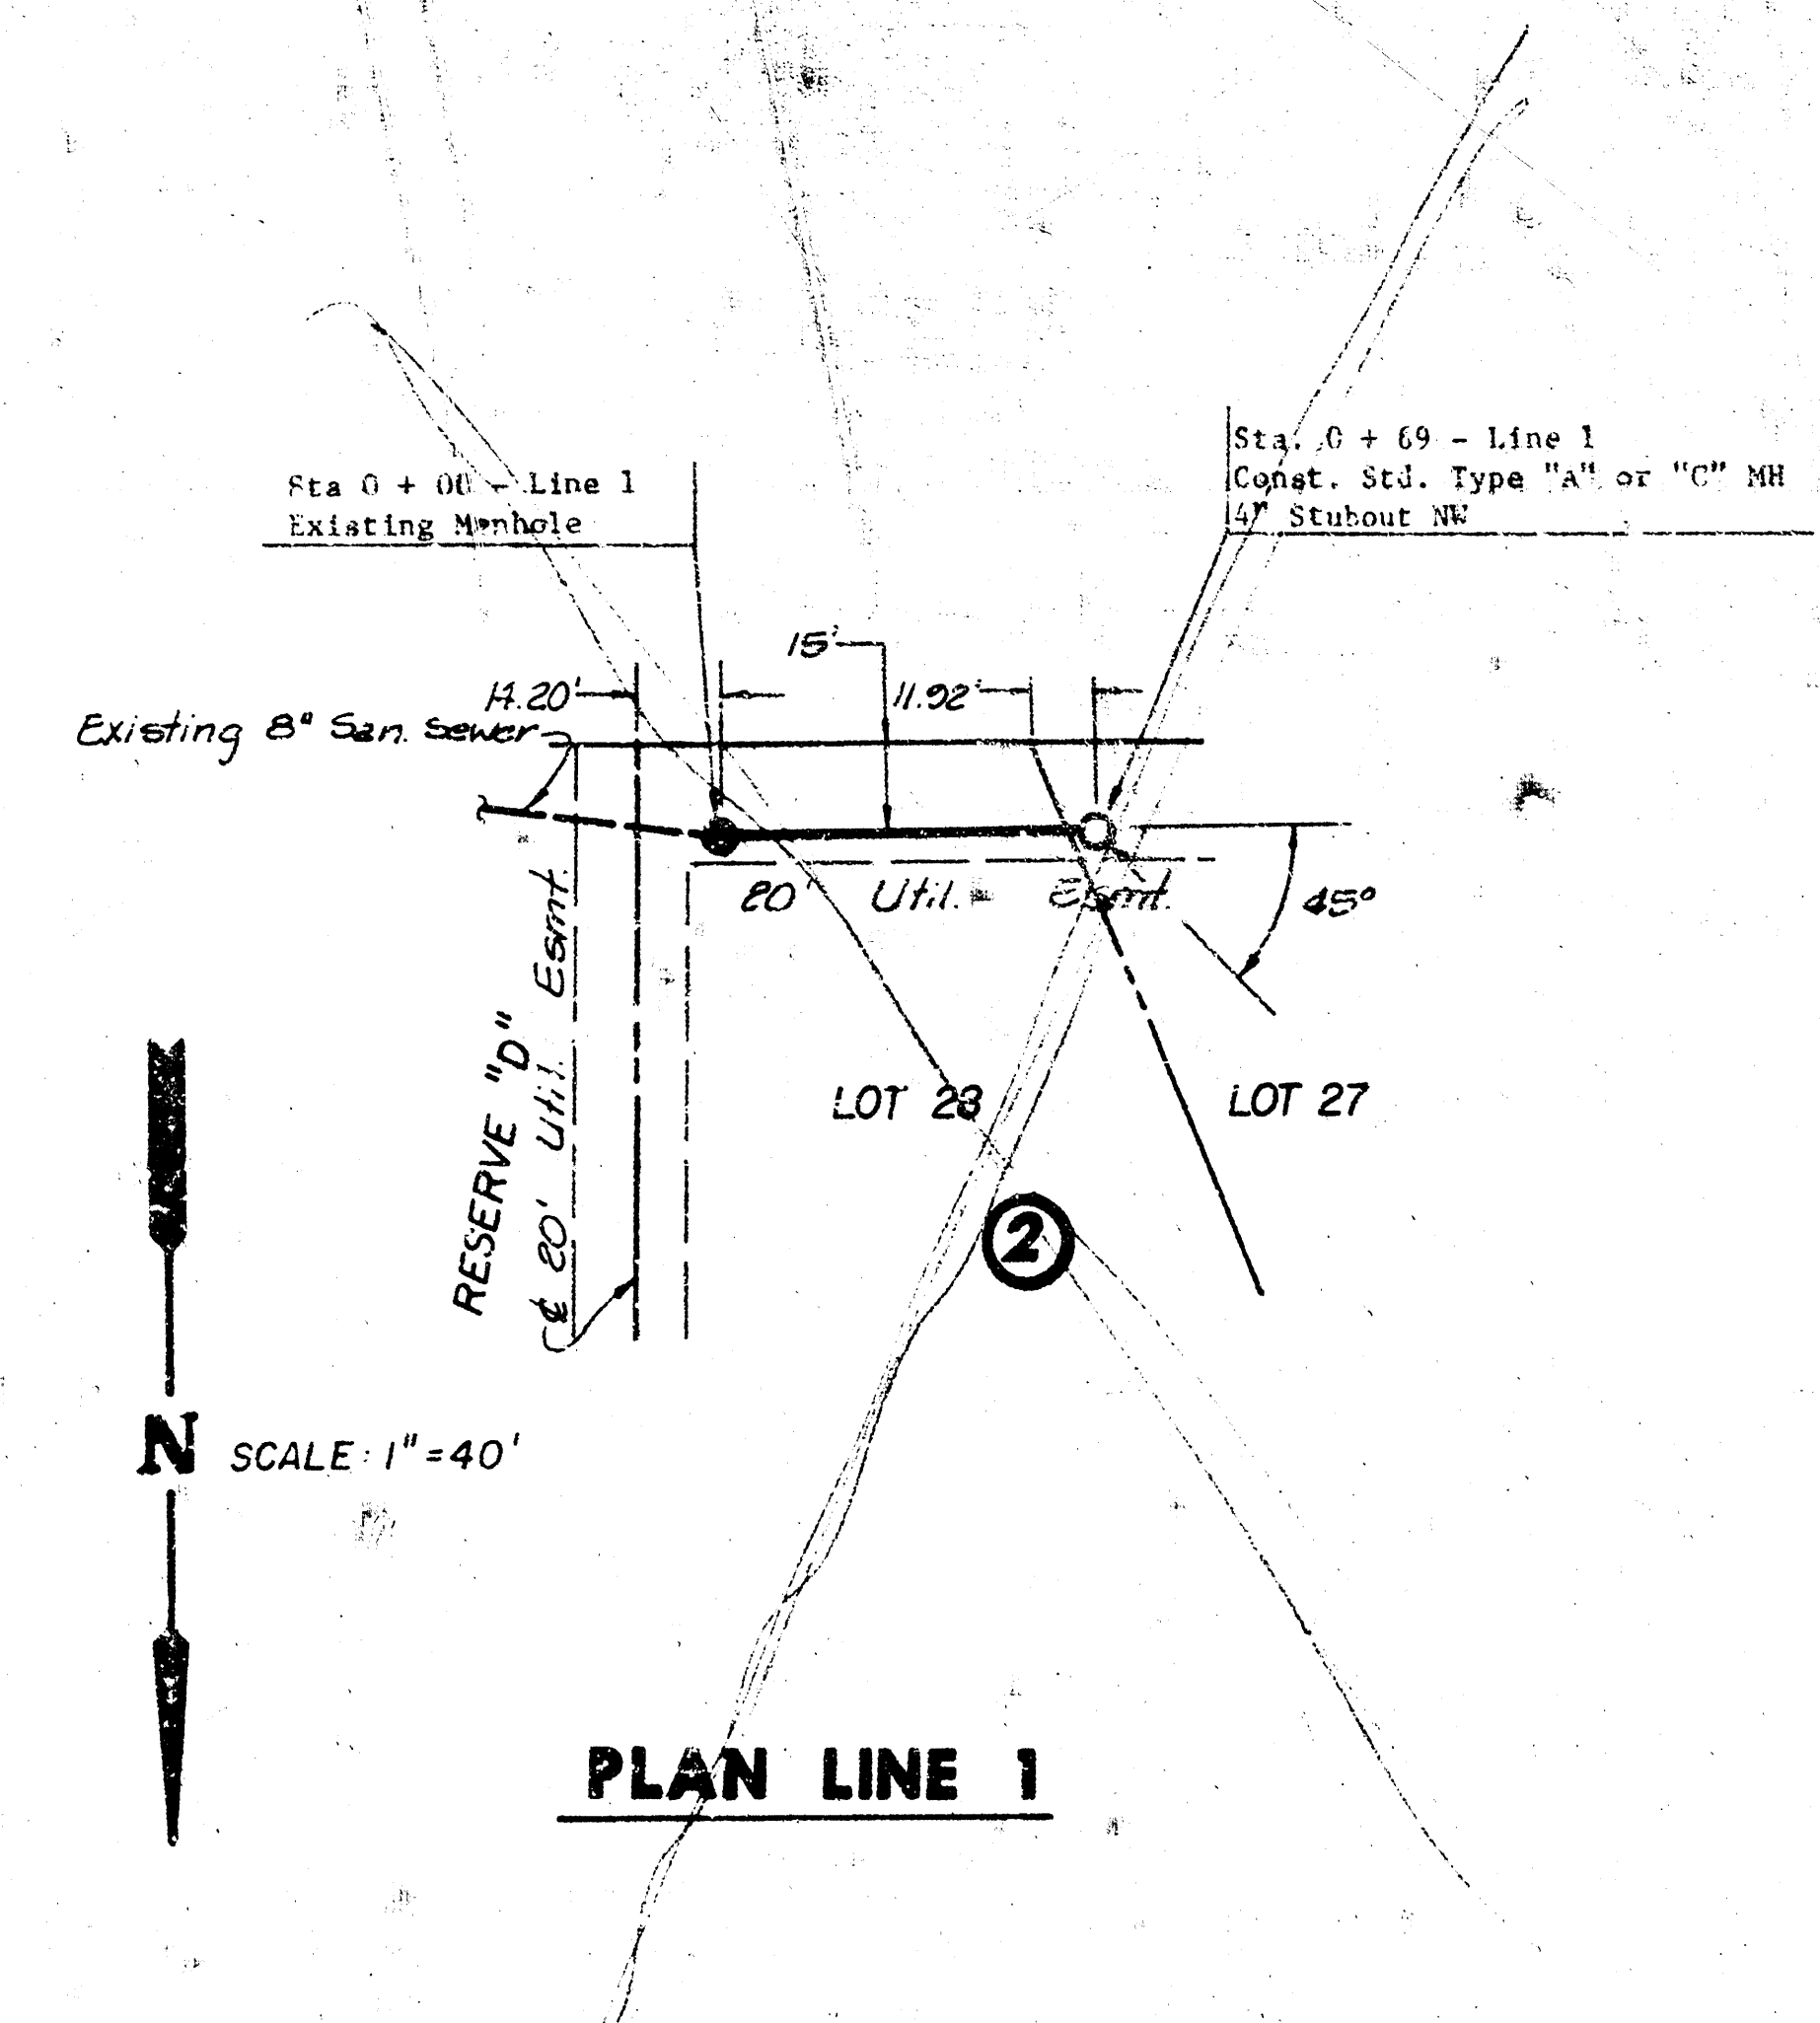

NOTE TO CONTRACTOR
 This project will be constructed under the supervision of the CITY ENGINEER. The CONTRACTOR shall be responsible for all costs of inspection.

APPROVED AS NOTED
 BY: [Signature]
 CITY ENGINEER OF WICHITA

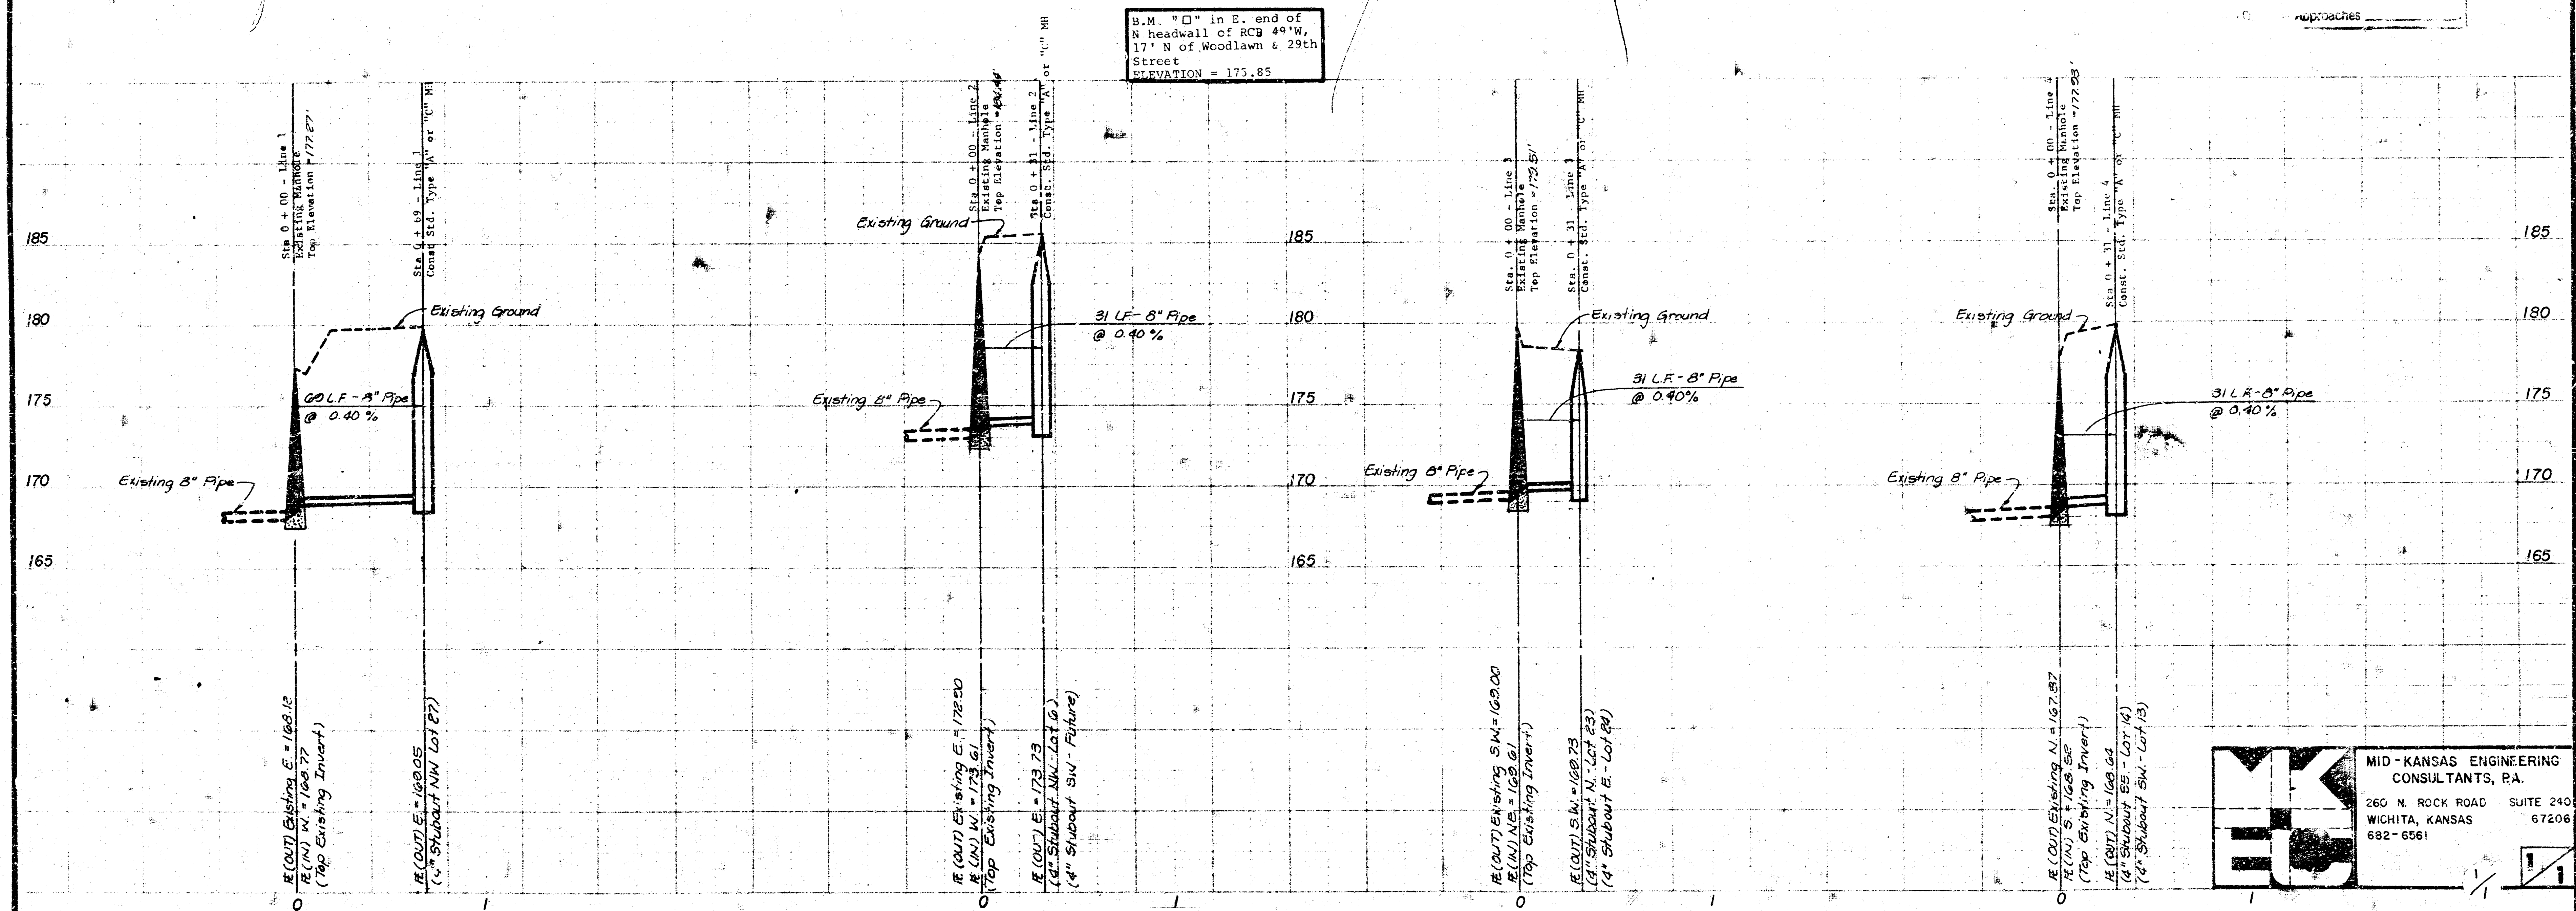

MID-KANSAS ENGINEERING CONSULTANTS, P.A.
 260 N. ROCK ROAD SUITE 240
 WICHITA, KANSAS 67206
 682-6561