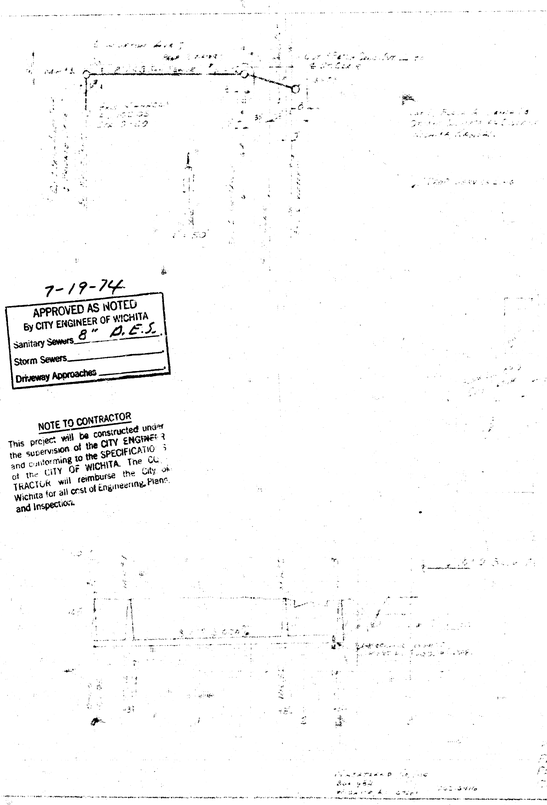


7-19-74

APPROVED AS NOTED
By CITY ENGINEER OF WICHITA
Sanitary Sewers 8" D.E.S.
Storm Sewers _____
Driveway Approaches _____

NOTE TO CONTRACTOR

This project will be constructed under the supervision of the CITY ENGINEER and conforming to the SPECIFICATIONS of the CITY OF WICHITA. The CONTRACTOR will reimburse the City of Wichita for all cost of Engineering, Plans and Inspection.