**BENCHMARK**

CHISELED SQUARE ON TOP OF CURB EAST SIDE OF INLET, NORTH SIDE OF KELLOG FRONTAGE ROAD ON SOUTH SIDE OF U.S. 54, APPROX. 330' WEST OF ℄ TYLER.
ELEV.= 1355.55 CITY DATUM.


## GENERAL NOTES


1. CONTRACTOR WILL BE REQUIRED TO PROVIDE A MINIMUM ADVANCE NOTICE OF TWENTY-FOUR (24) HOURS TO UTILITY COMPANIES PRIOR TO STARTING ANY EXCAVATIONS AS FOLLOWS:

   KANSAS ONE-CALL 1-800-344-7233
   THE CONTRACTOR MUST NOTIFY THE FOLLOWING IN CASE OF AN EMERGENCY:

   | | |
   |---|---|
   | CABLE VISION | 262-4270 or 263-2061 |
   | KP&L GAS SERVICE CO. | 263-7511 |
   | KANSAS GAS & ELECTRIC | 264-1141 |
   | ARKLA GAS COMPANY | 942-8930 or 263-8101 |
   | SOUTHWESTERN BELL TELEPHONE CO. | 1-511-2611 |
   | CITY OF WICHITA WATER DEPARTMENT | 268-4908 |
   | CITY OF WICHITA SEWER MAINTENANCE | 268-4071 |

2. UNDERGROUND UTILITY SERVICE LINES AND OVERHEAD UTILITY POLE LINES ARE TO BE ADJUSTED AS NECESSARY BY OTHERS PRIOR TO CONSTRUCTION UNLESS THE PLANS SPECIFICALLY CALL FOR THEIR ADJUSTMENT BY THE CONTRACTOR. EXISTING UTILITIES AND THEIR LOCATION, AS SHOWN ON PLANS, REPRESENT THE BEST INFORMATION OBTAINABLE FOR DESIGN. THE CONTRACTOR WILL BE REQUIRED TO WORK AROUND EXISTING UTILITIES WITHIN THE RIGHT-OF-WAY WHICH DO NOT CONFLICT WITH PROPOSED CONSTRUCTION.

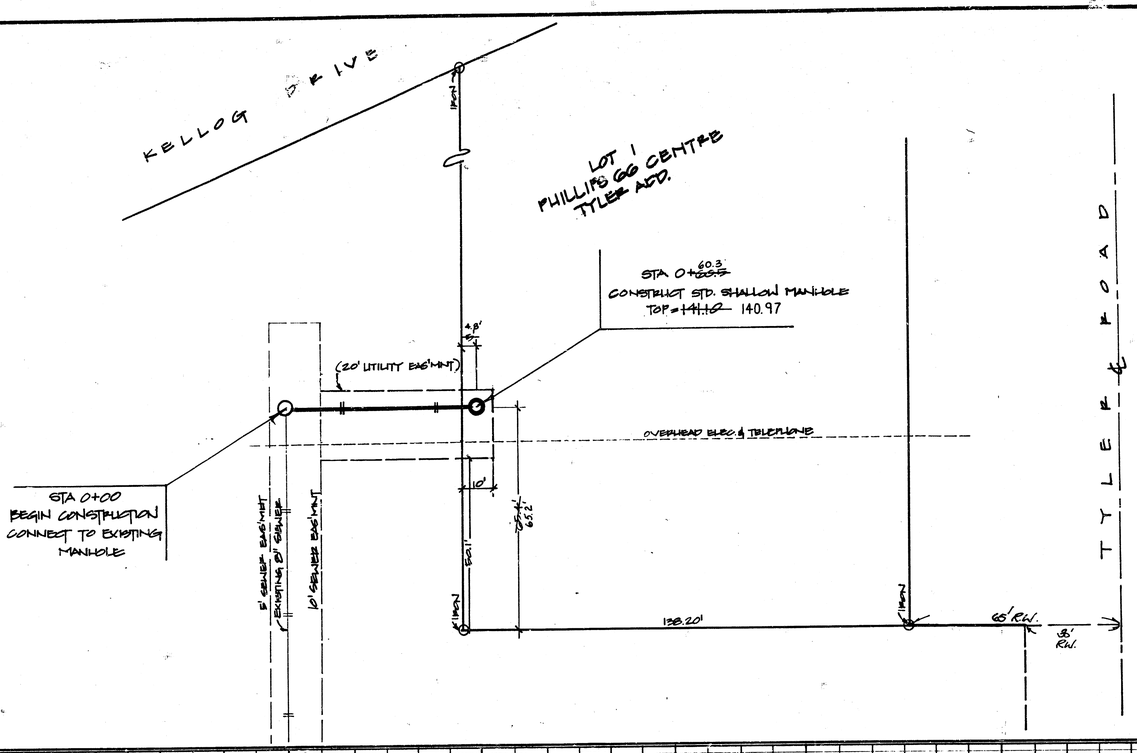


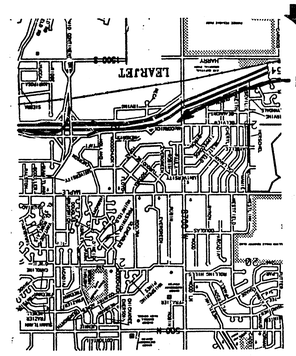
VICINITY MAP

SCALE: 1" = 20' PLAN
1" = 5' VERT.

APPROVED AS NOTED
By CITY ENGINEER OF WICHITA
Sanitary Sewers VRH 5/31/91
Storm Sewers
Driveway Approaches
Water Mains
Paving

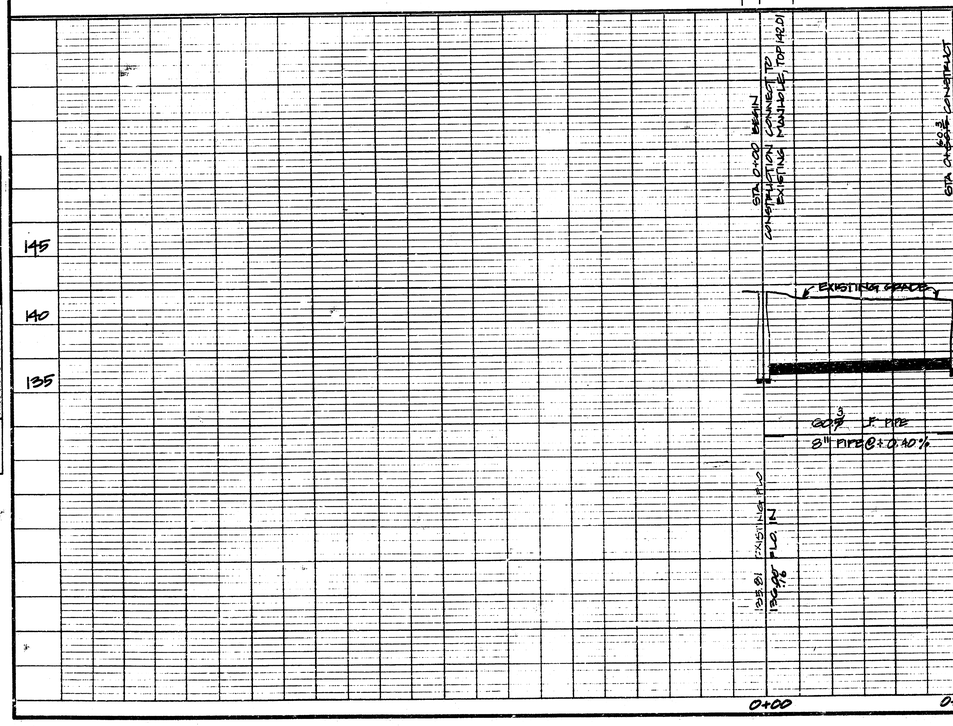


NOTE TO CONTRACTOR

INSPECTION AND TESTING FOR THIS PROJECT IS TO BE PROVIDED BY A LICENSED CONSULTING ENGINEERING FIRM UNDER CONTRACT WITH THE OWNER/DEVELOPER. SAID INSPECTION TO BE IN ACCORDANCE WITH THE CITY OF WICHITA STANDARD CONSTRUCTION ENGINEERING PRACTICES AND CERTIFIED BY A LICENSED PROFESSIONAL ENGINEER. NO WORK SHALL BE PERFORMED IN DEDICATED EASEMENTS OR PUBLIC RIGHT-OF-WAY BY THE CONTRACTOR WITHOUT SUCH INSPECTION NOR SHALL ANY WORK BE COMMENCED WITHOUT WRITTEN AUTHORIZATION BY THE CITY ENGINEER.

BOOKED UKB 2-6-92
REVISED AS BUILT 7-19-91

N. BRENT WOOTEN LICENSED 8479 K.A.N.S.A.S. PROFESSIONAL ENGINEER

Title
PRIVATE SANITARY SEWER TO SERVE PHILLIPS 66 CENTRE - TYLER ADD.

BAUGHMAN COMPANY, P.A.
SURVEYING & ENGINEERING
316/262-7271 • 315 ELLIS • WICHITA, KANSAS 67211

| Design: | Drawn: | Approved: | Date: | Scale: | Sheet |
|---|---|---|---|---|---|
| NBW | EML | NBW | MAY 29,91 | 1" = 20' PLAN 1" = 5' VERT. | 1 of 1 |

PRIVATE PROJECT NO. 288 FPB (607861)

PLAN: SURVEYED / PLOTTED / NOTE BOOK / No. / ALIGNMENT CHECKED / BY / DATE

PROFILE: SURVEYED / PLOTTED / CHAINS CHECKED / No. / STRUCTURE LOCATIONS CHECKED / BY / DATE

FILMED FROM THE BEST AVAILABLE COPY