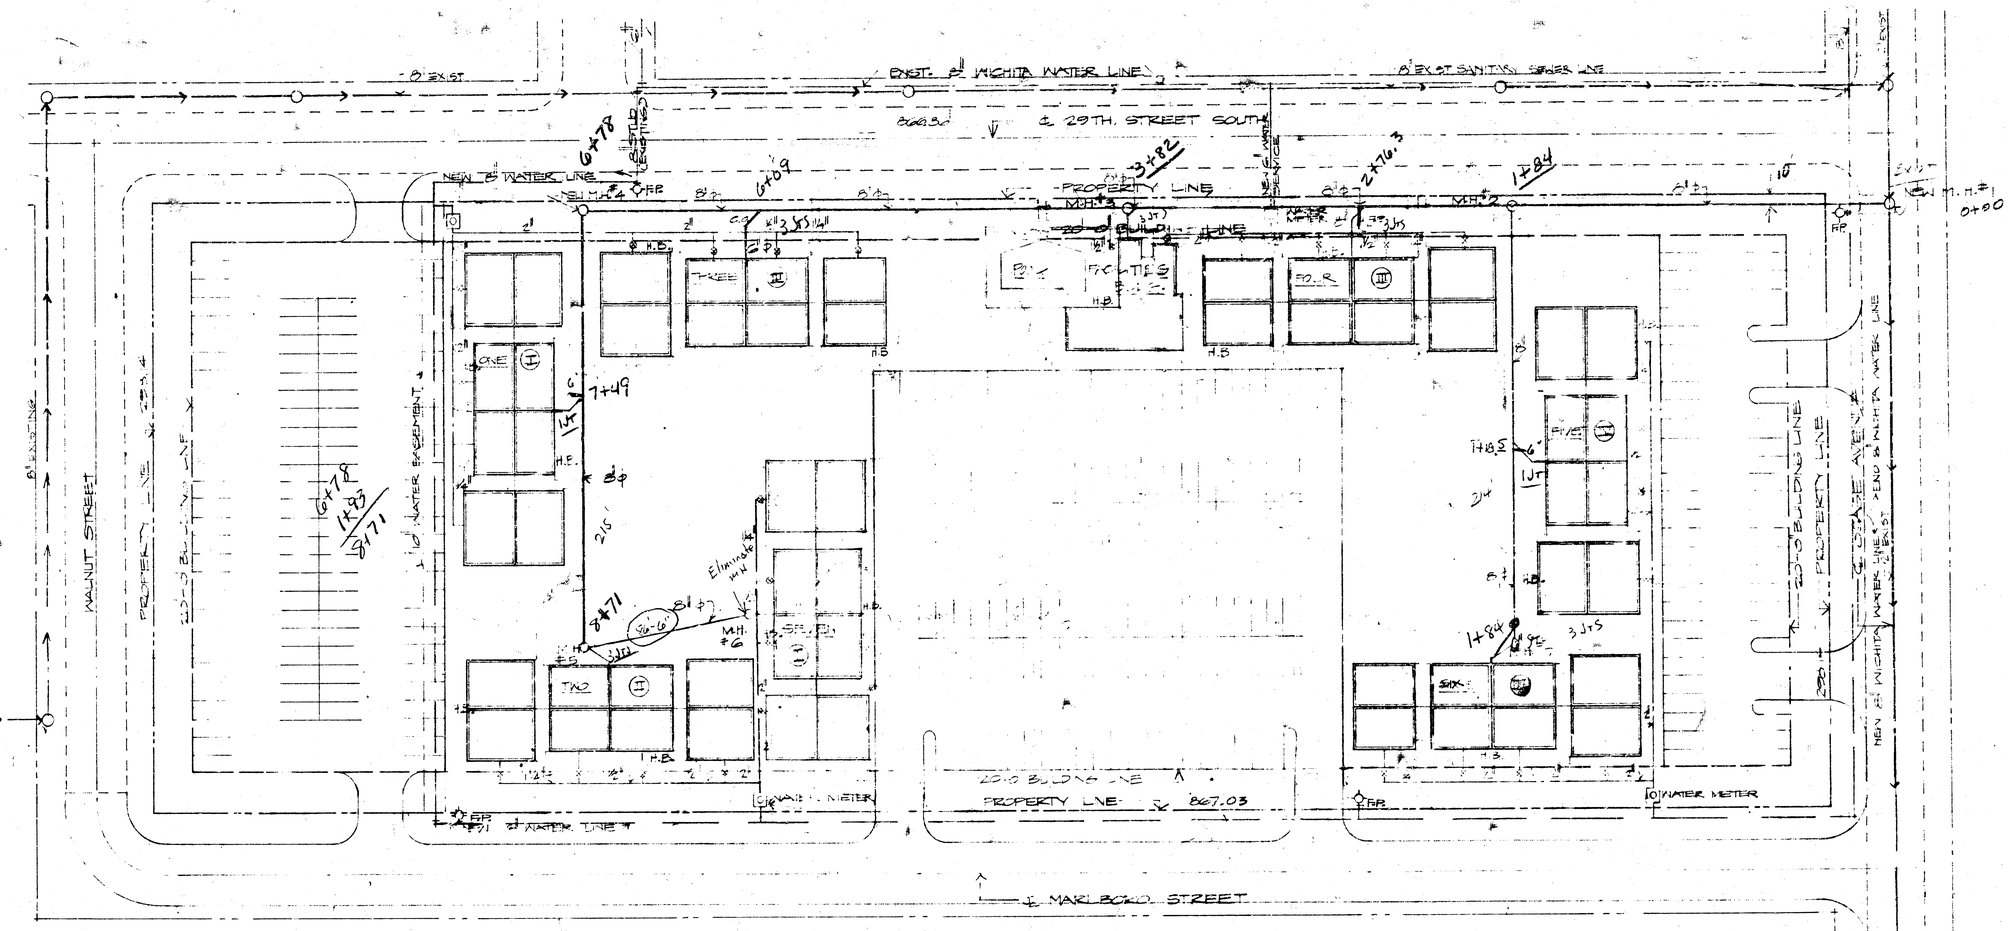


MECHANICAL SITE PLAN

Mid States Const. Co. Inc.
As Built

8"
214
215
675
1104LF

6"
86LF

871
124
955

JOB #656

Revised 1/7-74

DEC 12 1973

MECHANICAL SITE PLAN

REVISED 20 AUG 73

PLANTATION 3 APARTMENTS

sheet M-1

DEC 12 1973

NEW M.H.#4
TP M.H. 98.42
FL SOUTH 91.43
FL EAST 91.92

NEW M.H.#3
TP M.H. 94.50
FL 90.51

NEW M.H.#2 CORR M.H.2
TP M.H. 94.42
FL WEST 89.45
FL SOUTH 94.43

DEC 12 1973

LINE A
1"= 40'-0"
VERT

	#5	#6	#7
T.P.	96.82	97.42	100.32
F.L.	93.91	94.32	96.00
	2.91	3.10	4.32

6.75
4
27.00

11.93
2
89.23

6°
9°
9.5°
9°














PLANTATION APARTMENTS

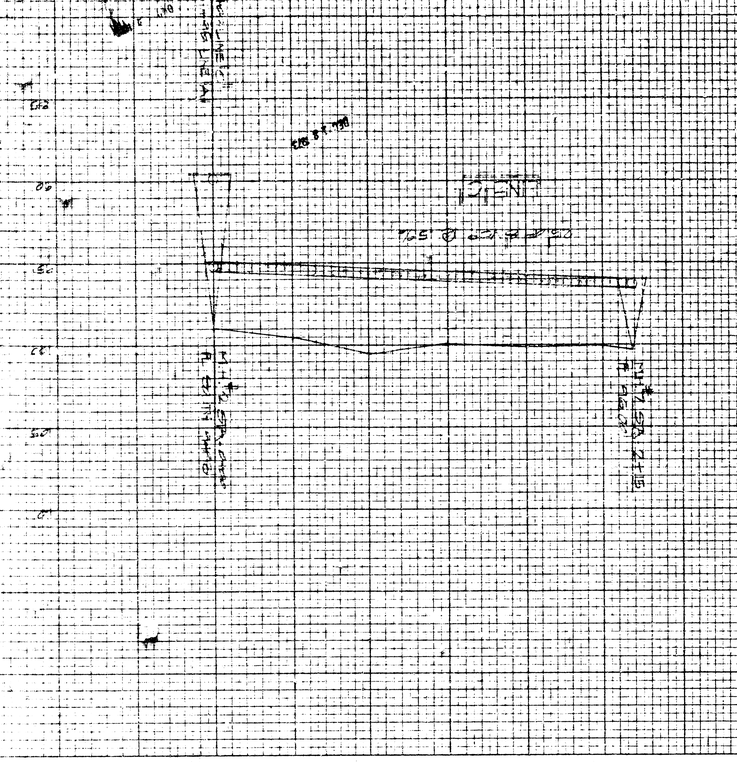


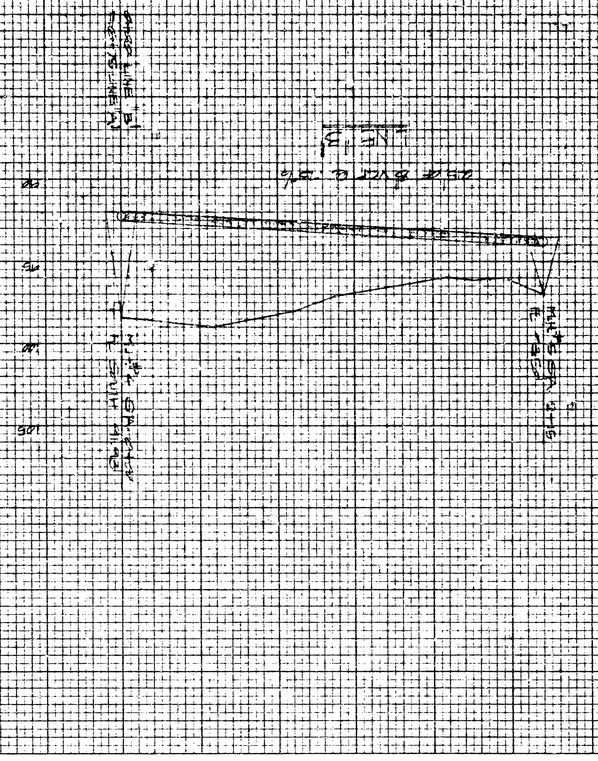


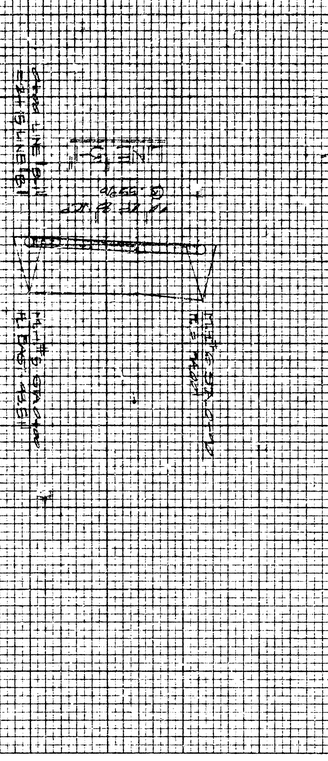

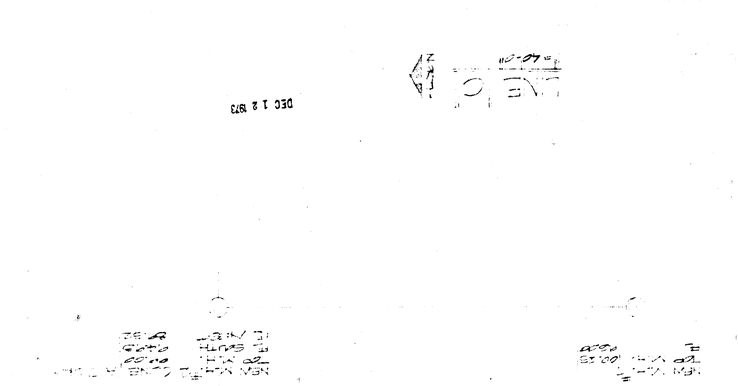

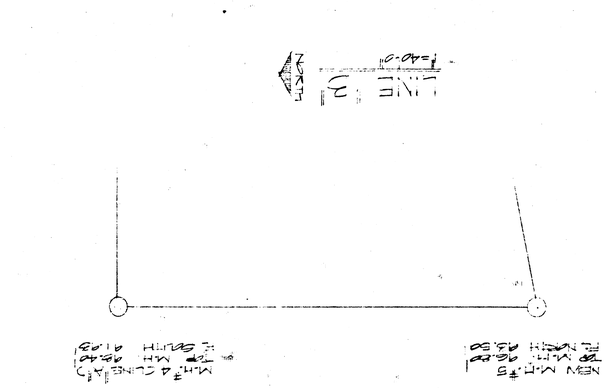

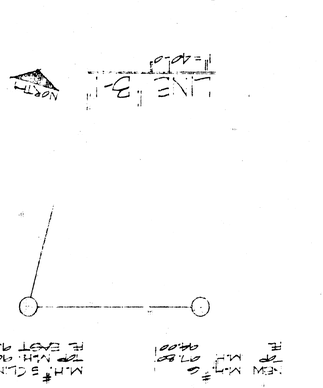

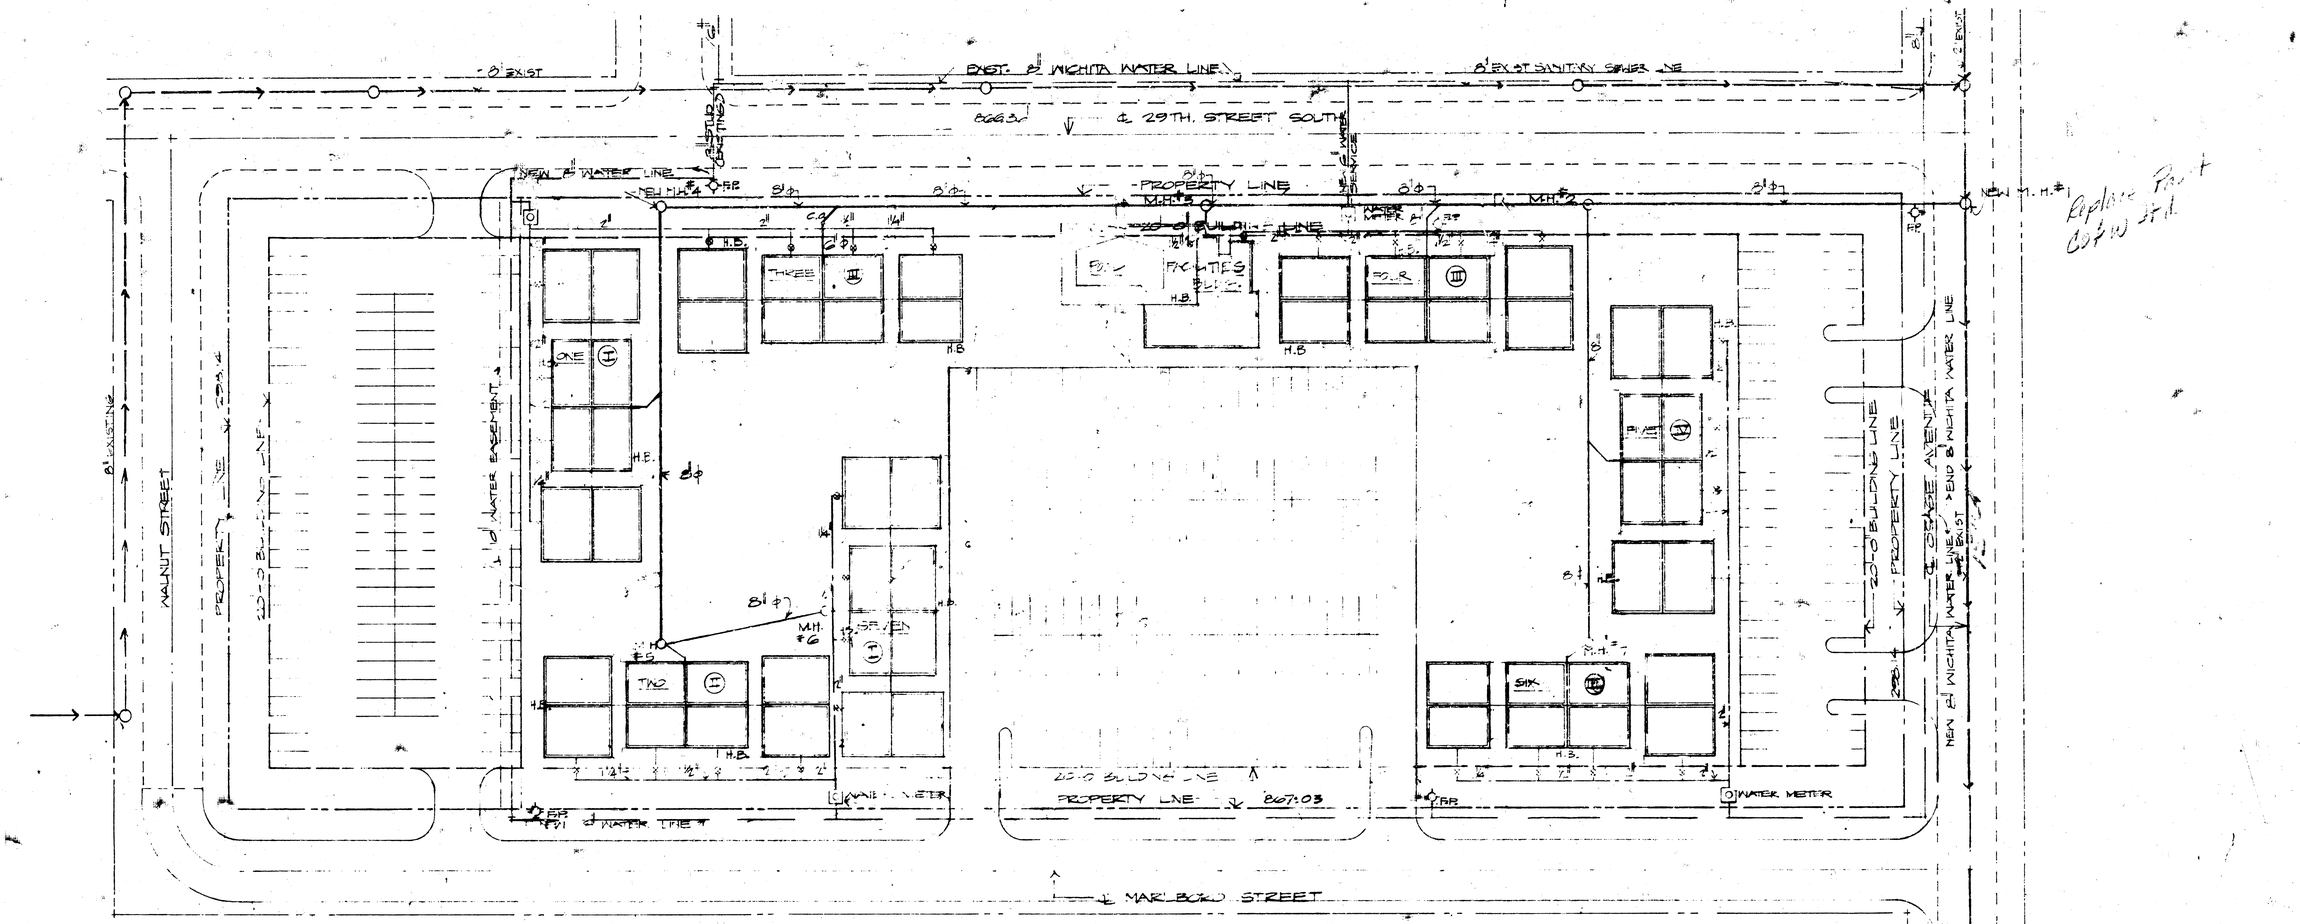

Replace Post
Cap'd 3-11

All MH to be T/A

MECHANICAL SITE PLAN
1"=20'

APPROVED AS NOTED
By CITY ENGINEER OF WICHITA
Sanitary Sewers DRB 2-27-73
Storm Sewers _____
Driveway Approaches _____

NOTE TO CONTRACTOR

This project will be constructed under the supervision of the CITY ENGINEER and conforming to the SPECIFICATIONS of the CITY OF WICHITA. The CONTRACTOR will reimburse the City of Wichita for all cost of Engineering, [redacted] and Inspection.


BHKB 73053

MECHANICAL SITE PLAN

REVISED 20 AUG 73

PLANTATION 3 APARTMENTS
WICHITA, KANSAS

sheet M-1

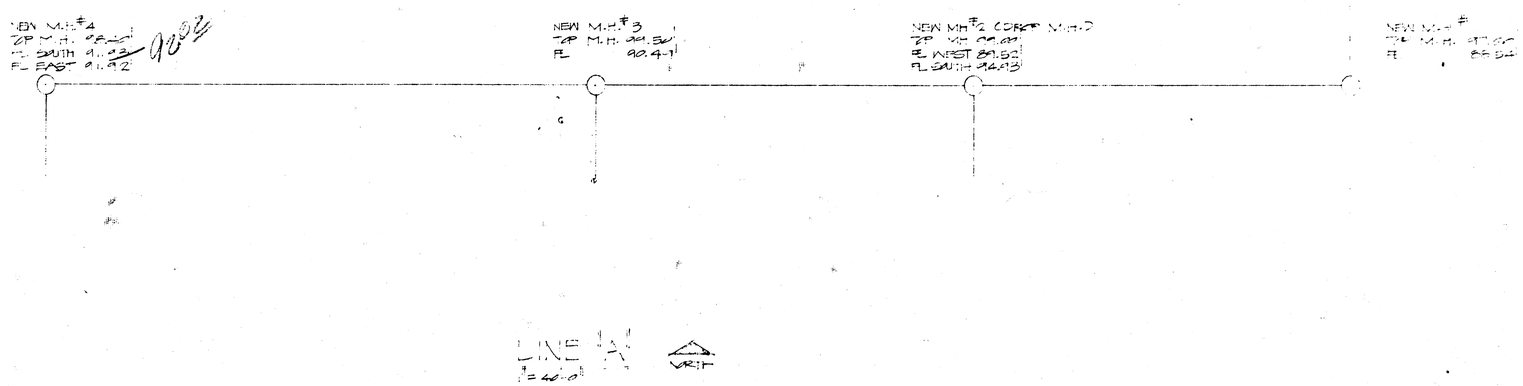

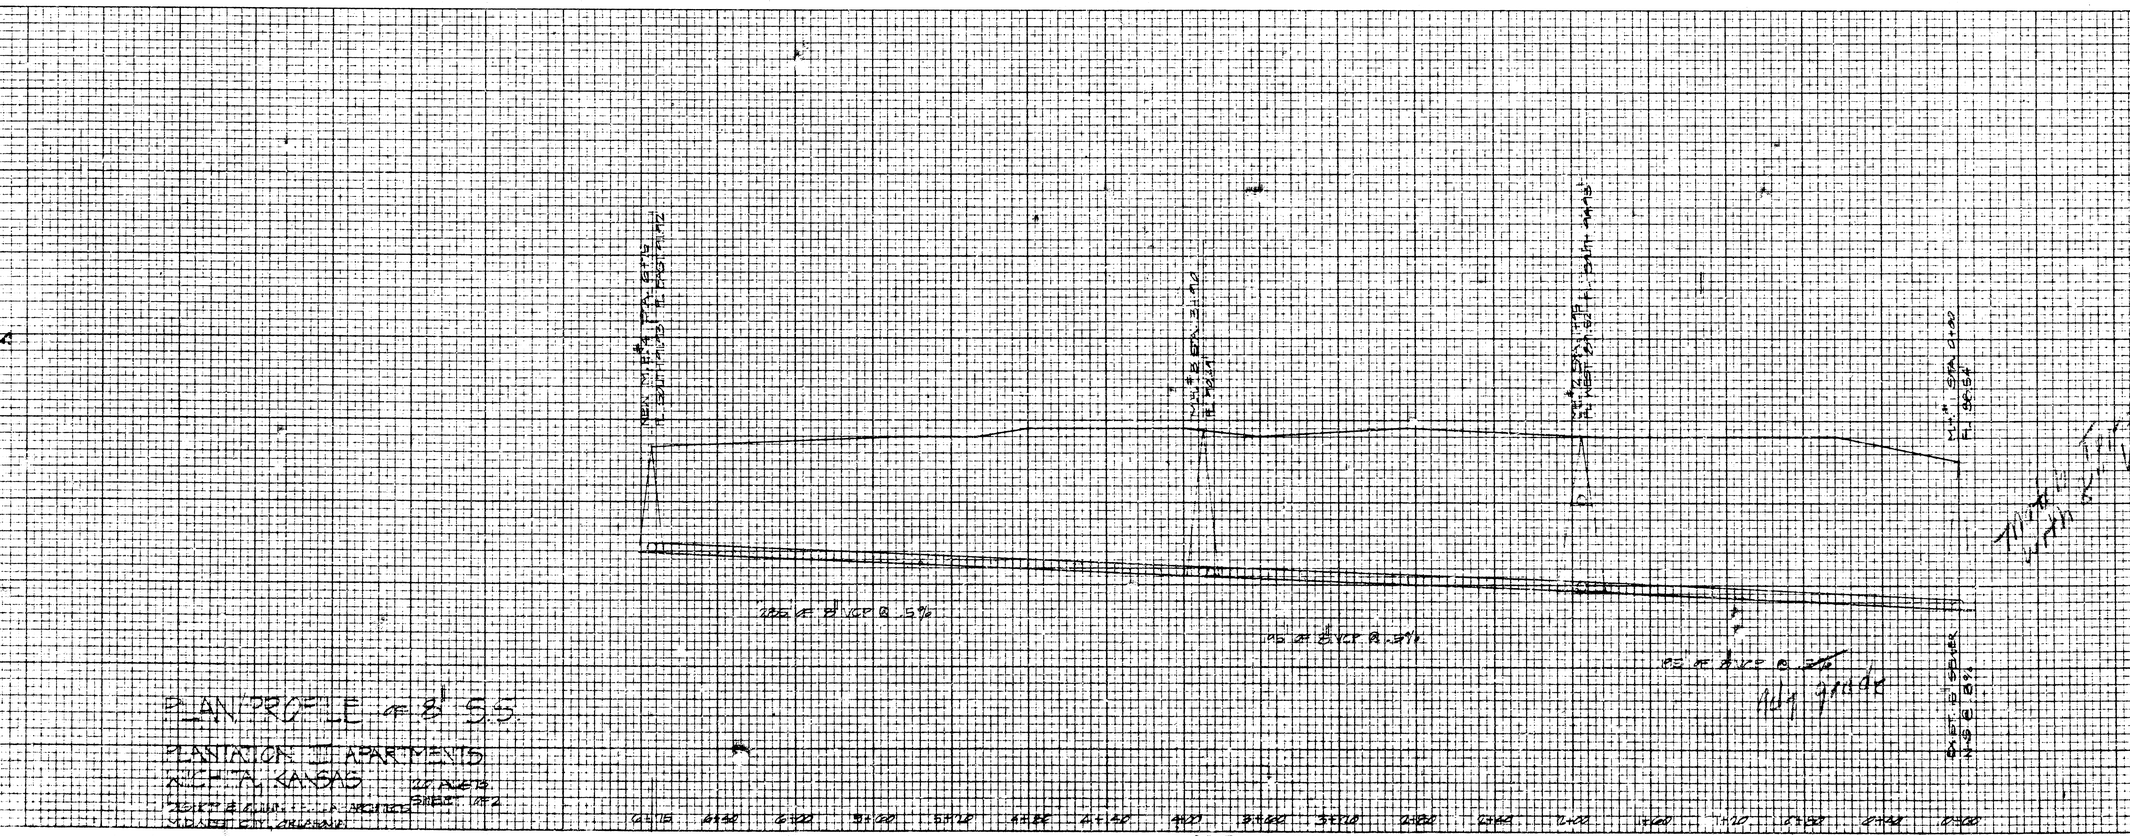



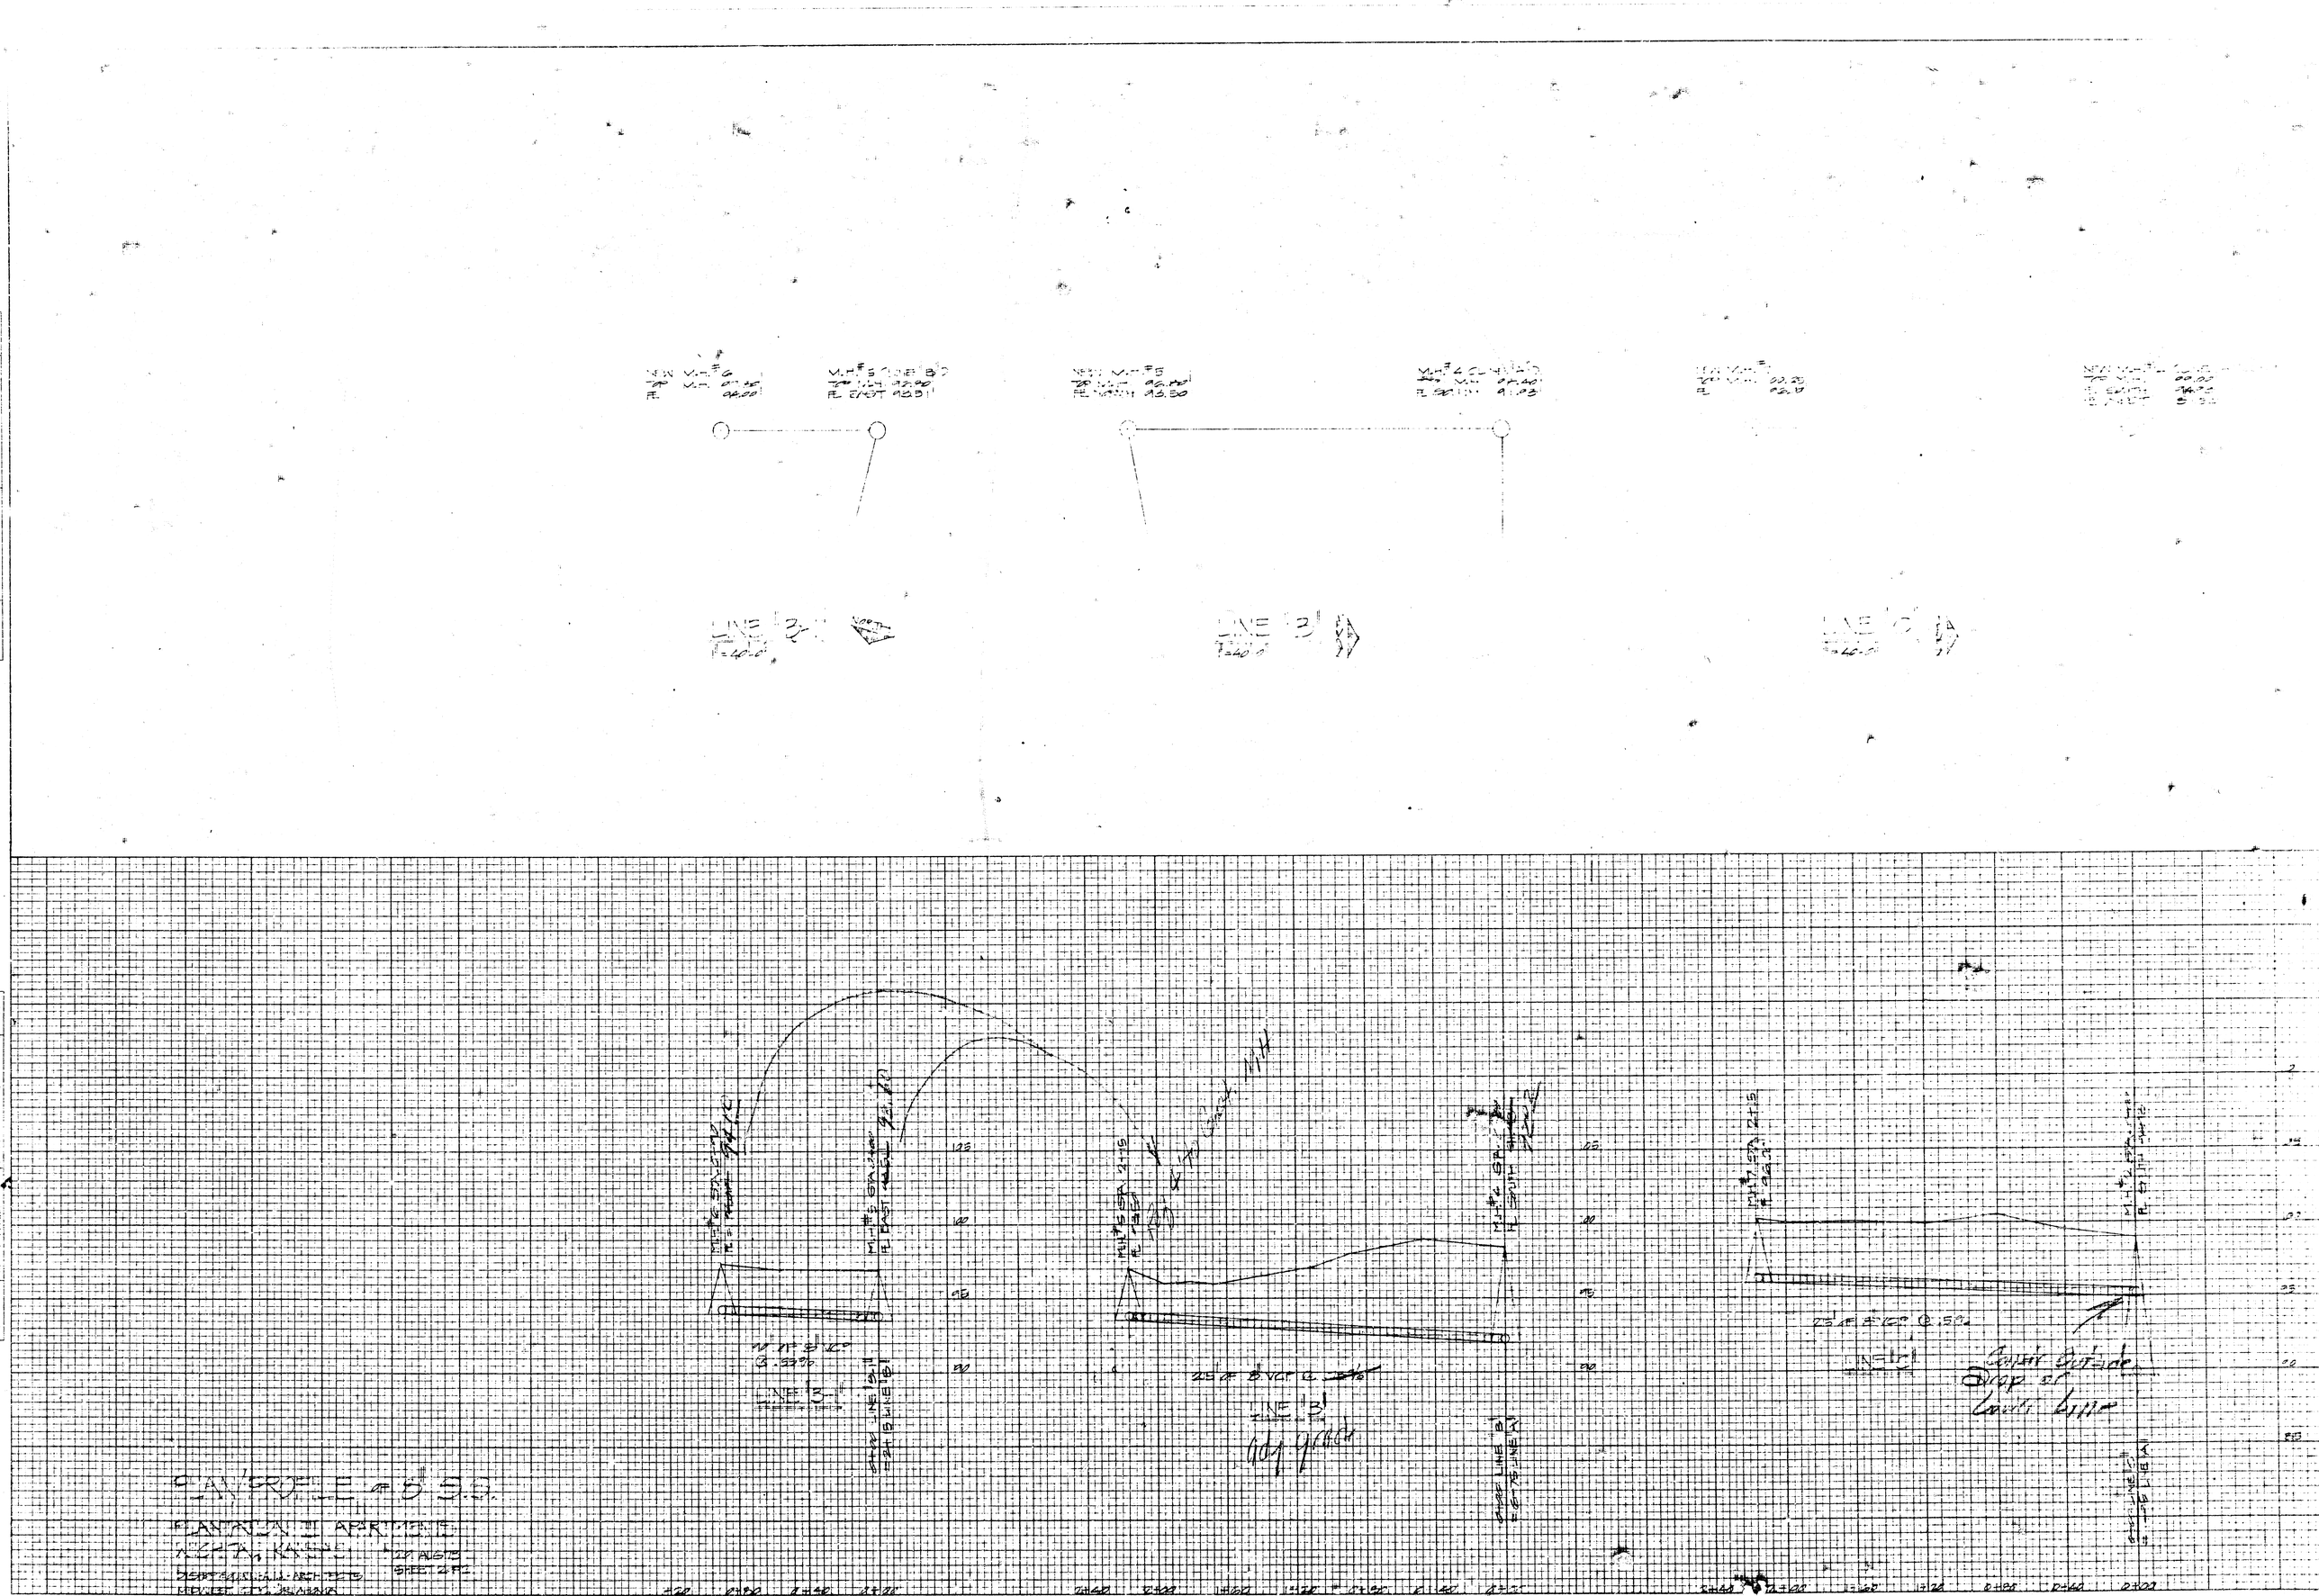


PLATE 4, CROSS SECTION
KEUFFEL & ESSER CO.

48 7076 MADE IN U.S.A.