PROJECT NO. 468-76-245-80001-000-000-132

CITY OF WICHITA, KANSAS

MICHAEL E. LINDEBAK, CITY ENGINEER

AUGUST, 1987

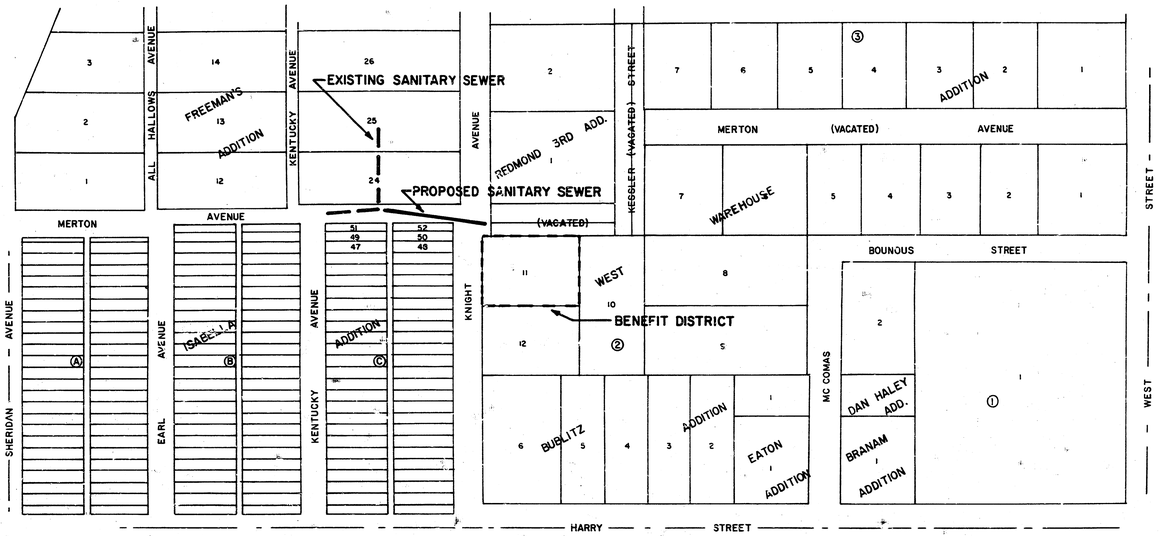

APPROVED AS NOTED
By CITY ENGINEER OF WICHITA
Sanitary Sewers GDB 9/2/87
Storm Sewers _____
Driveway Approaches _____
Water Mains _____
Paving _____

NOTE TO CONTRACTOR

This project will be constructed under the supervision of the CITY ENGINEER and conforming to the SPECIFICATIONS of the CITY OF WICHITA. The CONTRACTOR will pay the City of Wichita all costs of plan review, inspection and bonding per contract.

NOTE:

THE CITY OF WICHITA WILL AIR TEST AND TELEVISE THE NEW LINE PRIOR TO ACCEPTANCE.

WICHITA, KANSAS
SANITARY SEWER EXTENSIONS

MAP AND BENEFIT DISTRICT
PROJECT NO. 468-76-245-80001-000-000-132
PLASTIC FABRICATION CO.

CASTLE & ASSOCIATES ENGINEERS WICHITA, KANSAS

DSG LJK
DR LJK
CH
APP

DWG FILE NO 8738-D-60,047

DATE August 1987

SHEET NO 1 OF 1 1/2

REV

FILMED FROM THE BEST AVAILABLE COPY

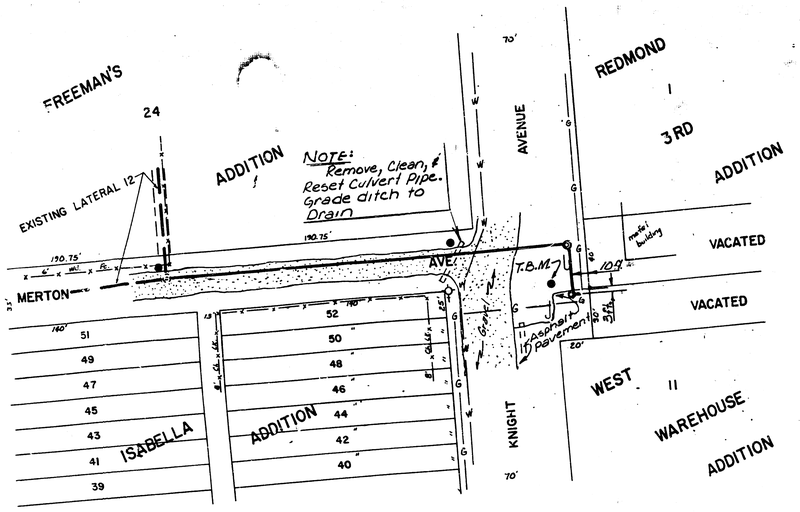



LEGEND

- PROPERTY IRON FOUND
- POWER POLE
- SANITARY SEWER MANHOLE
- FIRE HYDRANT
- DEADMAN
- 6' Wd x Fc — FENCE, TYPE AND SIZE
- G — GAS LINE
- W — WATER LINE

B.M. - CITY OF WICHITA BENCHMARK DISC, 53' WEST AND 43' SOUTH OF WEST ST. AND HARRY. ELEV. - 111.768

T.B.M. - 60d NAIL IN POWER POLE S.E. OF THE S.E. COR. OF LOT 11, WEST WAREHOUSE ADD.. ELEV. - 111.01

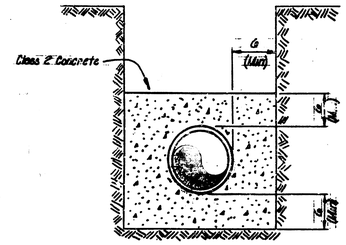

TYPE II CONCRETE ENCASEMENT

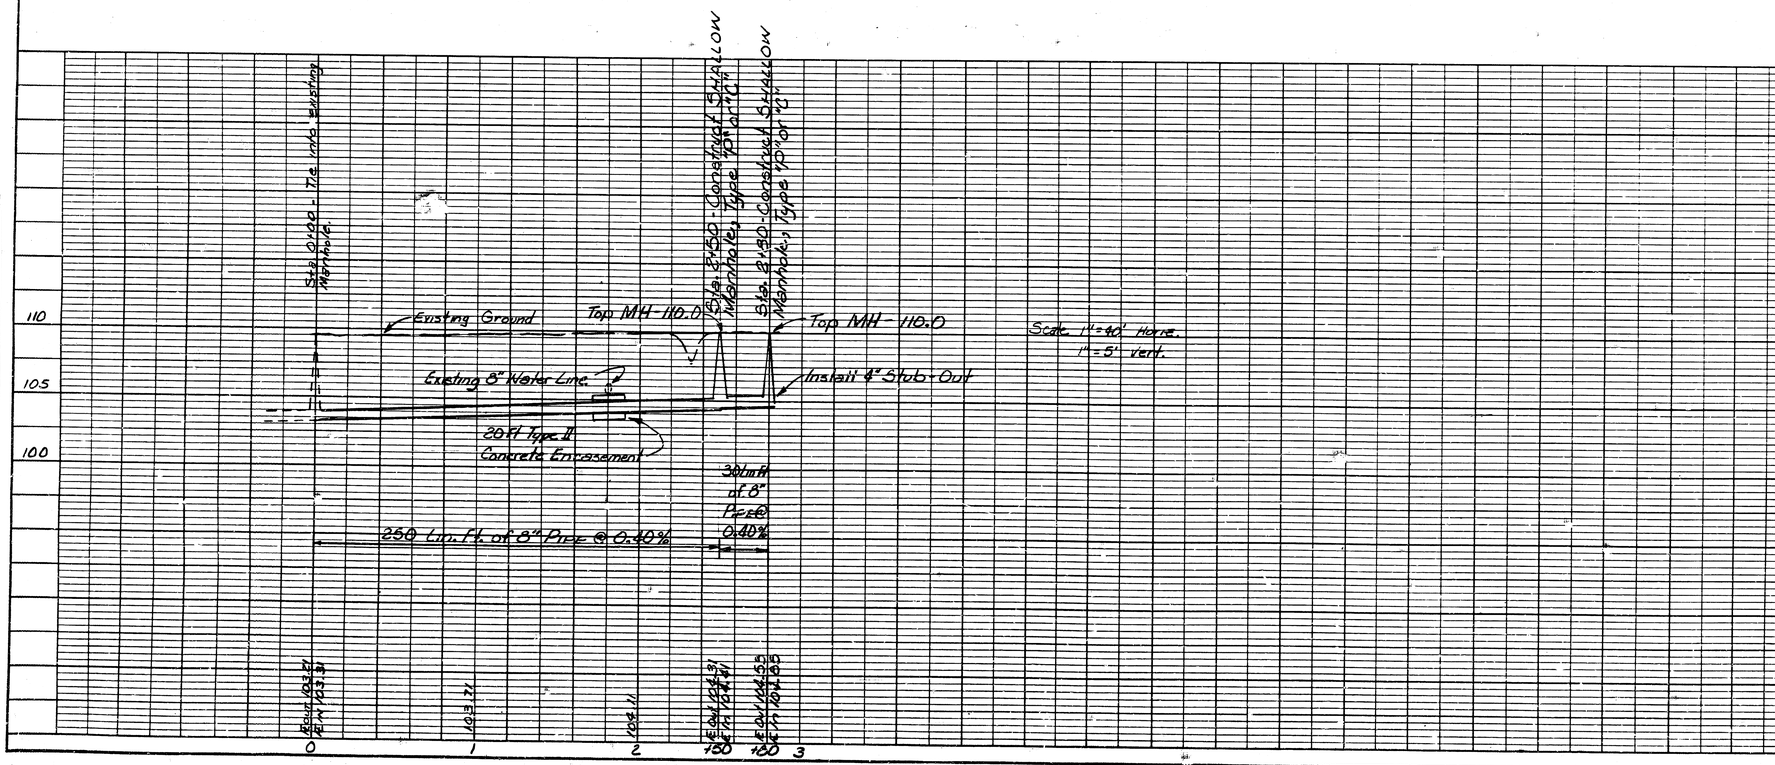

Scale 1" = 40' Horiz.
1" = 5' Vert.

Rev. A	8/26/87	RMH	Change Alignment Per City of Wichita

WICHITA, KANSAS
SANITARY SEWER EXTENSIONS

PLAN AND PROFILE
PROJECT No. 468-76-245-80001-000-000-132
PLASTIC FABRICATION CO.

CASTLE & ASSOCIATES
ENGINEERS
WICHITA, KANSAS

DSG LJK
DR LJK
CH
APP

DWG FILE NO. 8738-D-60,048

DATE AUGUST 1987

SHEET NO 2 OF 2

REV.

KEUFFEL & ESSER PLATE 1, PLAN-PROFILE
48 7024 Made in U.S.A.

PLAN
NOTE BOOK
NO.
SURVEYED
PLOTTED
ALIGNMENT CHECKED
RT. OF WAY CHECKED
BY
DATE

PROFILE
NOTE BOOK
NO.
SURVEYED
PLOTTED
GRADES CHECKED
B.M.'S NOTED
STRUCTURE NOTATIONS CHECKED
BY
DATE

FILMED FROM THE BEST AVAILABLE COPY