PROJECT NO. 468-76-245-80001-000-000-132

CITY OF WICHITA, KANSAS

MICHAEL E. LINDEBAK, CITY ENGINEER

AUGUST, 1987

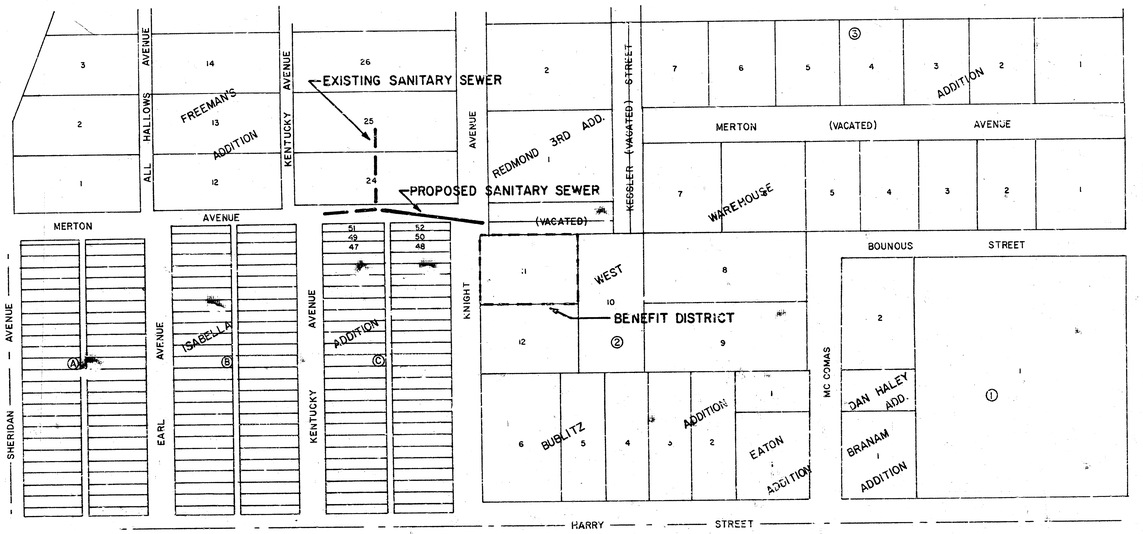

APPROVED AS NOTED
By CITY ENGINEER OF WICHITA
Sanitary Sewers [signature] 9/2/87
Storm Sewers
Driveway Approaches
Water Mains
Paving

NOTE TO CONTRACTOR

This project was constructed under the supervision of the CITY ENGINEER and conforming to the SPECIFICATIONS of the CITY OF WICHITA. The CONTRACTOR will pay the City of Wichita for all costs of plan review, inspection and cooking per contract.

NOTE:

THE CITY OF WICHITA WILL AIR TEST AND TELEVISE THE NEW LINE PRIOR TO ACCEPTANCE.

WICHITA, KANSAS
SANITARY SEWER EXTENSIONS

MAP AND BENEFIT DISTRICT
PROJECT No. 468-76-245-80001-000-000-132
PLASTIC FABRICATION CO.

CASTLE & ASSOCIATES ENGINEERS WICHITA, KANSAS	DSG LJK DR LJK CH APP	DWG FILE NO 8738-D-60,047
DATE August 1987		SHEET NO 1 OF 2 REV.

1/2

FILMED FROM THE BEST AVAILABLE COPY

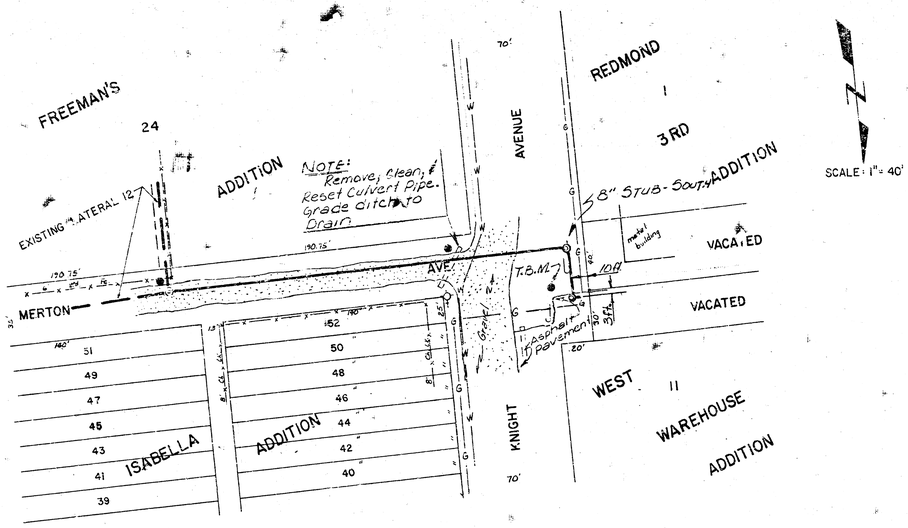

SCALE: 1" = 40'

LEGEND

- ● – PROPERTY IRON FOUND
- ● – POWER POLE
- ⊙ – SANITARY SEWER MANHOLE
- ✧ – FIRE HYDRANT
- ⊃ – DEADMAN
- 6' std x 72" – FENCE, TYPE AND SIZE
- ——G—— – GAS LINE
- ——W—— – WATER LINE

B.M. – CITY OF WICHITA BENCHMARK DISC, 53' WEST AND 43' SOUTH OF WEST ST. AND HARRY. ELEV. - 111.768

T.B.M. – 60d NAIL IN POWER POLE S.E. OF THE S.E. COR. OF LOT 11, WEST WAREHOUSE ADD.. ELEV. - 111.01

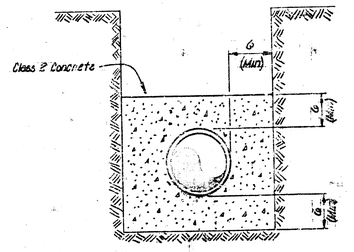

TYPE II CONCRETE ENCASEMENT

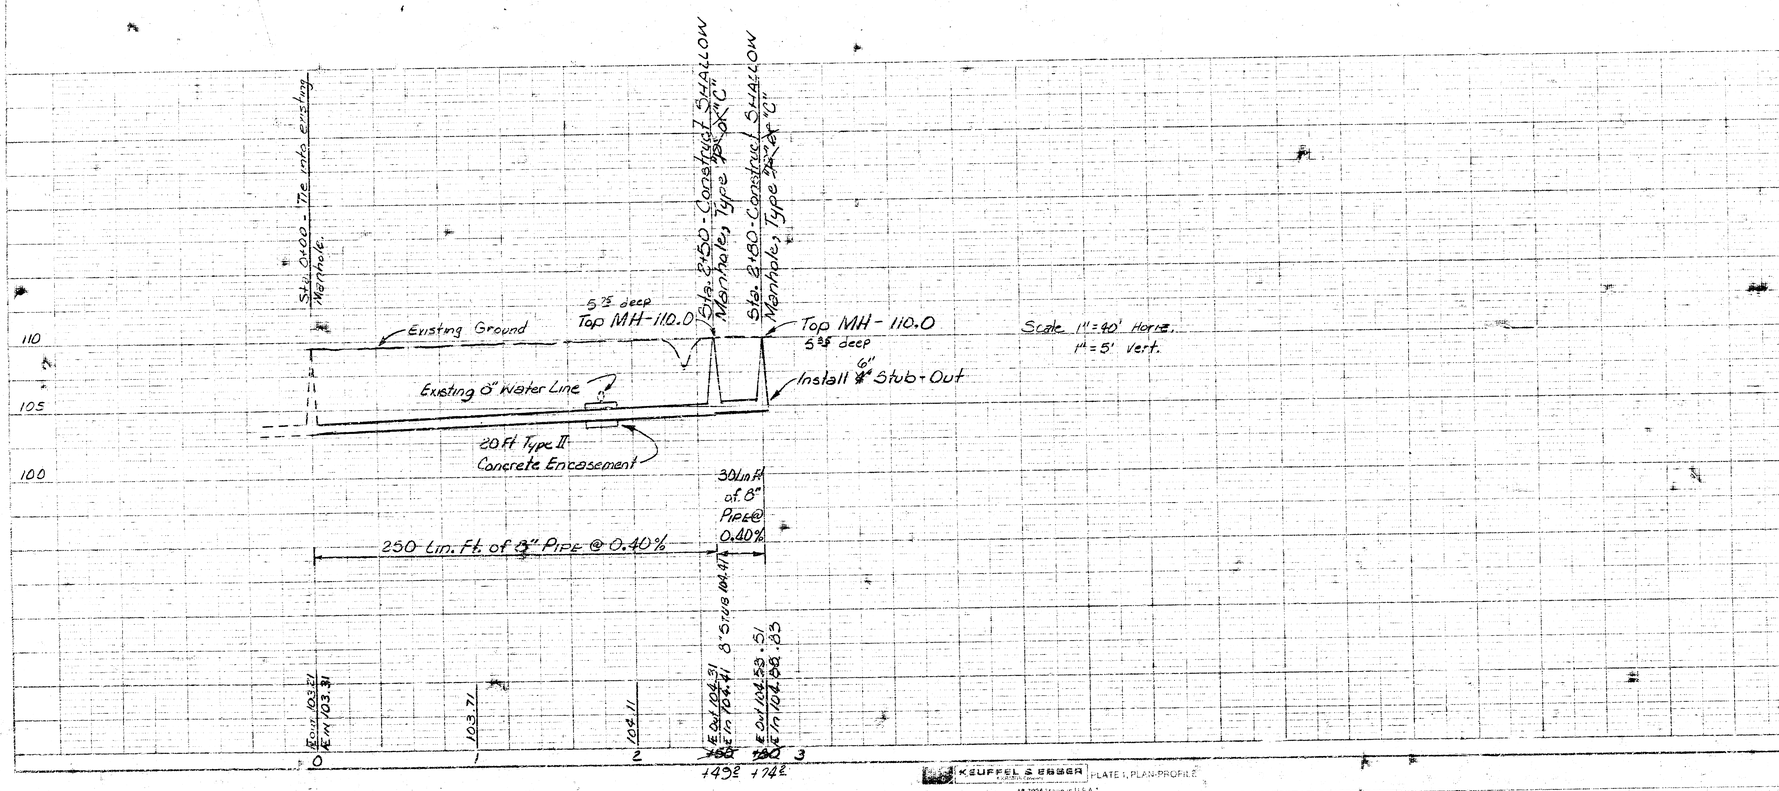

Rev E0	9/23/87	RMH	RECORD DRAWING
Rev A	8/26/87	RMH	Change Alignment Per City of Wichita

WICHITA, KANSAS
SANITARY SEWER EXTENSIONS
PLAN AND PROFILE
PROJECT No. 468-76-245-60001-000-000-132
PLASTIC FABRICATION CO.

CASTLE & ASSOCIATES ENGINEERS WICHITA, KANSAS

DSG LJK | DR LJK | CH | APP

DWG FILE NO 8738-D-60,048

DATE AUGUST 1987

SHEET NO 2 OF 2 | REV E0

KEUFFEL & ESSER | PLATE 1, PLAN-PROFILE

2/2

FILMED FROM THE BEST AVAILABLE COPY.....