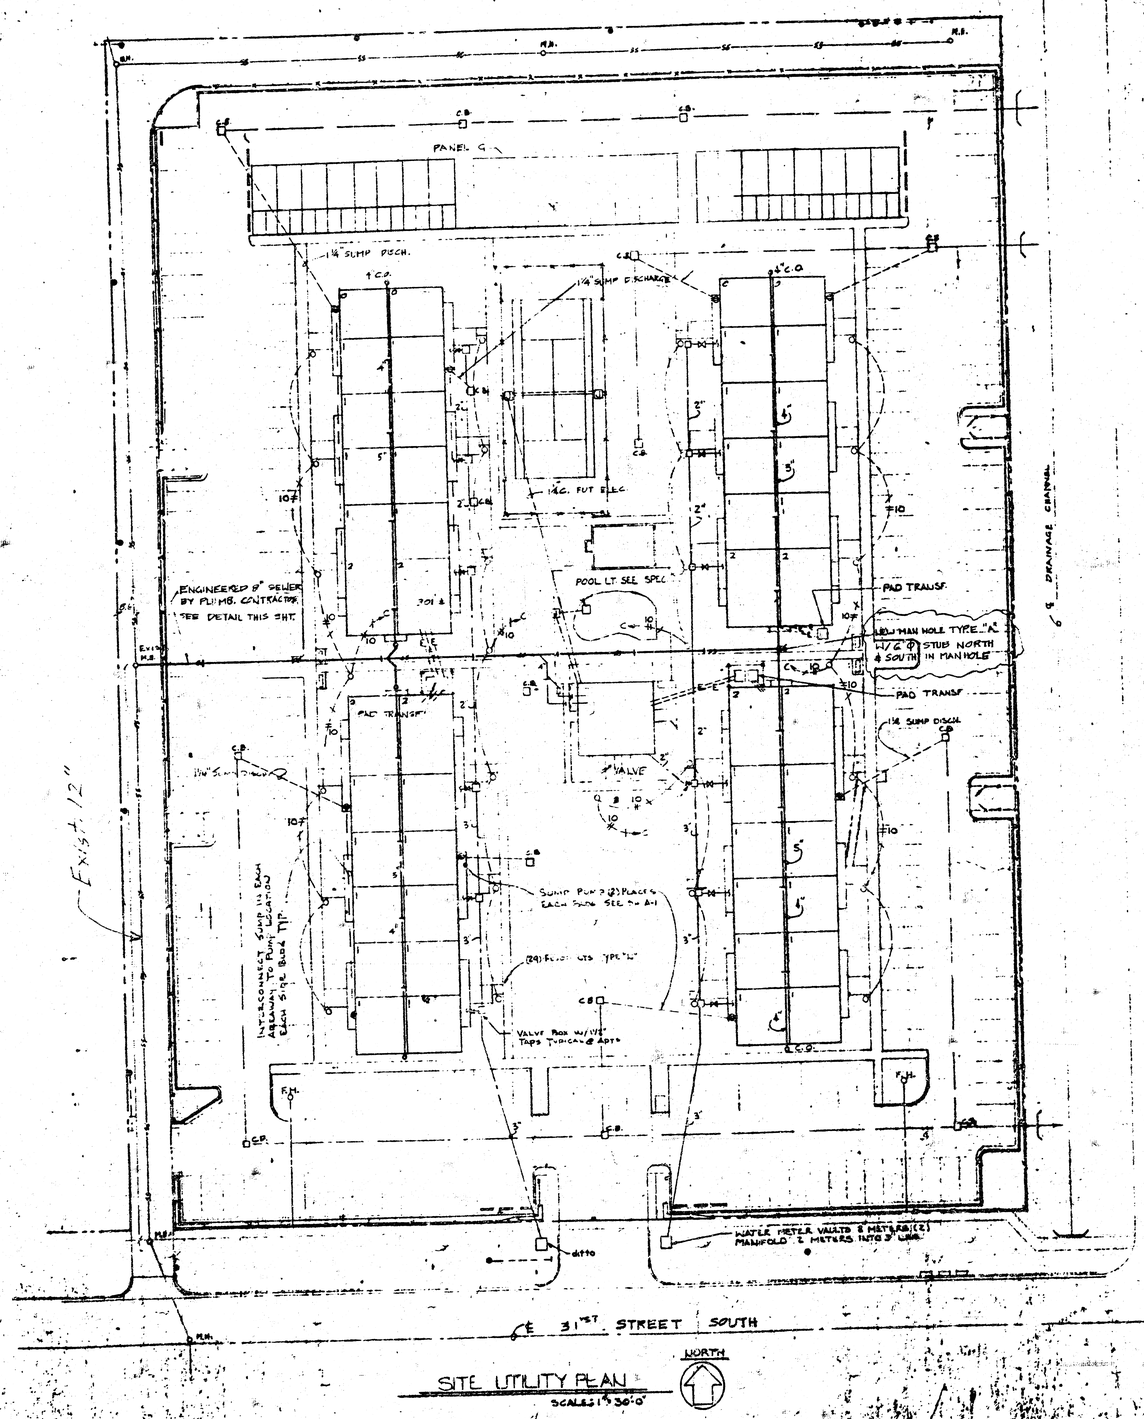

SITE UTILITY PLAN
SCALE: 1" = 30'-0"

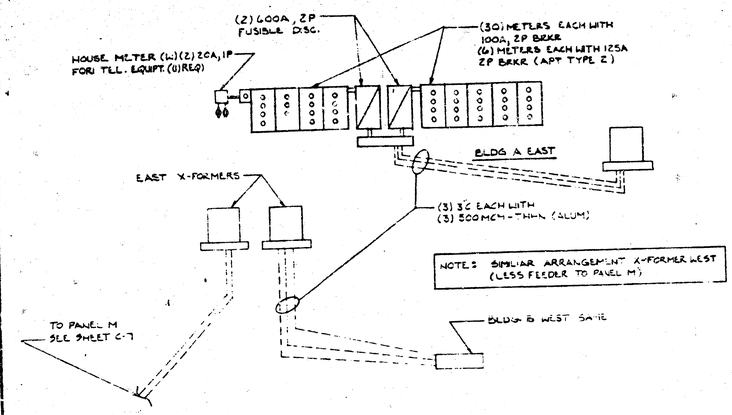

RISER X-FORMER EAST
NO SCALE

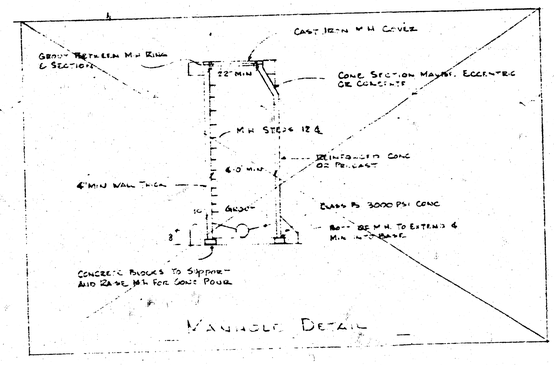

MANHOLE DETAIL

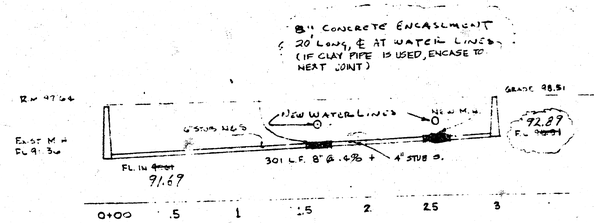

EAST WEST SEWER
CITY PROJECT NO. 468-76-245-80911-000-000

NOTE TO CONTRACTOR

This project will be constructed under the supervision of the CITY ENGINEER and conforming to the SPECIFICATIONS of the CITY OF WICHITA. The CONTRACTOR will reimburse the City of Wichita for all costs of engineering, inspection.

APPROVED AS NOTED
By CITY ENGINEER, WICHITA
Sanitary Sewers 11/24/80 CDB
Storm Sewers
Driveway Approaches

Stearns Engineering
CONSULTING ENGINEERS
ROOM 108 AM 2-1201
254 LAURA, WICHITA

REV 24 JAN 1980

DATE	SEPT. 79
DRAWN	BES
CHECKED	LEW
REVISED	12 OCT 79
	24 OCT 79

LAWRENCE E. WELLS
A R C H I T E C T
254 LAURA, SUITE 205 WICHITA, KANSAS 67211

REGISTERED ARCHITECT LAWRENCE E. WELLS 138 STATE OF KANSAS

SITE UTILITY PLAN

PLAZA WEST APARTMENTS

PLAN NO. C-346 PROJECT 396

SHEET C-8