
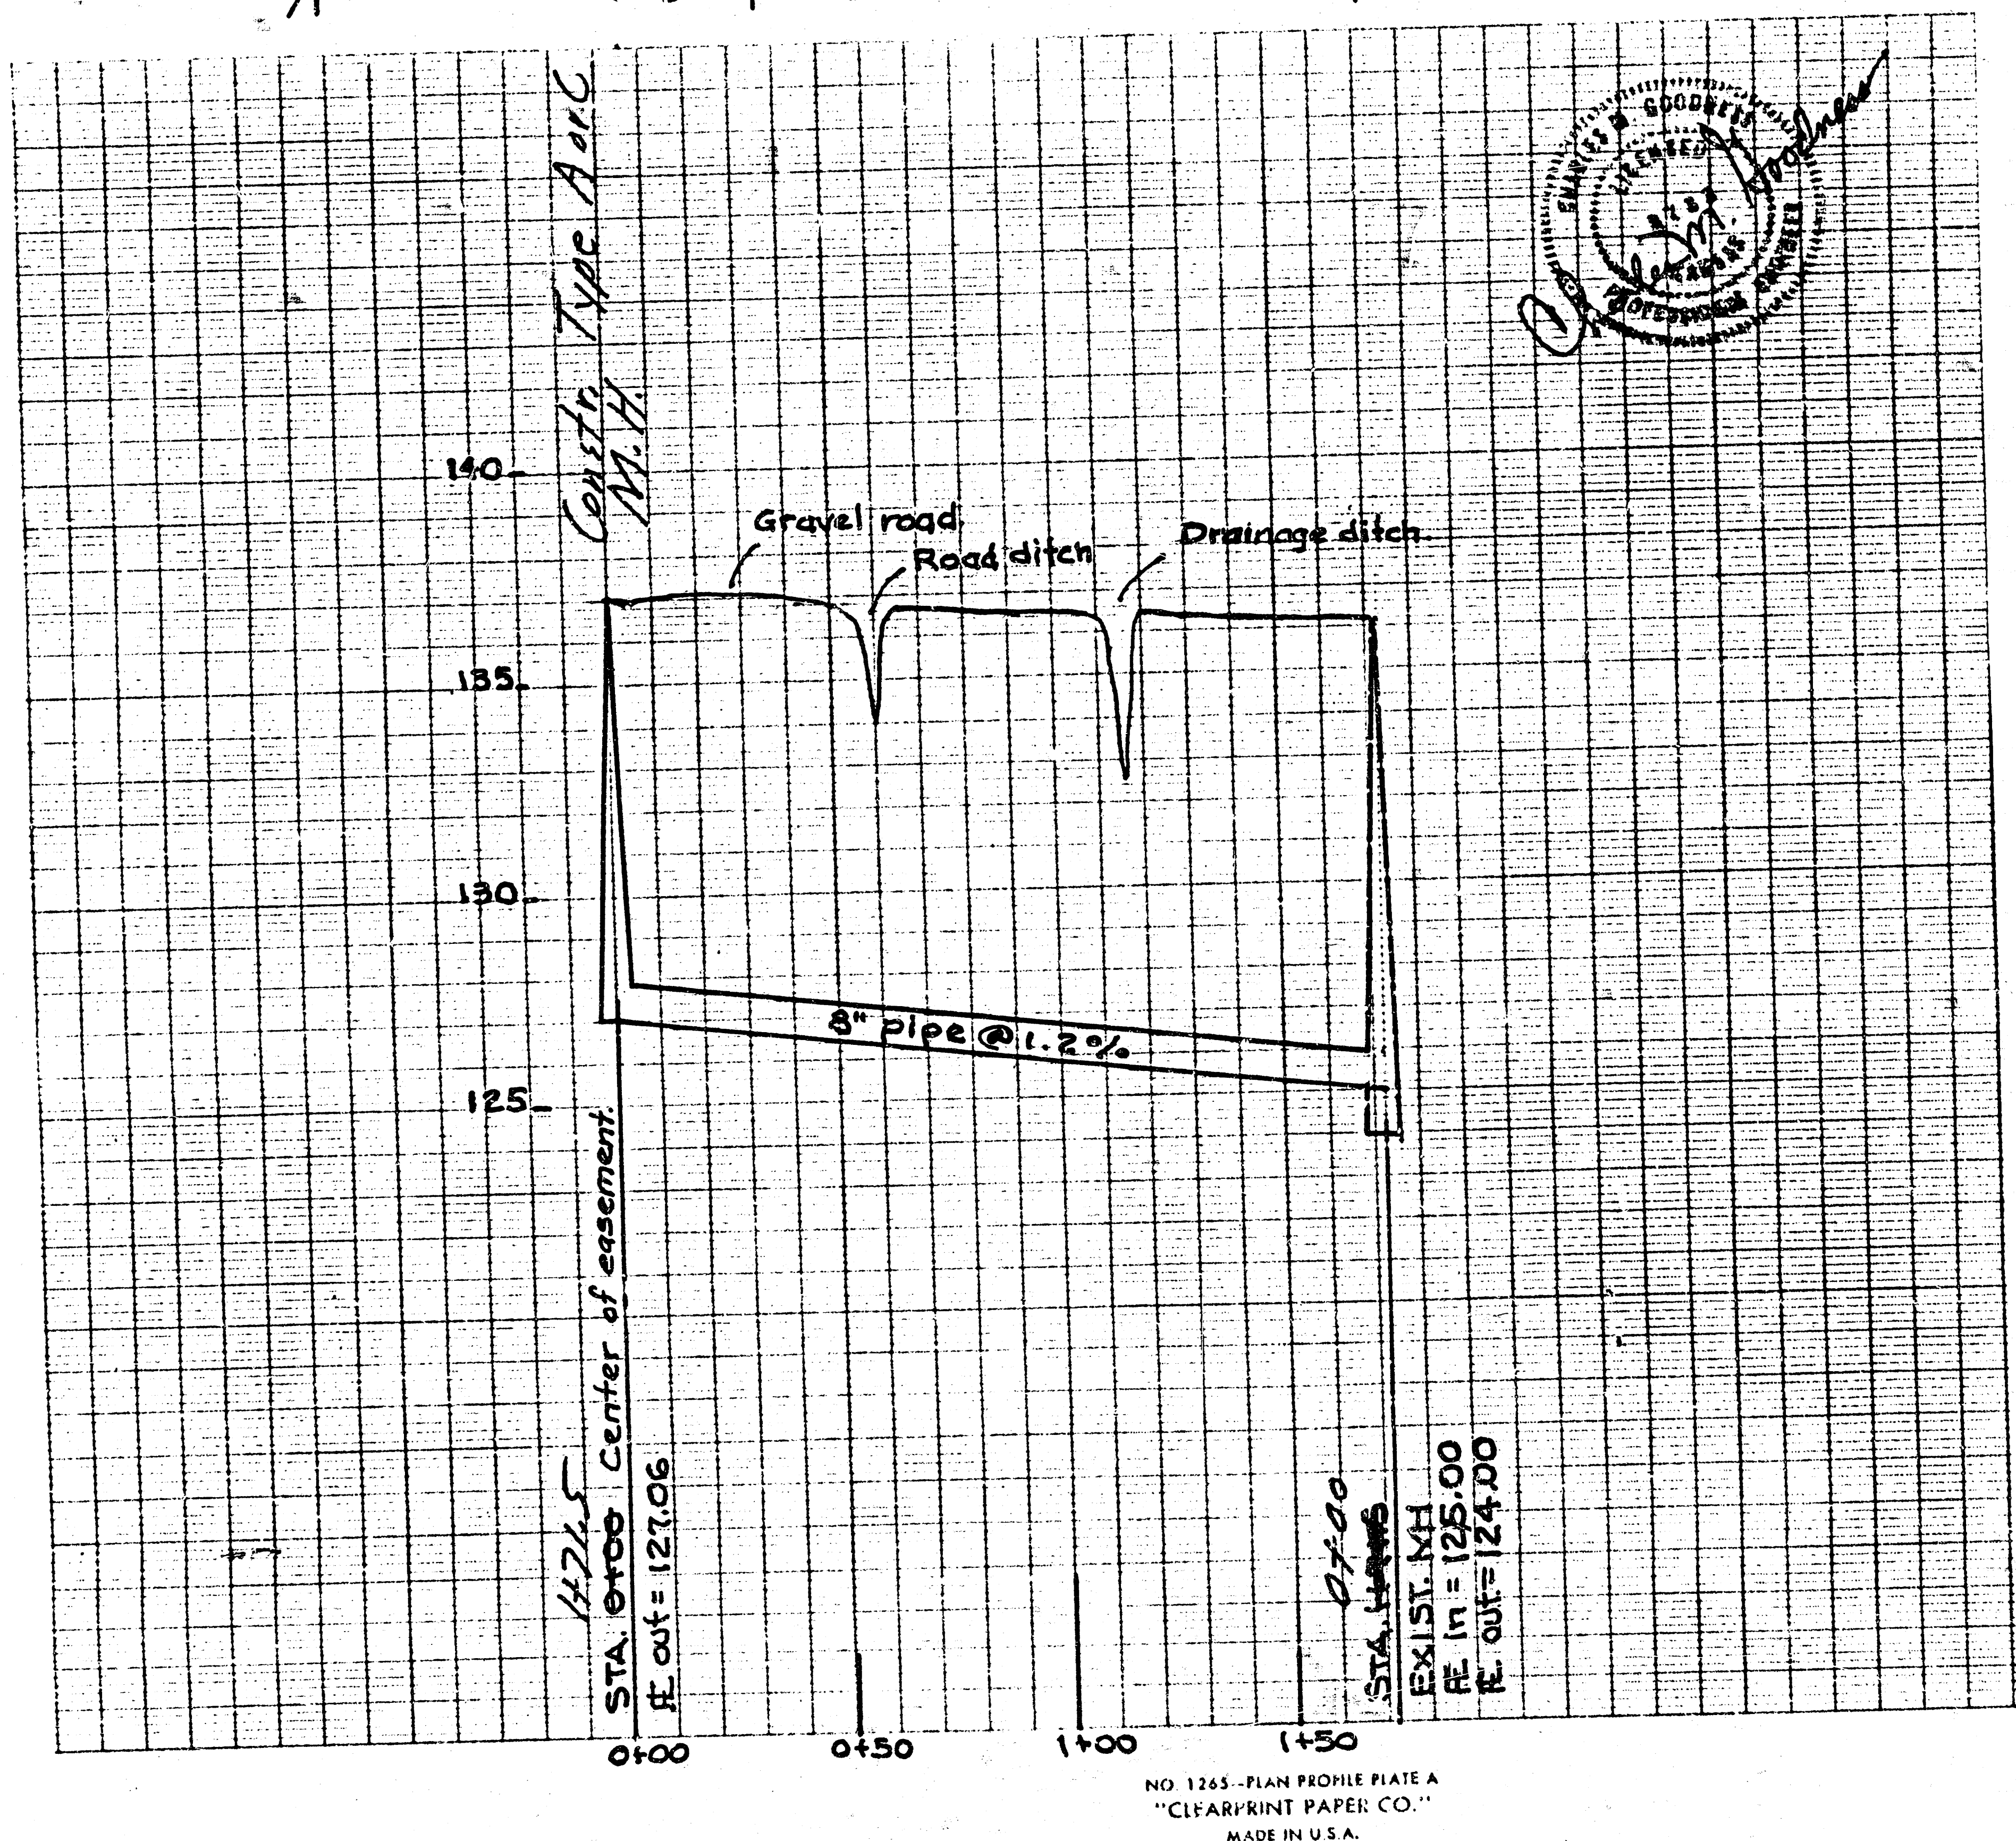


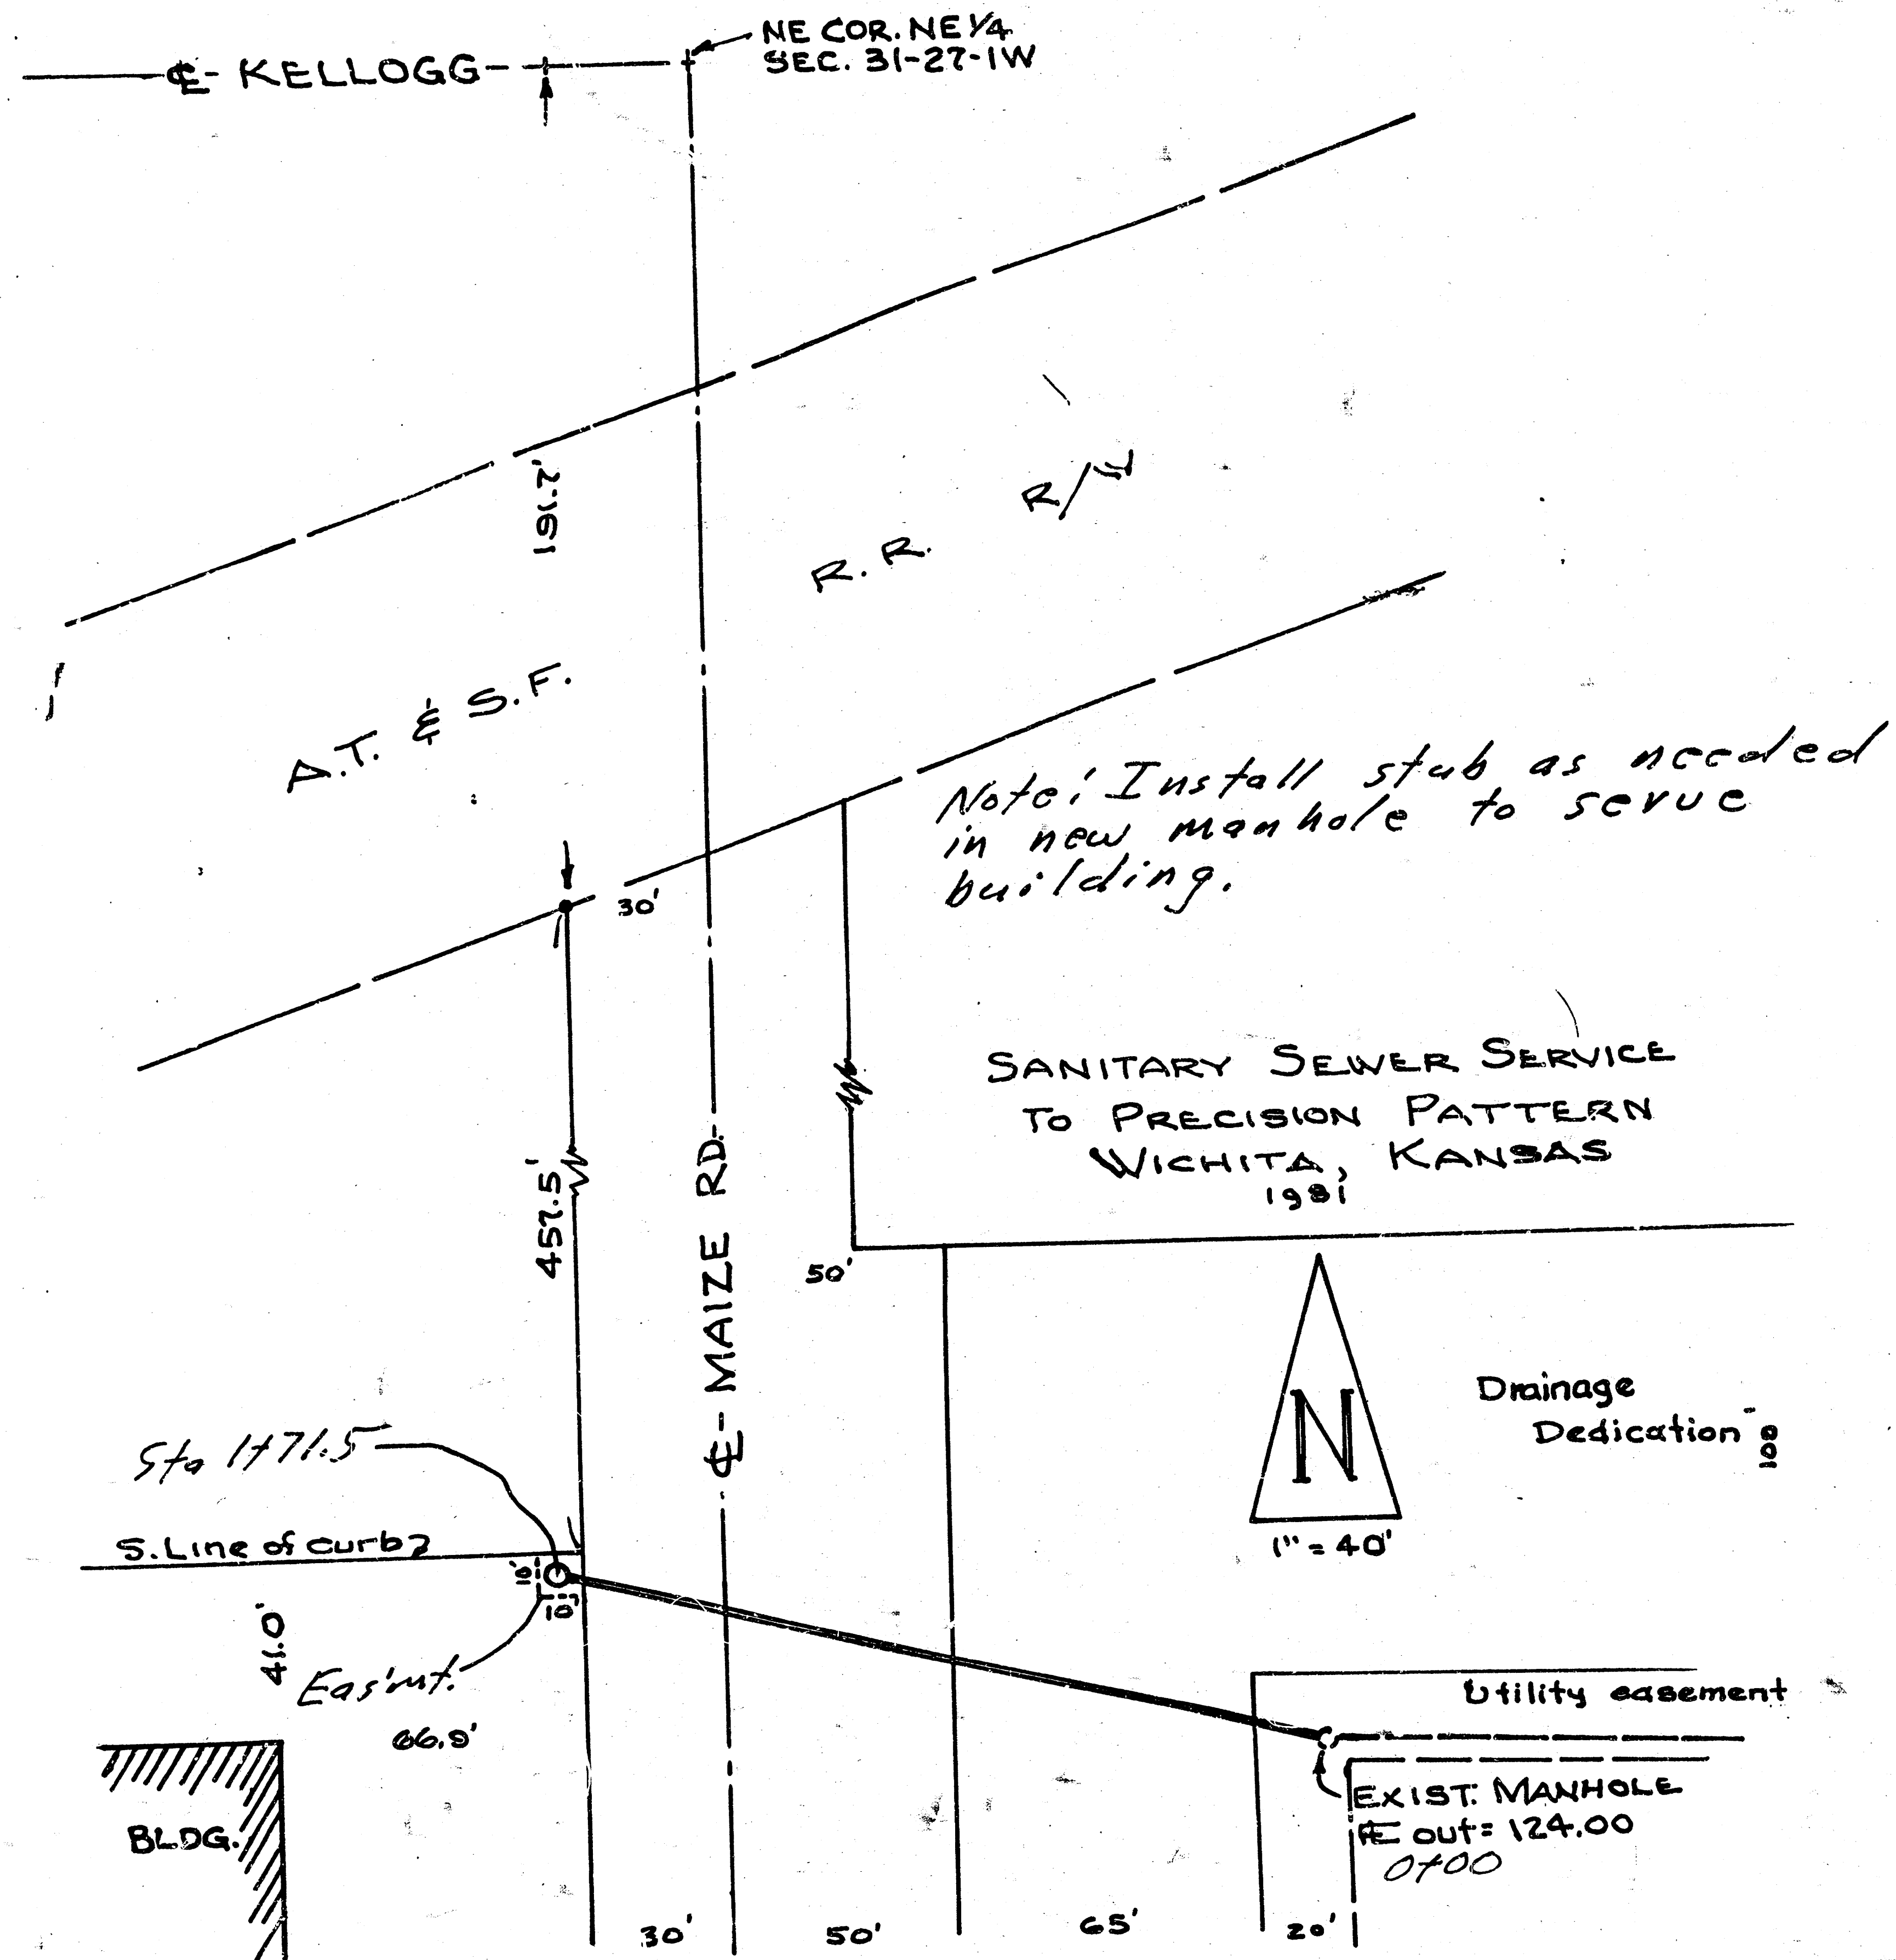

City #468-76-245-80000-000-000-008