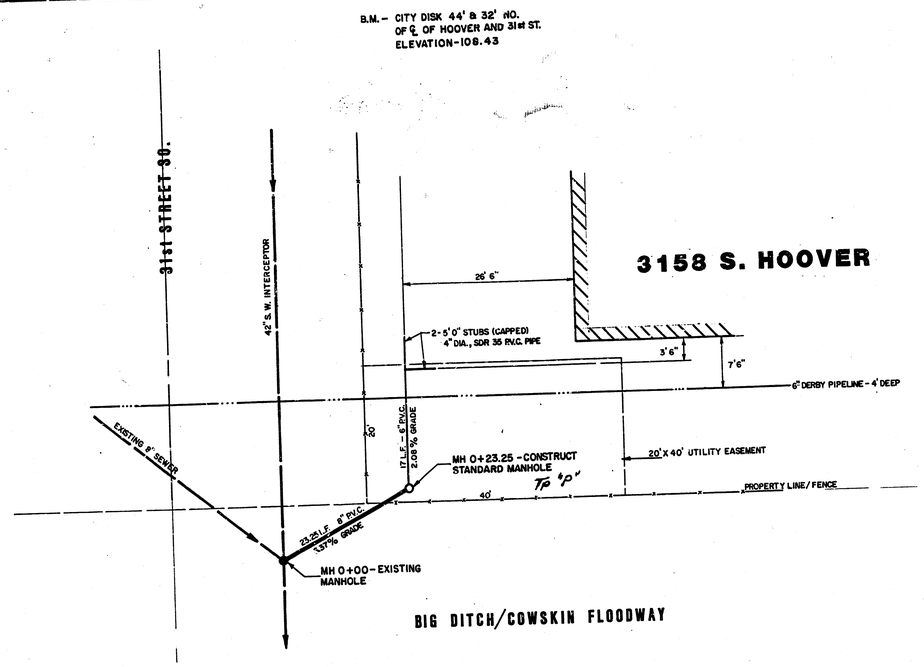


N

SCALE
PLAN 1" = 10'
PROFILE
VERT. 1" = 4'
HORZ. 1" = 10'

CITY OF WICHITA

**PRIVATE PROJECT NO. 209PPS**

MAY 1989

**AS CONSTRUCTED**

ALL PIPE IS P.V.C. – S.D.R. 35

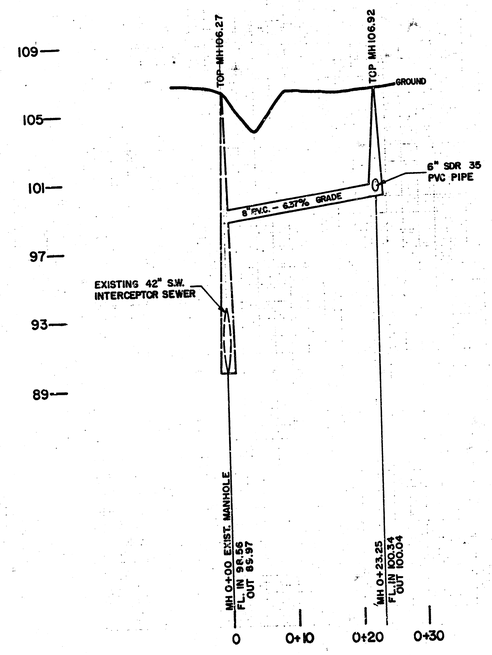


REISS & GOODNESS ENGINEERS
2160 WEST 21ST STREET
WICHITA, KANSAS 67204
(316) 832-0213

1/2

| REVISION | | DRAWN BY | | CHECKED BY | DESIGNED BY | PROJECT | CUSTOMER | SCALE | PROJECT NO. |
|---|---|---|---|---|---|---|---|---|---|
| | | JH | 5-9-89 | B.P. | D.C. | **POLLUTION CONTROL PROJECT** | **QUALITY MANUFACTURERS, INC.** | GIVEN | MS 1288 |
| | | | | | | | | DATE 4-10-89 | SHEET 1 OF 1 |

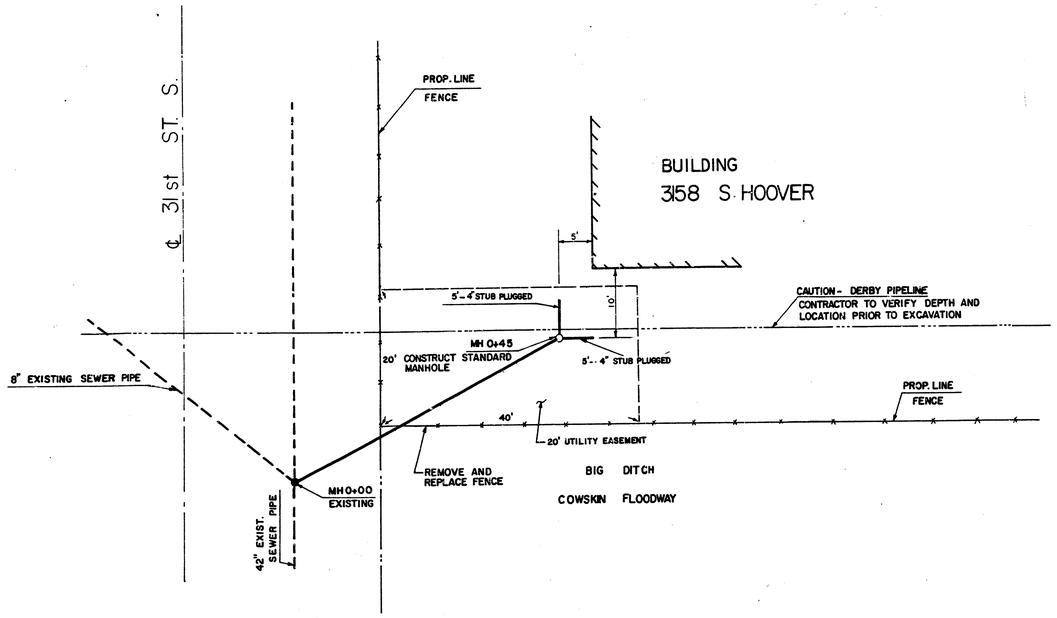


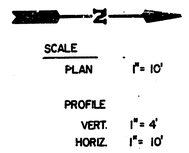


BM. CITY DISK 44' EAST & 32' NORTH OF
℄ OF HOOVER & 31st ST. S.- ELEV. 108.43

# CITY OF WICHITA
# PRIVATE PROJ. NO. 209PPS
# APRIL 1989

NOTE TO CONTRACTOR
INSPECTION AND TESTING FOR THIS PROJECT IS TO BE PRO
BY A LICENSED CONSULTING ENGINEERING FIRM
CONTRACT WITH THE OWNER/DEVELOPER AND
ACCEPTANCE WITH THE CITY OF WI
PROJECT
BE
ANY WITHOUT WRITTEN AUTHORIZATION
CITY ENGINEER.

APPROVED AS NOTED
By CITY ENGINEER OF WICHITA
Sanitary Sewers VRH 4/13/89
Storm Sewers
Paving
Water

( ALL PIPE IS 8" PVC. SDR-35. )

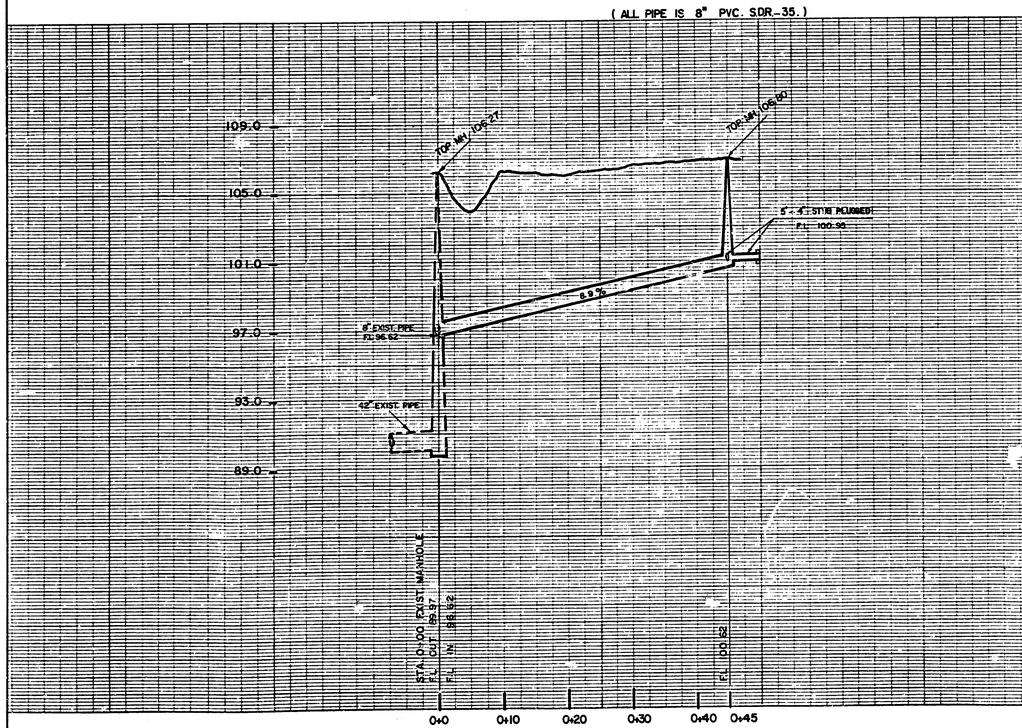


REISS & GOODNESS ENGINEERS
2150 WEST 21ST STREET
WICHITA, KANSAS 67204
(316) 832-0213

| REVISION | | DRAWN BY | CHECKED BY | DESIGNED BY | PROJECT | CUSTOMER | SCALE | PROJECT NO. |
|---|---|---|---|---|---|---|---|---|
| | | Rocky | B.P | D.C | POLLUTION CONTROL PROJECT | QUALITY MANUFACTURERS, INC. | GIVEN | MS 1288 |
| | | | | | | | DATE 4-10-89 | SHEET 1 OF 1 |

2/2