B.M. - CITY DISK 44' & 32' NO.
OF ℄ OF HOOVER AND 31st ST.
ELEVATION-108.43

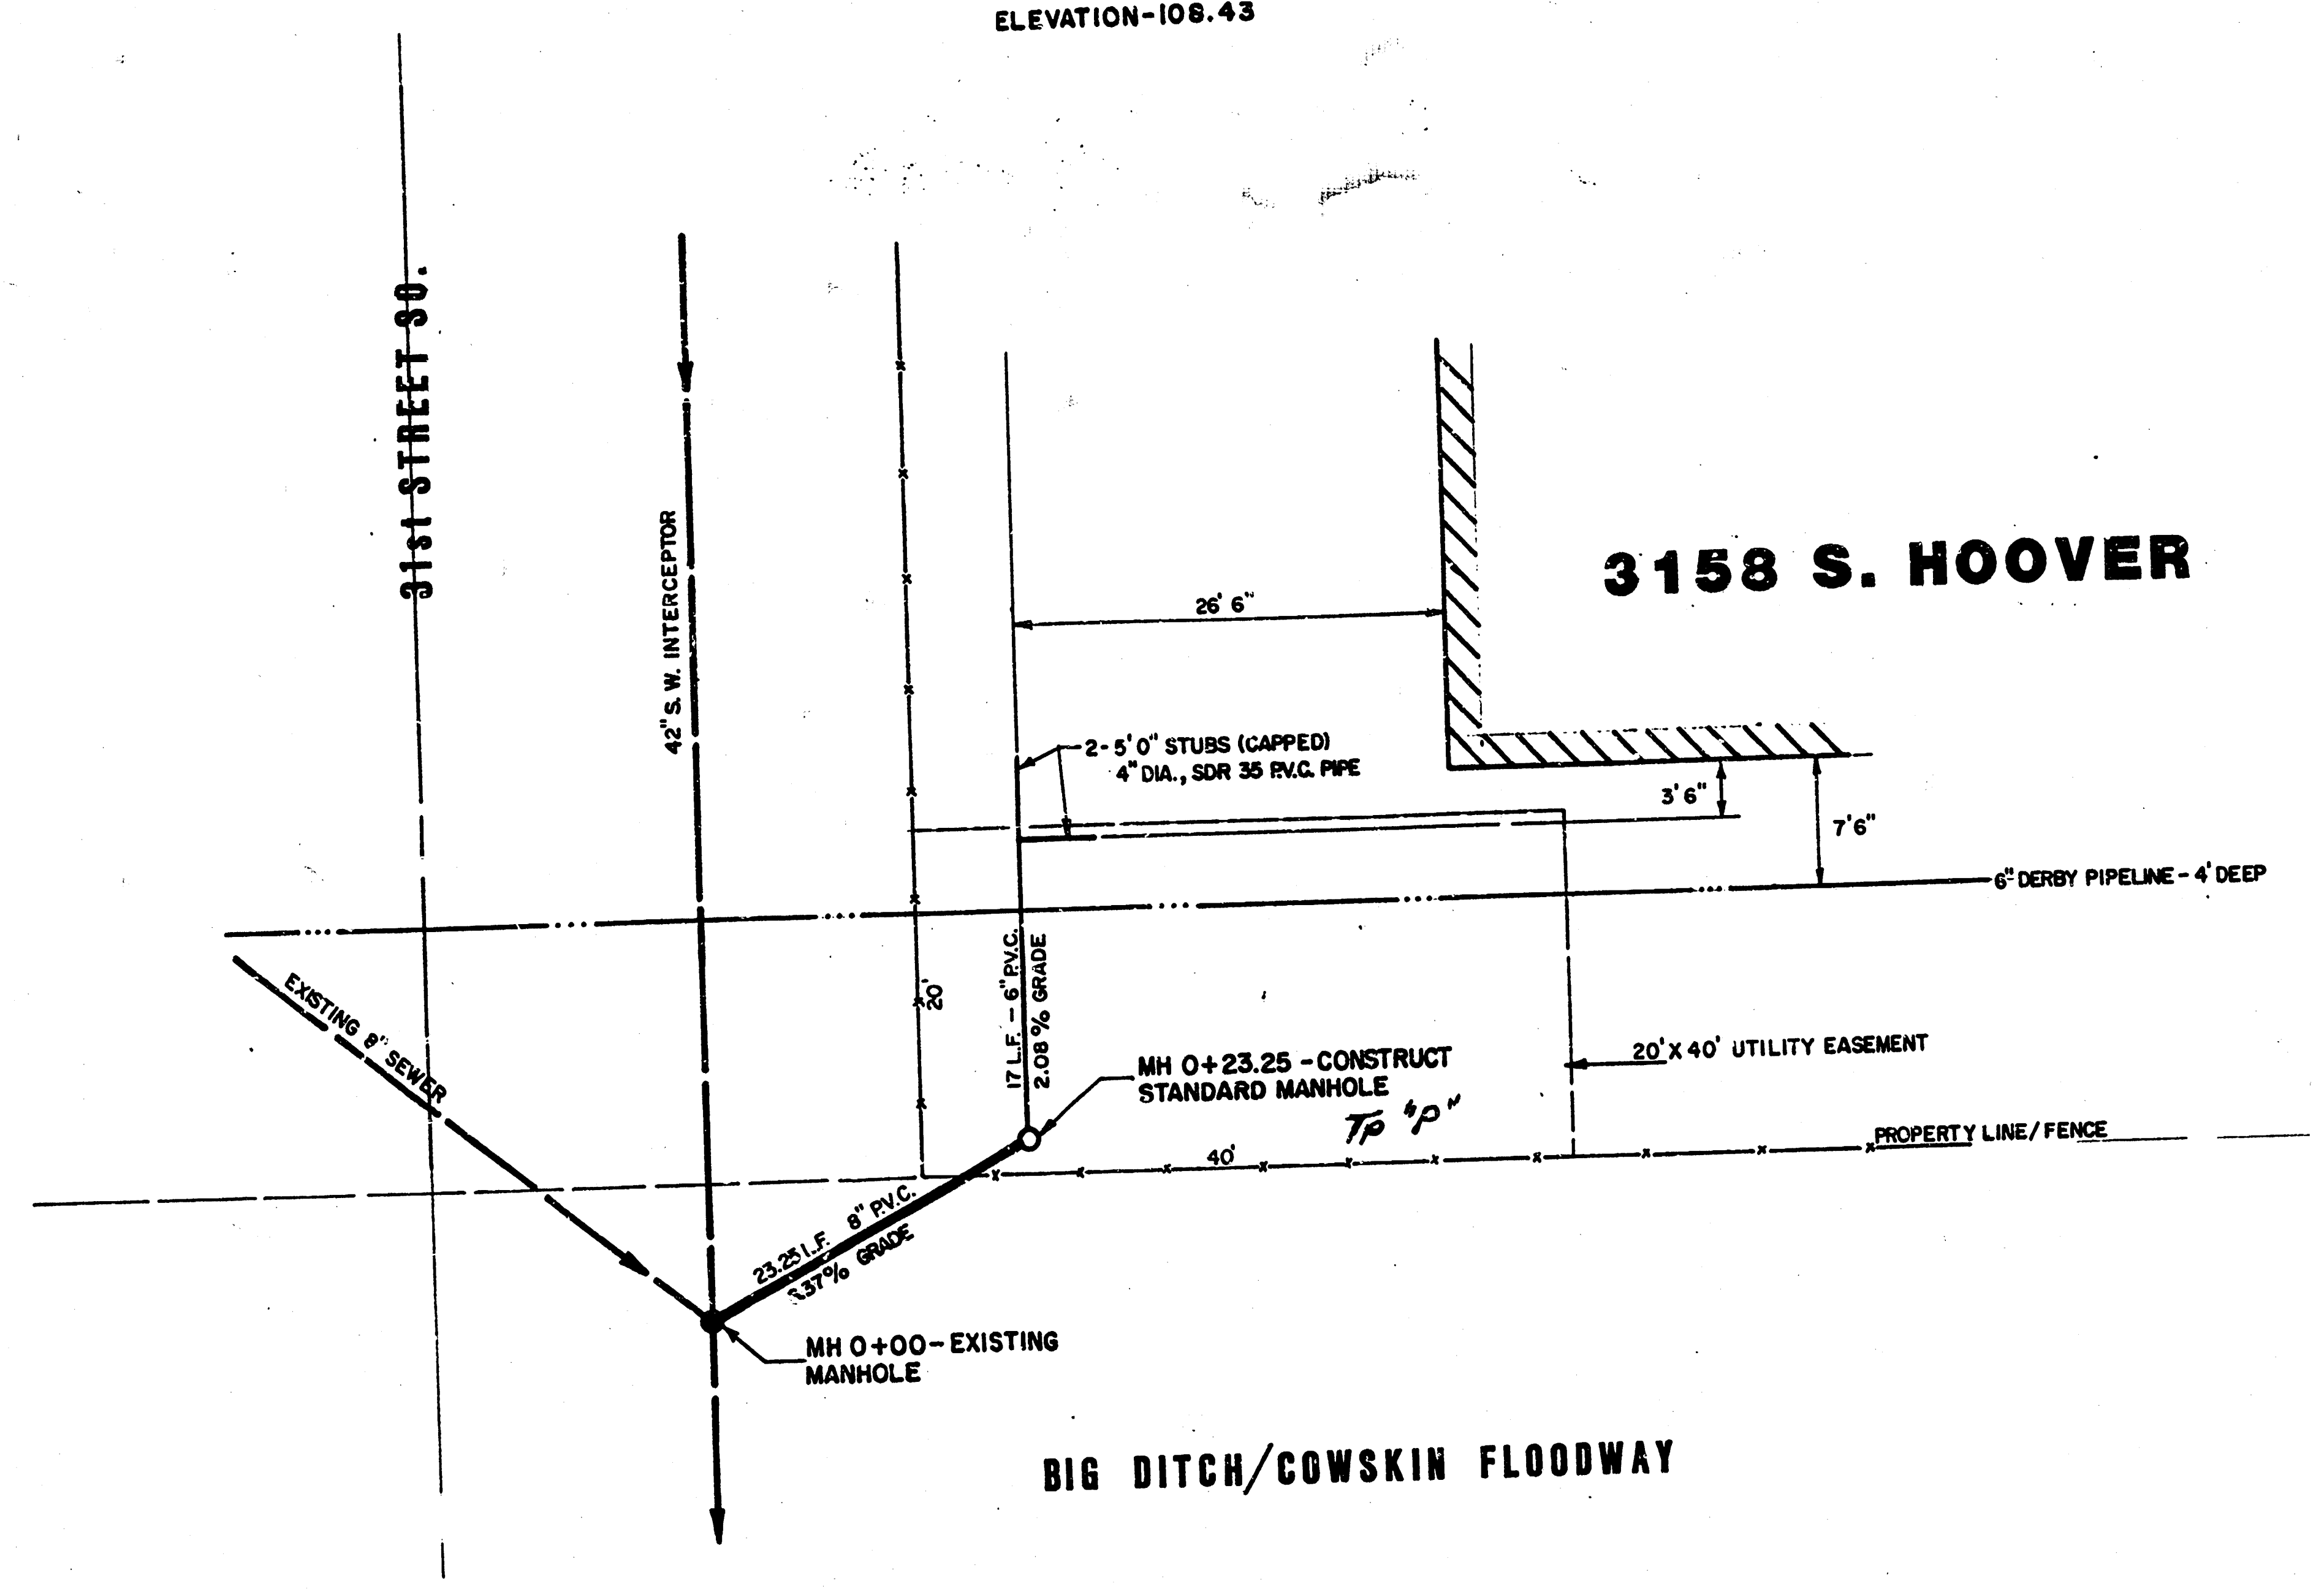
31st STREET SO.
42" S.W. INTERCEPTOR
3158 S. HOOVER
26' 6"
2-5'0" STUBS (CAPPED)
4" DIA., SDR 35 P.V.C. PIPE
3' 6"
7'6"
6" DERBY PIPELINE - 4' DEEP
EXISTING 8" SEWER
20'
17 L.F. - 6" P.V.C.
2.08% GRADE
MH 0+23.25 - CONSTRUCT
STANDARD MANHOLE
TP "P"
20' X 40' UTILITY EASEMENT
PROPERTY LINE/FENCE
40'
23.25 L.F. 8" P.V.C.
6.37% GRADE
MH 0+00 - EXISTING
MANHOLE
BIG DITCH/COWSKIN FLOODWAY

N

SCALE
PLAN 1" = 10'
PROFILE
VERT. 1" = 4'
HORZ. 1" = 10'

CITY OF WICHITA

PRIVATE PROJECT NO. 209PPS

MAY 1989

AS CONSTRUCTED

ALL PIPE IS P.V.C. - S.D.R. 35

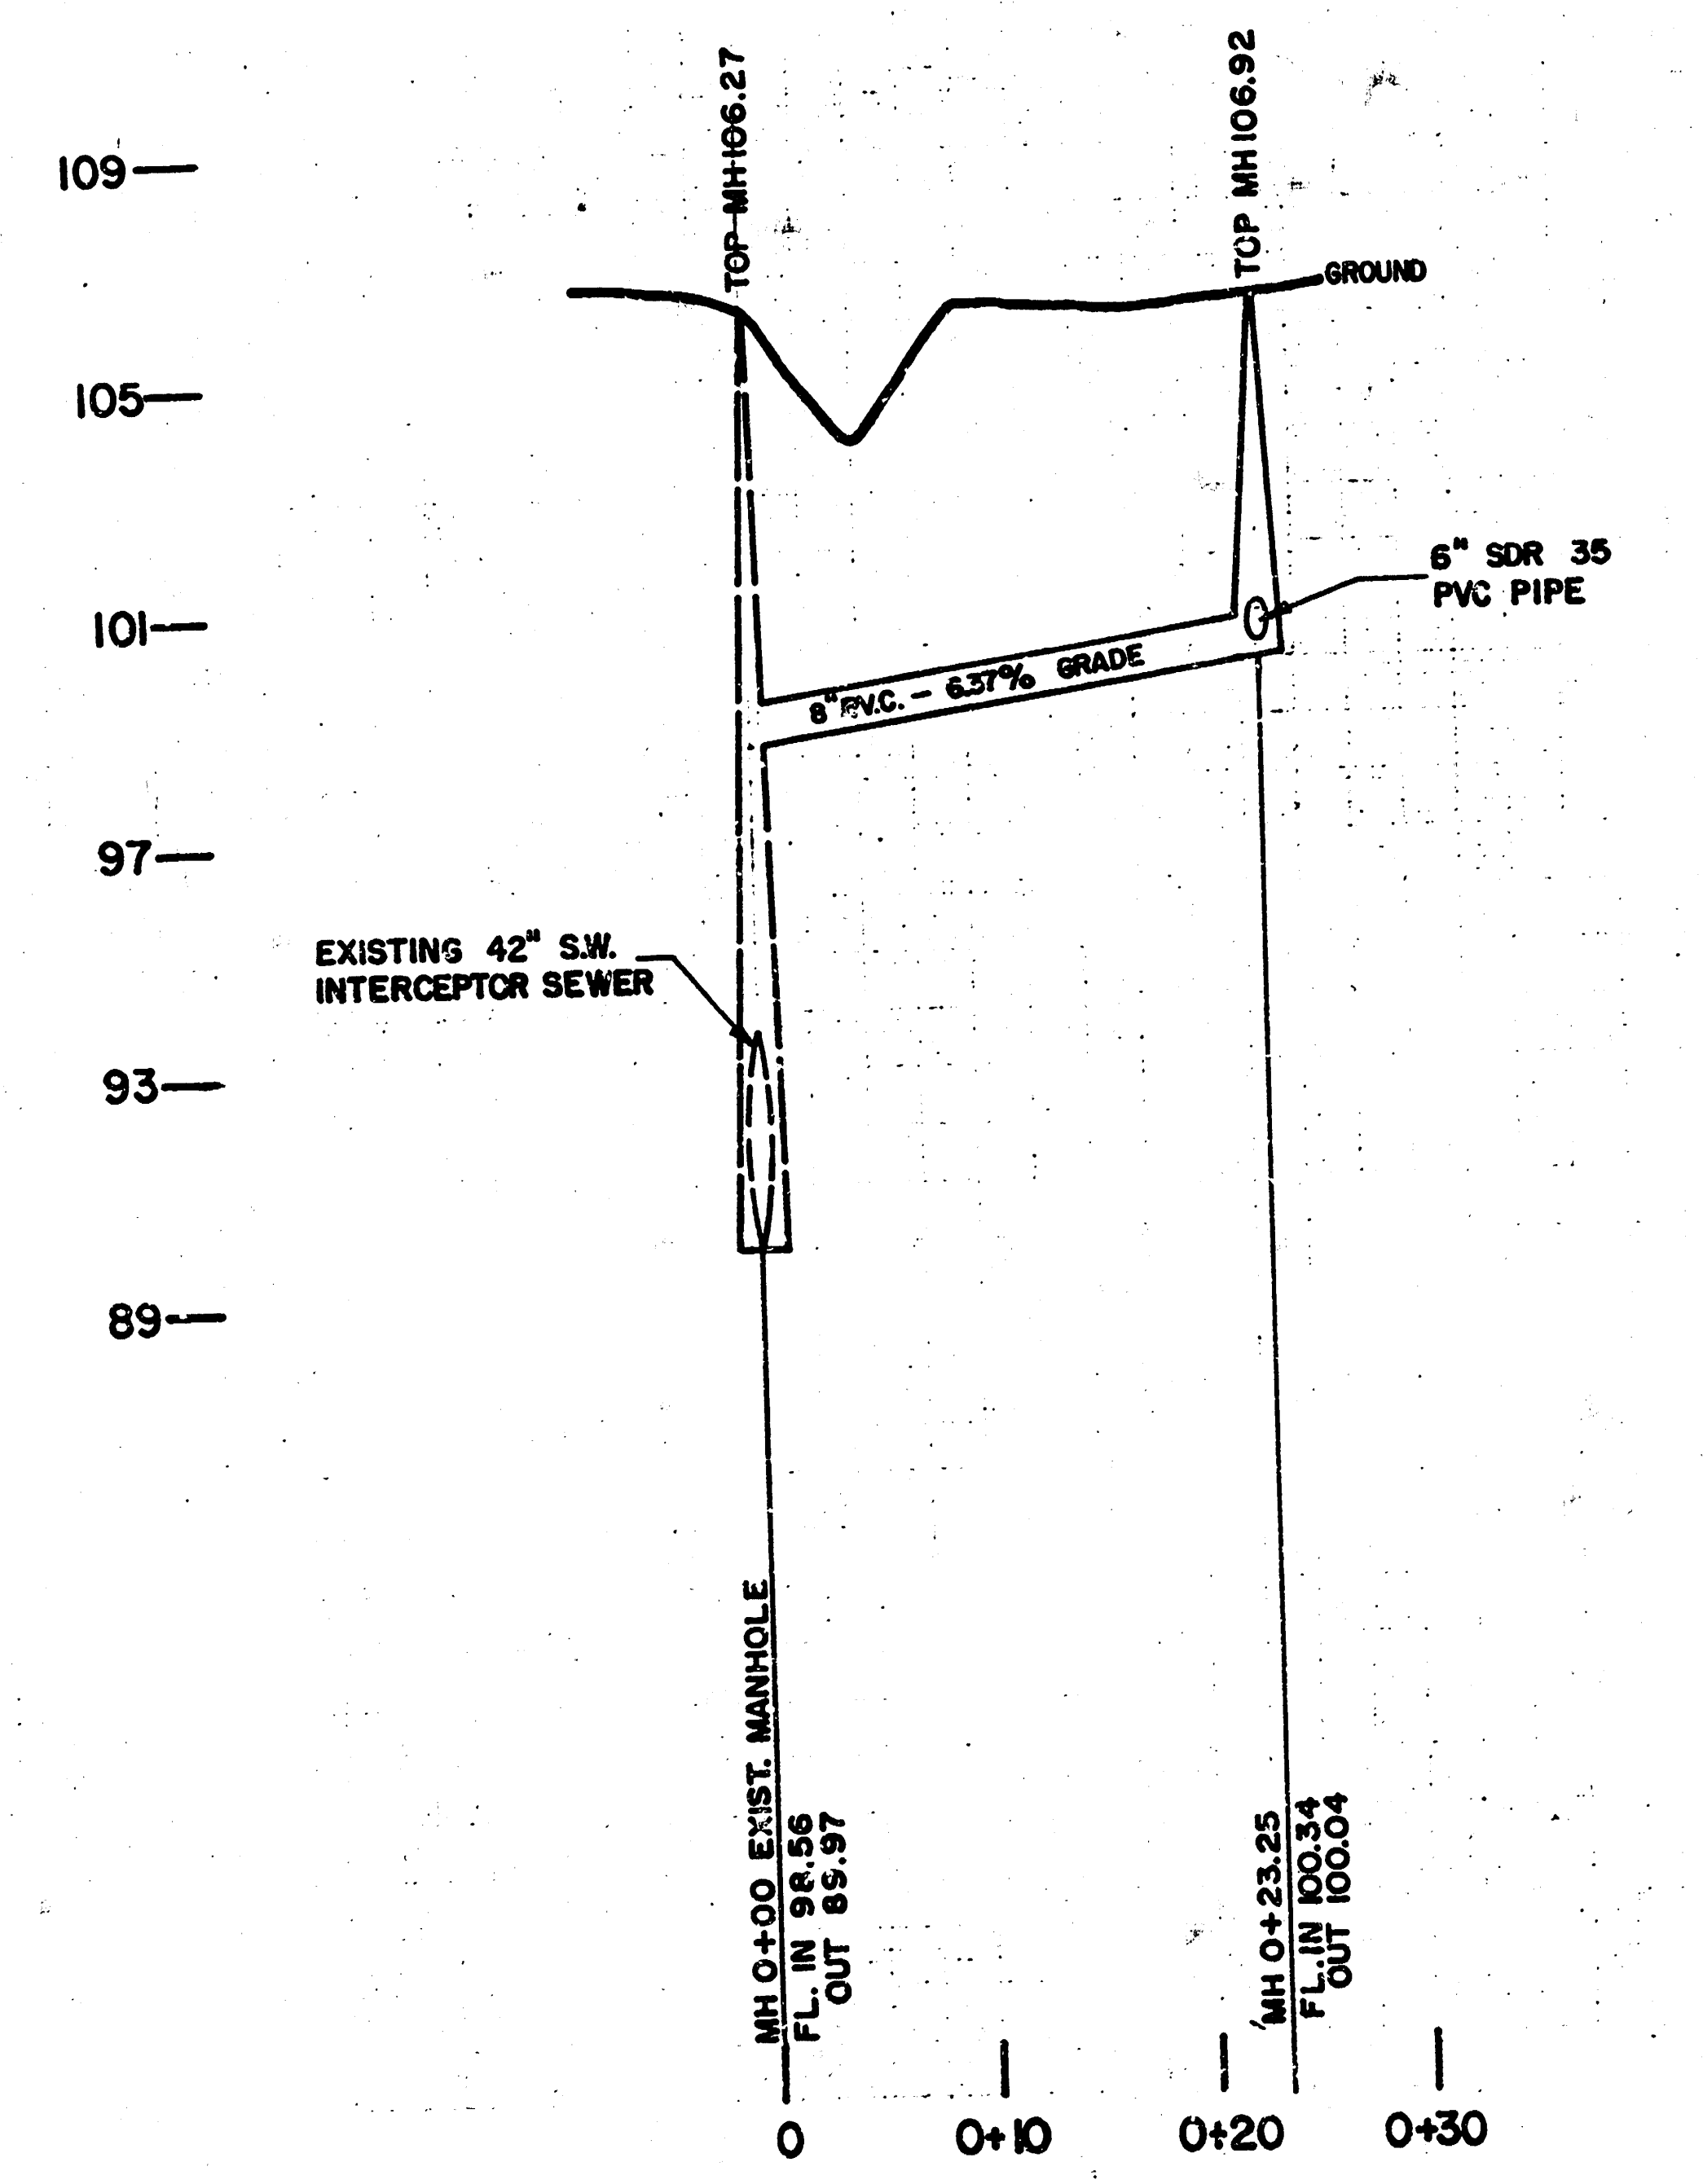
109
105
101
97
93
89
TOP-MH106.27
TOP MH106.92
GROUND
6" SDR 35
PVC PIPE
8" P.V.C. - 6.37% GRADE
EXISTING 42" S.W.
INTERCEPTOR SEWER
MH 0+00 EXIST. MANHOLE
FL. IN 98.56
OUT 85.97
MH 0+23.25
FL. IN 100.34
OUT 100.04
0
0+10
0+20
0+30

ADOLF E. REISS

REISS & GOODNESS ENGINEERS
2160 WEST 21st STREET
WICHITA, KANSAS 67204
(316) 832-0213

1/2

REVISION	DRAWN BY DM 5-9-89	CHECKED BY B.P.	DESIGNED BY D.C.	PROJECT	**POLLUTION CONTROL PROJECT**	CUSTOMER	**QUALITY MANUFACTURERS, INC.**	SCALE GIVEN DATE 4-10-89	PROJECT NO. MS 1288 SHEET 1 OF 1

7

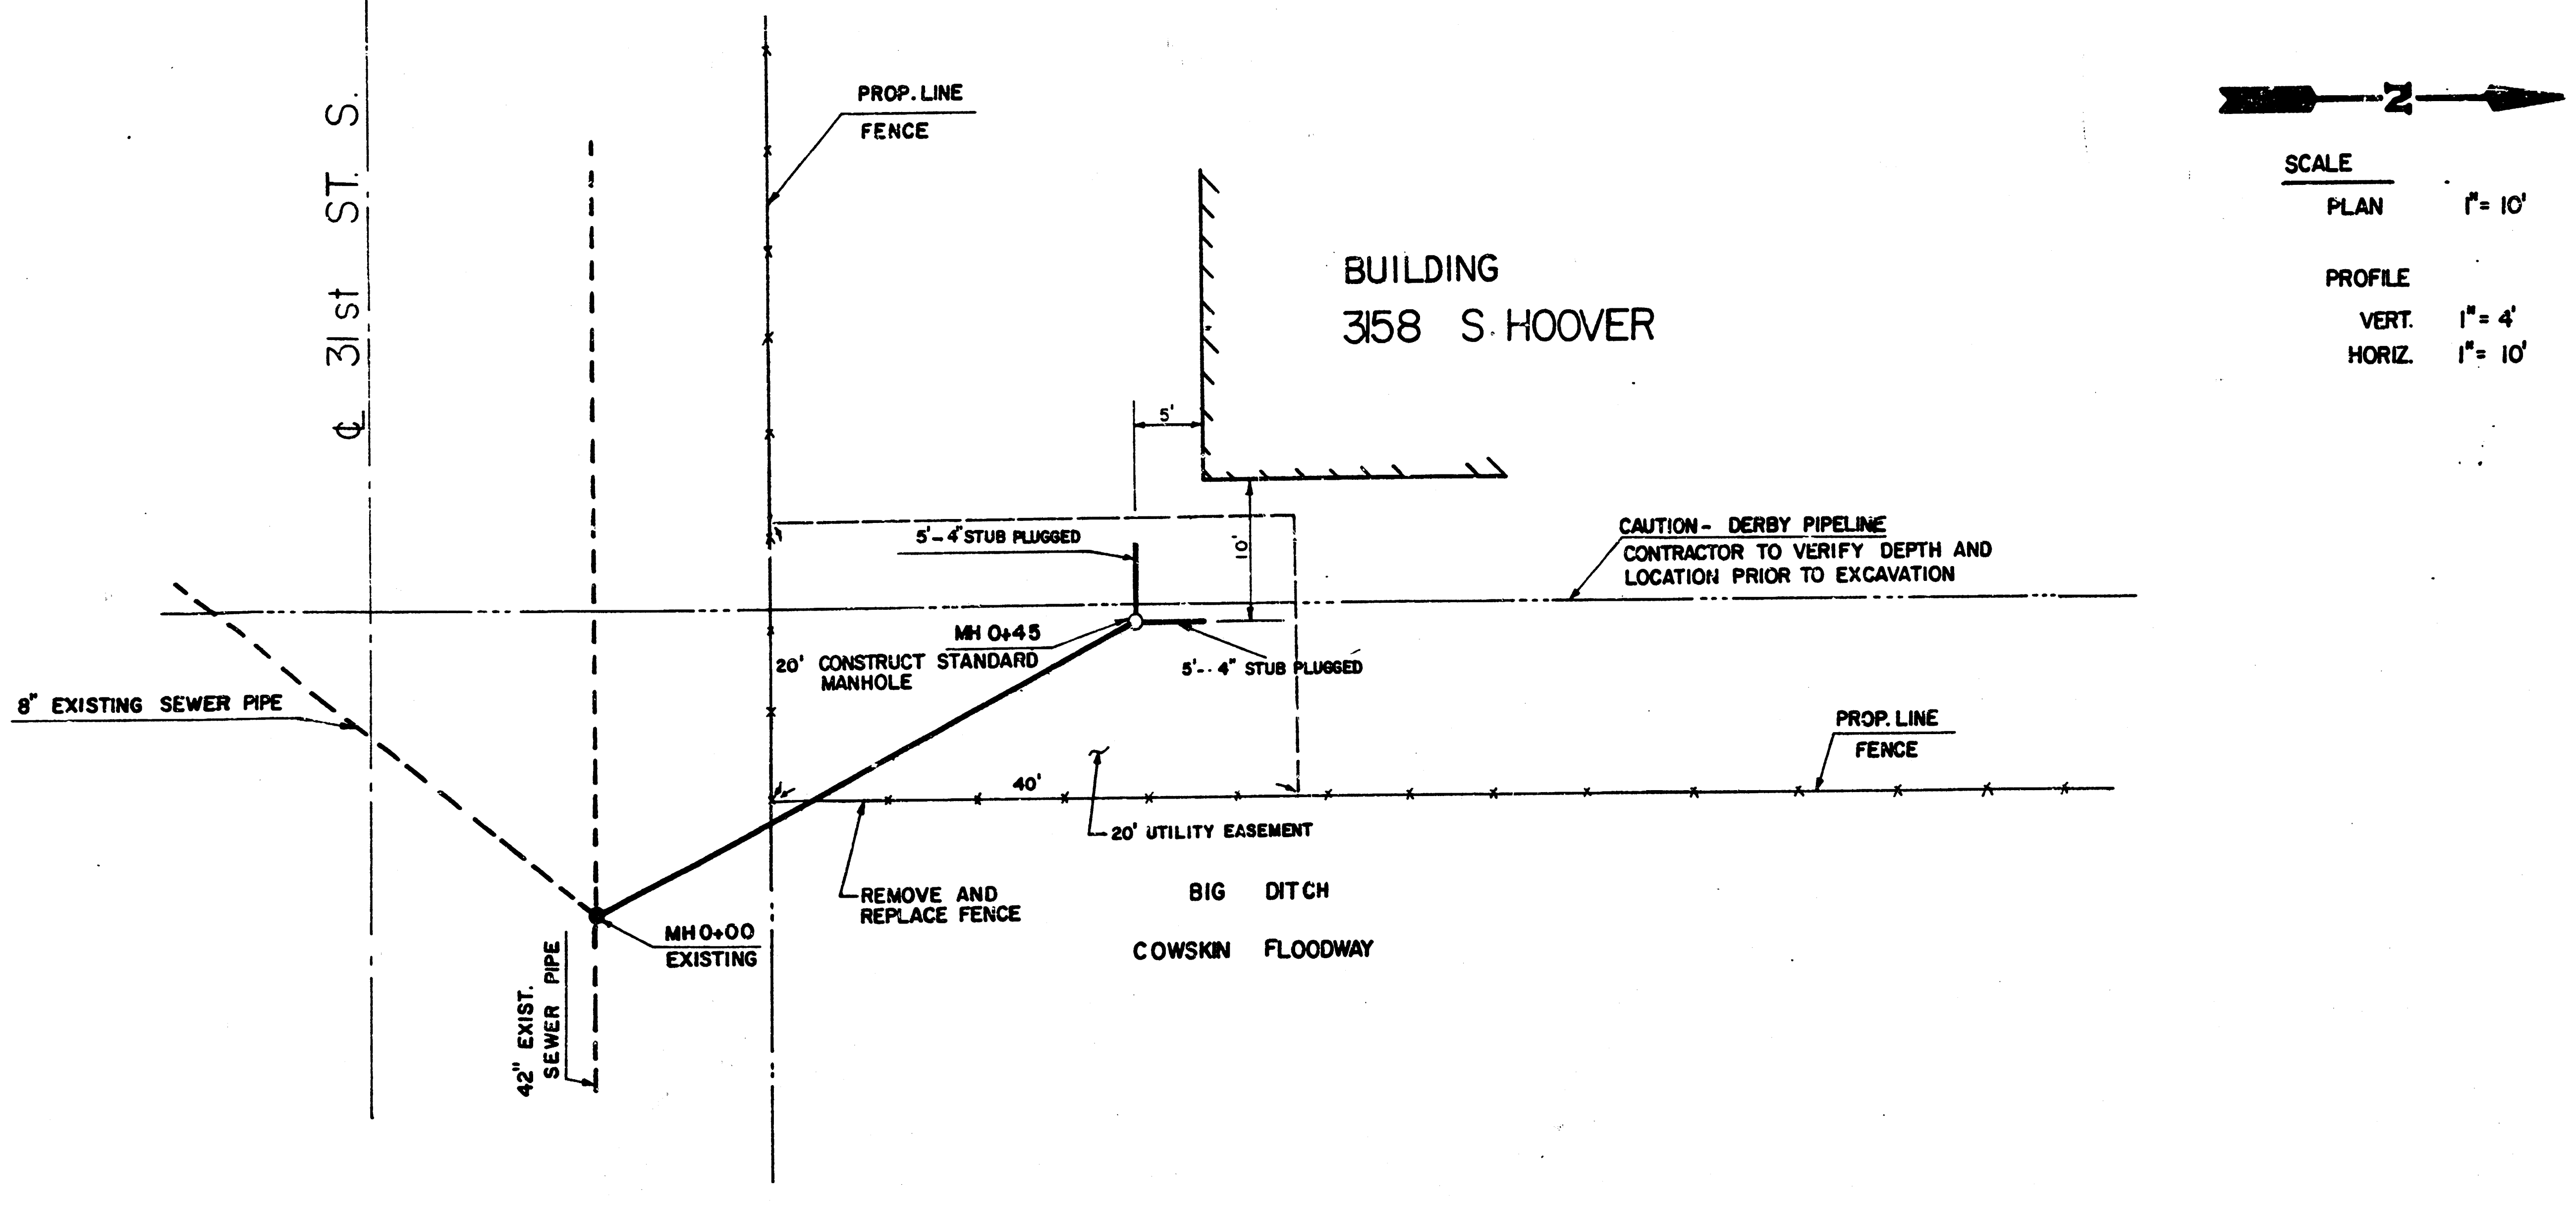

℄ 31st ST. S.
PROP. LINE
FENCE
BUILDING
3158 S. HOOVER
5'
10'
5'-4" STUB PLUGGED
CAUTION - DERBY PIPELINE
CONTRACTOR TO VERIFY DEPTH AND
LOCATION PRIOR TO EXCAVATION
MH 0+45
20' CONSTRUCT STANDARD MANHOLE
5'-4" STUB PLUGGED
8" EXISTING SEWER PIPE
PROP. LINE
FENCE
40'
20' UTILITY EASEMENT
REMOVE AND REPLACE FENCE
BIG DITCH
COWSKIN FLOODWAY
MH 0+00
EXISTING
42" EXIST. SEWER PIPE
N
SCALE
PLAN 1"= 10'
PROFILE
VERT. 1"= 4'
HORIZ. 1"= 10'

BM. CITY DISK 44' EAST & 32' NORTH OF
℄ OF HOOVER & 31st ST. S.- ELEV. 108.43

CITY OF WICHITA
PRIVATE PROJ. NO. 209PPS
APRIL 1989

NOTE TO CONTRACTOR

INSPECTION AND TESTING FOR THIS PROJECT IS TO BE PRO[illegible] BY A LICENSED CONSULTING ENGINEERING FIRM [illegible] CONTRACT WITH THE OWNER/DEVELOPER. SAID [illegible] IN ACCORDANCE WITH THE CITY OF WICH[illegible] [illegible] ENGINEERING PRACTICES [illegible] [illegible] ENGINEER. [illegible] [illegible] RIGHT-OF-WAY WITHOUT WRITTEN AUTHORIZATION [illegible] CITY ENGINEER.

APPROVED AS NOTED
By CITY ENGINEER OF WICHITA

Sanitary Sewers VRH 4/13/89
Storm S[illegible] ____
D[illegible] ____
[illegible] ____

(ALL PIPE IS 8" PVC. SDR-35.)

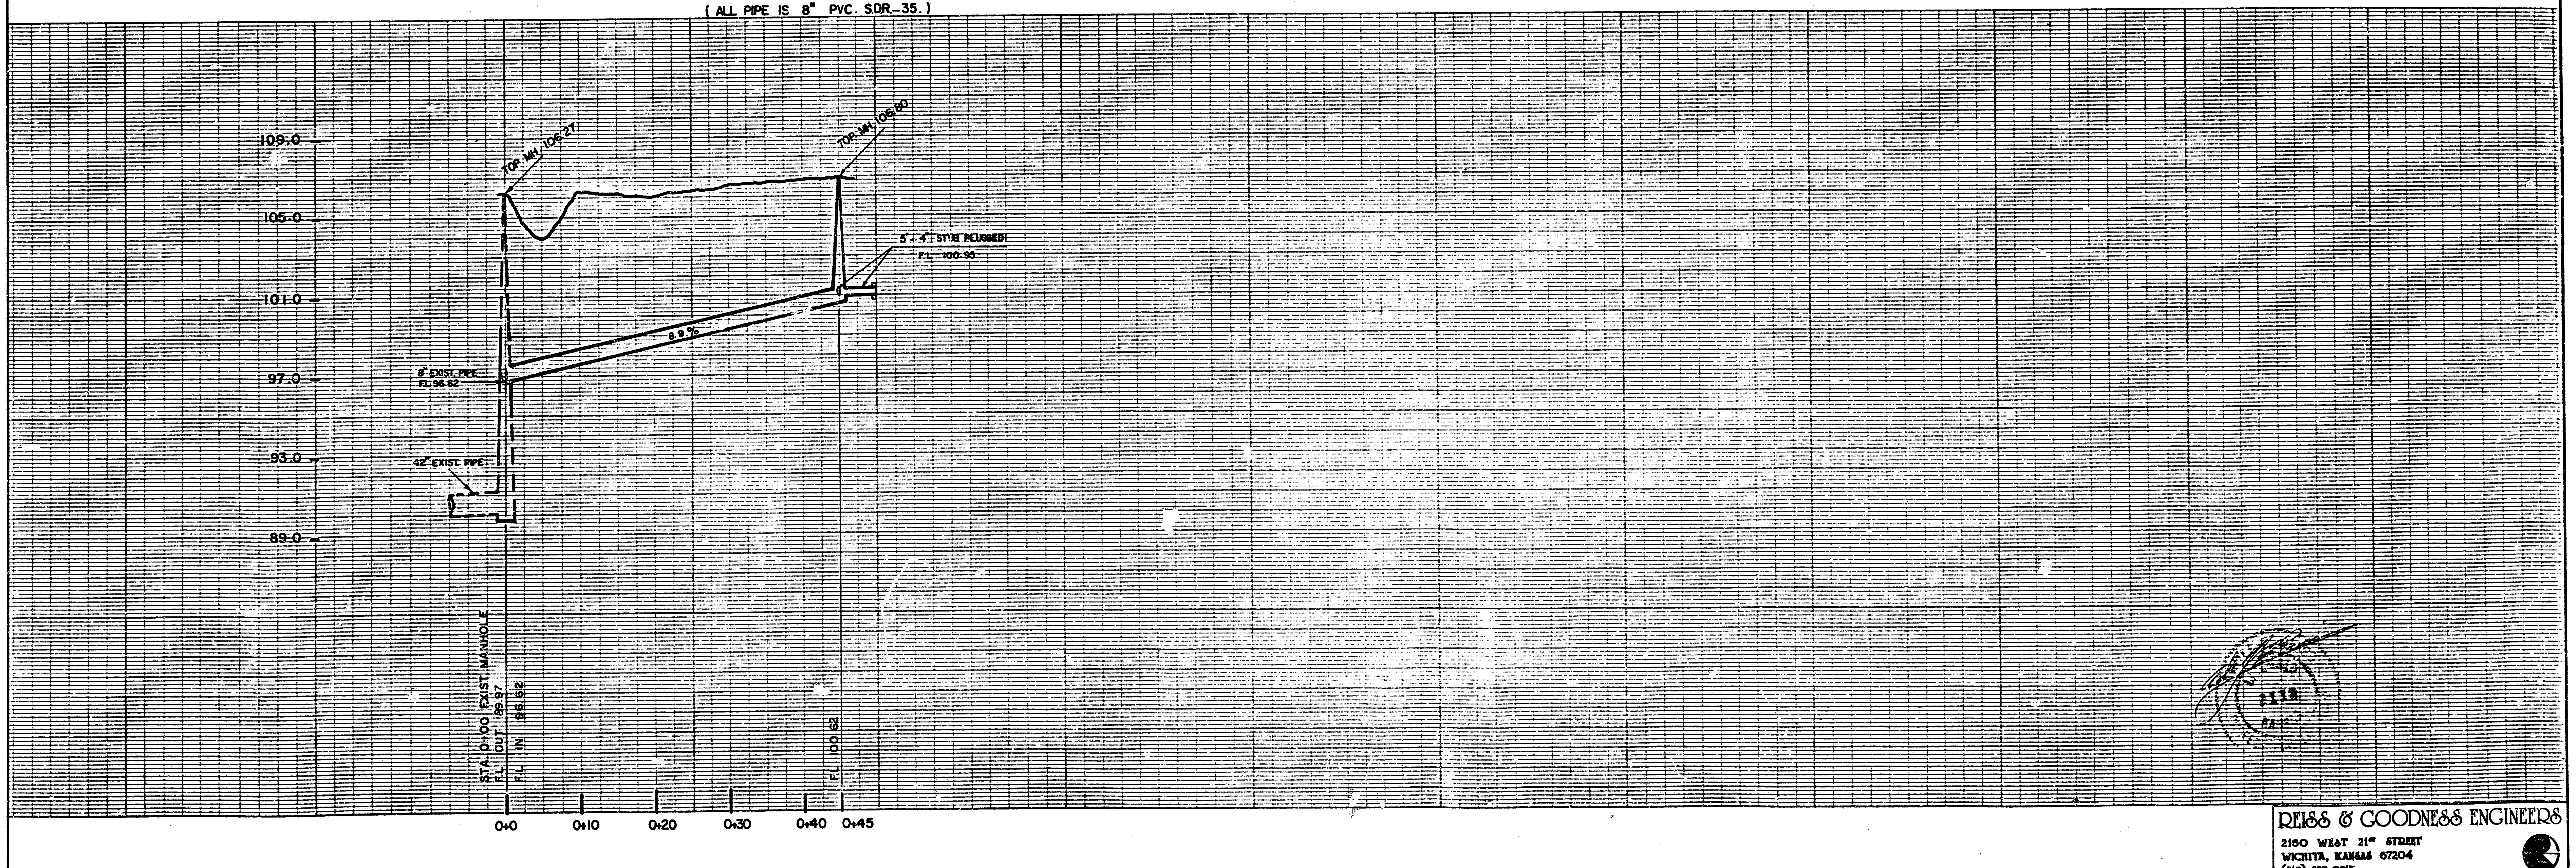

109.0
105.0
101.0
97.0
93.0
89.0
TOP MH 106.27
TOP MH 106.80
5'-4" STUB PLUGGED
F.L. 100.90
0.9%
8" EXIST. PIPE
F.L. 96.62
42" EXIST. PIPE
STA. 0+00 EXIST. MANHOLE
F.L. OUT 99.97
F.L. IN 96.62
F.L. 100.62
0+0
0+10
0+20
0+30
0+40
0+45

REISS & GOODNESS ENGINEERS
2160 WEST 21st STREET
WICHITA, KANSAS 67204
(316) 832-0213

REVISION	DRAWN BY	CHECKED BY	DESIGNED BY	PROJECT	CUSTOMER	SCALE	PROJECT NO.
	Rocky	B.P	D.C	**POLLUTION CONTROL PROJECT**	**QUALITY MANUFACTURERS, INC.**	GIVEN	MS 1288
						DATE 4-10-89	SHEET 1 OF 1

2/2