


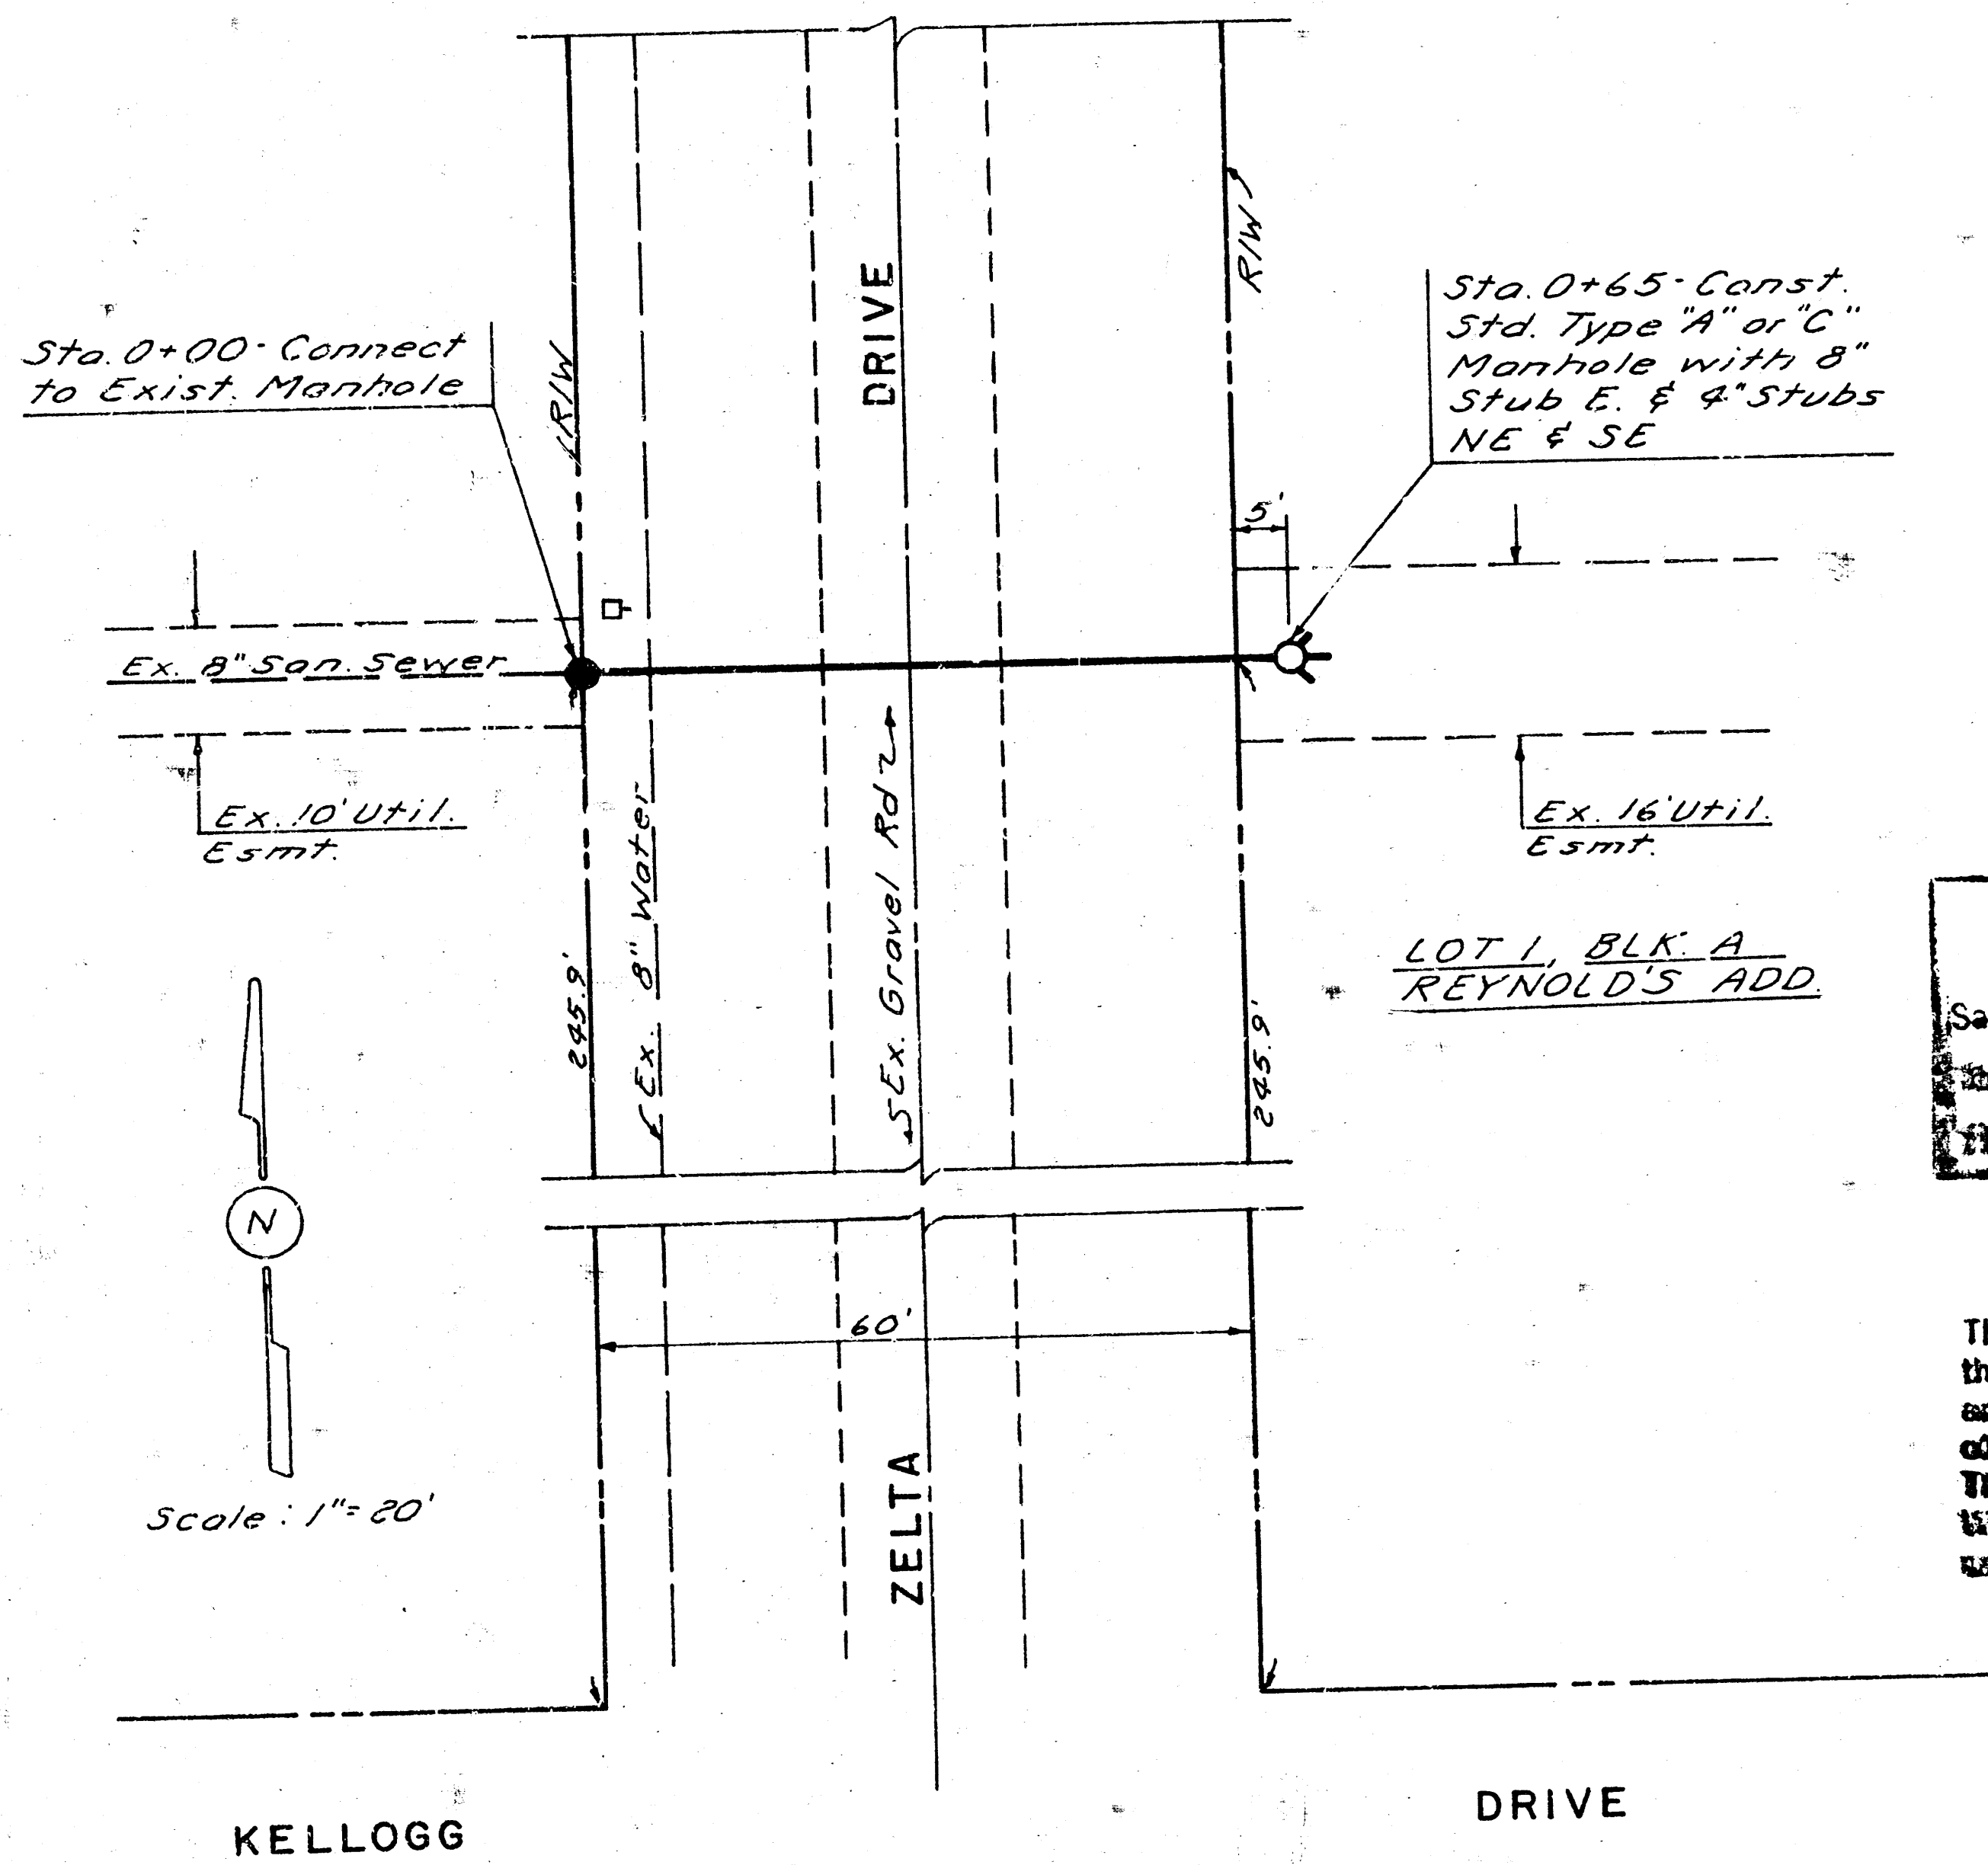

7-5-77

APPROVED AS NOTED
By CITY ENGINEER OF WICHITA

Sanitary Sewers D.E.S.


Storm Sewers _____

Highway Approaches _____

NOTE TO CONTRACTOR

This project will be constructed under the supervision of the CITY ENGINEER and conforming to the SPECIFICATIONS of the CITY OF WICHITA. The CONTRACTOR will reimburse the City of Wichita for all cost of Engineering, Plans, and Inspection.

BM - City disc 75' W. & 6' N. E
Zelta & Kellogg - El. 174.70

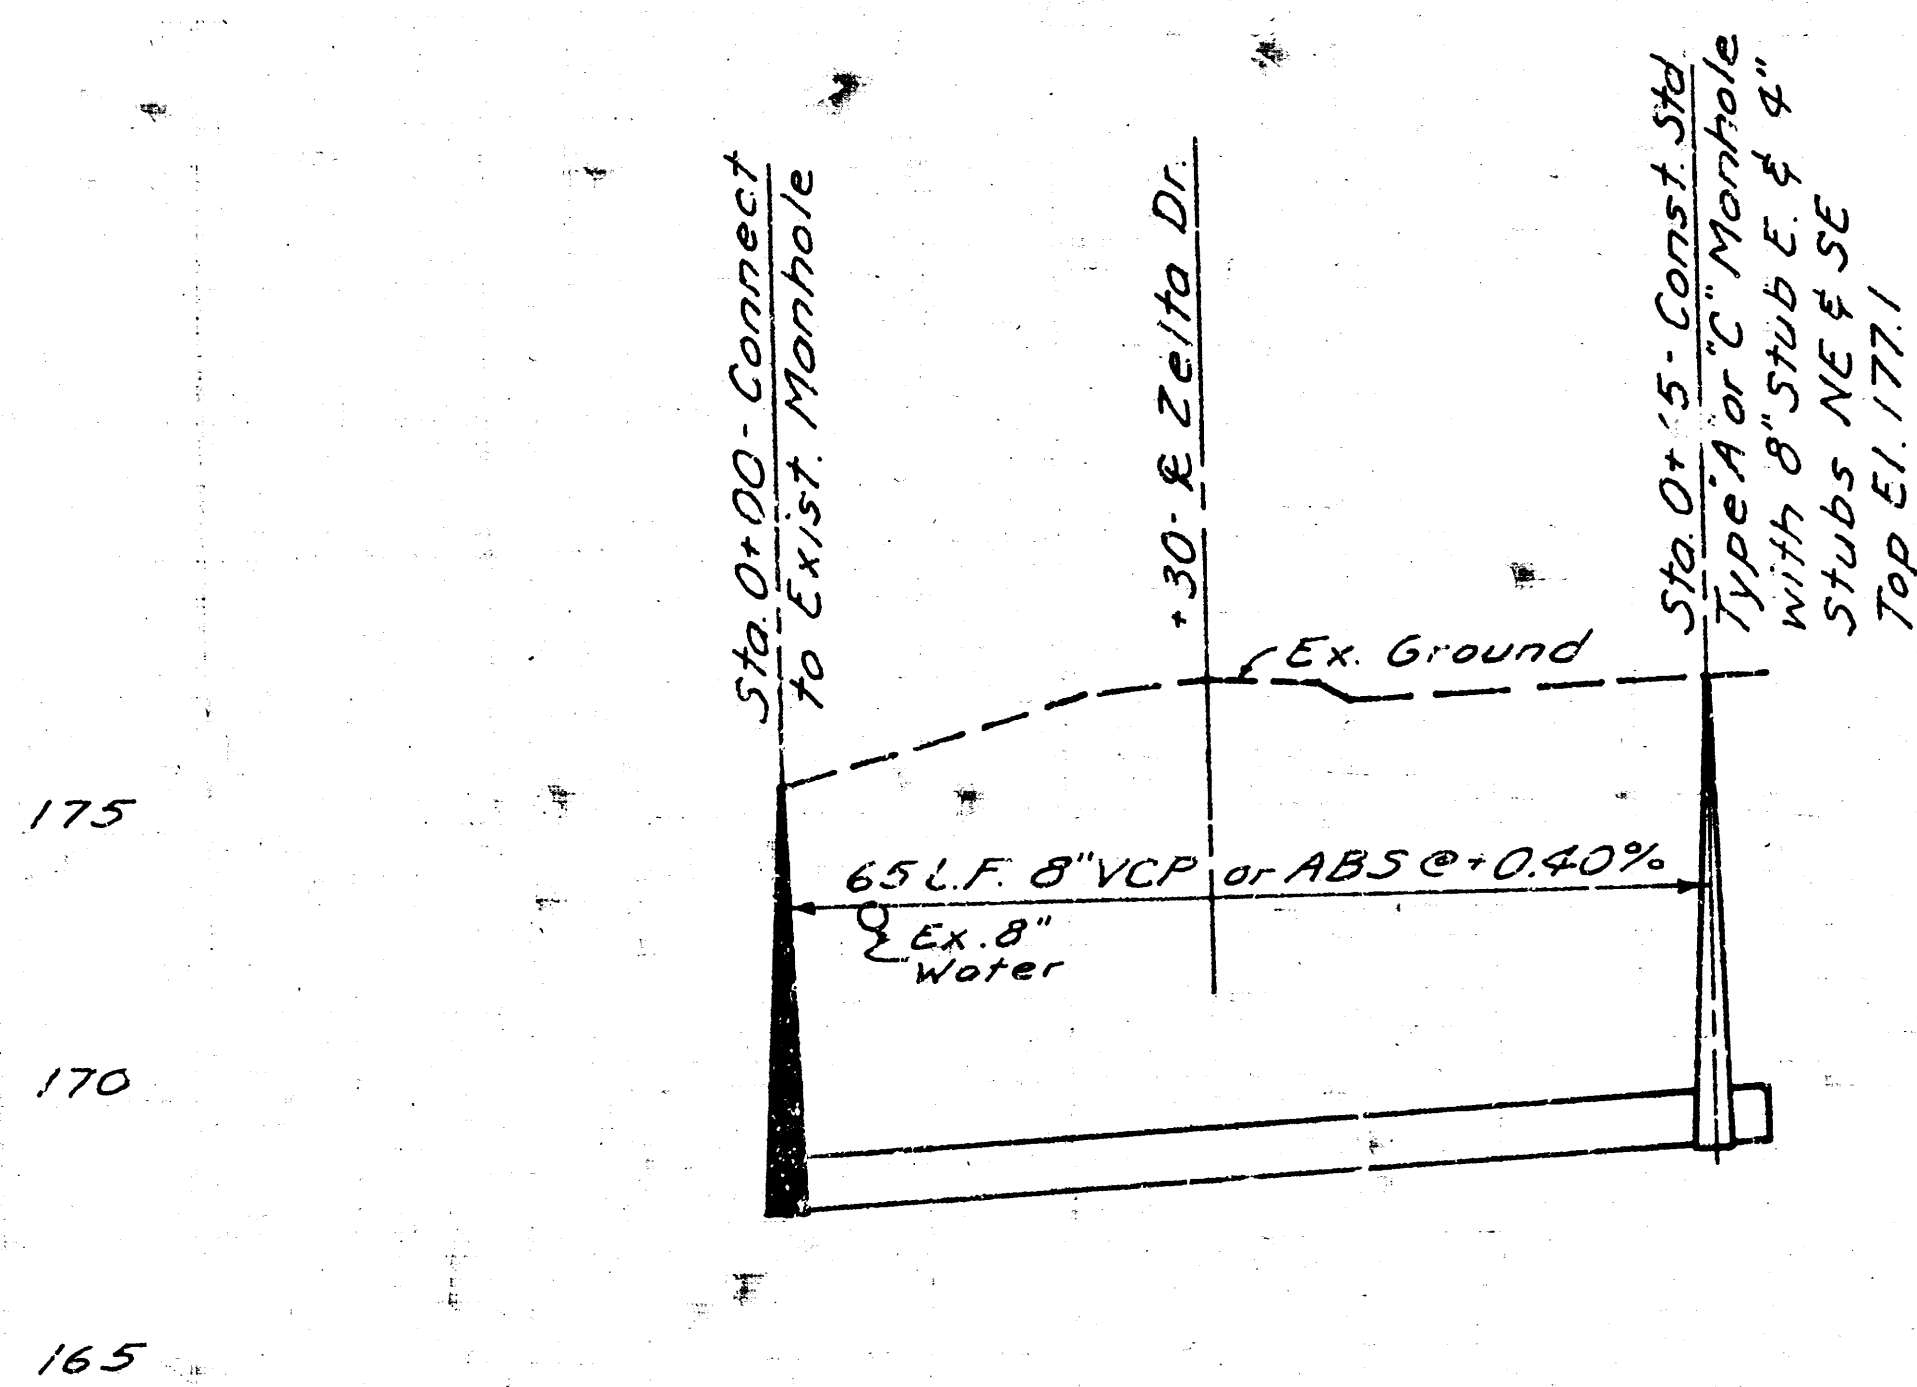

0 RE out 167.57
RE in 167.67

+25 RE 167.77

+50 RE 167.87

RE out 167.93
RE in 167.93 (L)
RE in 168.26 (NE & SE)

CITY PROJ. NO. DBKW 707031
SANITARY SEWER EXTENSION
TO SERVE LOT 1, BLOCK "A"
REYNOLDS'S ADDITION