


B.M. 141.103 City st. disc. 52' S. + 32' W.
of E. of Woodchuck + Maple

B.M. 139.92 Chiseled "D" on top of curb-
west side of Holland St. opposite
E. of 1st St.

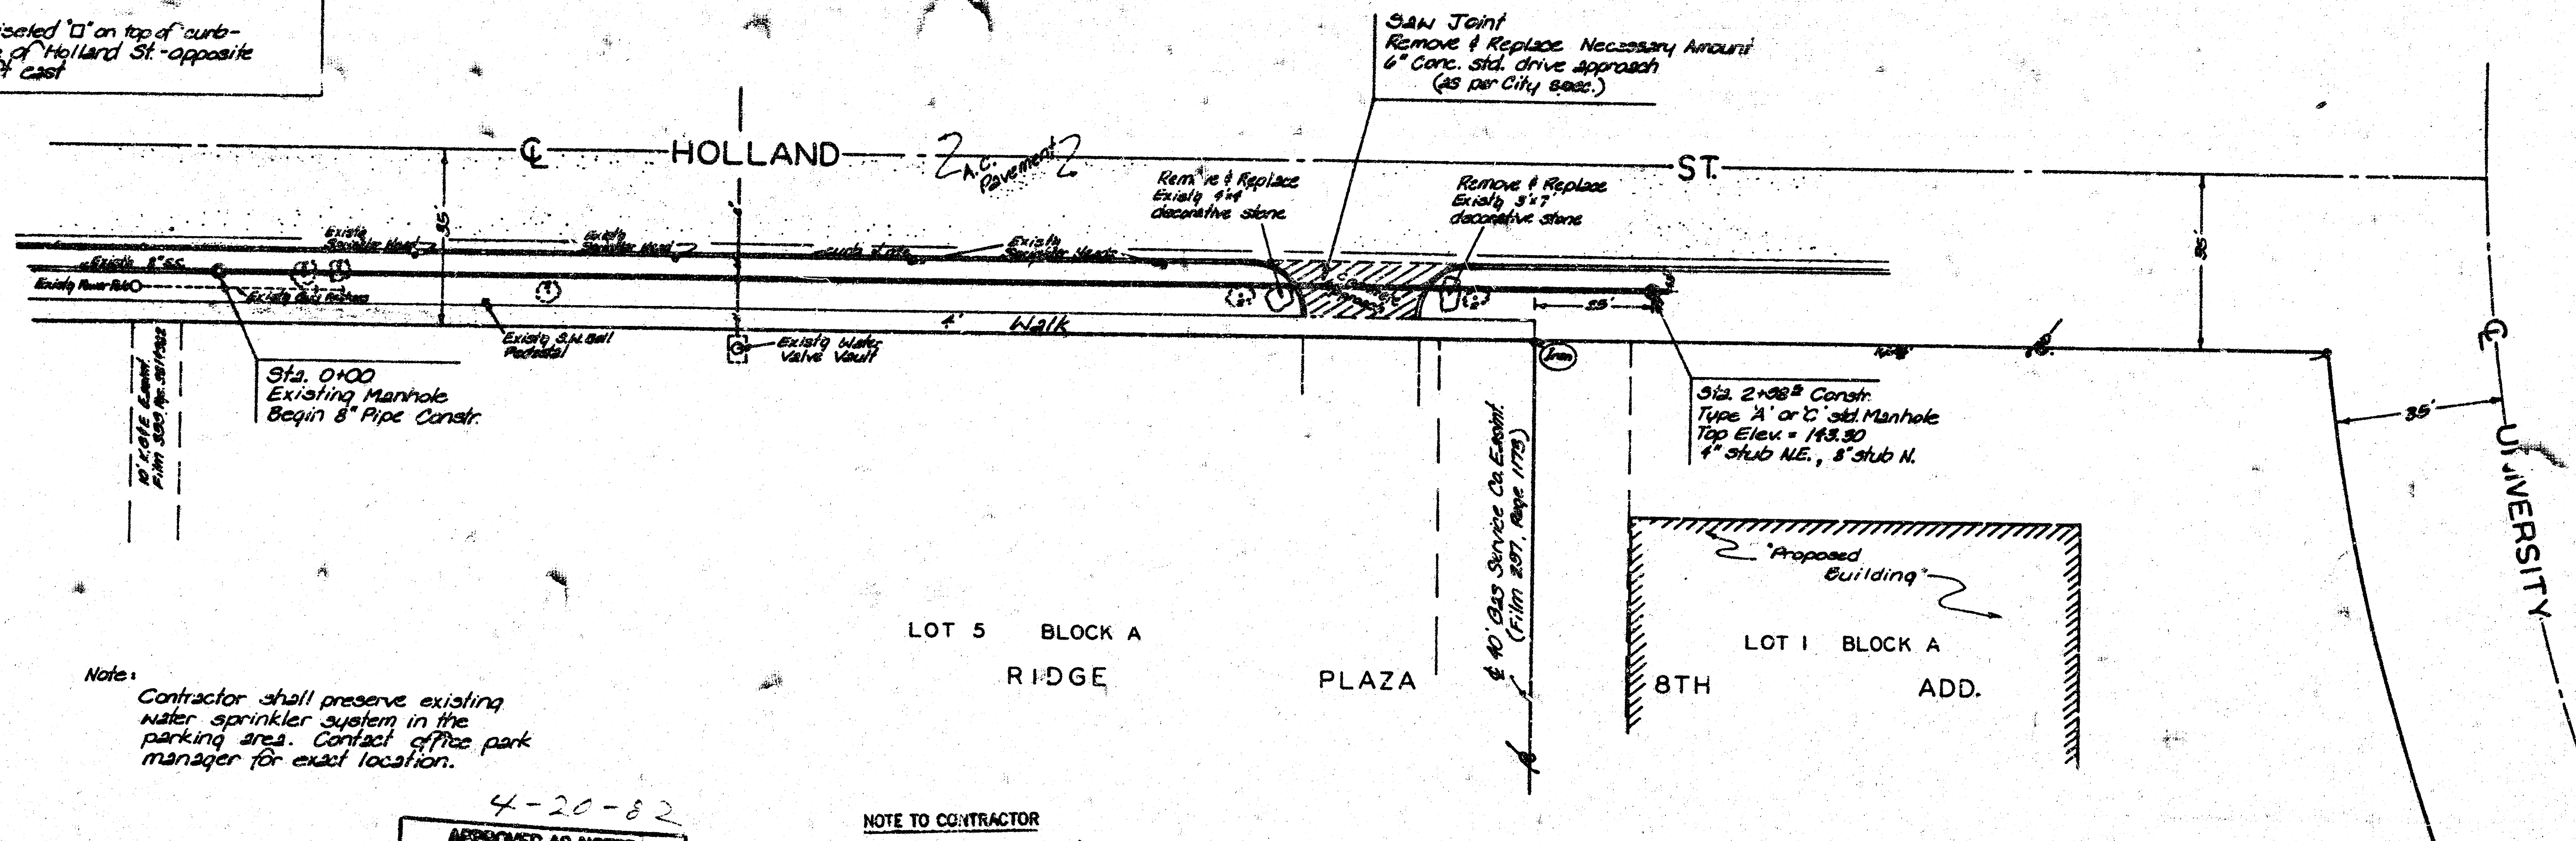

Note: Contractor shall preserve existing water sprinkler system in the parking area. Contact office park manager for exact location.

4-20-82

APPROVED AS NOTED
By CITY ENGINEER OF WICHITA


Sanitary Sewers 2.5.2

Storm Sewers _____

Driveway Approaches _____

NOTE TO CONTRACTOR

This project will be constructed under the supervision of the CITY ENGINEER and conforming to the SPECIFICATIONS of the CITY OF WICHITA. The CONTRACTOR will prepay the City of Wichita for all costs of inspection.

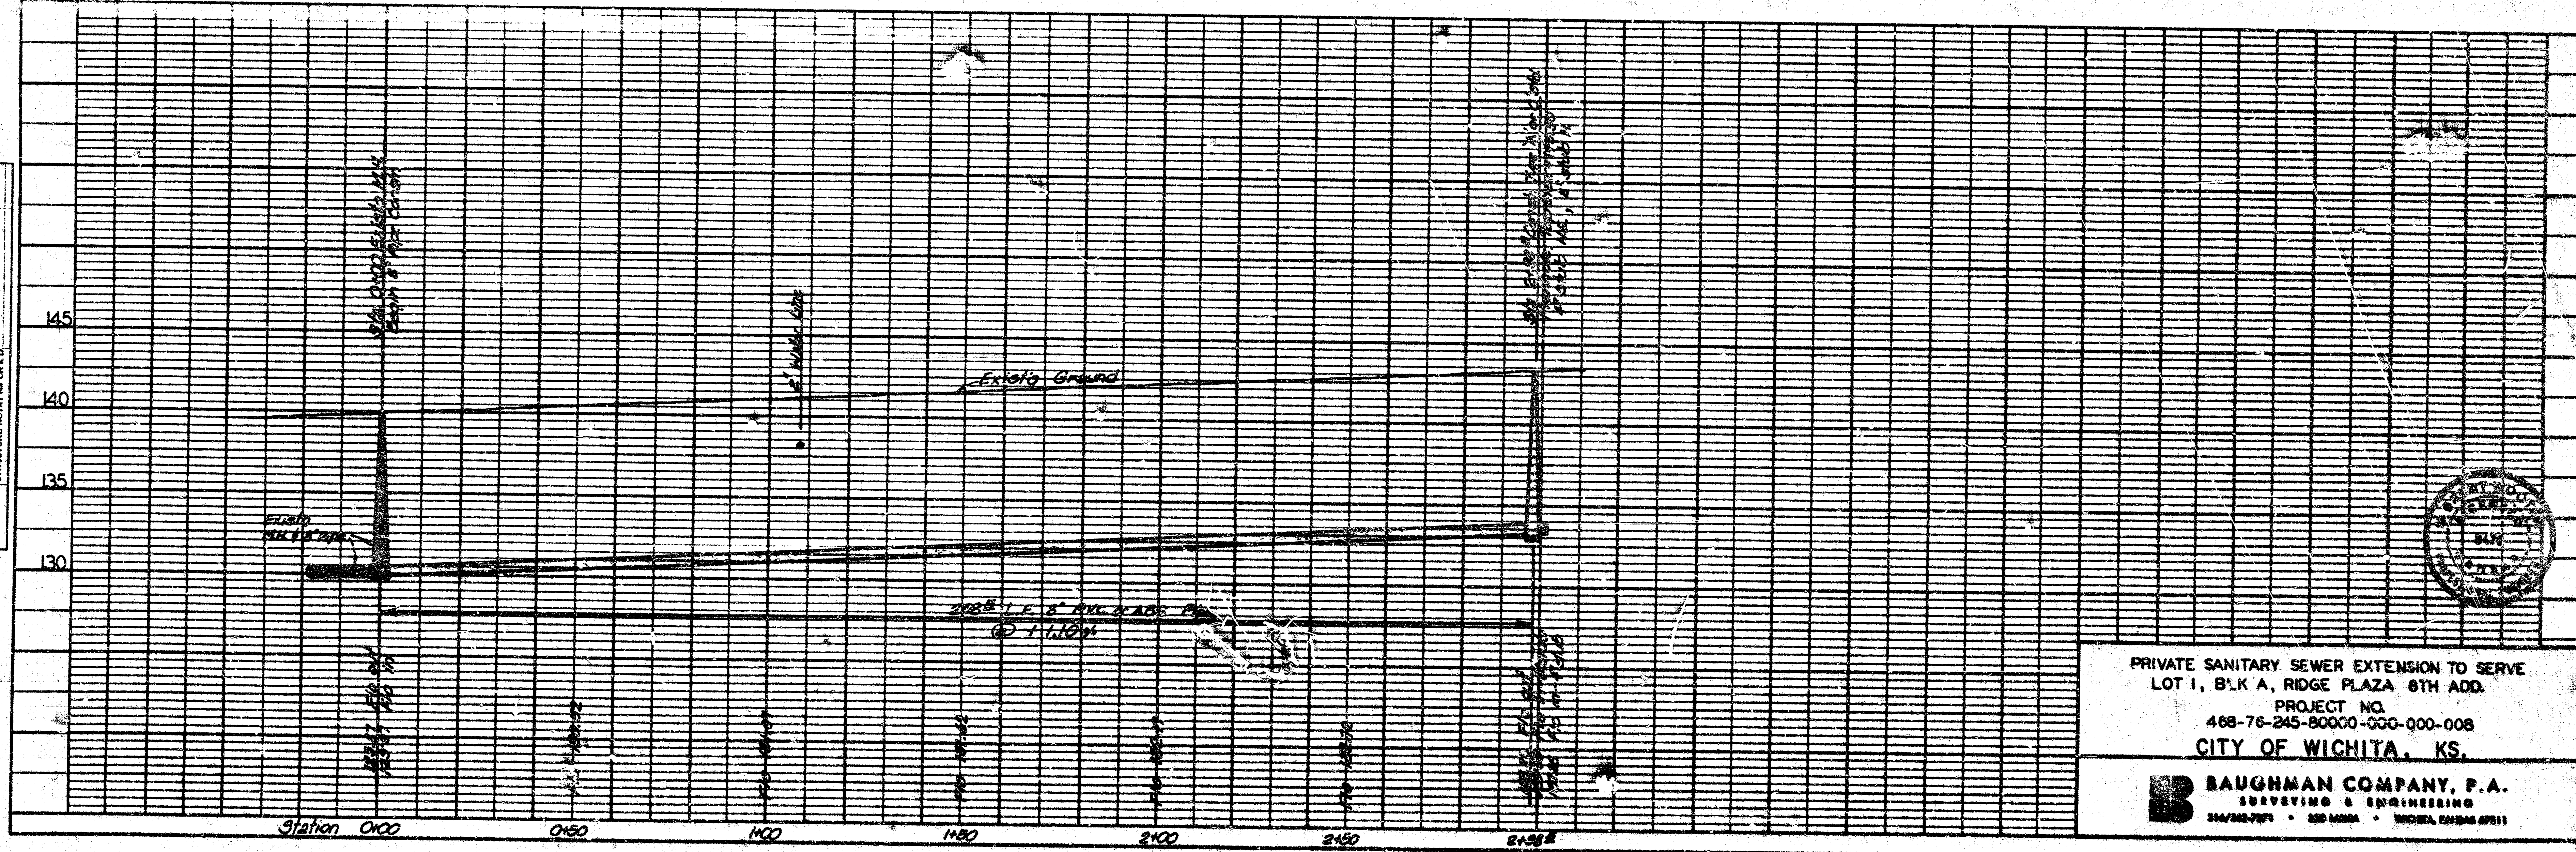

PRIVATE SANITARY SEWER EXTENSION TO SERVE
LOT 1, B'K A, RIDGE PLAZA 8TH ADD.

PROJECT NO.
468-76-245-80000-000-000-008

CITY OF WICHITA, KS.

BAUGHMAN COMPANY, P.A.
SURVEYING & ENGINEERING
314/282-7071 • 220 N. MAIN • WICHITA, KANSAS 67201

10 3 3 15