




PLAT 10-78
D. S. RULLEY
11-18
200 WS

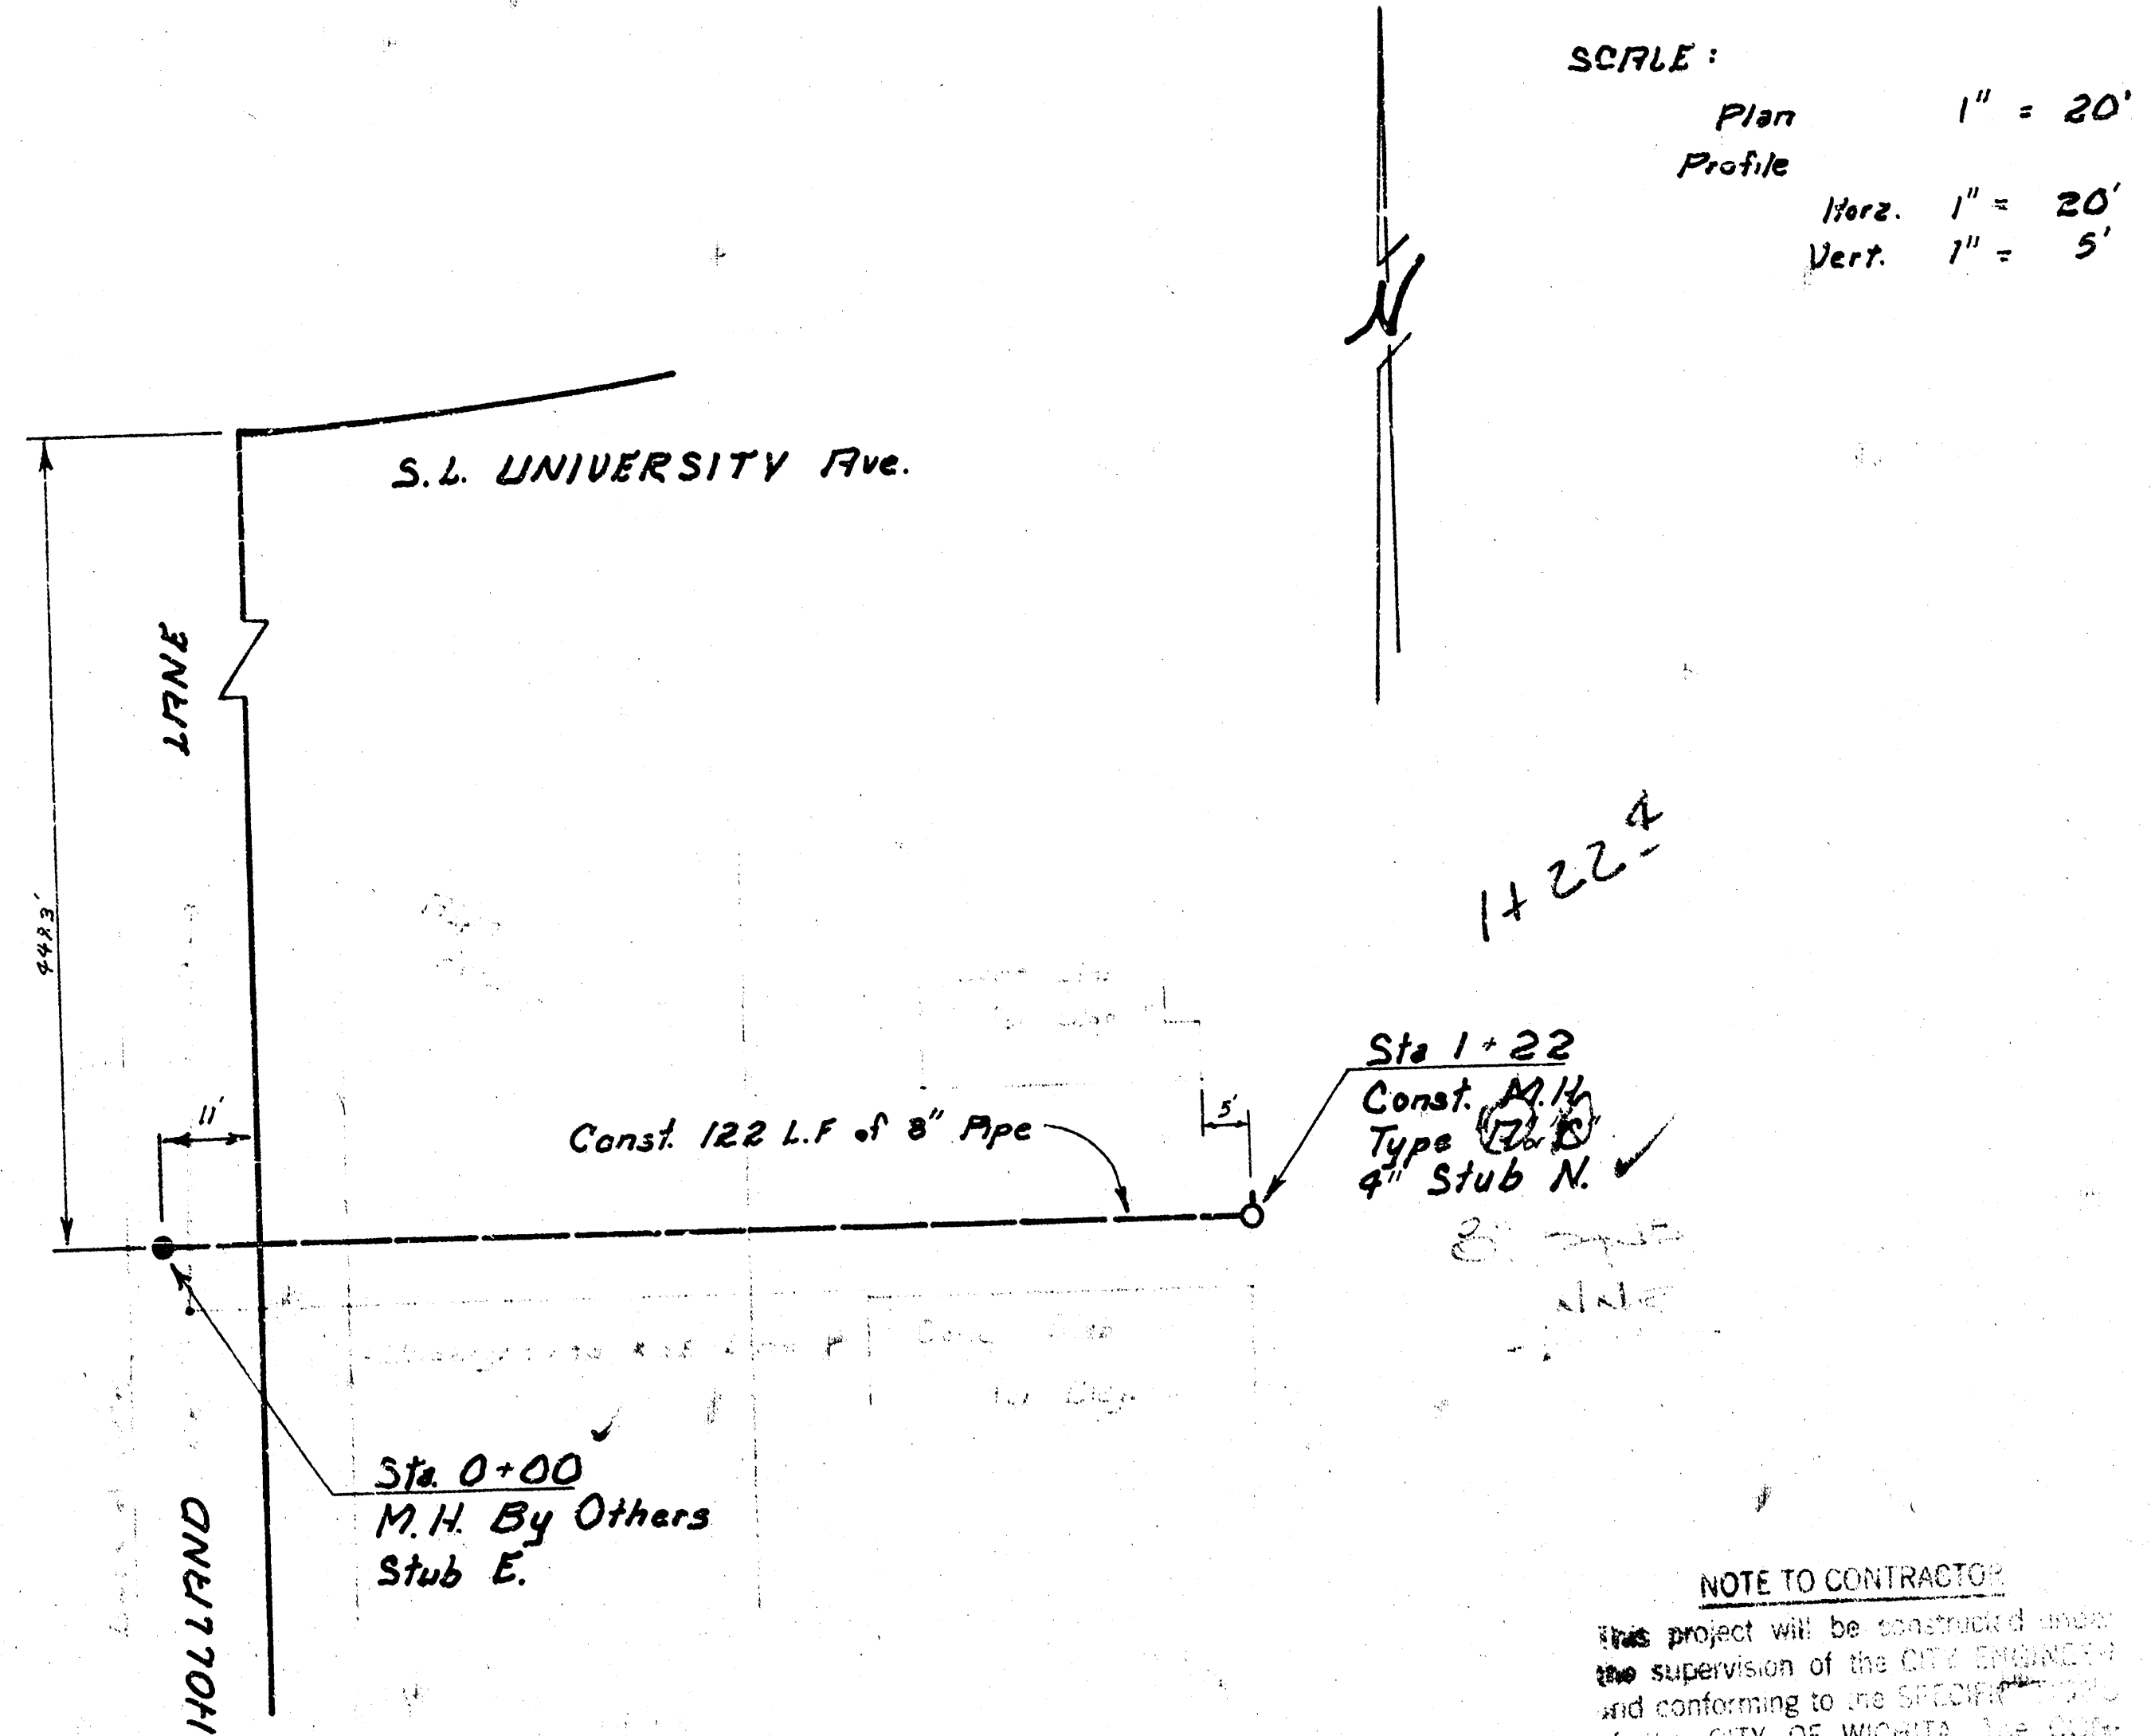

NOTE TO CONTRACTOR:
This project will be constructed under the supervision of the City Engineer and conforming to the SPECIFICATIONS of the CITY OF WICHITA. The CONTRACTOR will reimburse the City of Wichita for the cost of Engineering, Plans, and Inspection.

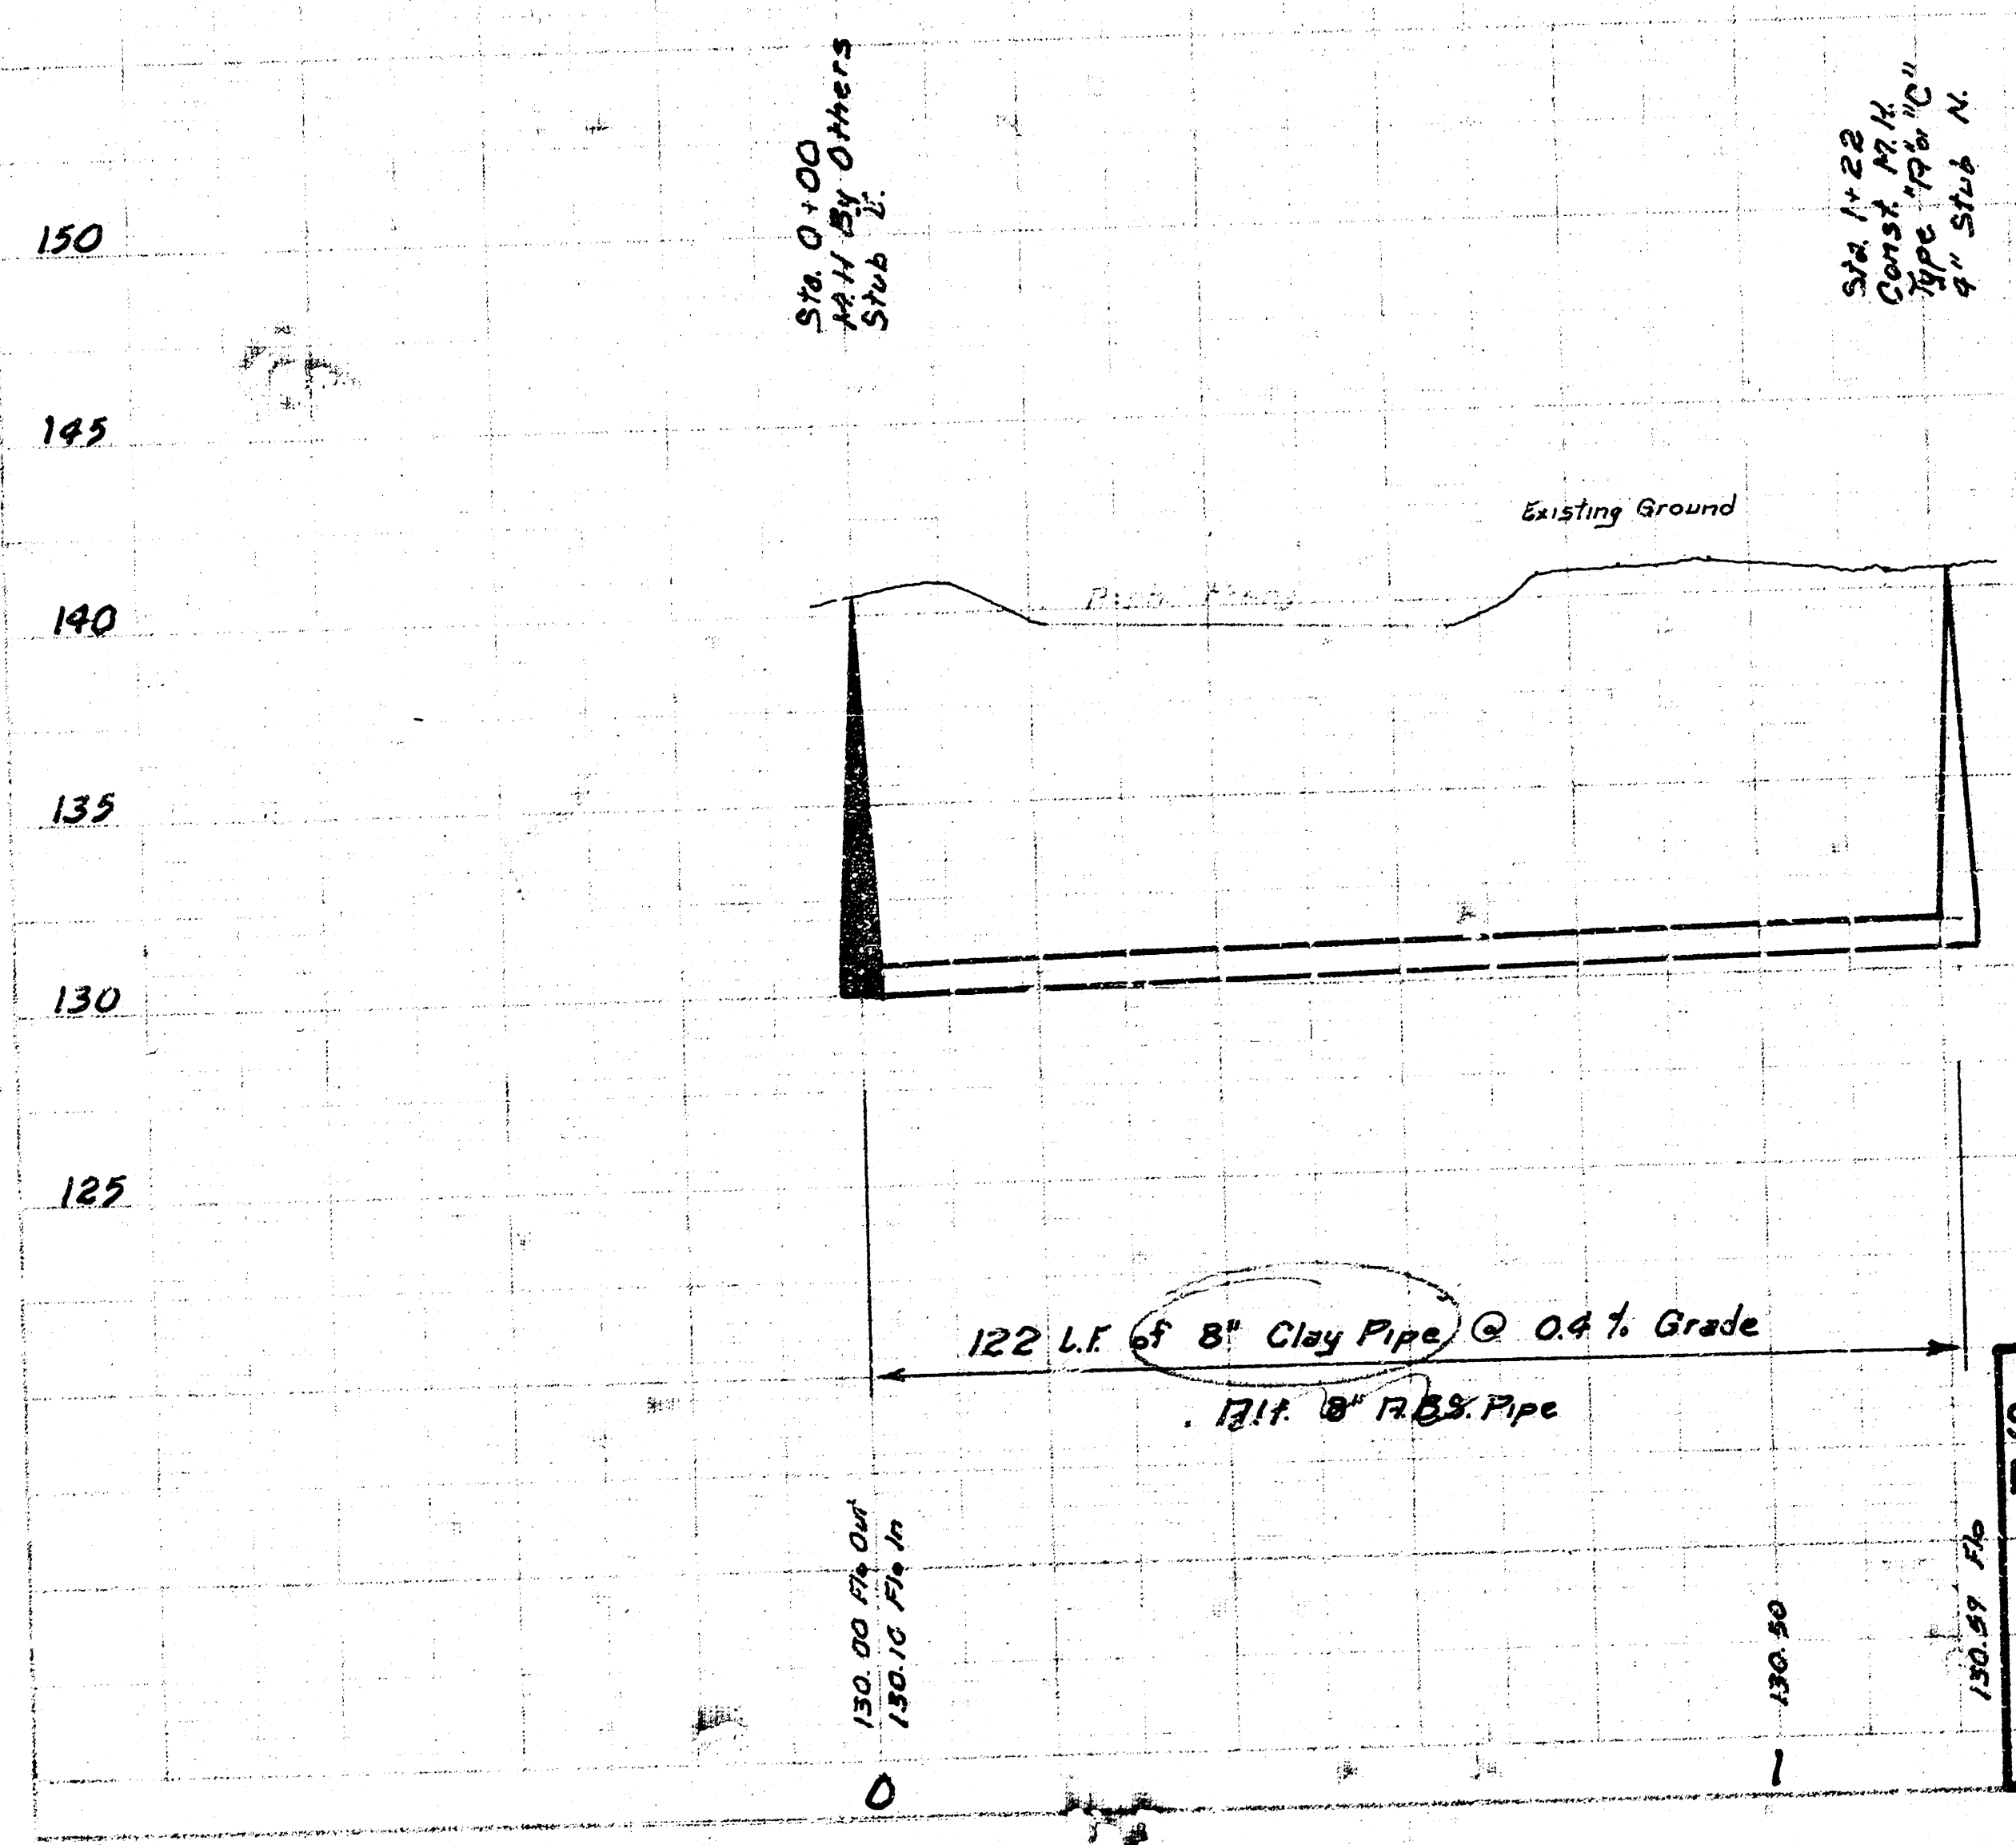

AD BUILT
FUTURE
D 34
AR-8

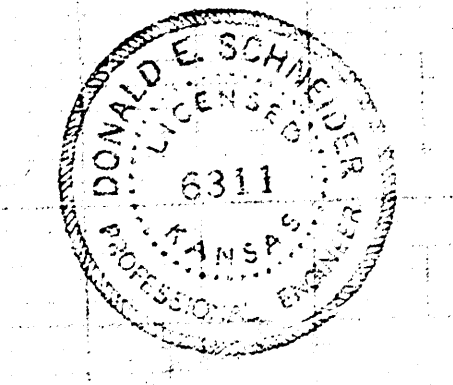

SANITARY SEWER Extension to serve RIDGE PLAZA OFFICE PARK at 520 S. HOLLAND
CITY of WICHITA, KANSAS
R.W. LINN - CITY ENGINEER
DATE: _____
PROJECT No. 468-76-245-80626-000-000-008 1/1