



PLAT 10-78
D. S. RULLEY
D. S. RULLEY
D. S. RULLEY

PLAT 10-78

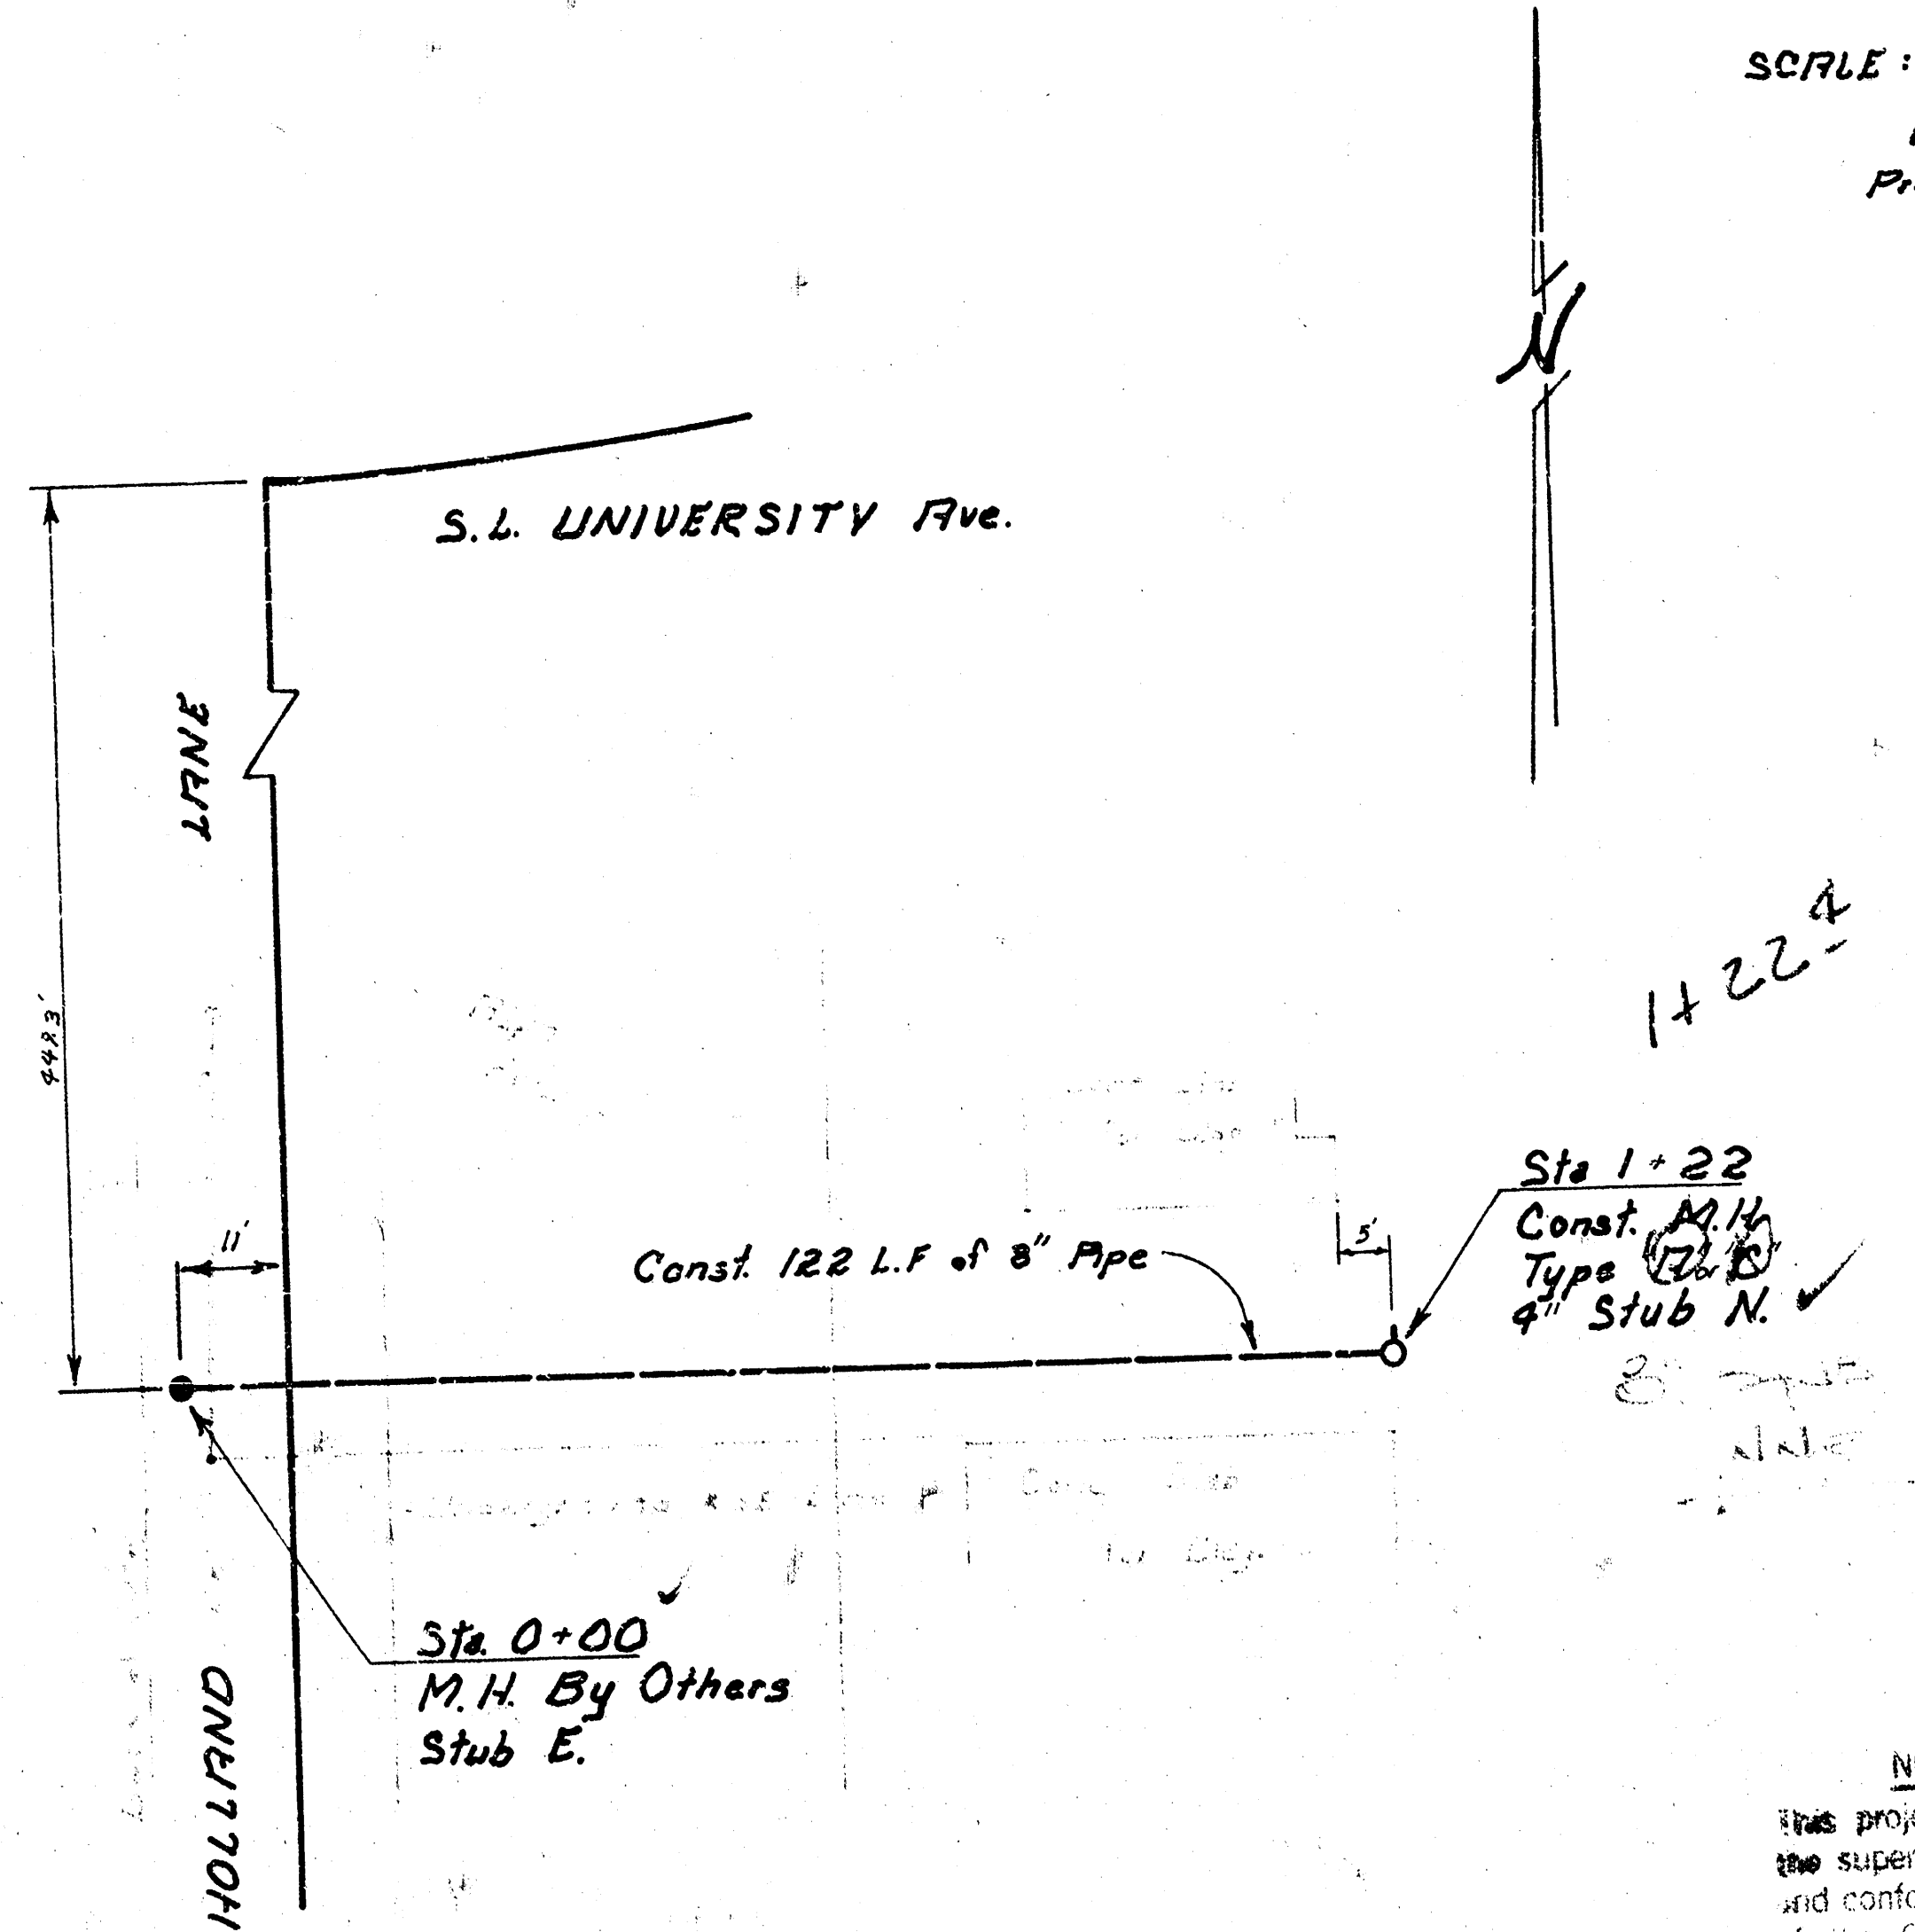


SCALE:
Plan 1" = 20'
Profile Horiz. 1" = 20'
Vert. 1" = 5'

NOTE TO CONTRACTOR:
This project will be constructed under the supervision of the City Engineer and conforming to the specifications of the CITY OF WICHITA. The CONTRACTOR will reimburse the City of Wichita for the cost of Engineering, Plans, and Inspection.

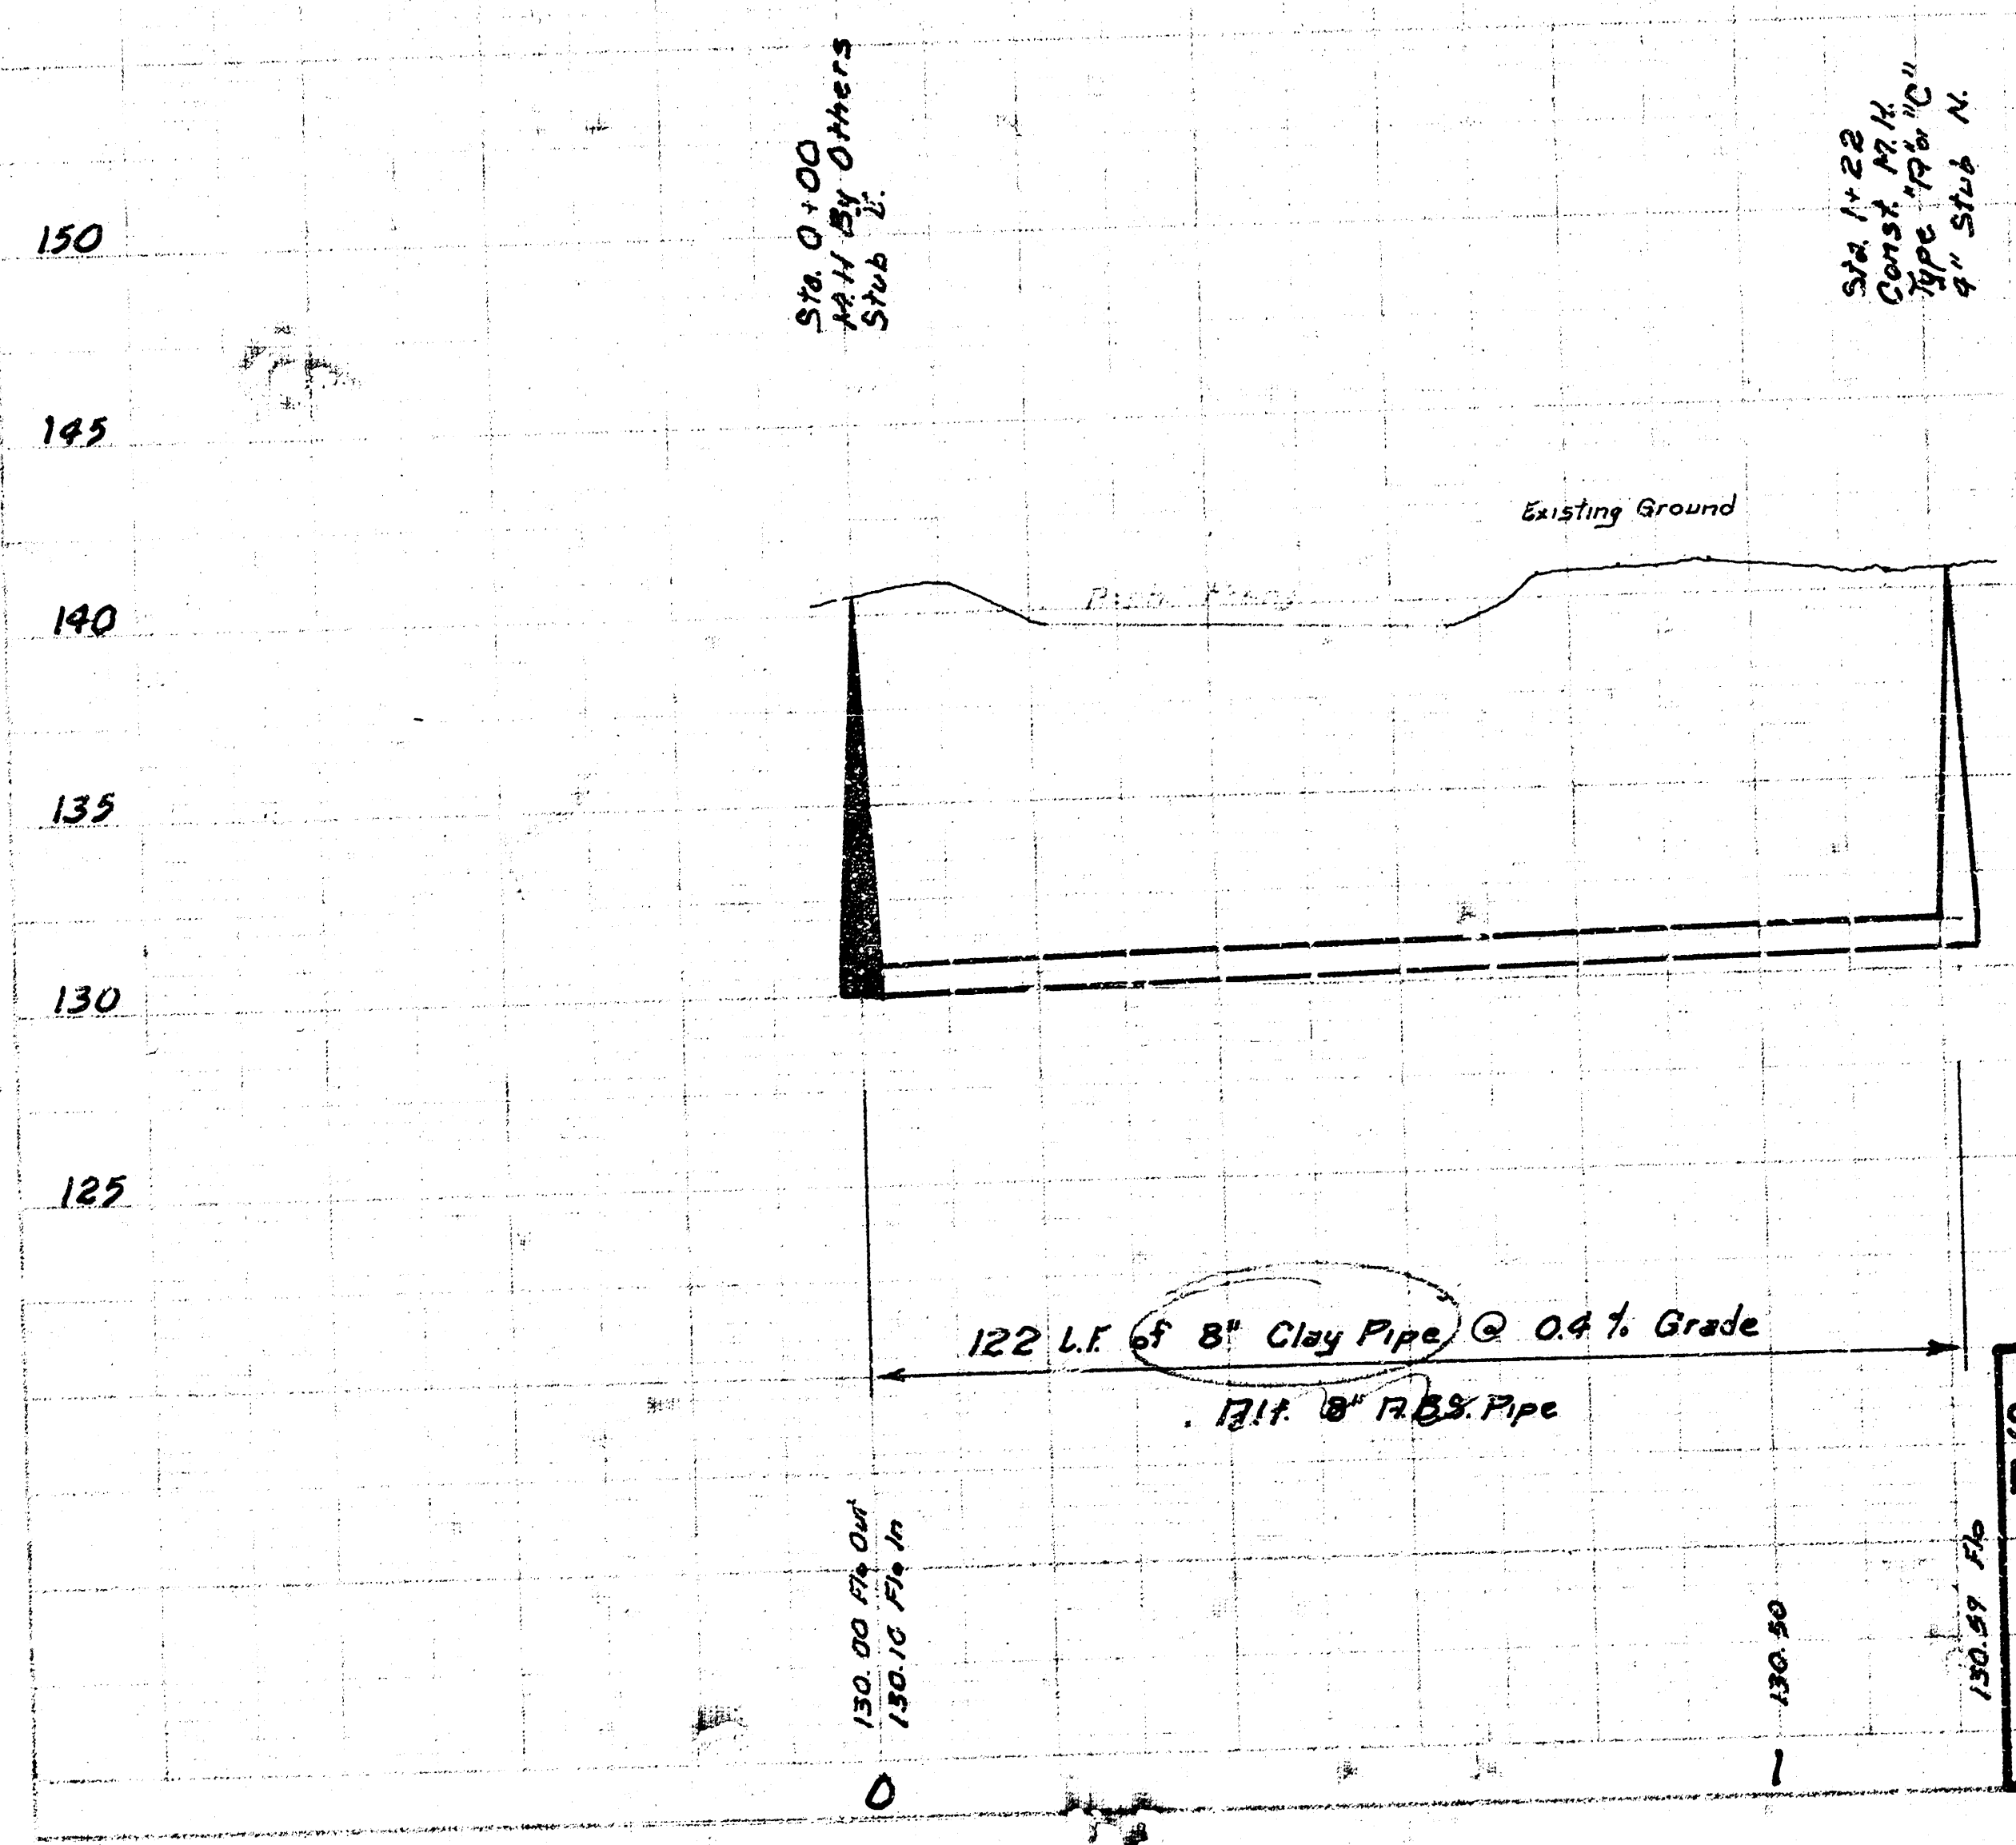

AD BUILT
AR-8

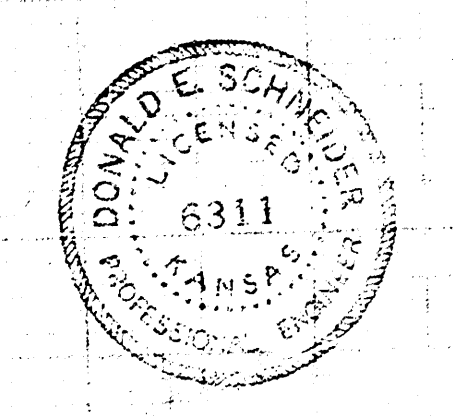

SANITARY SEWER Extension to serve RIDGE PLAZA OFFICE PARK at 520 S. HOLLAND
CITY of WICHITA, KANSAS
R.W. LINN - CITY ENGINEER
DATE: _____
PROJECT No. 468-76-245-80626-000-000-008 1/1

PLATE 1, PLAN & PROFILE
SHEET 1 OF 1

14 3 3 1