
B.M. 122.86 "X" Chisled on S.W. Cor. Conc. Piling N.E. Cor. 22nd St & Hood.

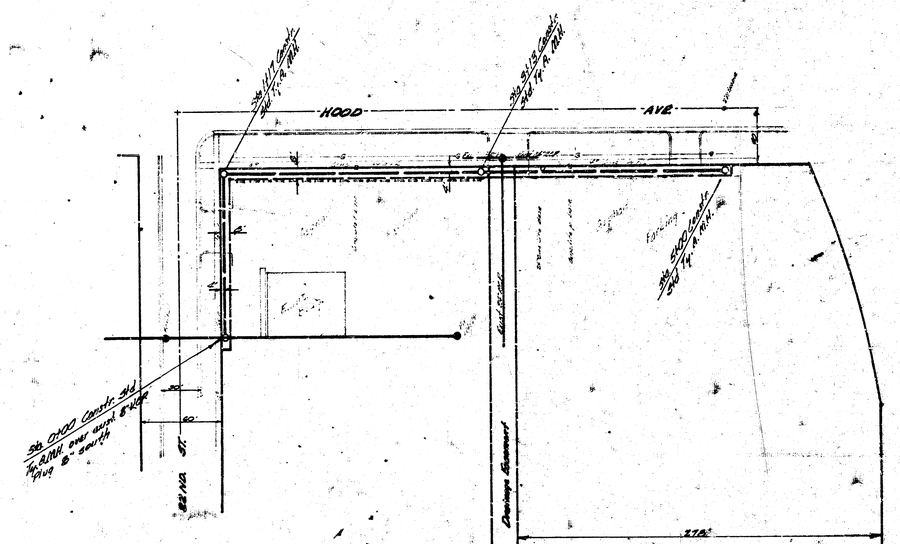

NOTE TO CONTRACTOR:


Contractor will excavate existing sanitary sewer @ Sta 0+00 so that Field Engr. may verify elev. prior to construction Field Engr. to note condition of exist. Walk & Drives. Contractor to replace any Walk or Drives damaged during construction of sanitary sewer.

N

NOTE TO CONTRACTOR

This project will be constructed under the supervision of the CITY ENGINEER and conforming to the SPECIFICATIONS of the CITY OF WICHITA. The CONTRACTOR will reimburse the City of Wichita for all costs of Engineering, Plans, and Inspection.

PLAN SCALE 1" = 40'
PROFILE SCALE 1" = 40' H.
PROFILE SCALE 1" = 4' V.

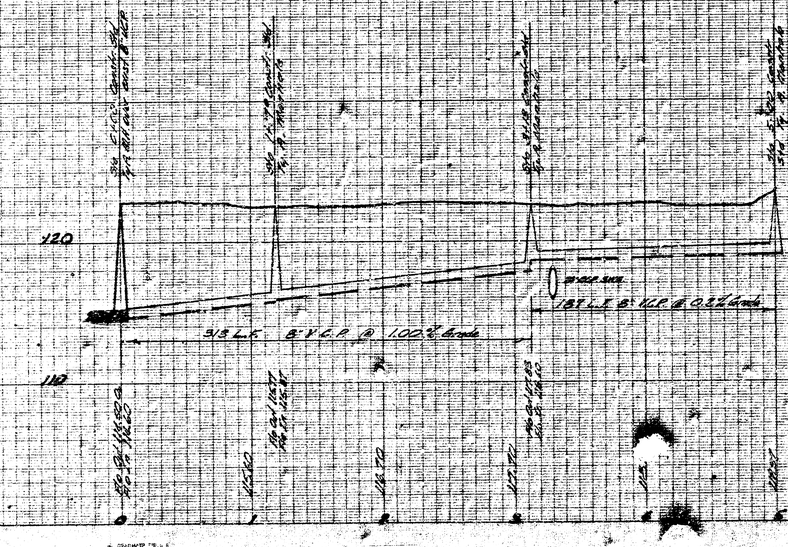

SANITARY SEWER FOR
RIVERBEND SHOPPING CENTER
CITY OF WICHITA, KANSAS
O. E. SMITH CITY ENGINEER
DATE: AUG. 1968 PRIVATE PROJECT

9 12 5 (4)