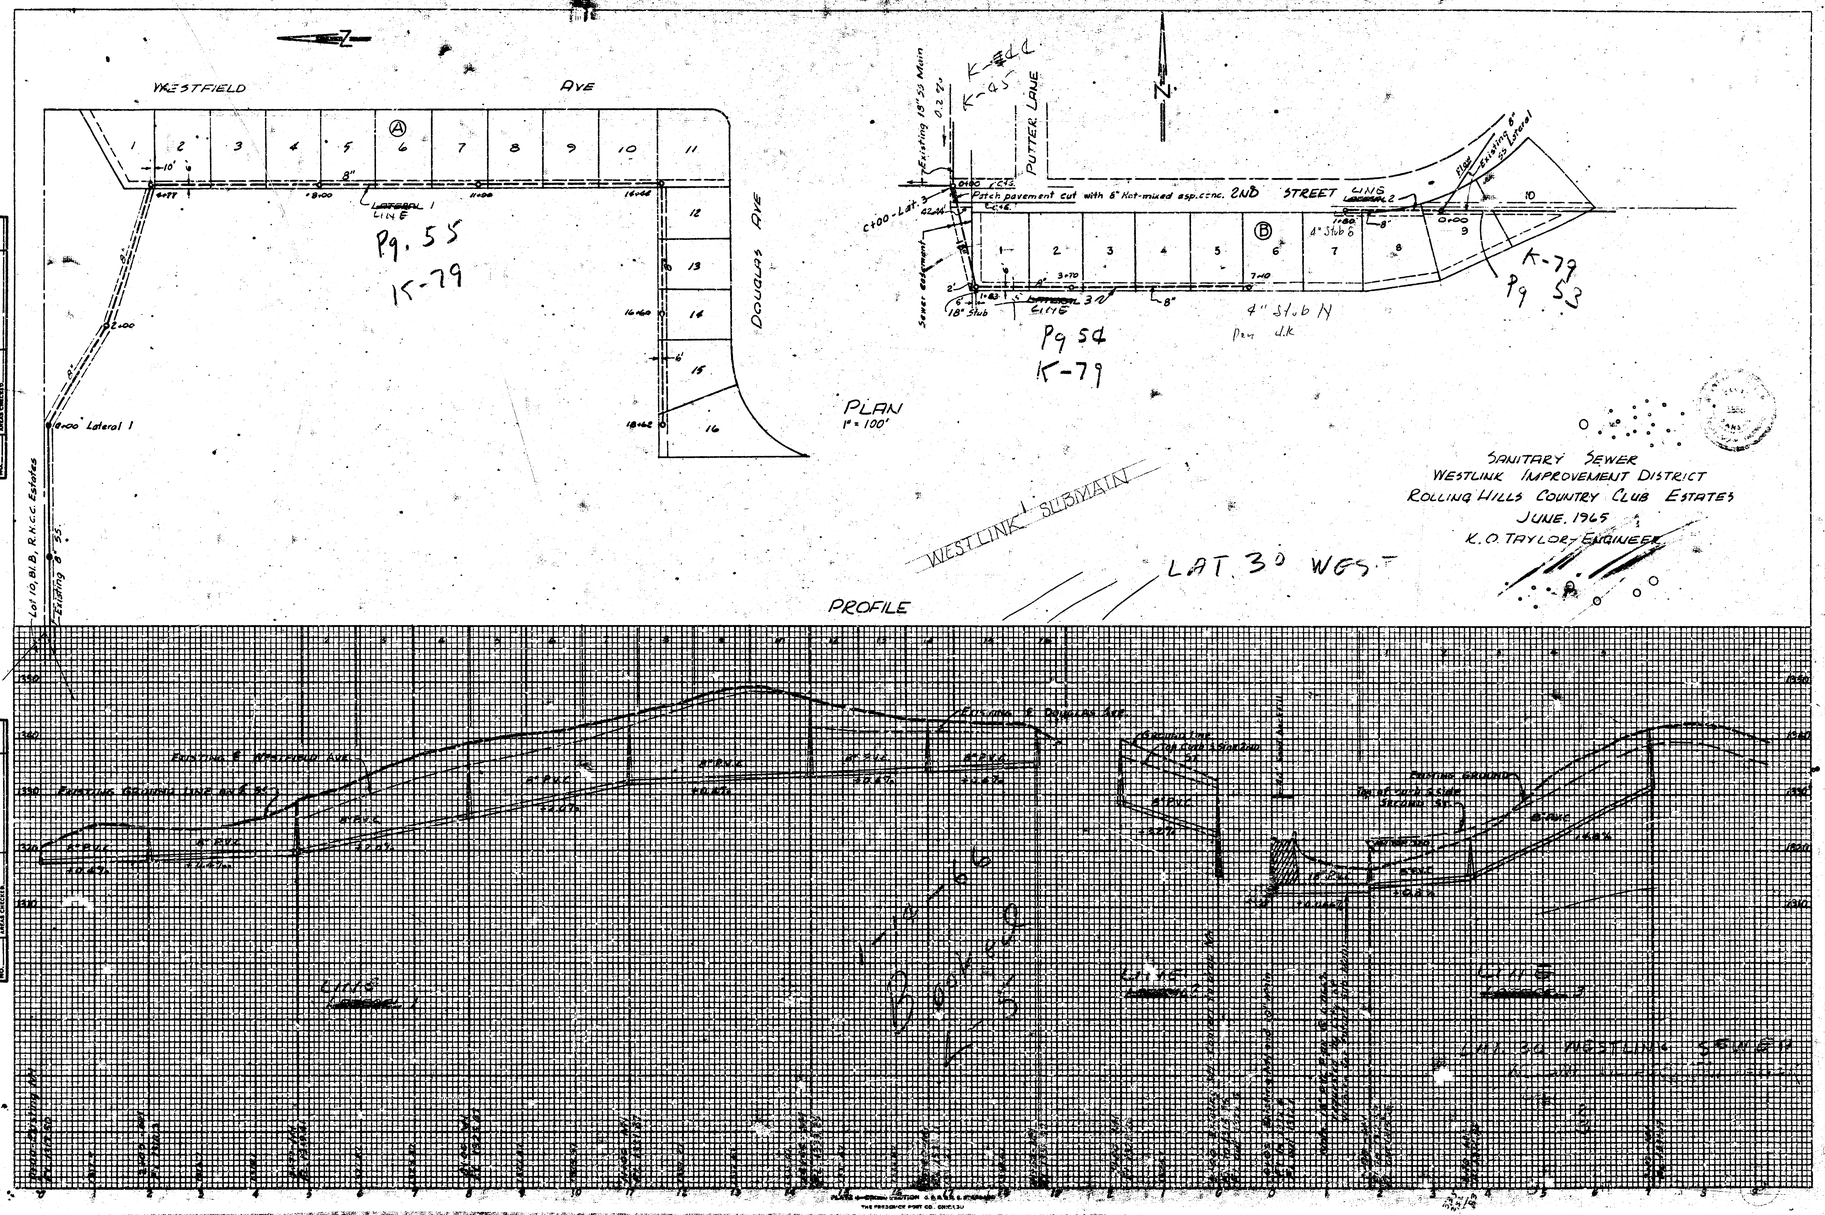
WESTFIELD AVE
DOUGLAS AVE
PUTTER LANE
2ND STREET
Lateral 1 Line
Pg. 55
K-79
Pg 54
K-79
Pg 53
K-79
Lat. 3
Lat. 2
Lat. 1
Existing 18" SS Main
Sewer easement
Patch pavement cut with 6" Hot-mixed asp. conc.
4" Stub N
4" Stub 6
18" Stub
Lot 10, Bl. B, R.H.C.C. Estates
Existing 8" SS
PLAN
1" = 100'
PROFILE
WESTLINK SUBMAIN
LAT. 3 WEST
SANITARY SEWER
WESTLINK IMPROVEMENT DISTRICT
ROLLING HILLS COUNTRY CLUB ESTATES
JUNE, 1965
K. O. TAYLOR, ENGINEER
FINAL SURVEY
ORIGINAL SURVEY
LAT. 3A WESTLINK SEWER