
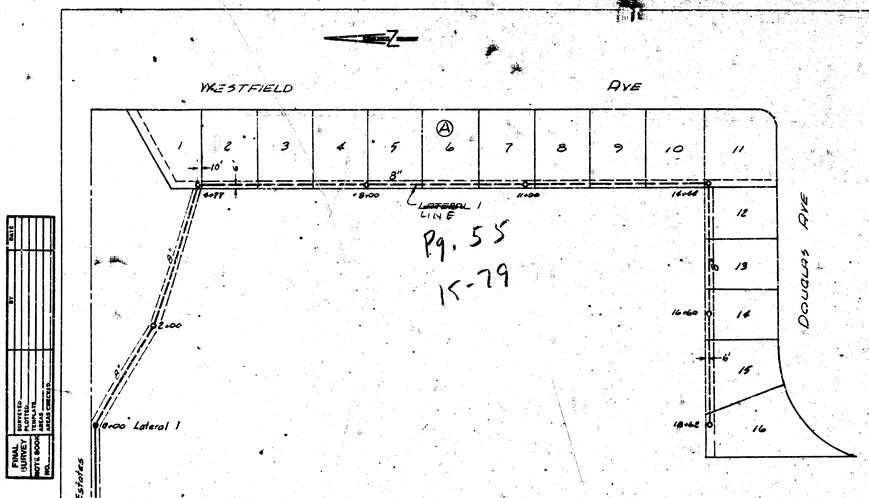


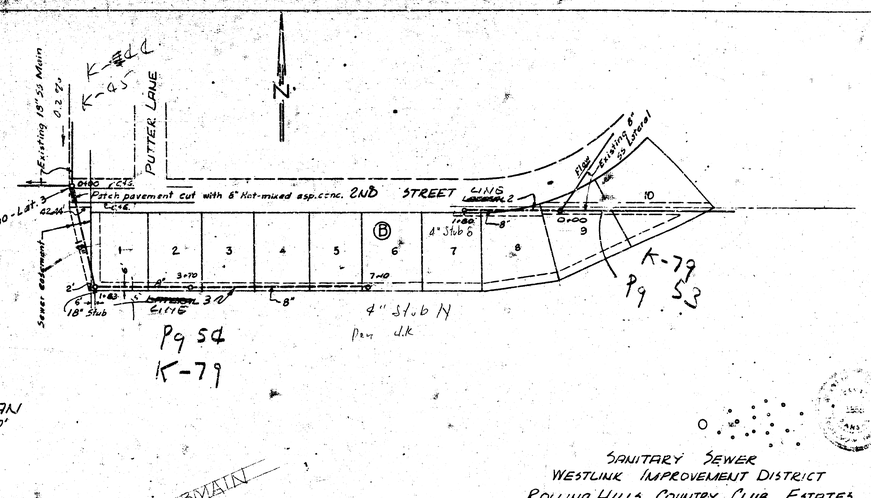

SANITARY SEWER
WESTLINK IMPROVEMENT DISTRICT
ROLLING HILLS COUNTRY CLUB ESTATES
JUNE, 1965
K.O. TAYLOR-ENGINEER

WESTLINK SUBMAIN

LAT. 30 WEST

PROFILE

