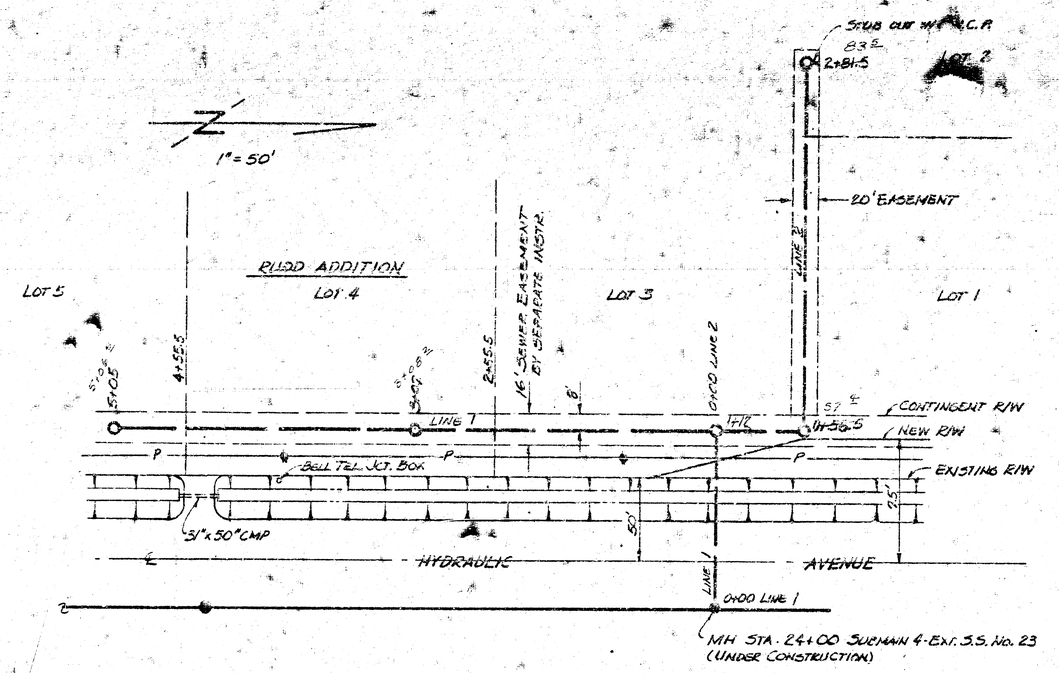

NOTE TO CONTRACTOR

This project will be constructed under the supervision of the CITY ENGINEER and conforming to the SPECIFICATIONS of the CITY OF WICHITA. The CONTRACTOR will reimburse the City of Wichita for all cost of [redacted] and inspection.

APPROVED AS NOTED
By CITY ENGINEER OF WICHITA
Sanitary Sewers 2-8-94
Storm Sewers
Driveway + Parkways

SCALE
1" = 50' HORZ.
1" = 5' VERT.

NOTES:

CASING FOR BORINGS SHALL BE 16" SCH 40 STEEL PIPE. CASING TO BE NEW OR APPROVED USED PIPE.

ALL LINES TO BE SAND BACKFILLED AND FLUSHED

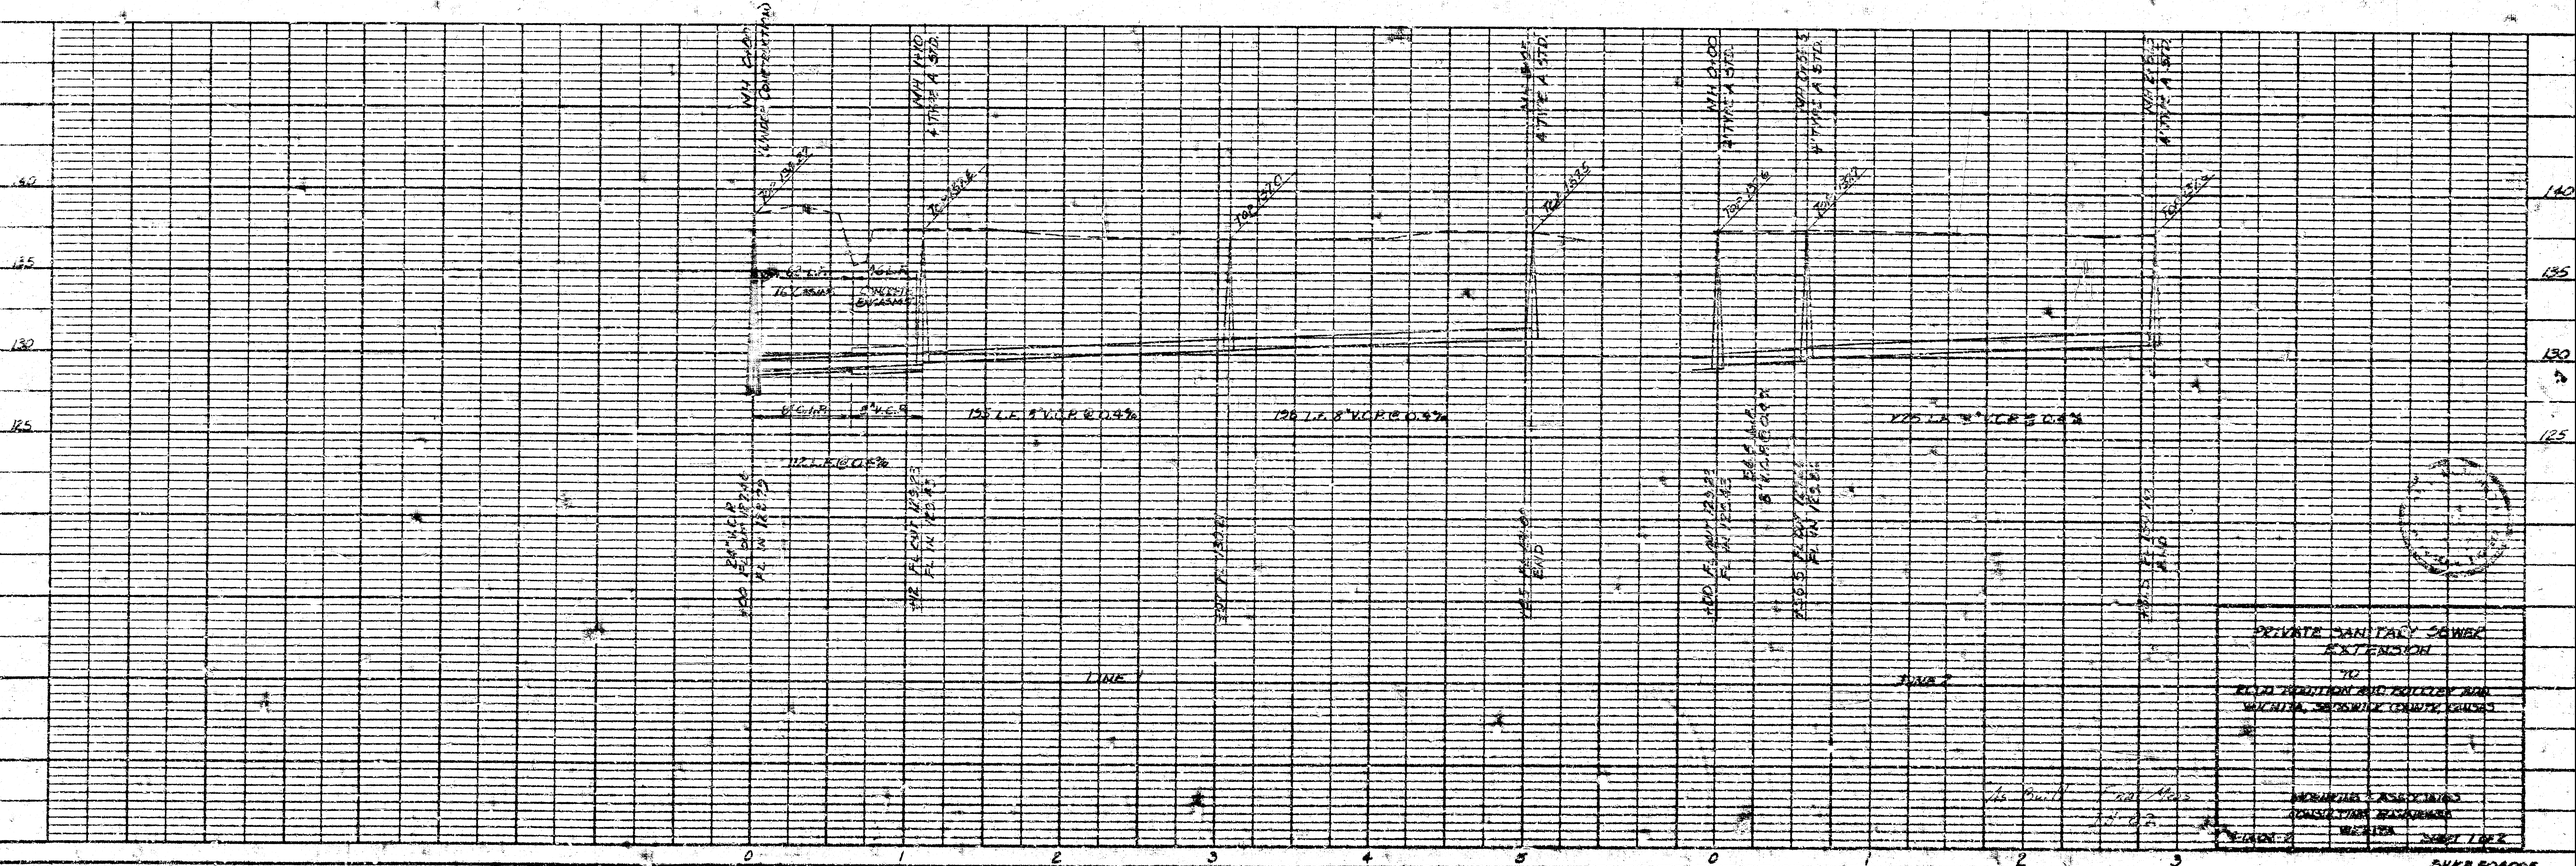

PLATE 1 - PLAN - PROFILE - F.A.S.
CLEARPRINT PAPER CO., S.F. CAL.