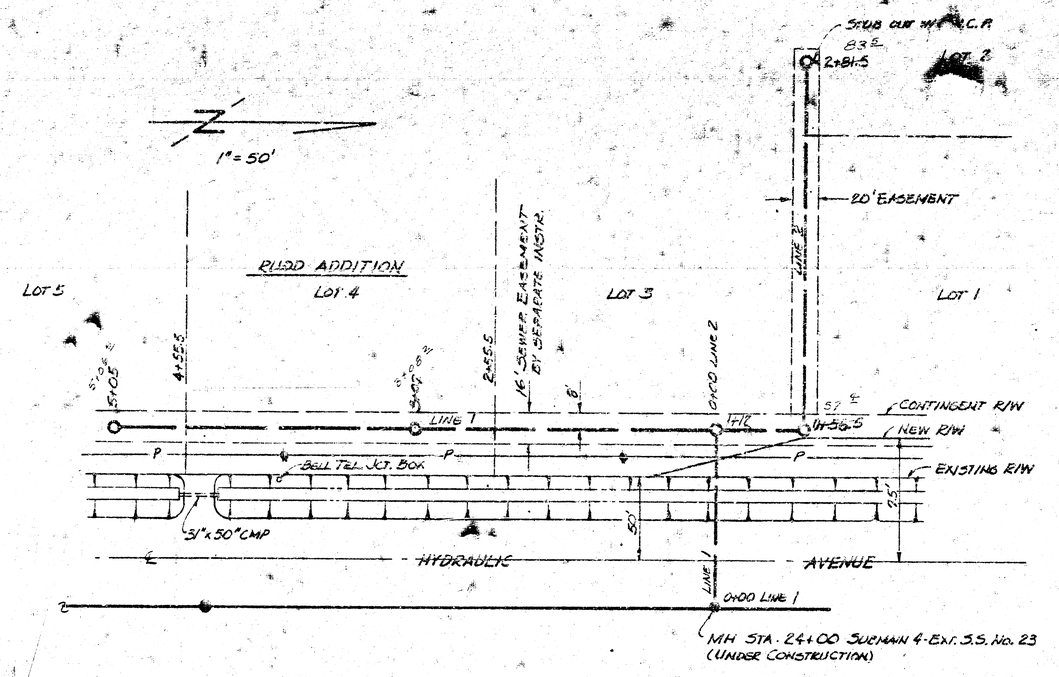


NOTE TO CONTRACTOR


This project will be constructed under the supervision of the CITY ENGINEER and conforming to the SPECIFICATIONS of the CITY OF WICHITA. The CONTRACTOR will reimburse the City of Wichita for all cost of [redacted] and inspection.

APPROVED AS NOTED
By CITY ENGINEER OF WICHITA
Sanitary Sewers 2-8-74 DJ
Storm Sewers
Drainage Districts

SCALE
1"= 50' HORZ.
1"= 5' VERT.

NOTES:
CASING FOR BORINGS SHALL BE 16" SCH 40 STEEL PIPE. CASING TO BE NEW OR APPROVED USED PIPE.

ALL LINES TO BE SAND BACKFILLED AND FLUSHED

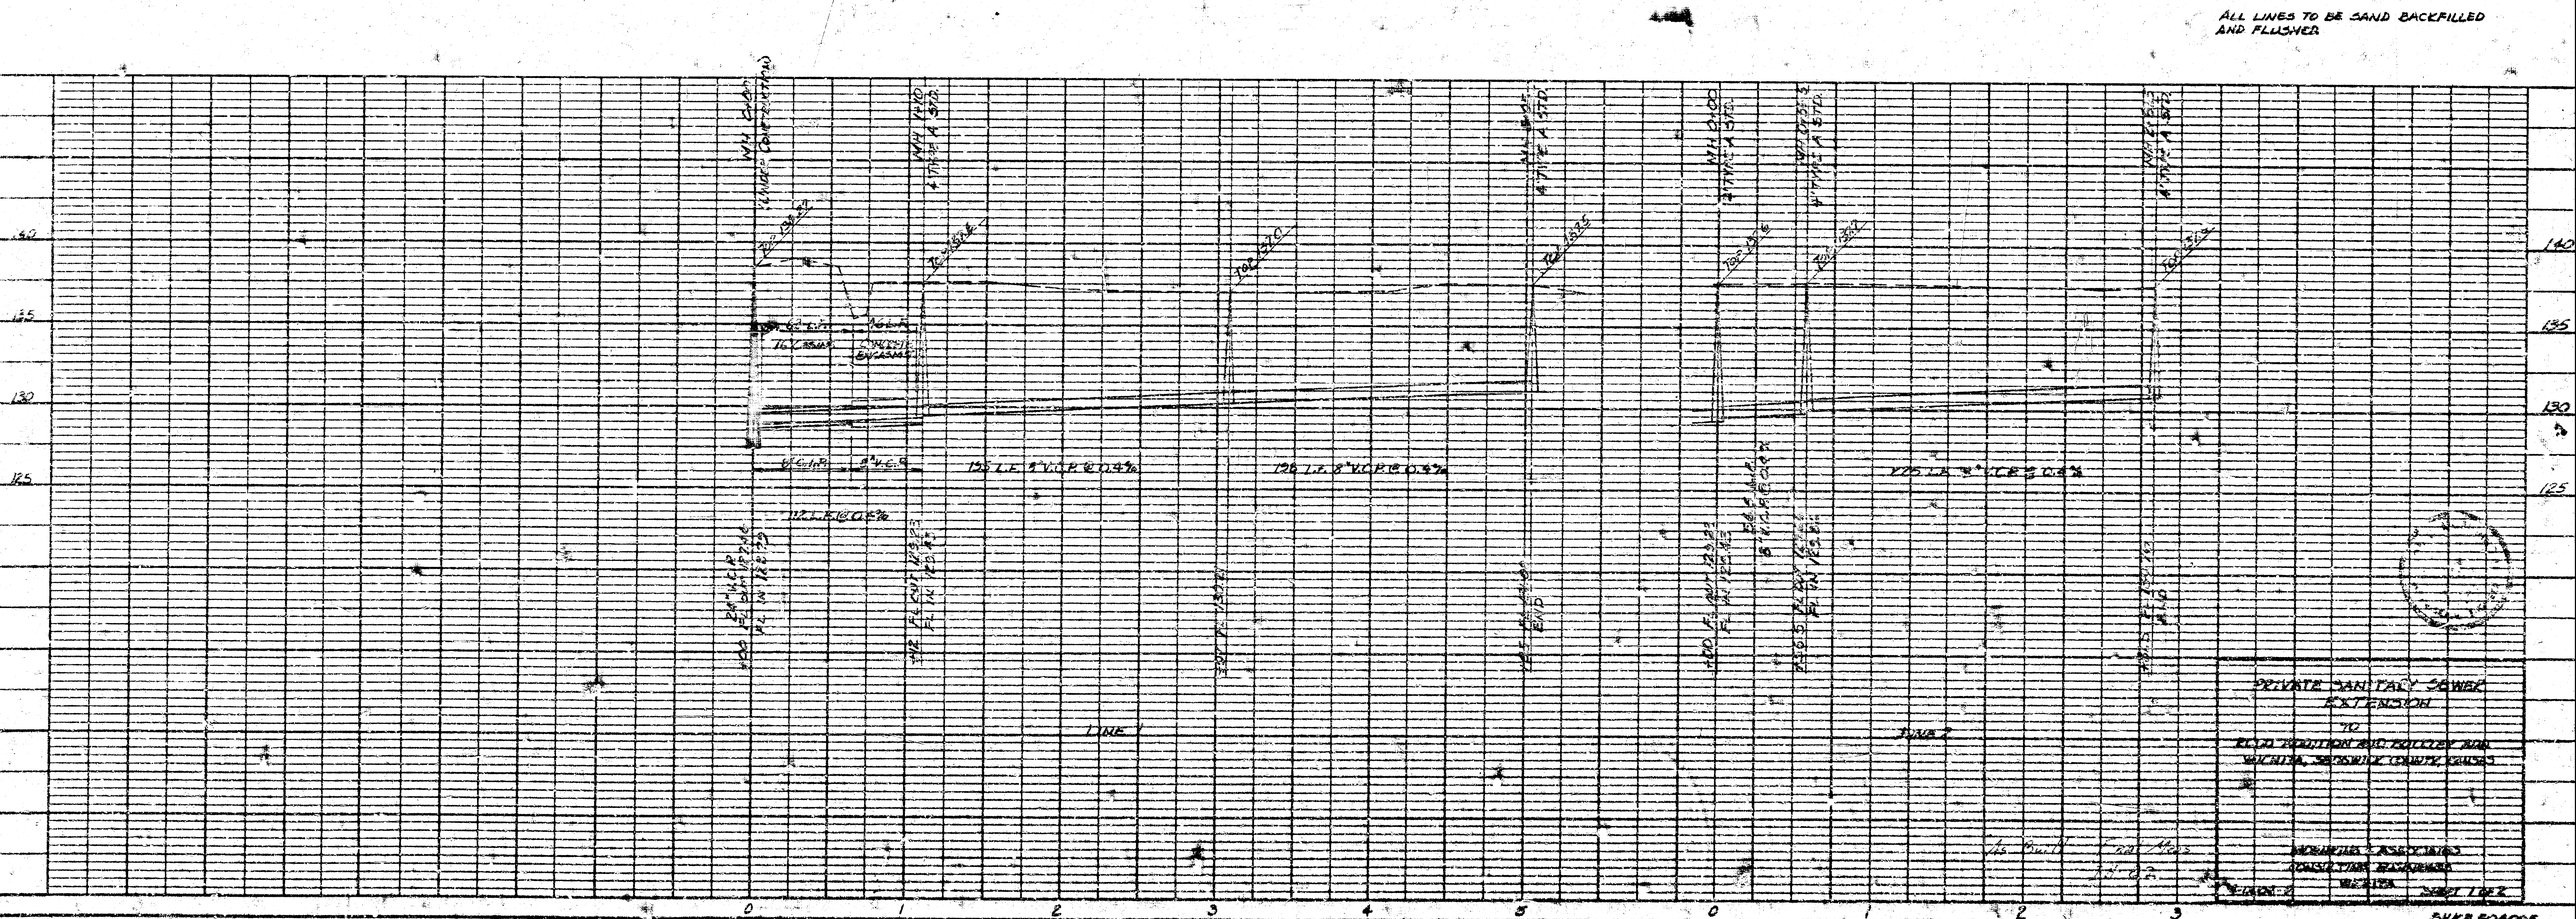

PRIVATE SANITARY SEWER EXTENSION
TO

[redacted]
CONSULTING ENGINEERS
WICHITA
SHEET 1 OF 2
SUKB 504005

PLATE 1 - PLAN - PROFILE - F.A.A.
CLEARPRINT PAPER Co., S.F. CAL.