



THE INFORMATION CONTAINED HEREIN IS FOR THE USE OF THE CITY OF WICHITA, KANSAS, AND IS NOT TO BE USED FOR ANY OTHER PURPOSE WITHOUT THE WRITTEN CONSENT OF THE CITY ENGINEER.

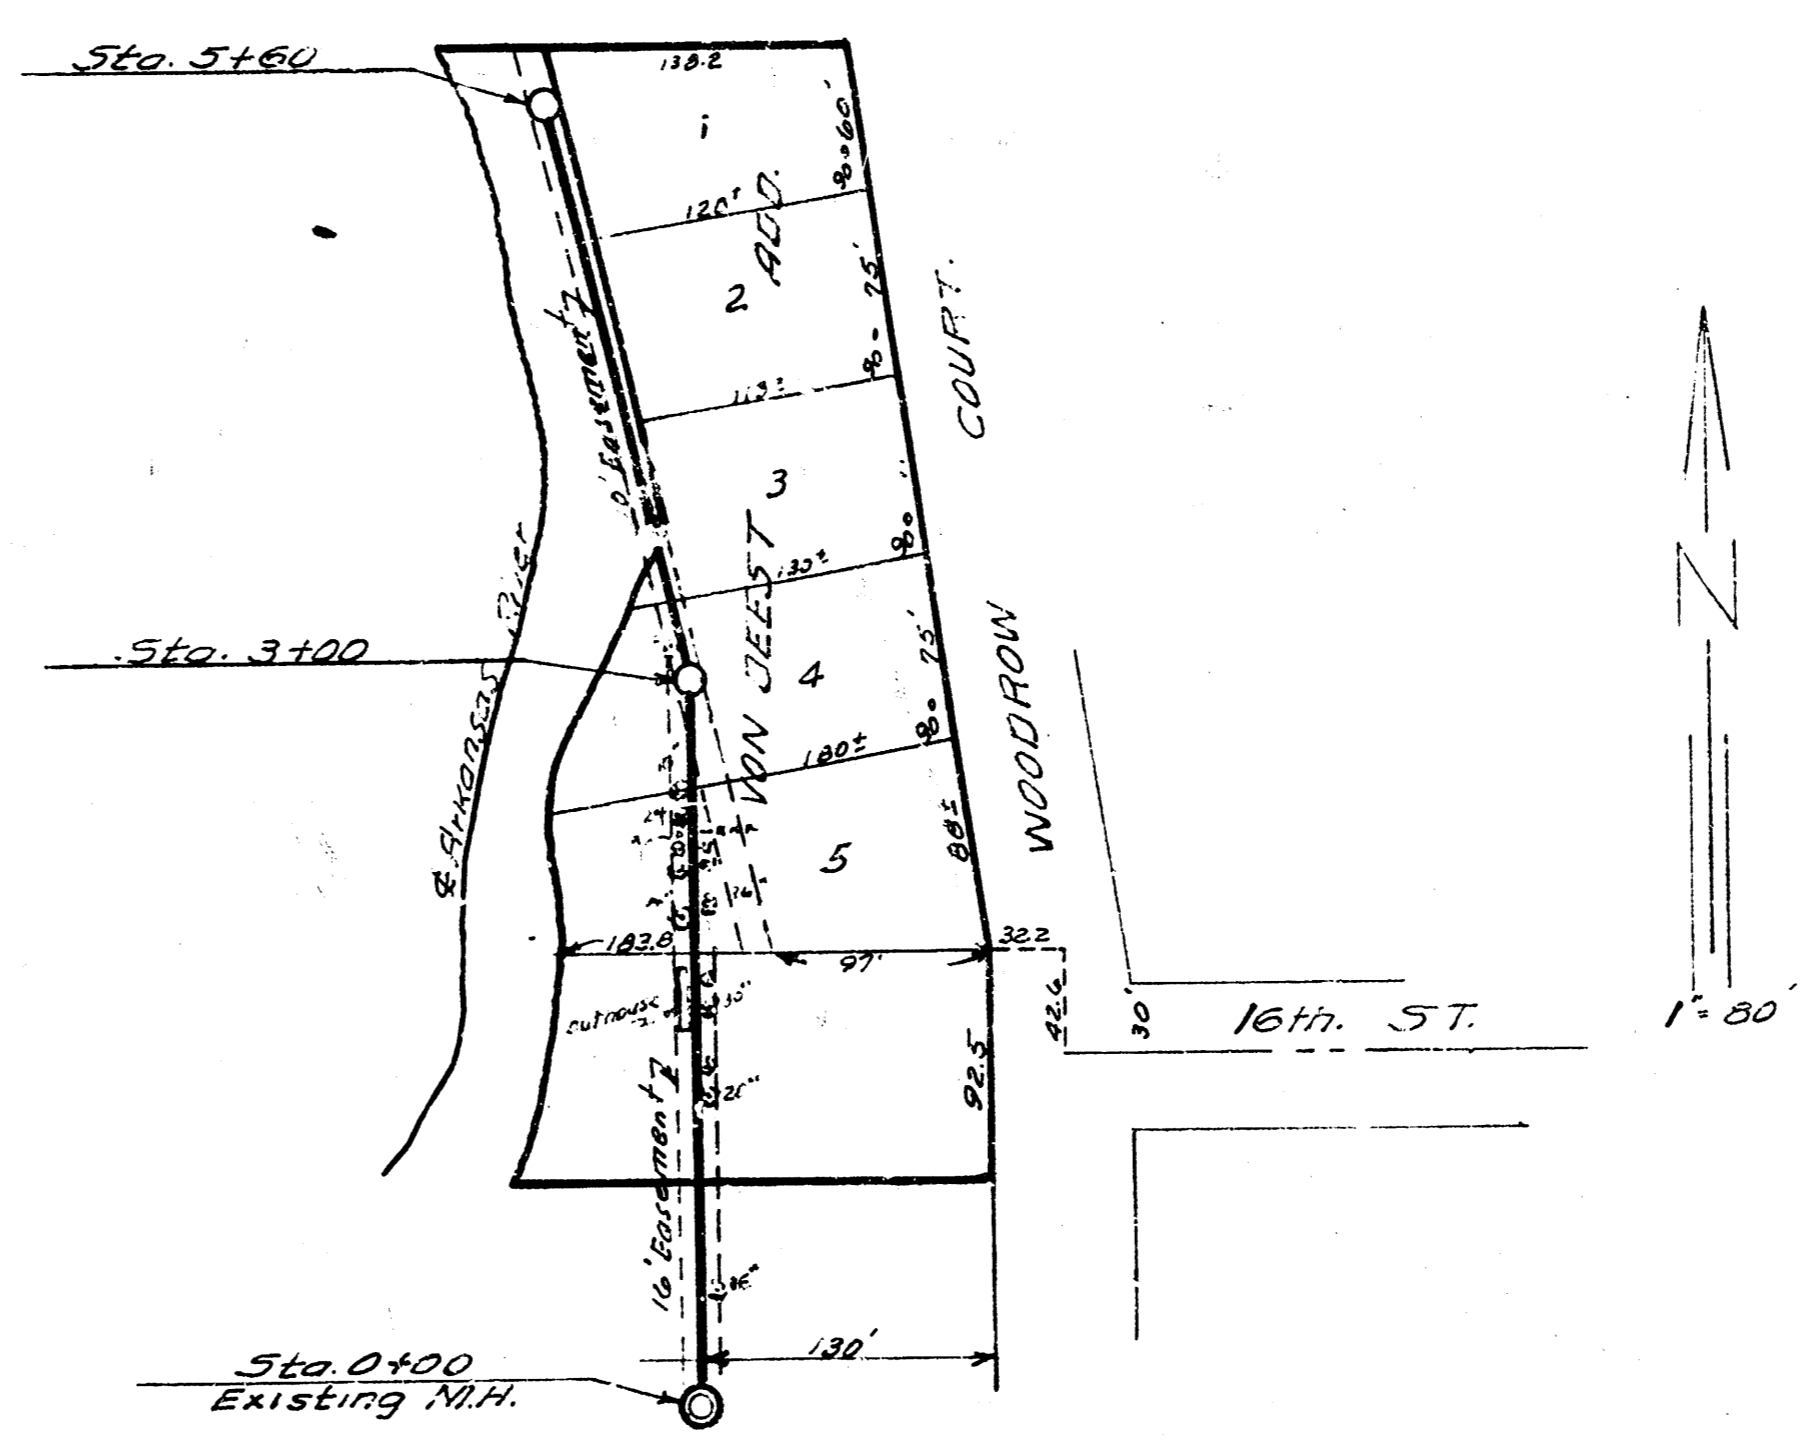


Date
Checked by
Book No.

B.M. 130.30 No rim of M.H. 115' S.D. of D400

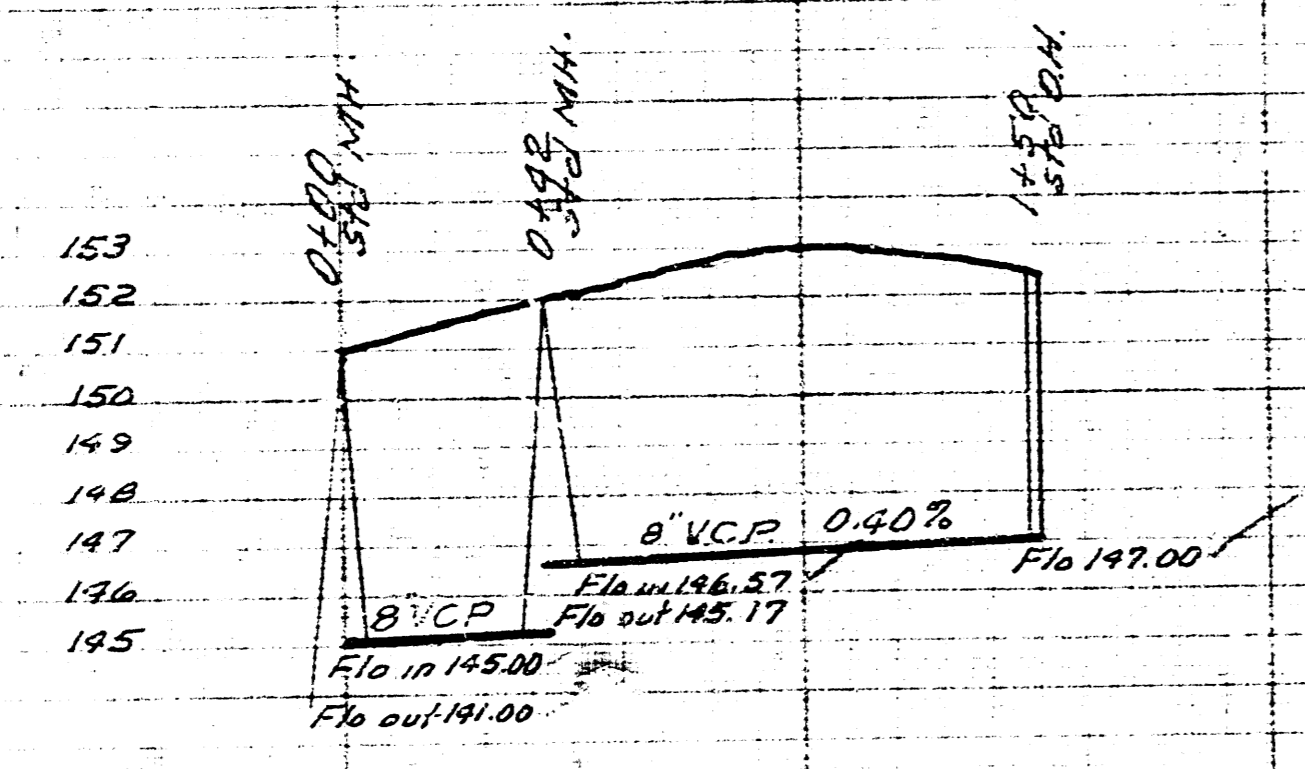


Date
Checked by
Book No.

B.M. 121.79 5a rim M.H. 0+00

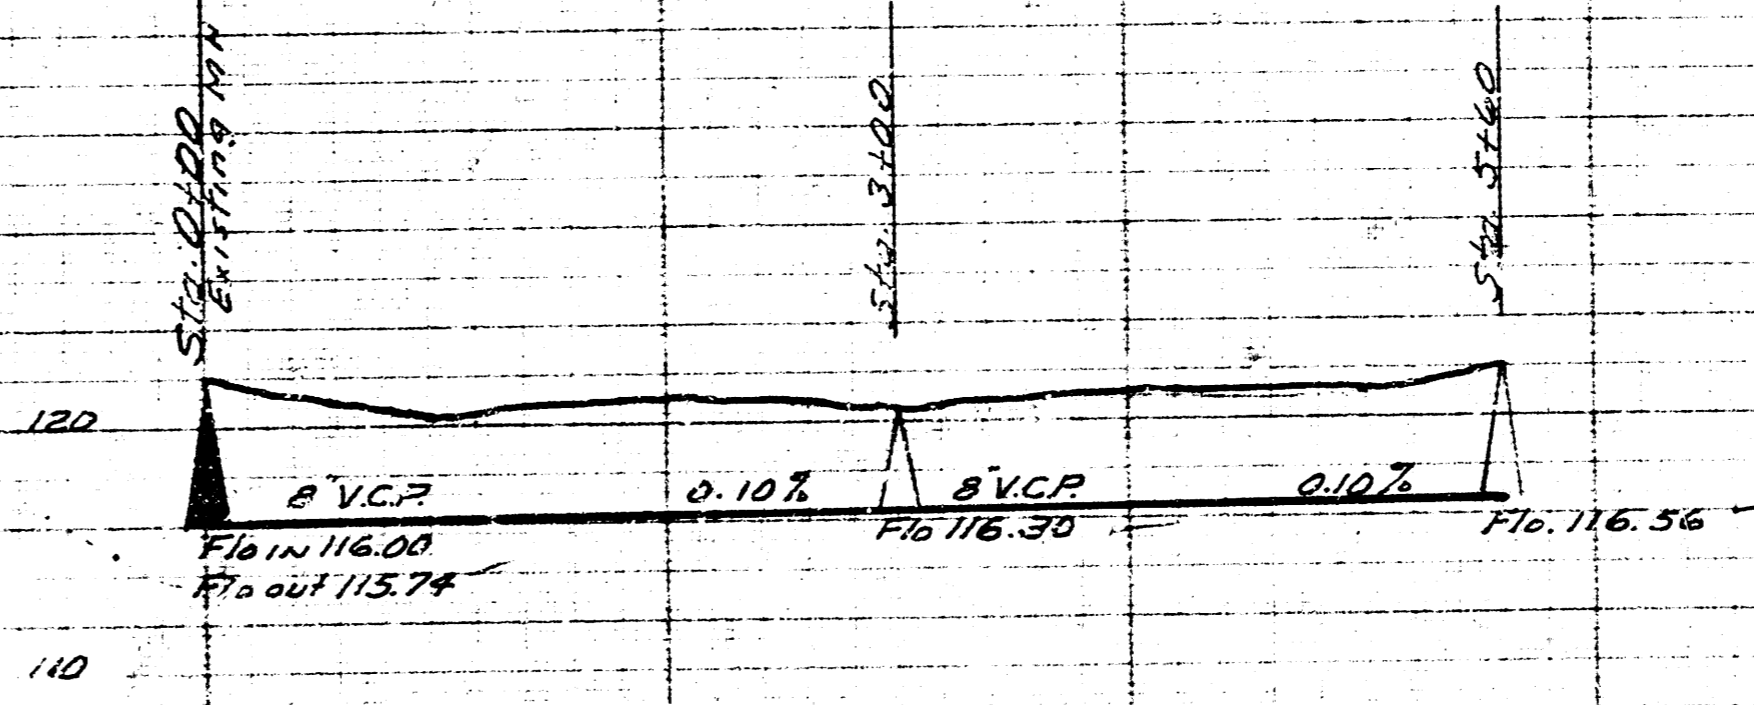

O.B. RYNDERS PRIVATE SEWER
CITY OF WICHITA KANSAS
B.E. SMITH CITY ENGINEER

 

LAT. 5 DIST. R. 5S.20
CITY OF WICHITA KANSAS
B.E. SMITH CITY ENGINEER
Proj. No. C-24-27

