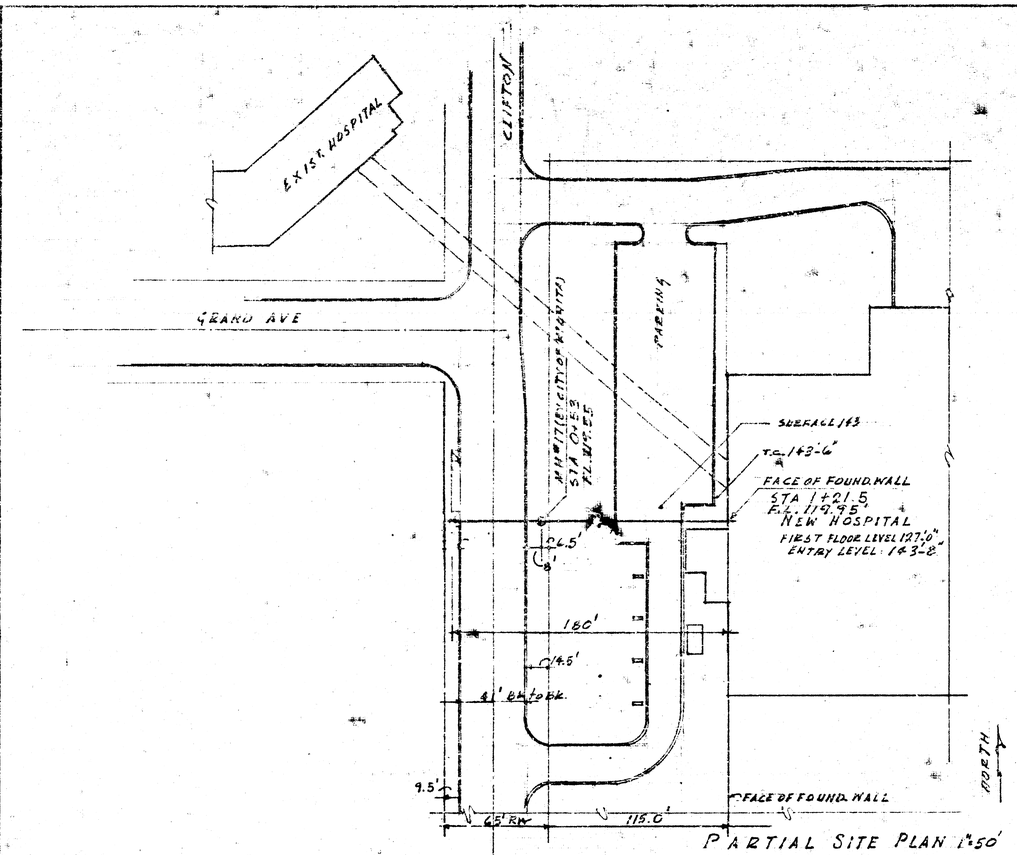

PARTIAL SITE PLAN 1"=50'

NOTE TO CONTRACTOR

The project will be constructed under the supervision of the CITY ENGINEER and conforming to the SPECIFICATIONS of the CITY OF WICHITA. The CONTRACTOR will reimburse the City of Wichita for all cost of [redacted] and inspection.

7-8-74

APPROVED AS NOTED
By CITY ENGINEER OF WICHITA
Sanitary Sewers D. E. S.
Storm Sewers
Driveway Approaches

HORIZONTAL = 1"=10', VERTICAL = 1"= 5'

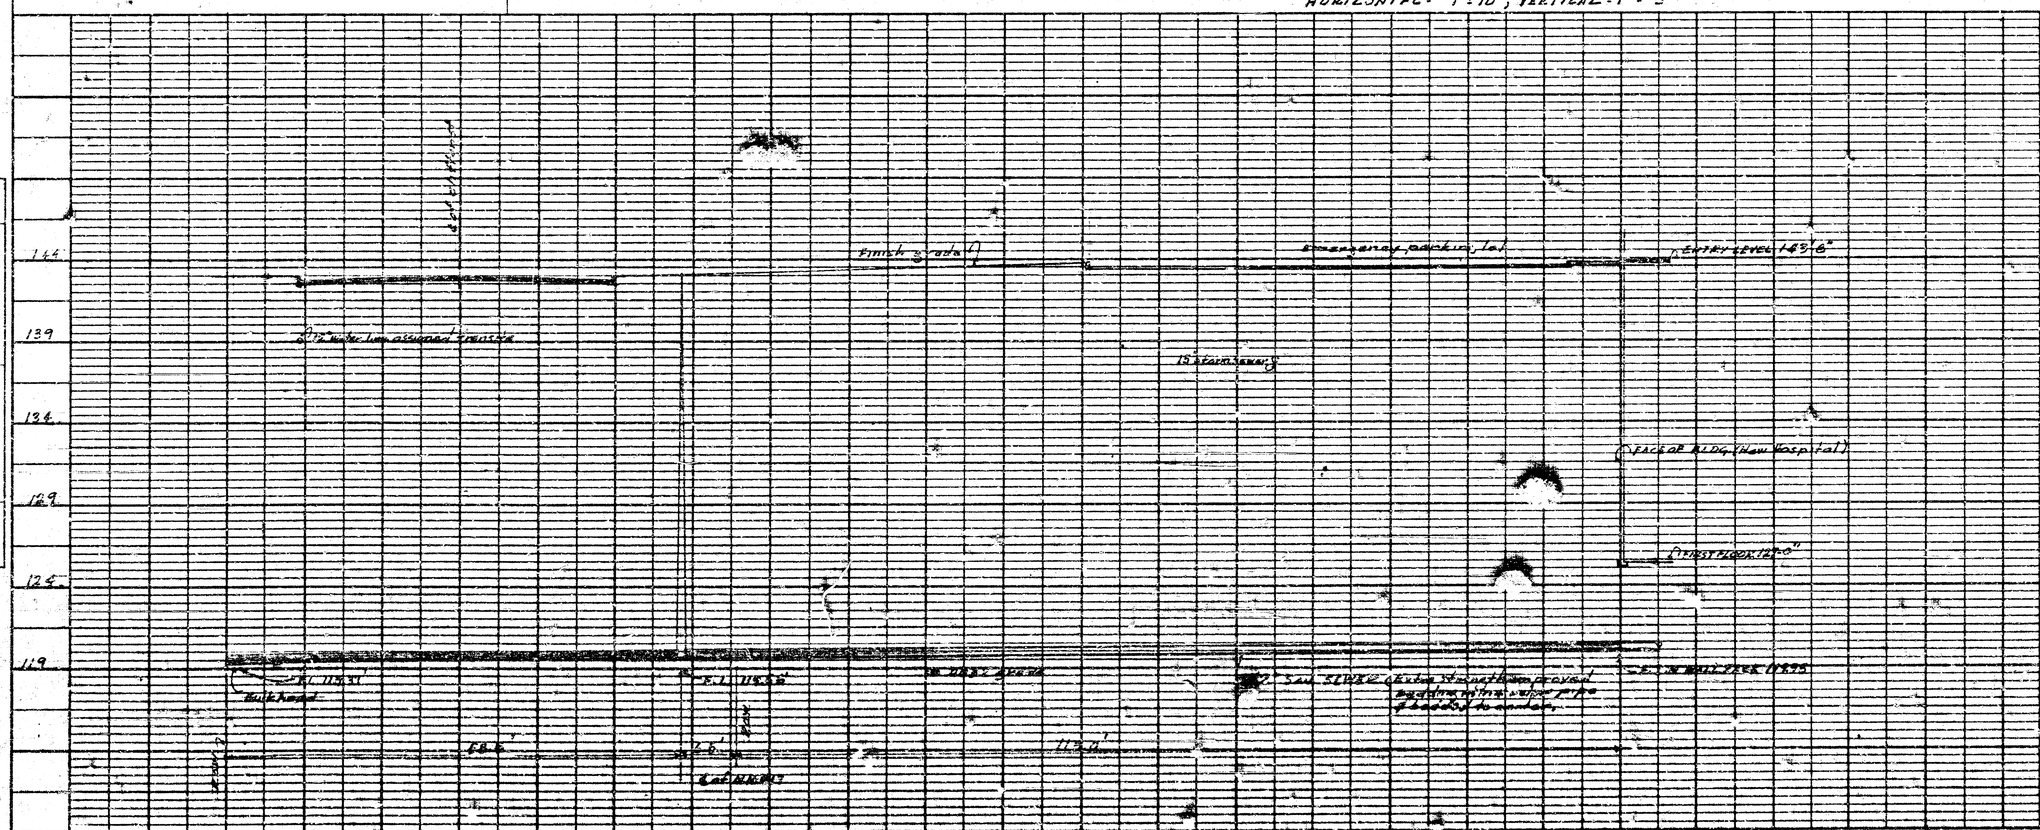

THE NEW ST. JOSEPH HOSPITAL
& REHABILITATION CENTER
WICHITA, KANSAS
PROJECT NO. 0BEW 104266