


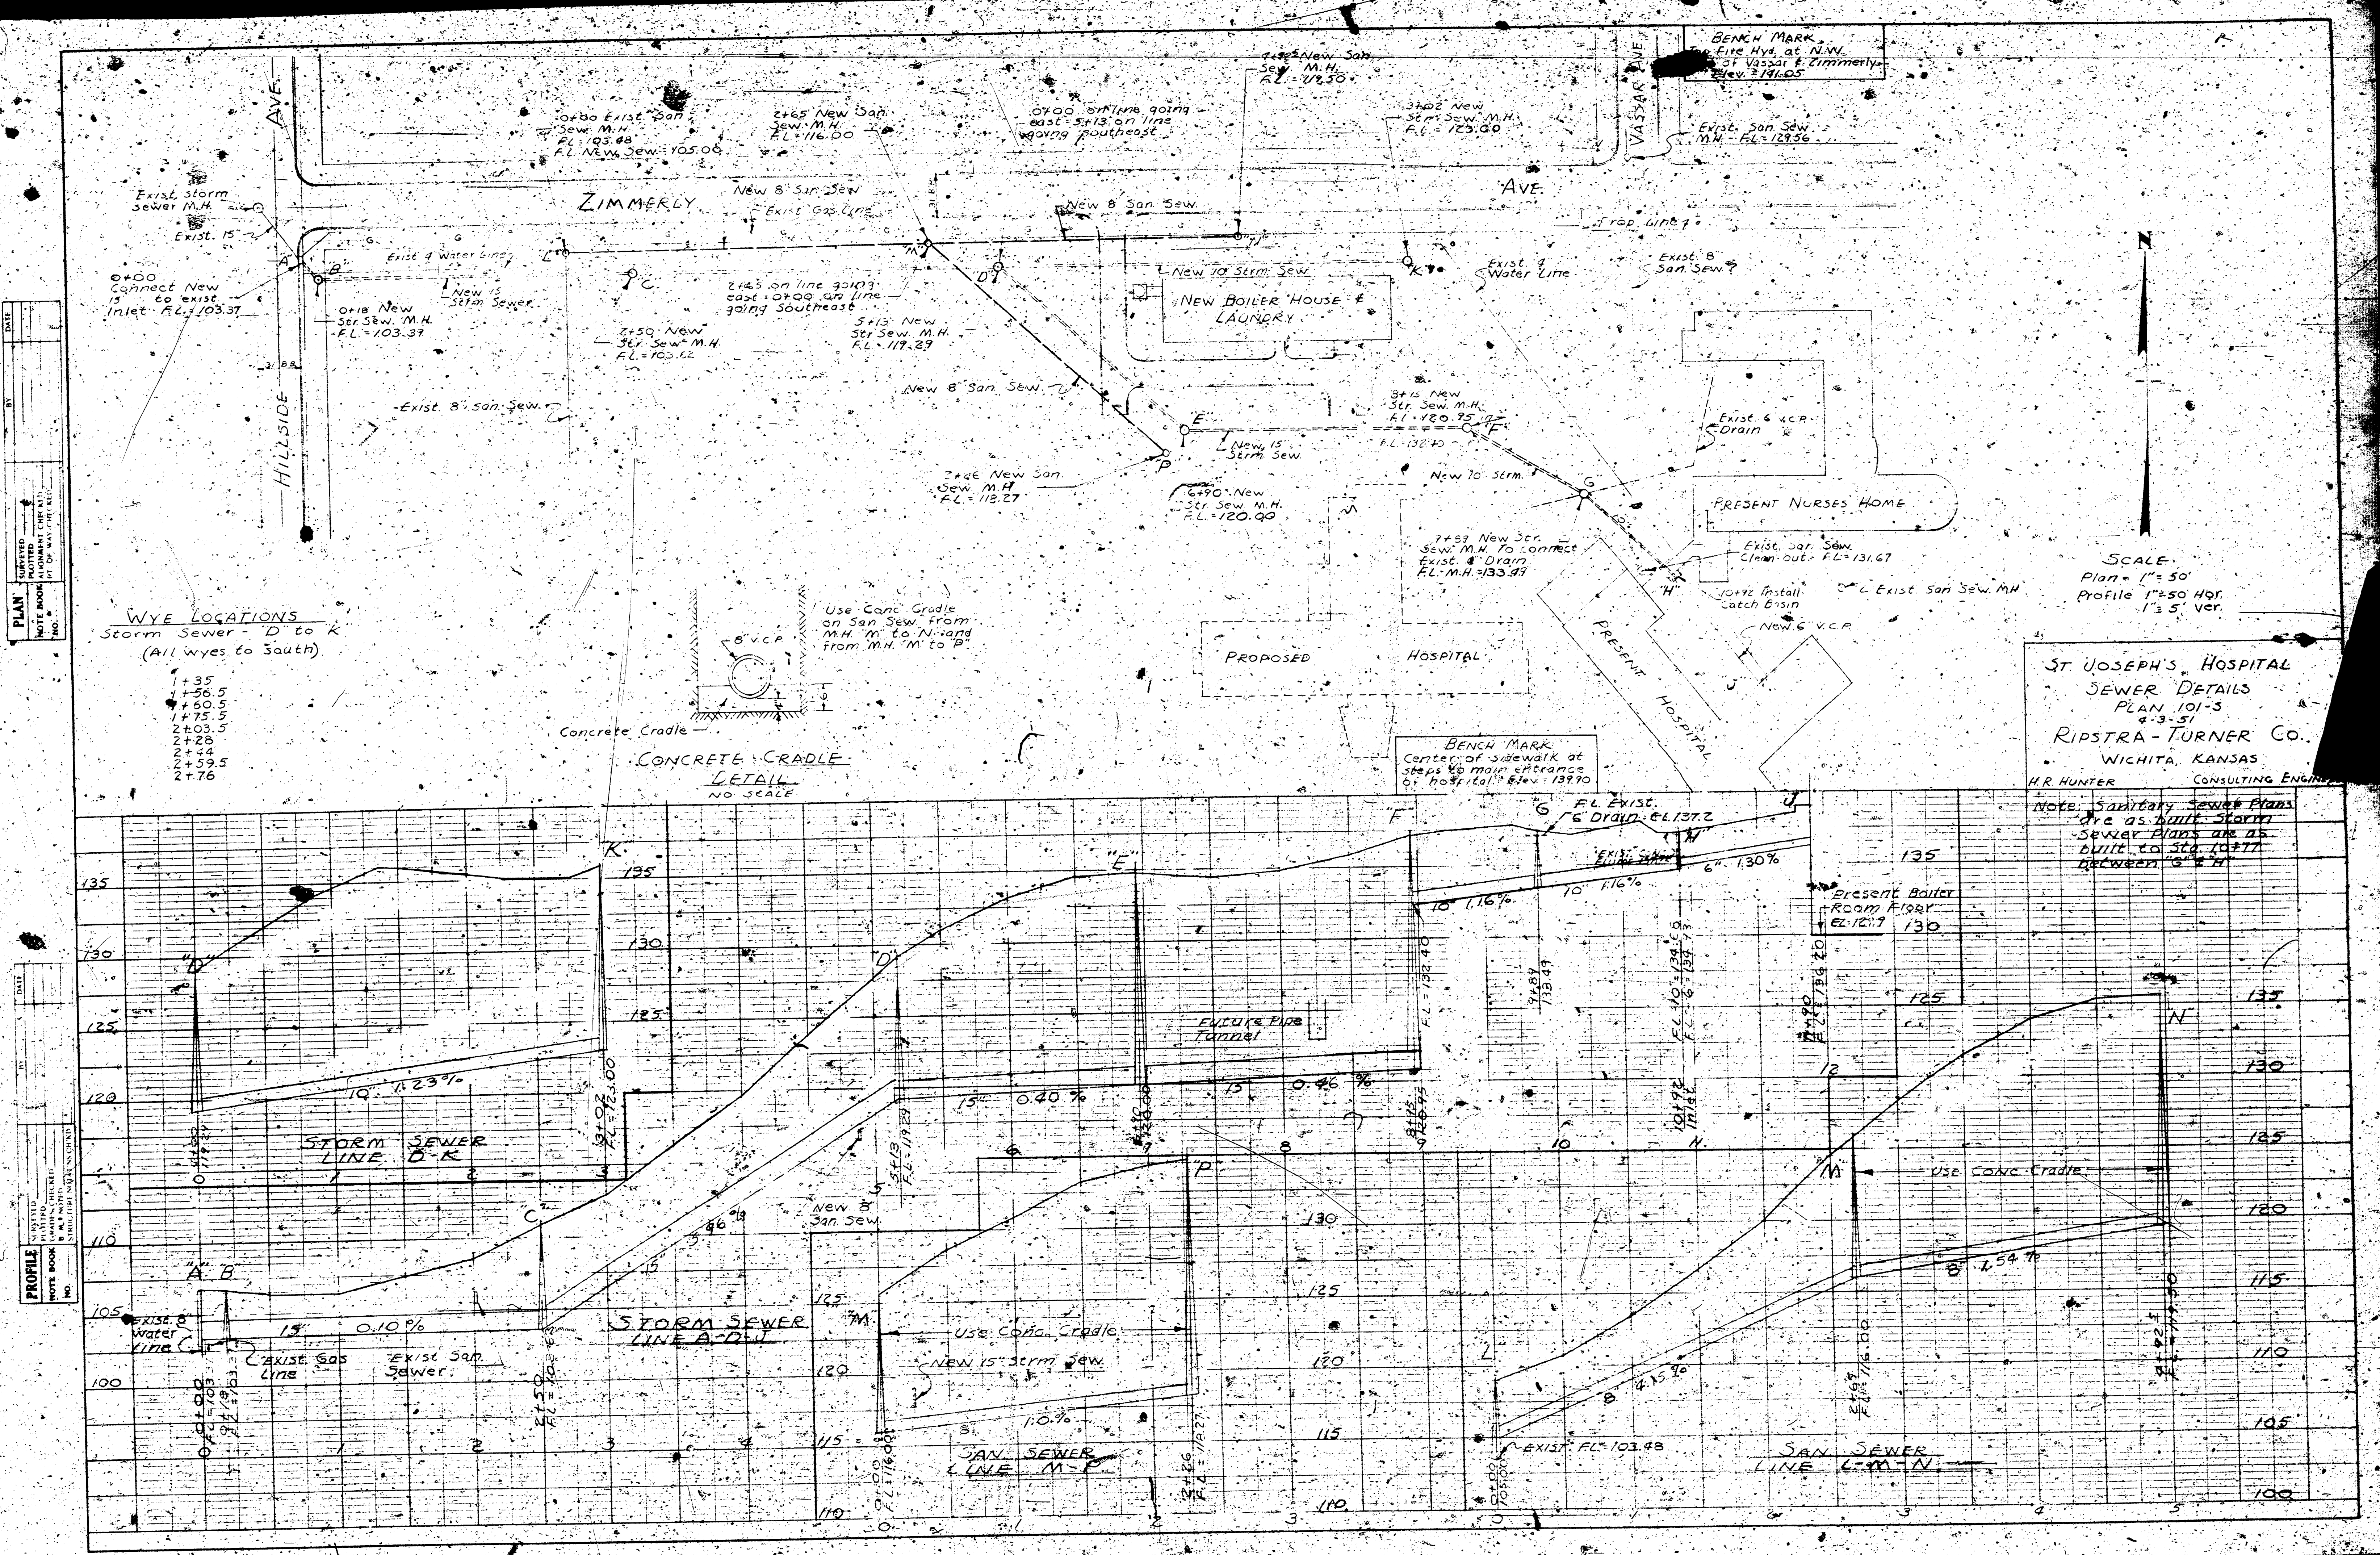

H. R. HUNTER
CONSULTING ENGINEER
P. O. BOX 1330 WICHITA, KANSAS
May 4, 1951

City Engineer
City of Wichita
City Building
Wichita, Kansas

Dear Sir, Write:

We enclose herewith a print showing sewers
as installed for St. Joseph Hospital.

Yours very truly,
H. R. HUNTER-CONSULTING ENGINEER
H. R. Hunter