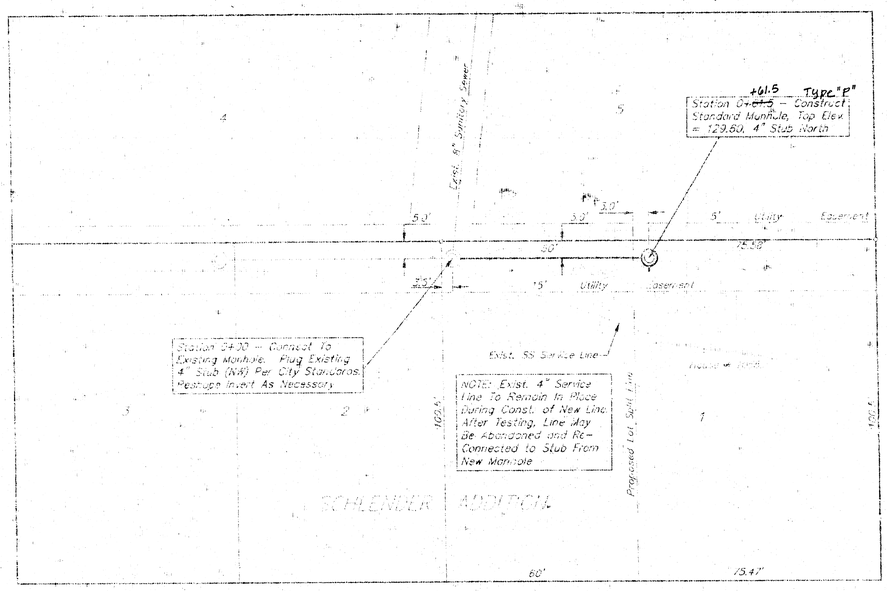

GENERAL NOTES

1. Underground utility service lines and overhead utility pole lines are to be adjusted as necessary by others prior to construction unless the plans specifically call for their adjustment by the Contractor or unless the plans specifically identify a utility to be adjusted by its owner during construction. Existing utilities and their location, as shown on the plans, represent the best information obtainable for design. The Contractor will be required to work around existing utilities within the right-of-way which do not conflict with proposed construction.

2. Trees and shrubs in public right-of-way which are in direct conflict with proposed new construction shall be removed by the Contractor with the Engineer's approval. Trees and shrubs which are not in direct conflict with proposed new construction shall be saved and protected from damage.

3. The Contractor shall be responsible for maintaining continuous flow of sewage through construction. Contractor's proposed method for maintaining sewage flow shall be approved by the Engineer. Cost of maintaining flow of sewage through construction will not be paid for directly and this cost shall be considered as subsidiary to the other pay items of work.

4. The Contractor shall be responsible for preserving property irons. The Contractor will be required to re-establish any property irons which are damaged or destroyed by his construction operations. Such irons shall be re-established by a licensed land surveyor in accordance with state laws.

VRH 8/19/92

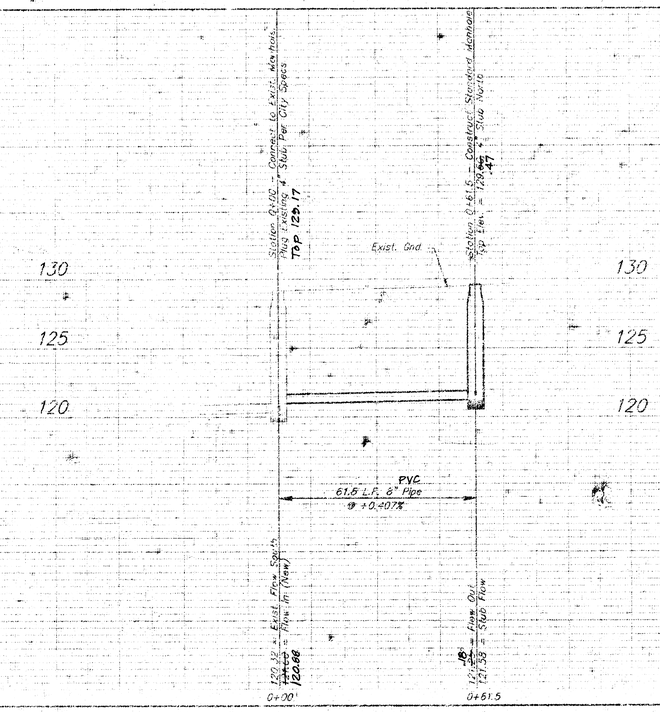

Booked 10-20-92 JKB

CHRISTOPHER MICHAEL BOHM LICENSED 11631 KANSAS PROFESSIONAL ENGINEER

Revised as built 9-4-92

PRIVATE SANITARY SEWER EXTENSION TO SERVE PART OF LOT 1, SCHLENDER ADDITION

BAUGHMAN COMPANY P. A.
ENGINEERING & SURVEYING
316/262-1727 • 315 ELLIS • WICHITA, KANSAS 67211

359 PPS			607861	
DESIGN C. Bohm	DRAWN C. Bohm		DATE Aug. 1992	SCALE