NOTE TO CONTRACTOR
This project will be constructed under the supervision of the CITY ENGINEER and conformance to the SPECIFICATIONS

10-7-74
APPROVED AS NOTED
By CITY ENGINEER OF WICHITA
Sanitary Sewers D.E.S.
Storm Sewers D.E.S.
Driveway Approaches

Proj. No. 08KW704059

RELATED DRAWINGS

SHEET

MADISON AVENUE

GENERAL NOTES

A REFERENCE FLOOR & SITE PLAN

2 QUADRANGLE

1 LOT AREA
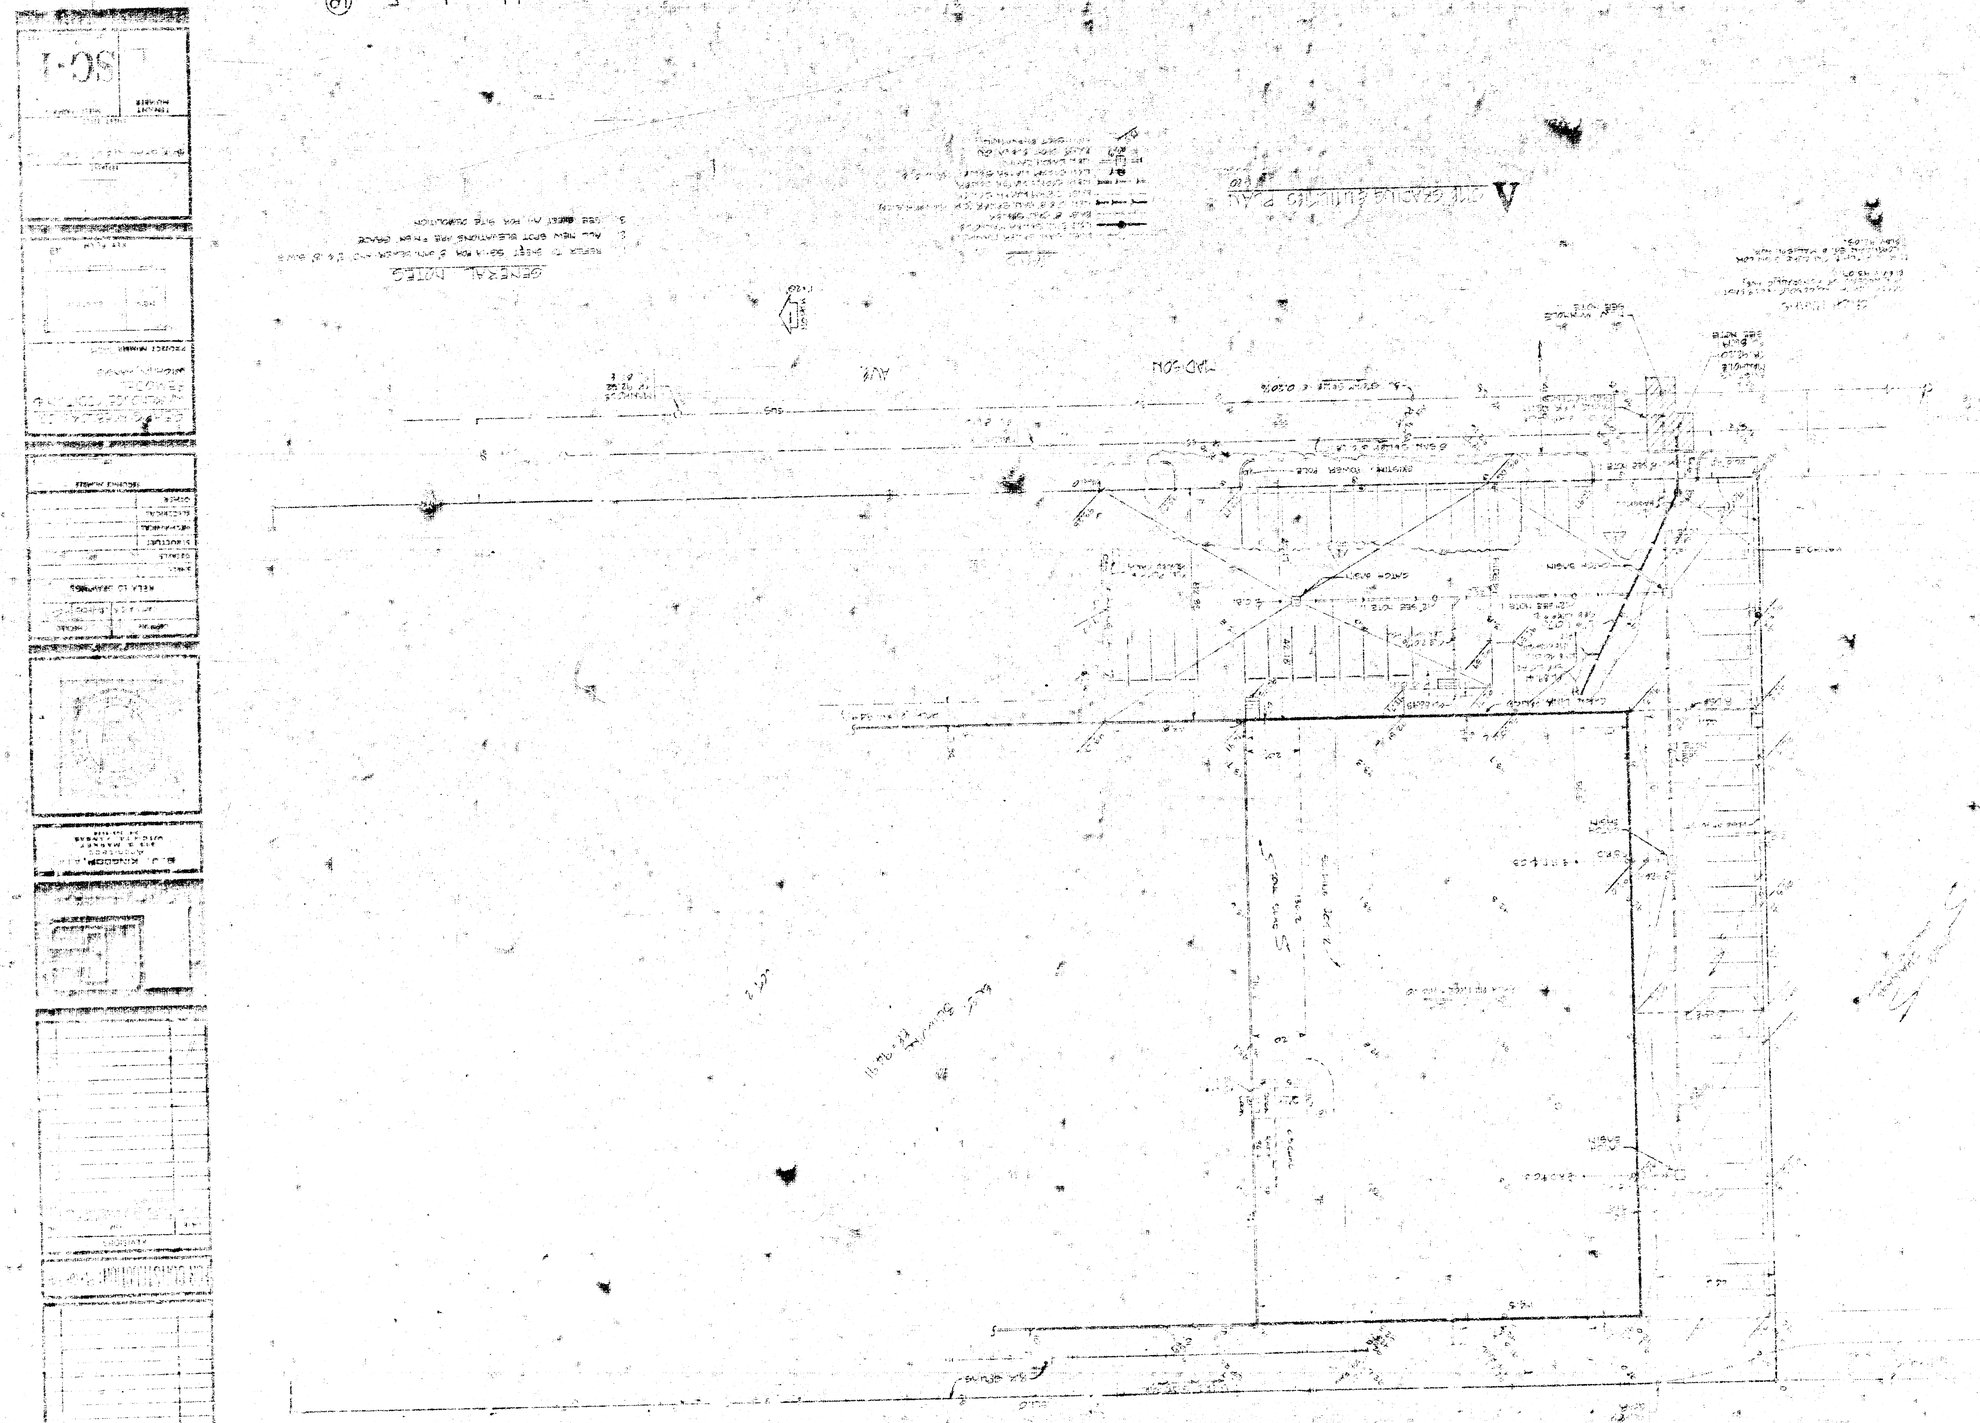
A1