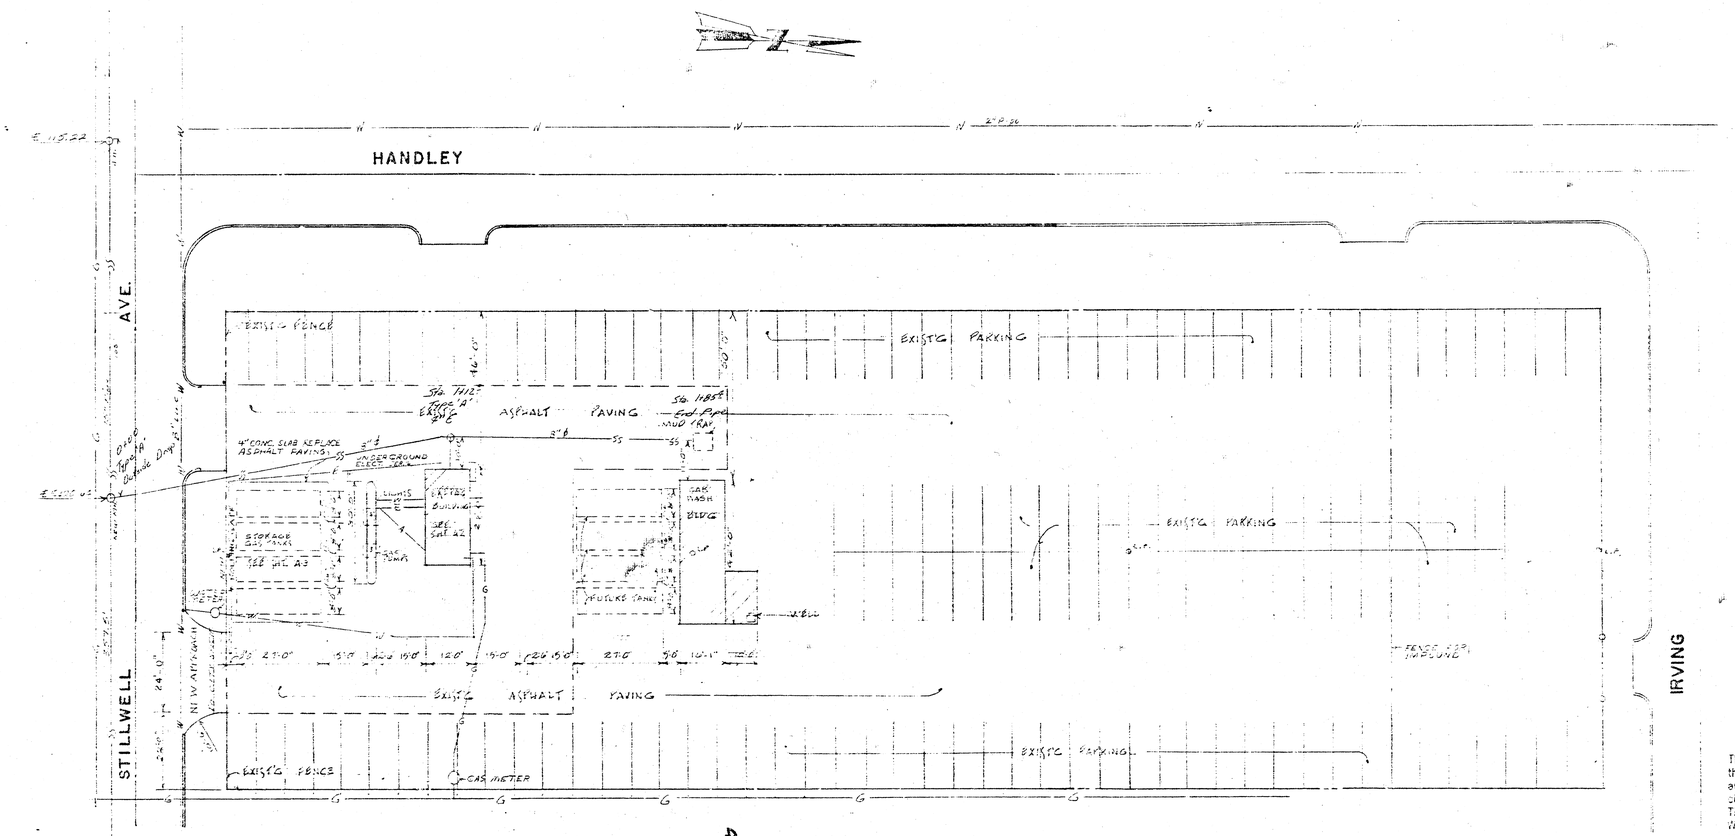

SITE PLAN

SCALE 20'-0"=1"

GENERAL NOTE:
INSTALL 208 V. SINGLE PHASE CONTROL CIRCUIT & POWER CIRCUIT FOR 2 HP. SUB-MERGIBLE PUMP AS REQUIRED BY PUMP MANUFACTURER.

LEGAL DESCRIPTION
LOTS SOUTH 20-1 OF LOT 24
FRANKLIN TIKE ADDITION
WICHITA, KANSAS

NOTE TO CONTRACTOR
This project will be constructed under the supervision of the CITY ENGINEER and conforming to the SPECIFICATIONS of the CITY OF WICHITA. The CONTRACTOR will [illegible] the City of Wichita for all cost of [illegible] inspection.

8-31-79

APPROVED AS NOTED
By CITY ENGINEER OF WICHITA
Sanitary Sewers
Storm Sewers
Driveway Approaches

As Built

E 154 AR 61

SERVICE STATION AND CAR WASH FACILITY

468-76-245-80829-000-000-008

PREPARED BY
SEDGWICK COUNTY DEPARTMENT OF PUBLIC WORKS

REVISED	SCALE	DESIGNED	TRACED	CHECKED	SHEET NO.
	AS NOTED	GCM JUKE	N.J. GRAHAM		A-1
	DATE				
	PLANFILE		TOTAL SHEETS		