
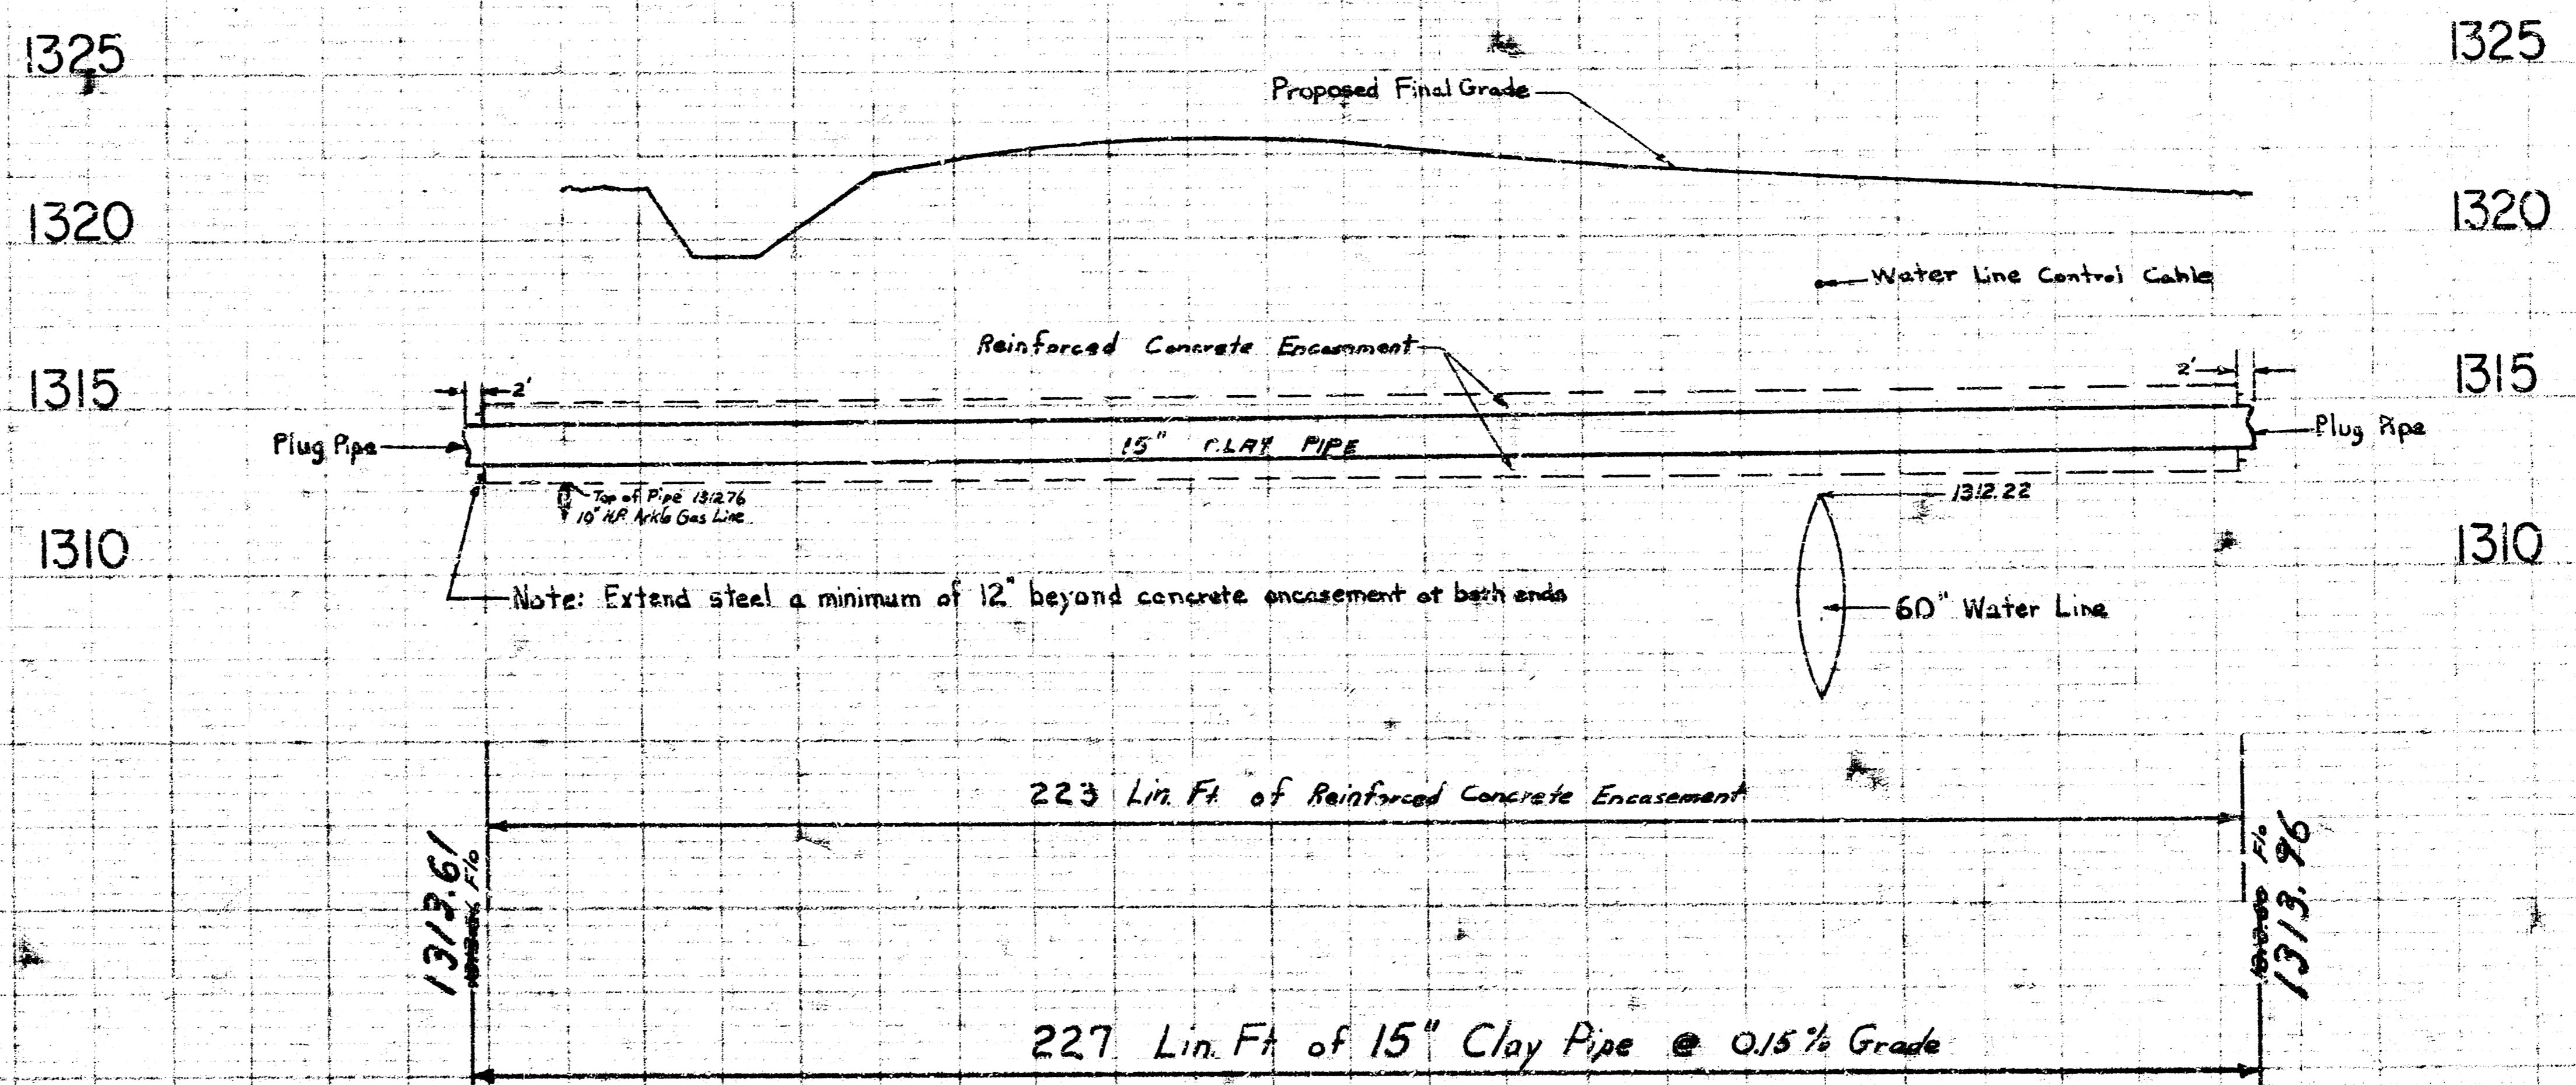
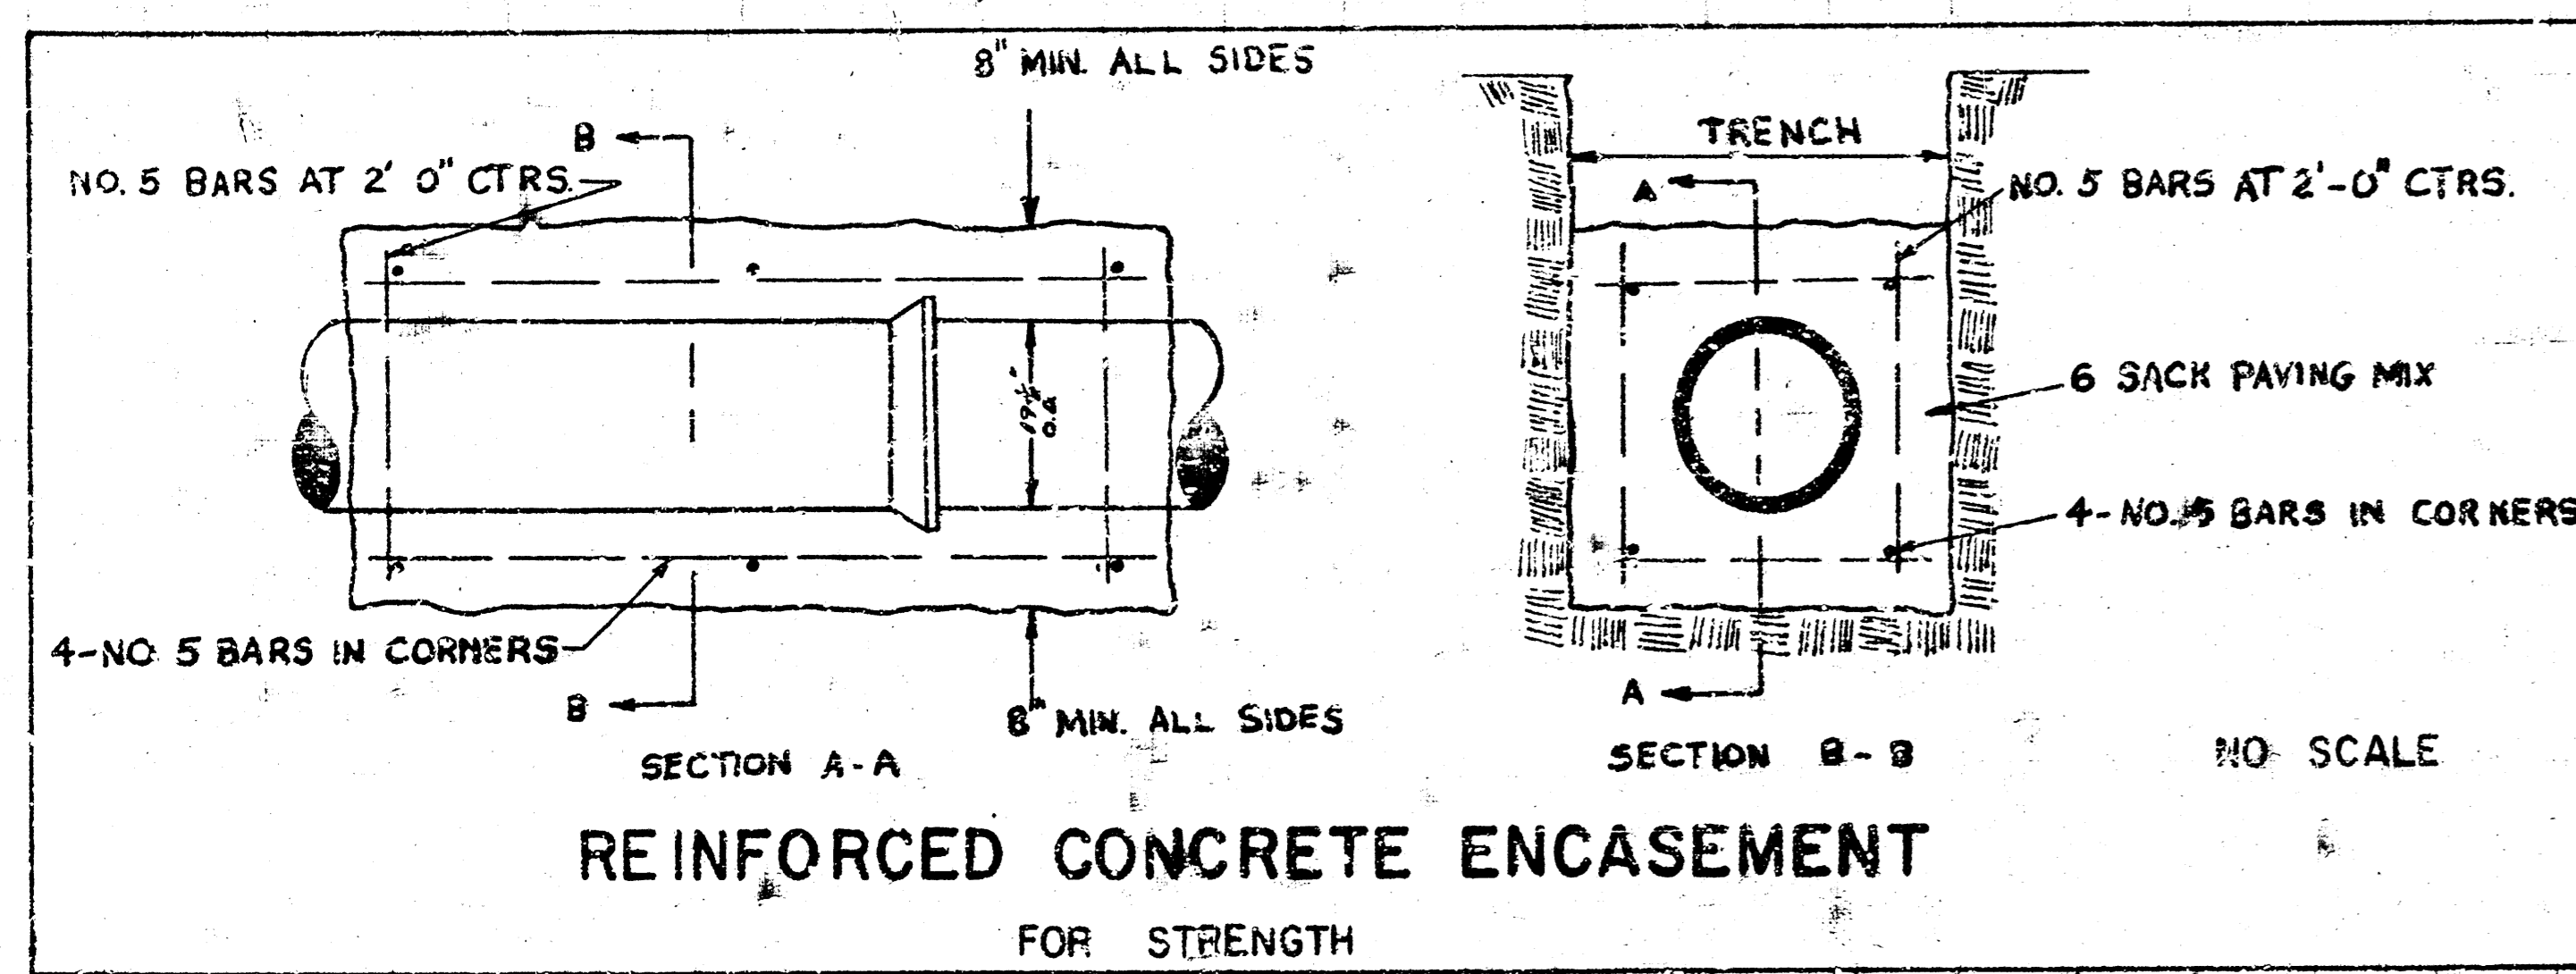


PUB ROAD DIV NO	STATE	PROJECT NO	FISCAL YEAR	SHEET NO	TOTAL SHEETS
5	KANSAS	87RS 428(13)			

Plan Scale 1"=20'  
 Profile Scale 1"=20' HORIZ  
 1"=5' VERT

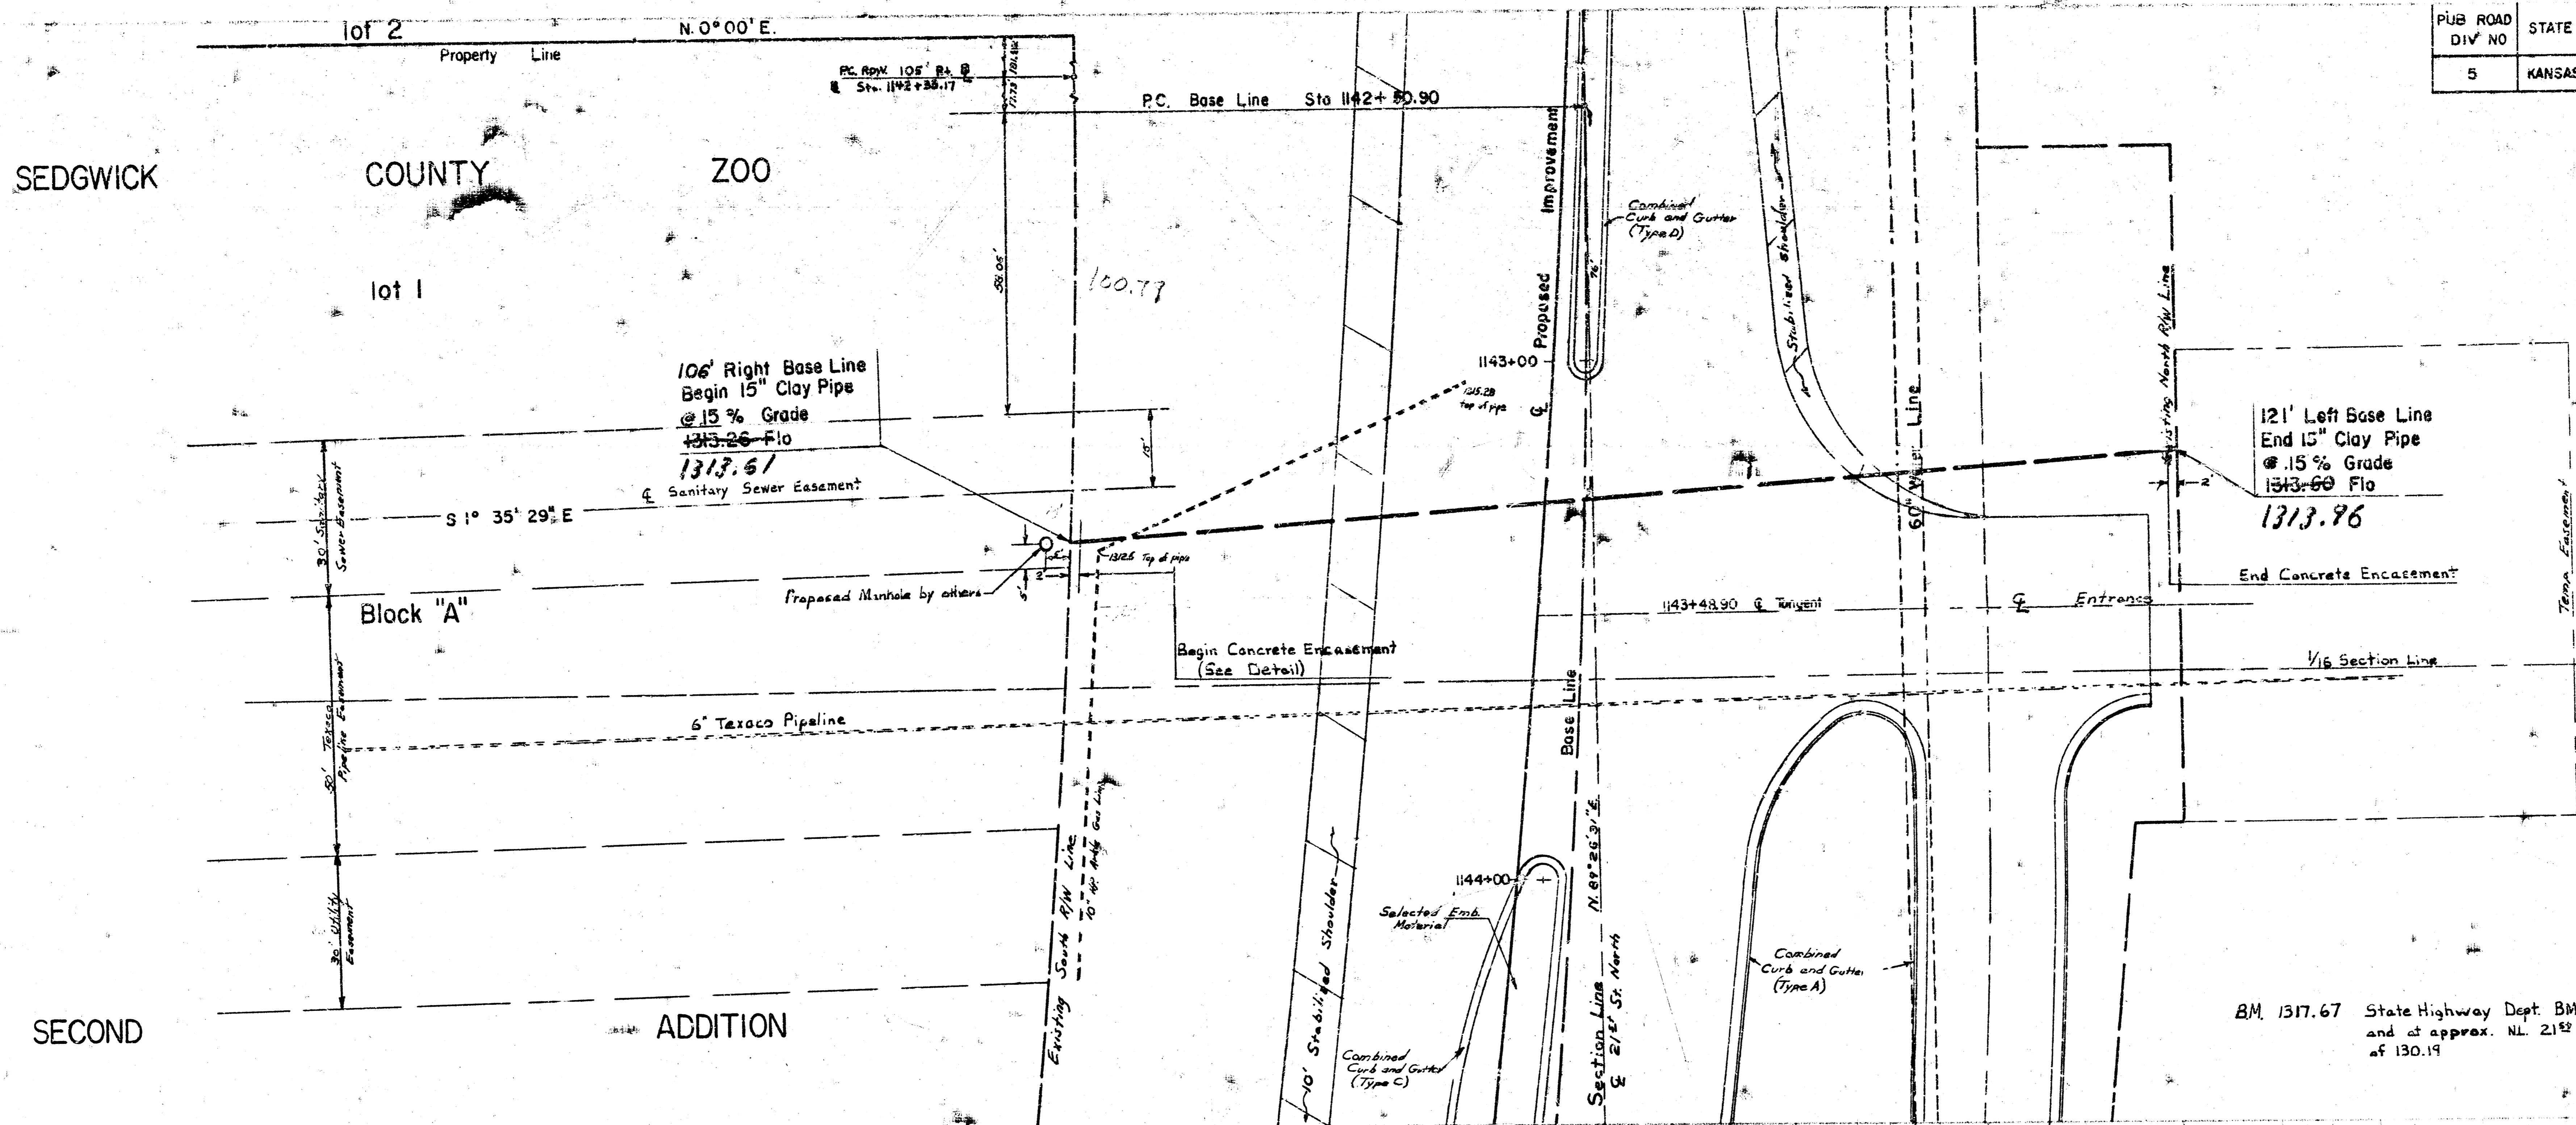

**SANITARY SEWER CROSSING**  
 TWENTY FIRST STREET  
 NORTH OF SEDGWICK CO.  
 ZOO  
 PRIVATE PROJECT DBKW705057